


C. E. NICHOLS ADDITION
(Drainage)

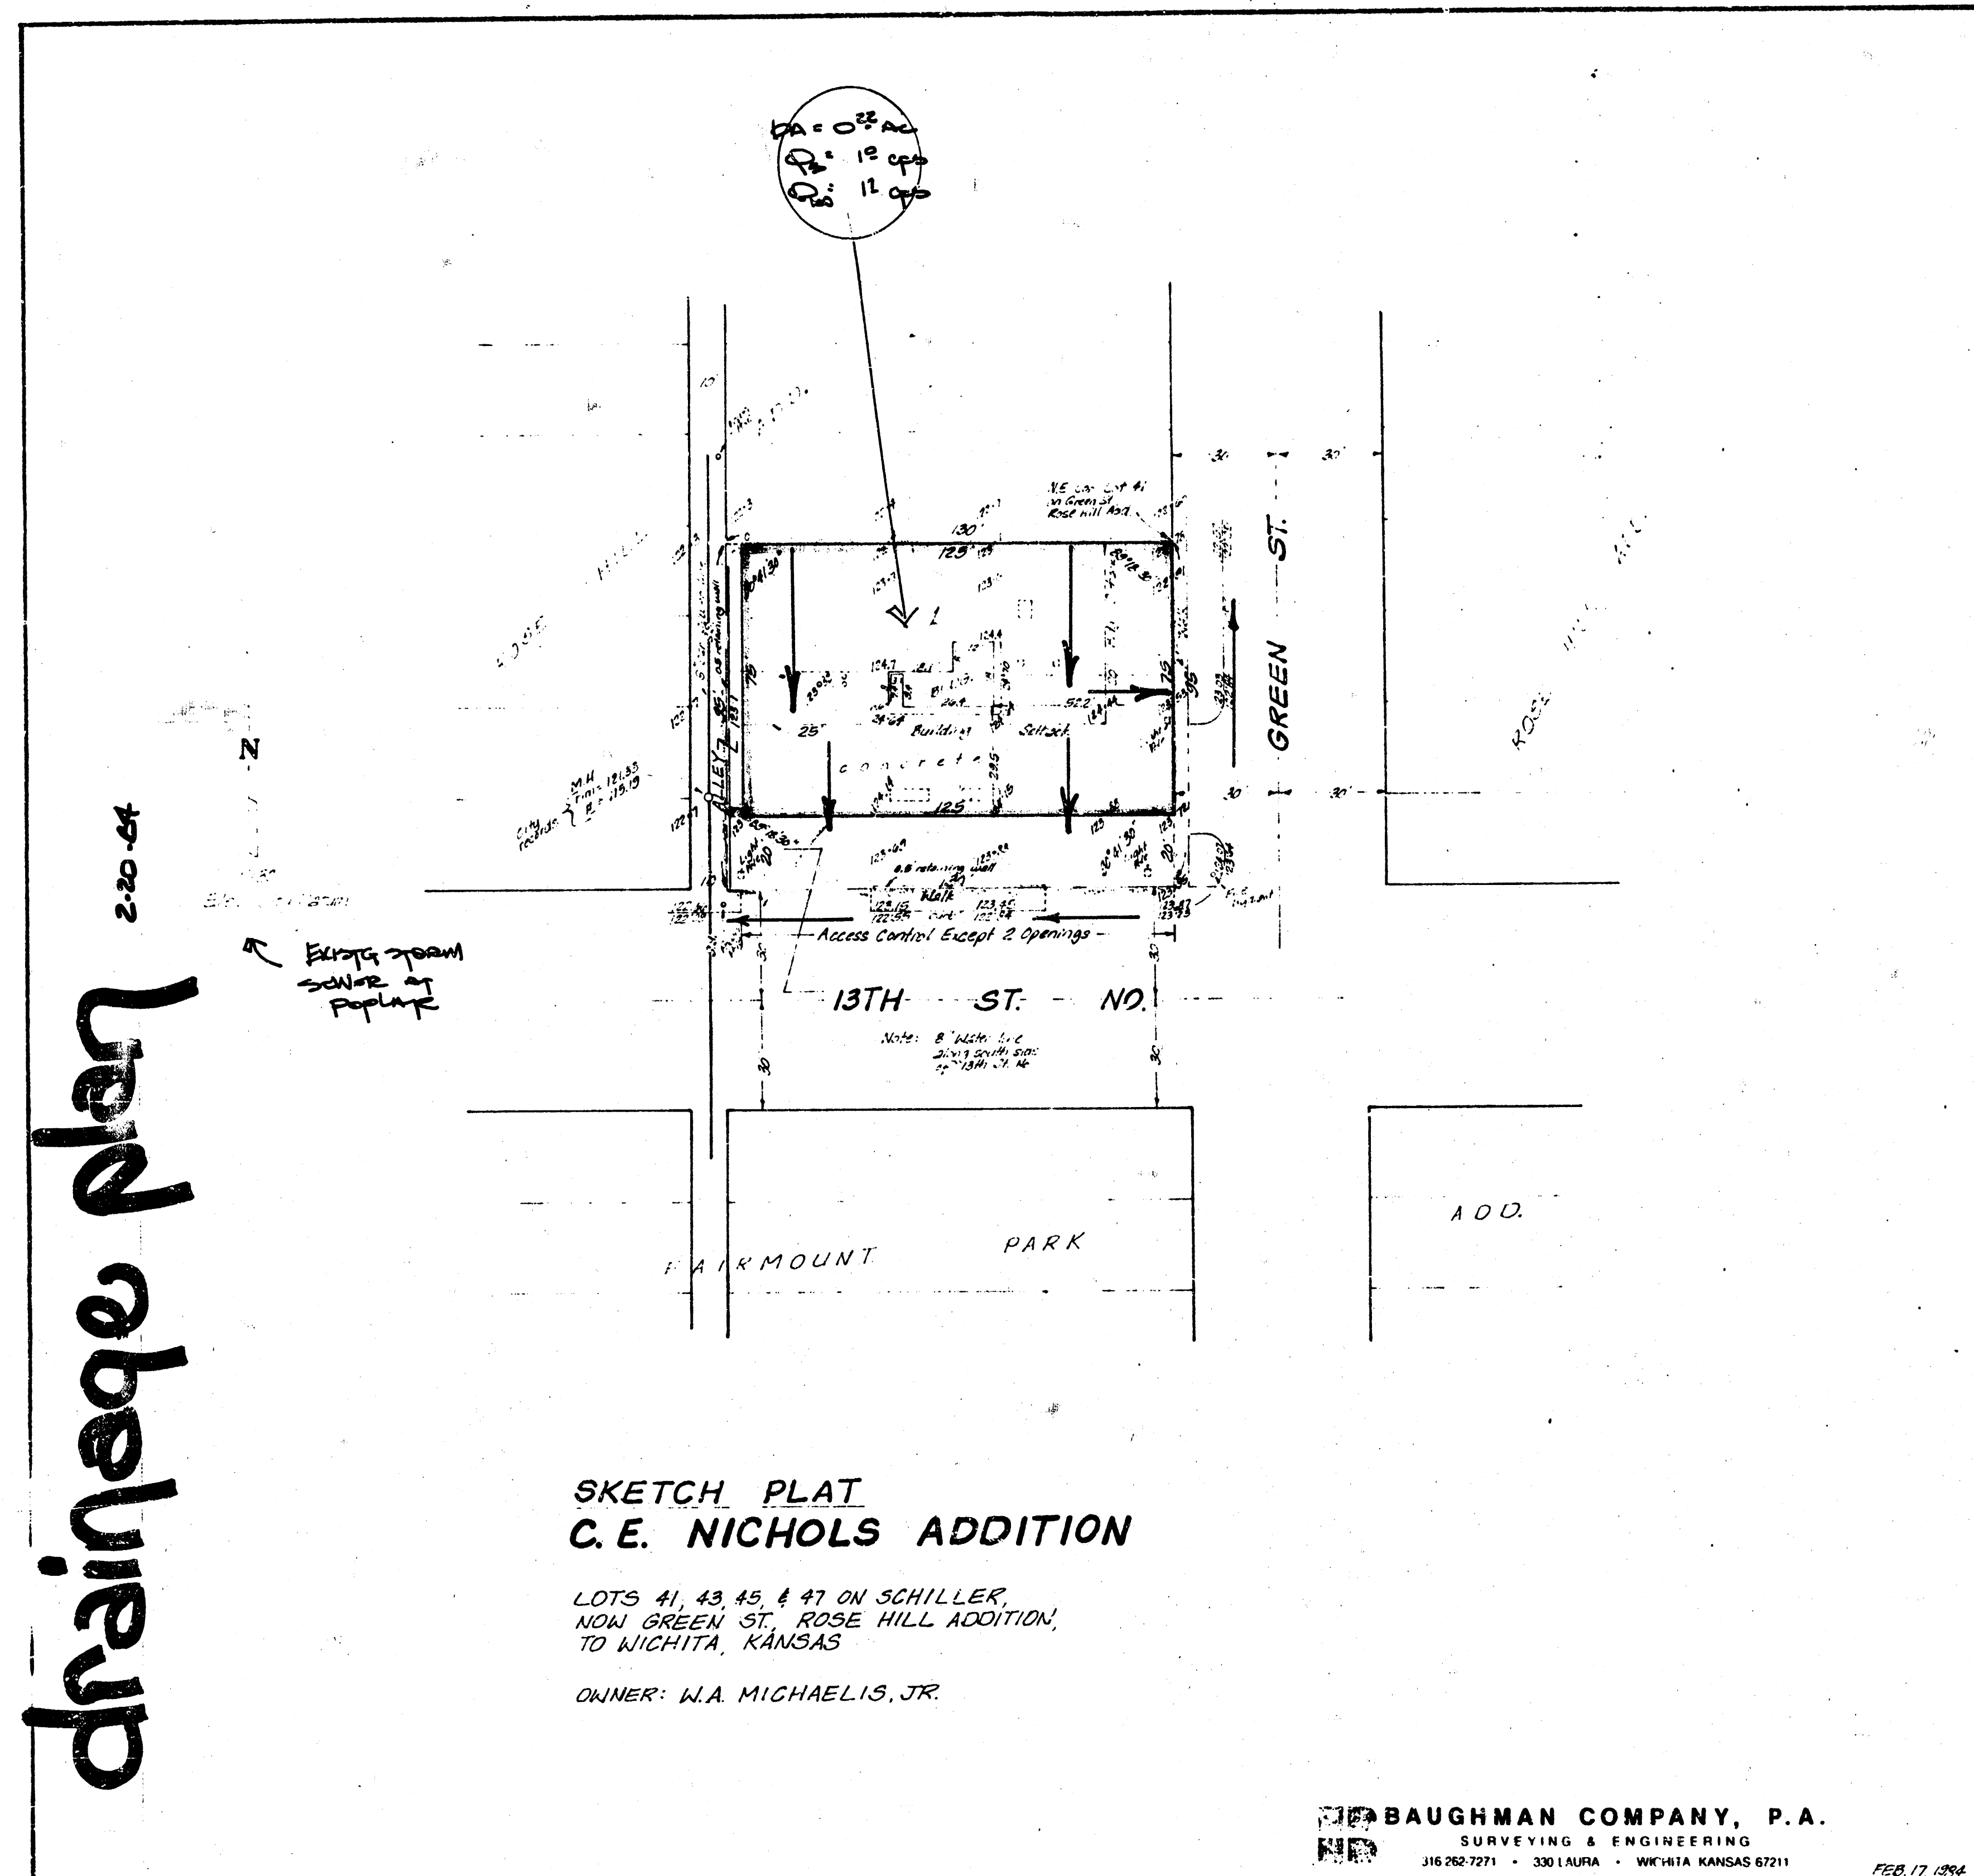

**SKETCH PLAT
C.E. NICHOLS ADDITION**

LOTS 41, 43, 45, & 47 ON SCHILLER,
NOW GREEN ST., ROSE HILL ADDITION,
TO WICHITA, KANSAS

OWNER: W.A. MICHAELIS, JR.

BAUGHMAN COMPANY, P.A.
SURVEYING & ENGINEERING
316 262-7271 • 330 LAURA • WICHITA, KANSAS 67211

FEB. 17, 1964

BAUGHMAN COMPANY, P.A.
SURVEYING & ENGINEERING
316/262-7271 • 330 LAURA • WICHITA, KANSAS 67211

**FORMAL
MEMO**

PROJECT C. E. NICHOLS ADDITION

DATE 2-20-64

JOB NO. _____

COPIES TO: _____

TO Chris Breitenstein

FROM N. Brent Wooten

REFERENCE Final Drainage Plan

Final plat is scheduled for subdivision for March 1, 1964.

Lot runoff factor for this commercial lot will be 0.85.
The lot will drain south and each to 13th St. or Green. Green
drains to the north as indicated. 13th St. drains west to storm
sewer at Poplar. Discharge will be to the street thru the drives.

O.K.