C. E. NICHOLS ADDITION
(Drainage)

drainage plan

2-20-84

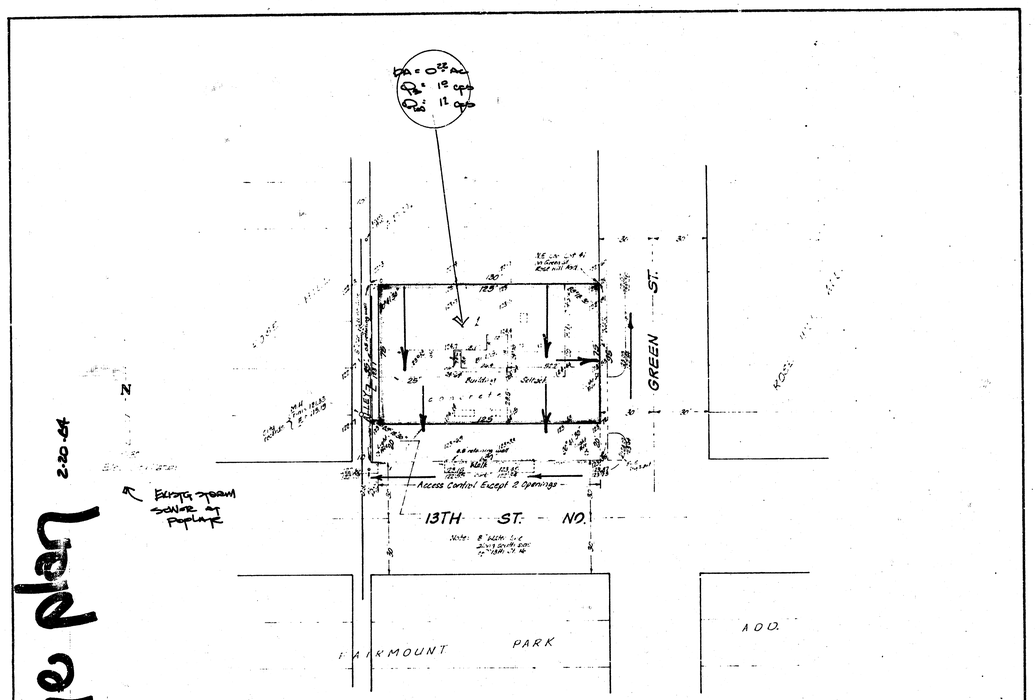

SKETCH PLAT
C.E. NICHOLS ADDITION

LOTS 41, 43, 45, & 47 ON SCHILLER, NOW GREEN ST., ROSE HILL ADDITION, TO WICHITA, KANSAS

OWNER: W.A. MICHAELIS, JR.

BAUGHMAN COMPANY, P.A.
SURVEYING & ENGINEERING
316.262-7271 • 330 LAURA • WICHITA KANSAS 67211

FEB. 17, 1984

BAUGHMAN COMPANY, P.A.
SURVEYING & ENGINEERING
316/262-7271 • 330 LAURA • WICHITA, KANSAS 67211

FIRMAT MEMO

PROJECT C. E. NICHOLS ADDITION
JOB NO.
TO Chris Breitenstein
FROM N. Brent Wooten
REFERENCE Final Drainage Plan

DATE 2-20-84
COPIES TO:

Final plat is scheduled for subdivision for March 1, 1984.

Lot runoff factor for this commercial lot will be 0.85. The lot will drain south and each to 13th St. or Green. Green drains to the north as indicated. 13th St. drains west to storm sewer at Poplar. Discharge will be to the street thru the drives.

O.K