


drainage plan

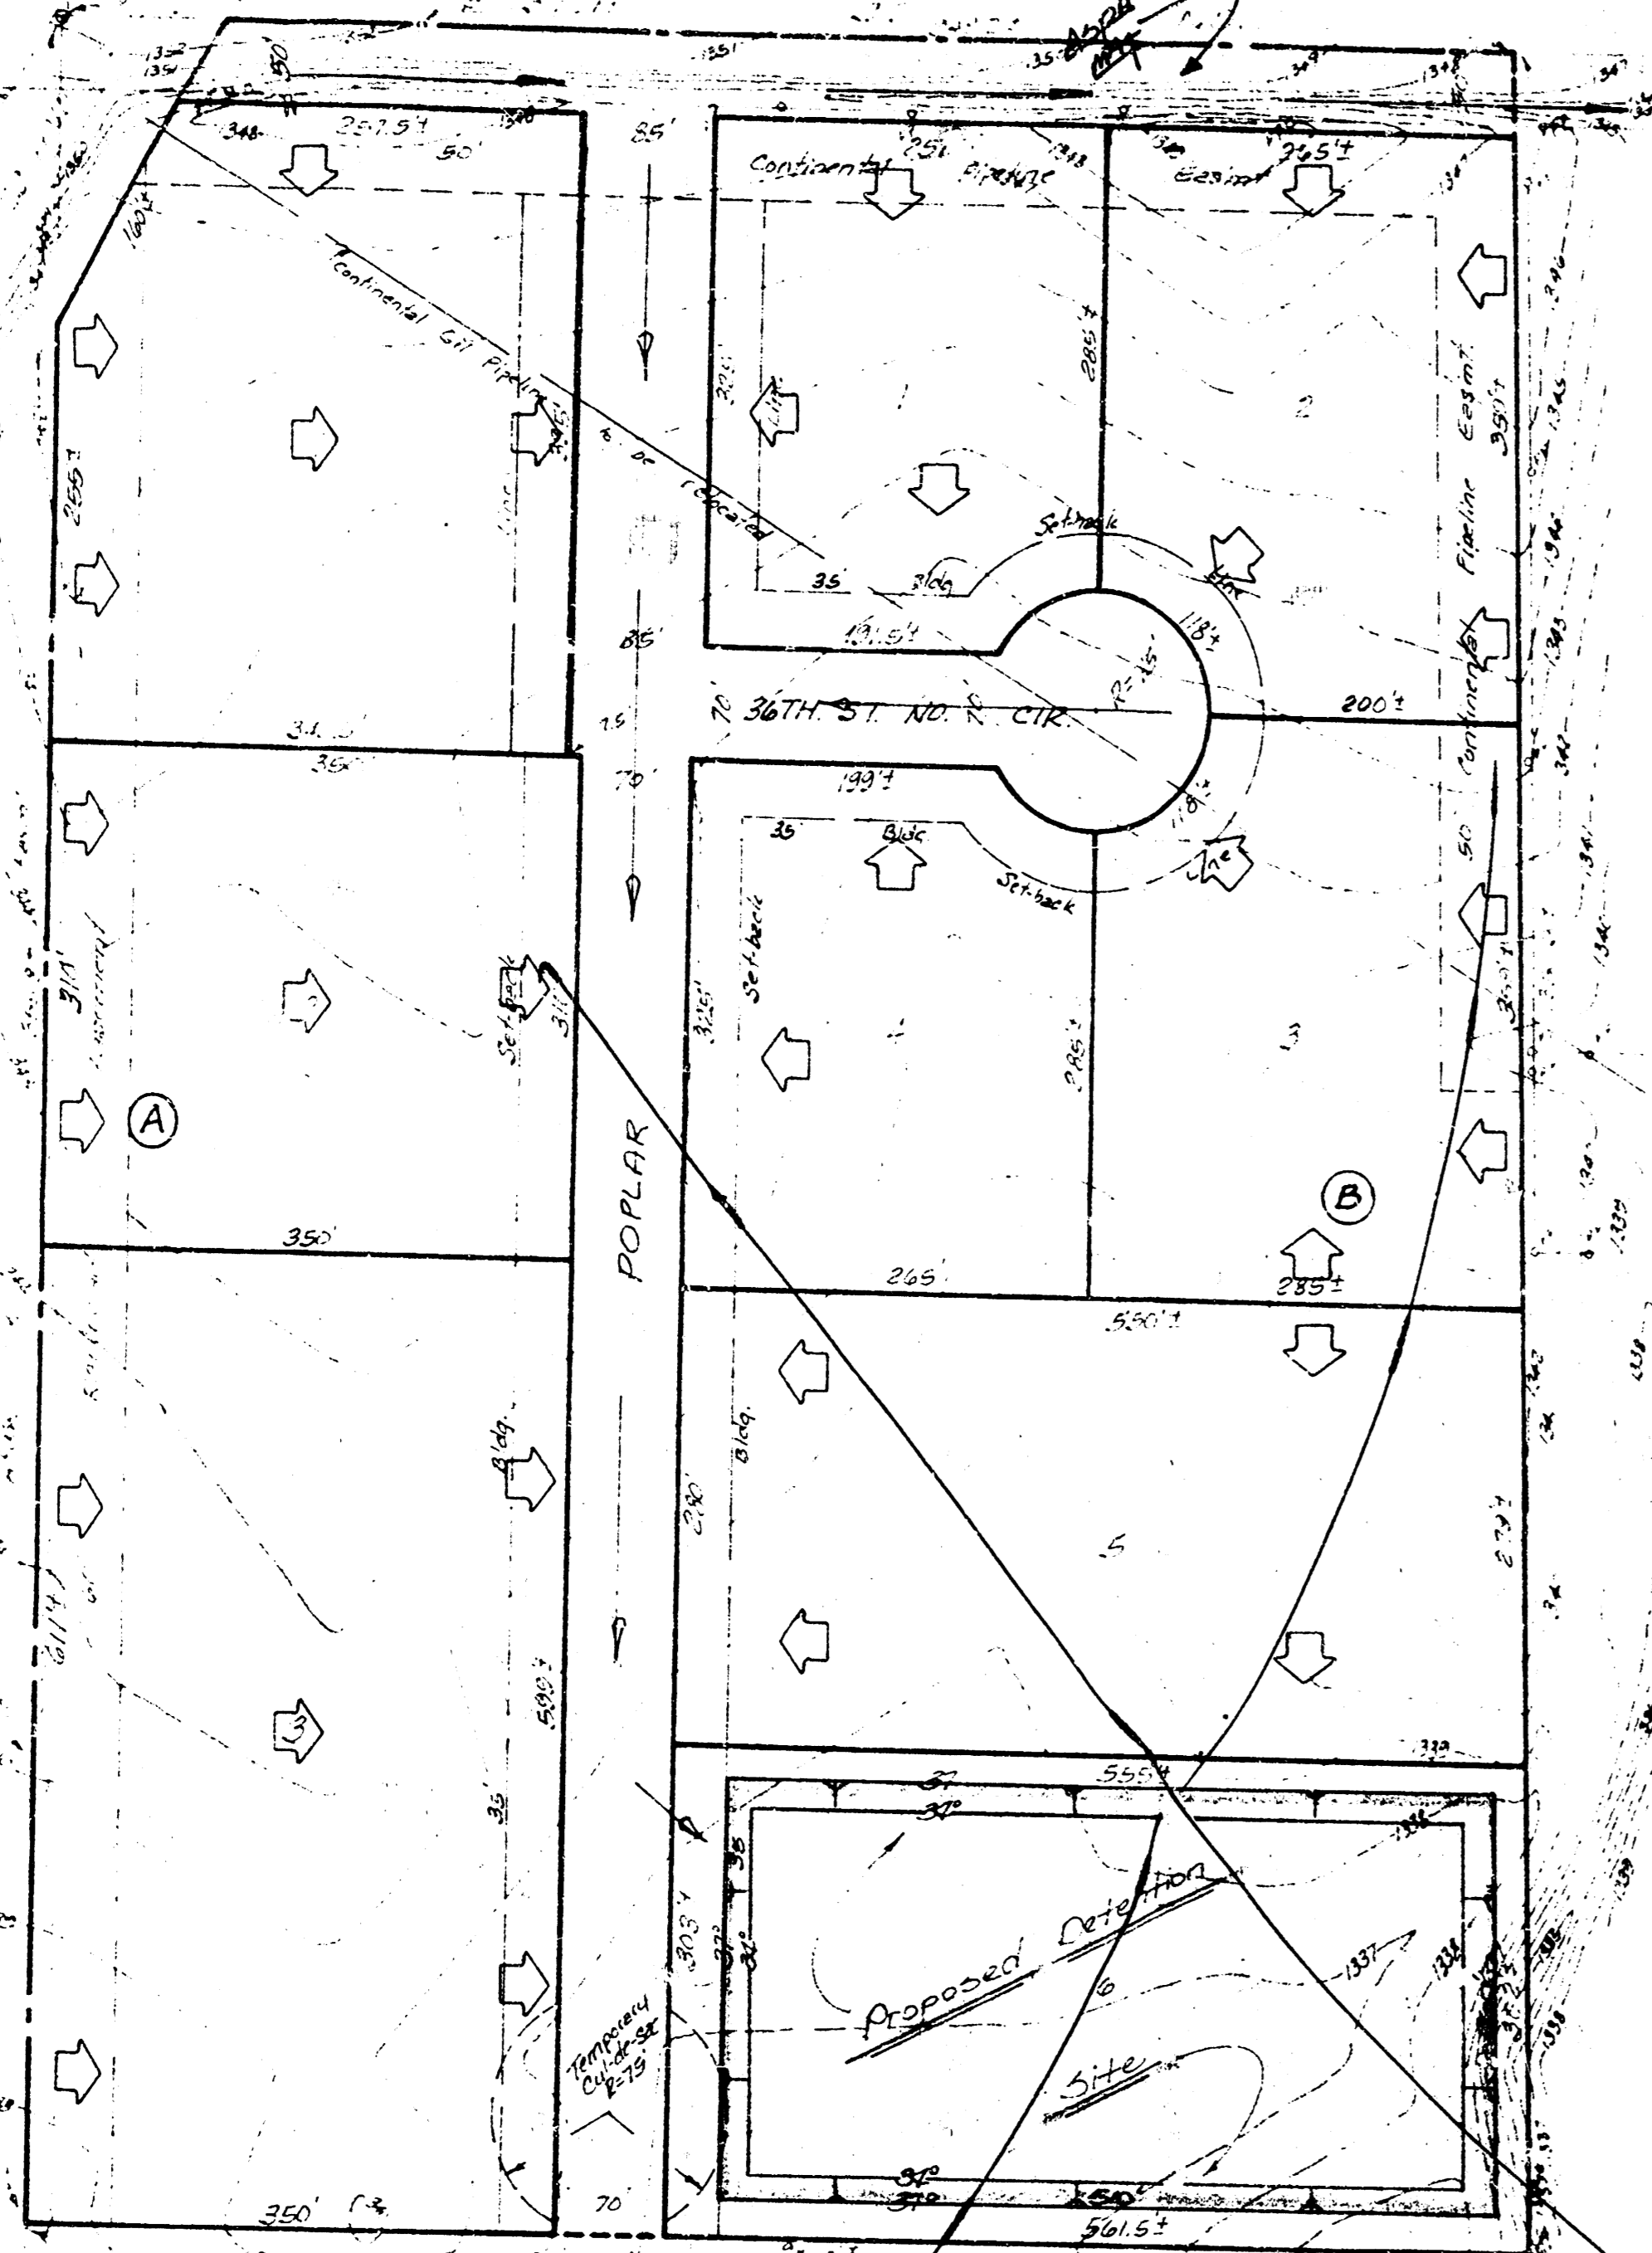


NORTHRIDGE INDUSTRIAL PARK

LEASING & RENTAL SERVICE, INC.
LESS RUDD

BAUGHMAN COMPANY, P.A.
SURVEYING & ENGINEERING
316/262-7271 • 330 LAURA • WICHITA, KANSAS 67211

drainage plan

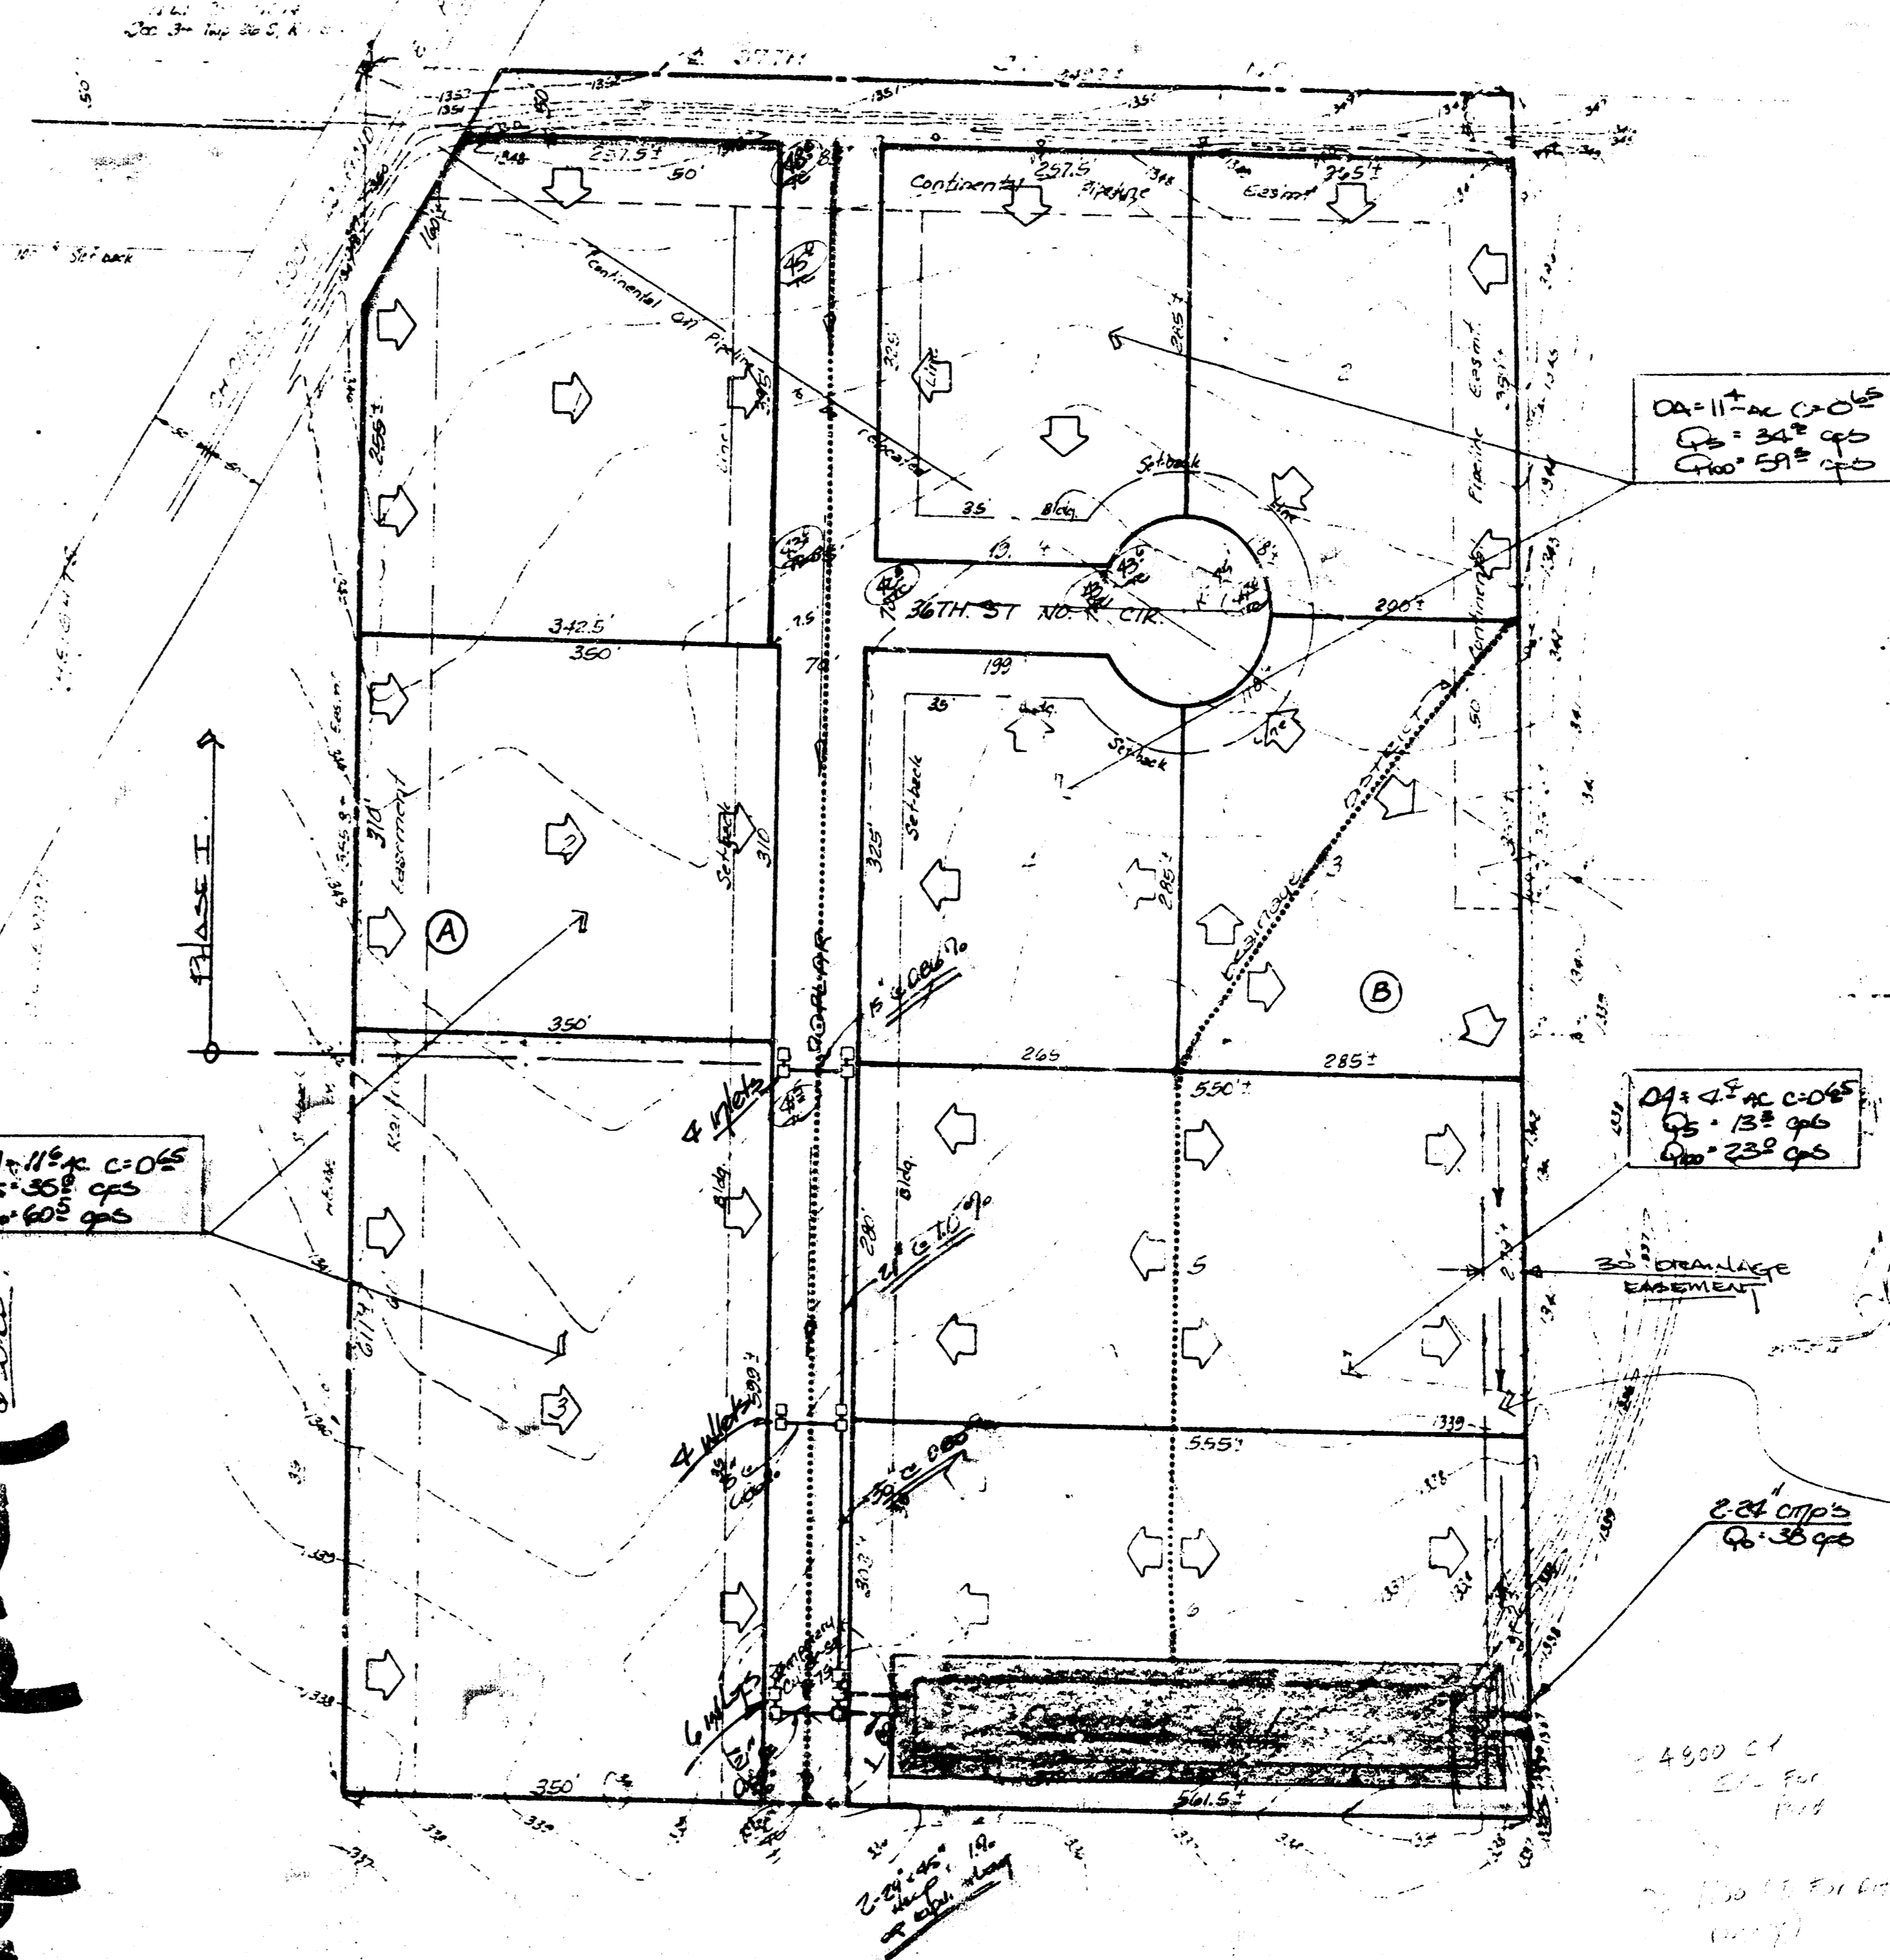

NORTHRIDGE INDUSTRIAL PARK

LEASING & RENTAL SERVICE, INC.
LESS RUDD

How to build Inlets at Cal-de-Sac
Requires off-site storage system

BAUGHMAN COMPANY, P.A.
SURVEYING & ENGINEERING
316/262-7271 • 330 LAURA • WICHITA, KANSAS 67211

BAUGHMAN COMPANY, P.A.
SURVEYING & ENGINEERING
316/262-7271 • 330 LAURA • WICHITA, KANSAS 67211

CONFIRMATION MEMO

Project: Northridge Industrial Plat
DATE: July 1, 1983
JOB NO.:
COPIES TO:
By: Chris Breitenstein
For: Brent Wooten
Subject: Drainage Plan

Final Plat of Northridge Industrial Park is scheduled for July 7, 1983. The final portion of the Plat is being finalized at this point. The site is to be an industrial park development with avg. sloped ground. Relief factor = 0.65.

The site is presently fernum soil type and group type B. Avg. runoff factor for the existing cultivated soil is 0.16. Area of the total site is 22.17 acres. The total area will be considered for the storage area at this point. The site is adjacent to a creek and the drainage will include discharge into the creek only at the existing corner of roof lots. The remainder will be detained in a storage area at the S.W. corner of the plat.

The detention pond and the 24" discharge pipes should be constructed at the first final phase of the plat. The area in the first phase is approximately 16 acres. The storm sewer system which begins at the S.W. corner of the first phase would be constructed with the second phase when it is final plotted and the cost of the total storm sewer system against both Phase I and Phase II.

The detention pond will adequately serve phase I without the storm sewer. Phase I from Phase I will be temporarily ditched south of the pond site.

The plan and the hydrograph are presented here.

TIME OF CONC.
Length = 1500 ft slope 0.16 to
C = 0.85 gutter flow
T_c = 20 min. I₁₀₀ = 8.08 in/hr
I₂ = 4.16 in/hr

ALLOWABLE FLO OUT
Q₂ = 0.16 (8.08) (29.17) = 38 cfs
assume we use 2-24" pipes amp
C = 11 cfs/pipe w 3.5' head.

developed flow in
Q₁ = 0.16 (8.08) (29.17) = 152 cfs

VOLUME OF STORAGE - APPROXIMATE STORAGE
= (Q₁ - Q₂) t_p
= (152 - 38) 20 (60) = 136800 CF
= 3.1 AC-FT

Basin Design -
DIMENSIONS WILL BE
80' x 80' x 3.5'
AND WILL BE LOCATED IN LOT 6 AS INDICATED.

INFLOW OUTFLOW HYDROGRAPH CHECK -

Outflow = 38 cfs
w 3.5' head & 24" pipes (amp)
Q/pipe = 19 cfs
so 2-24" pipes will handle discharge etc.

INFLOW HYDROGRAPH
Q₁ = 152 cfs Q₂ = 38 cfs
t_p = 20 min.

Basin Design -
80' x 80' x 3.5' = 3.15 AC-FT

Rating -
2-24" amp pipe

Rating - STAGE STORAGE.




Water Level	Surface Area	Inc. Vol.	Total Vol.
0	36281	18579	0
0.5	38036	19461	18579
1.0	39801	20352	38040
1.5	41600	21252	58292
2.0	43409	22161	79044
2.5	45236	23079	101603
3.0	47081	24000	125884

STAGE-DISCHARGE -

Water Level	Inflow	Outflow	Storage
0	0	0	0
0.5	0.25	2	4
1.0	0.5	4	6
1.5	0.75	6	16
2.0	1.0	10	37
2.5	1.25	16	52
3.0	1.50	18	66
3.5	1.75	20	80

INFLOW HYDROGRAPH -

Time	Inflow	Outflow	Storage
0	0	0	0
0.5	0.25	0	0.25
1.0	1.00	0	1.00

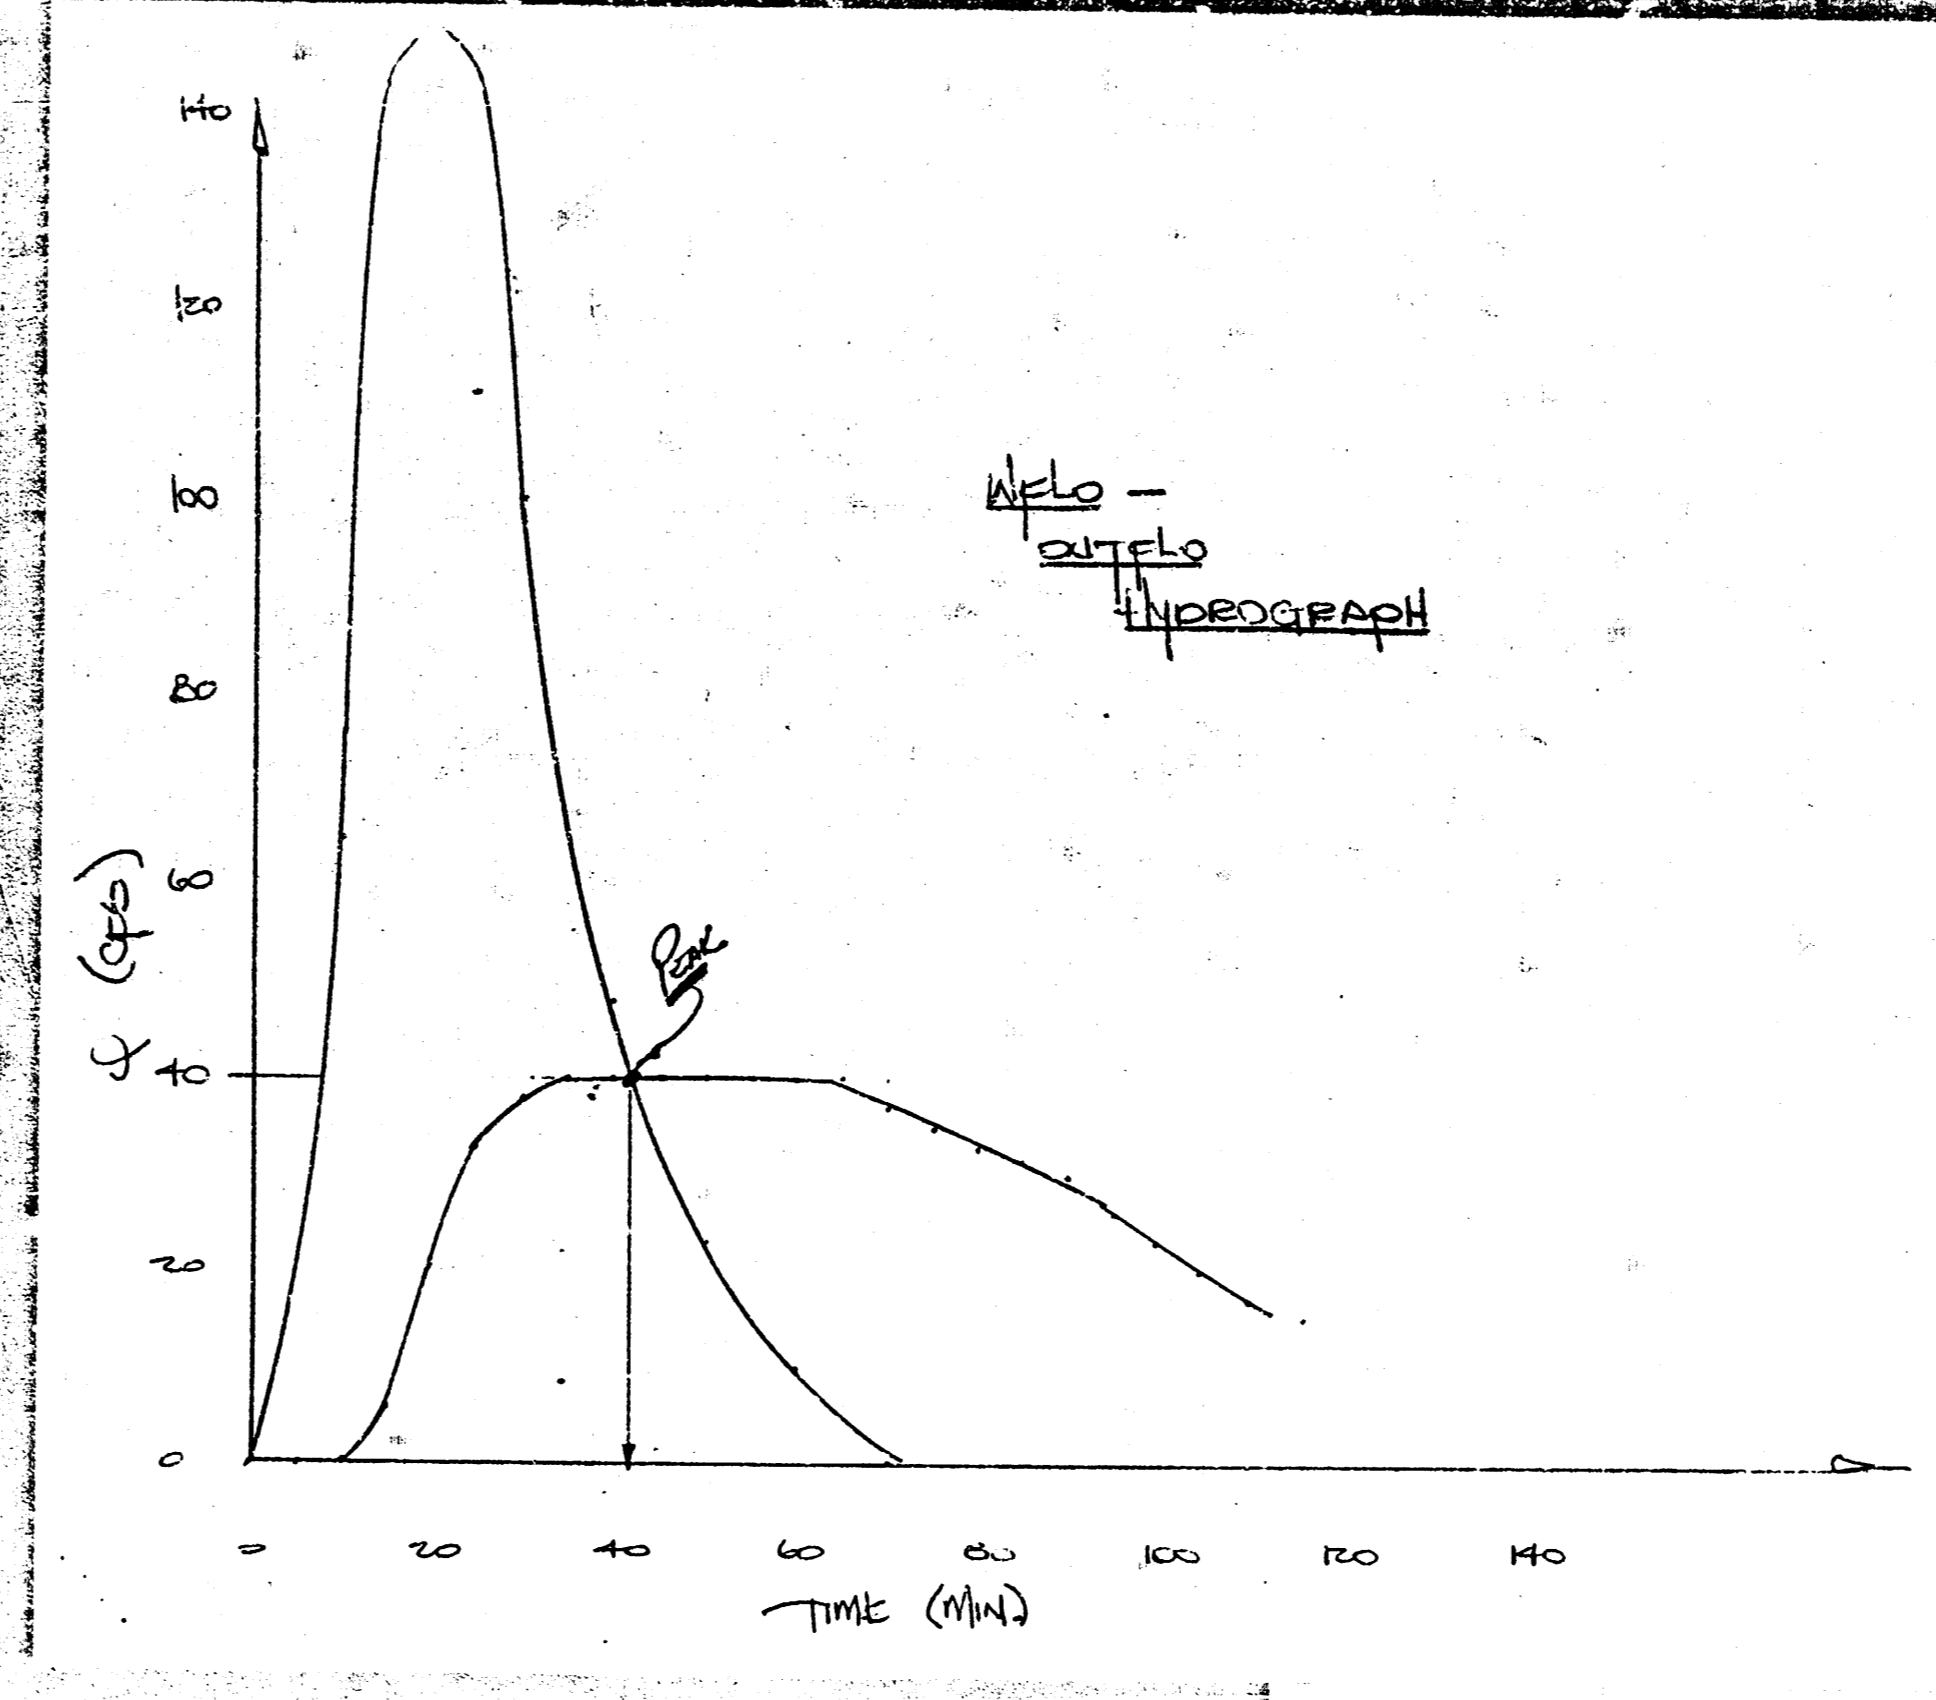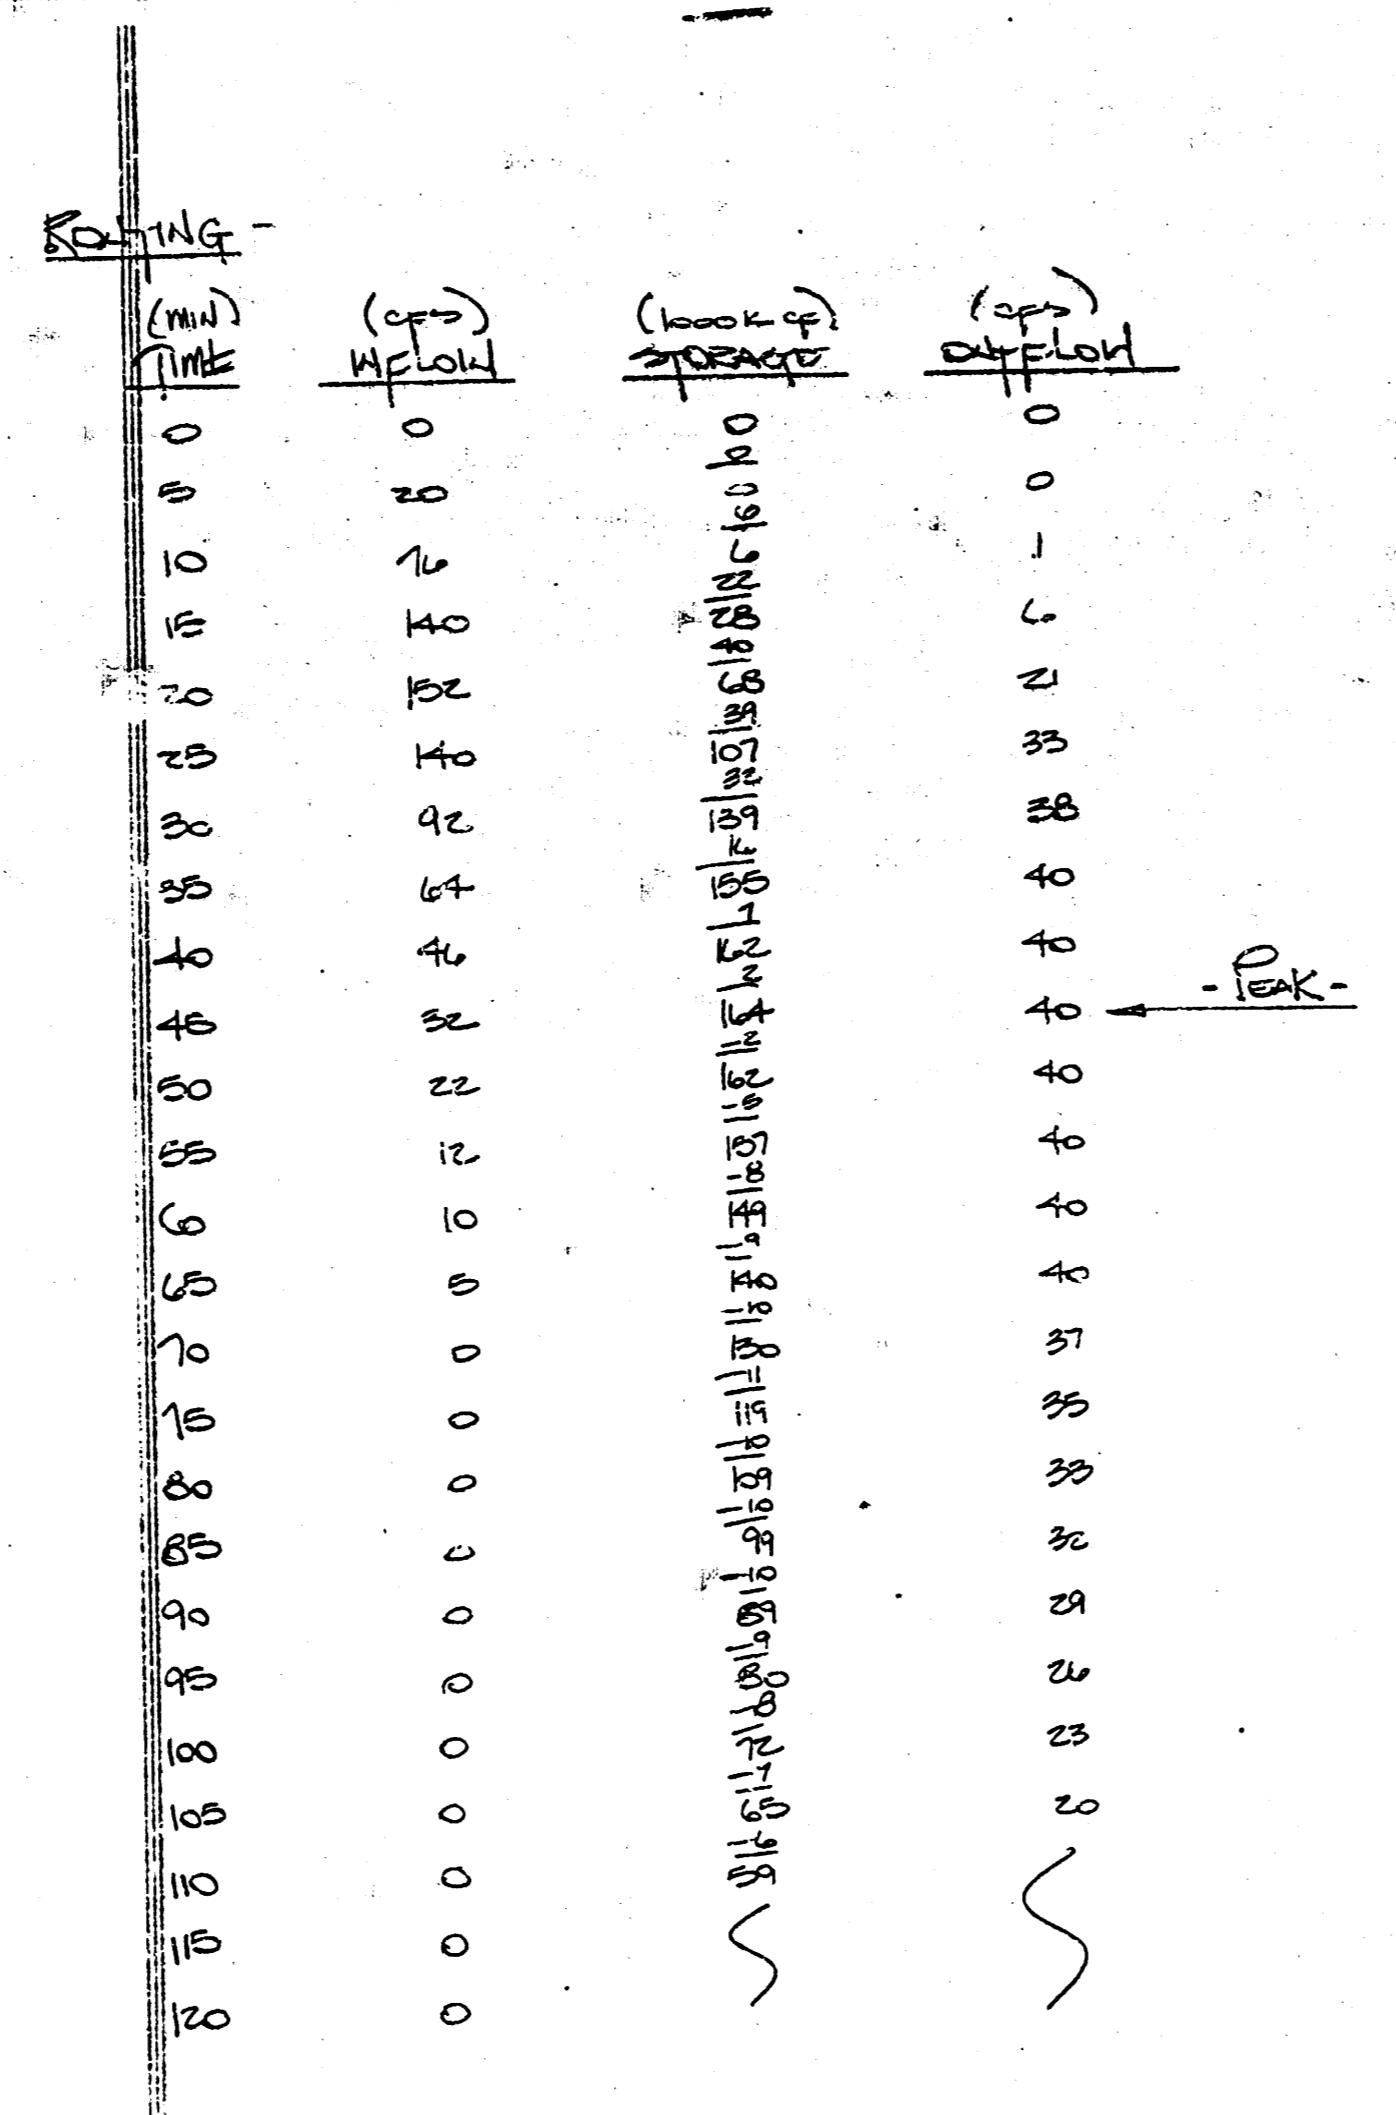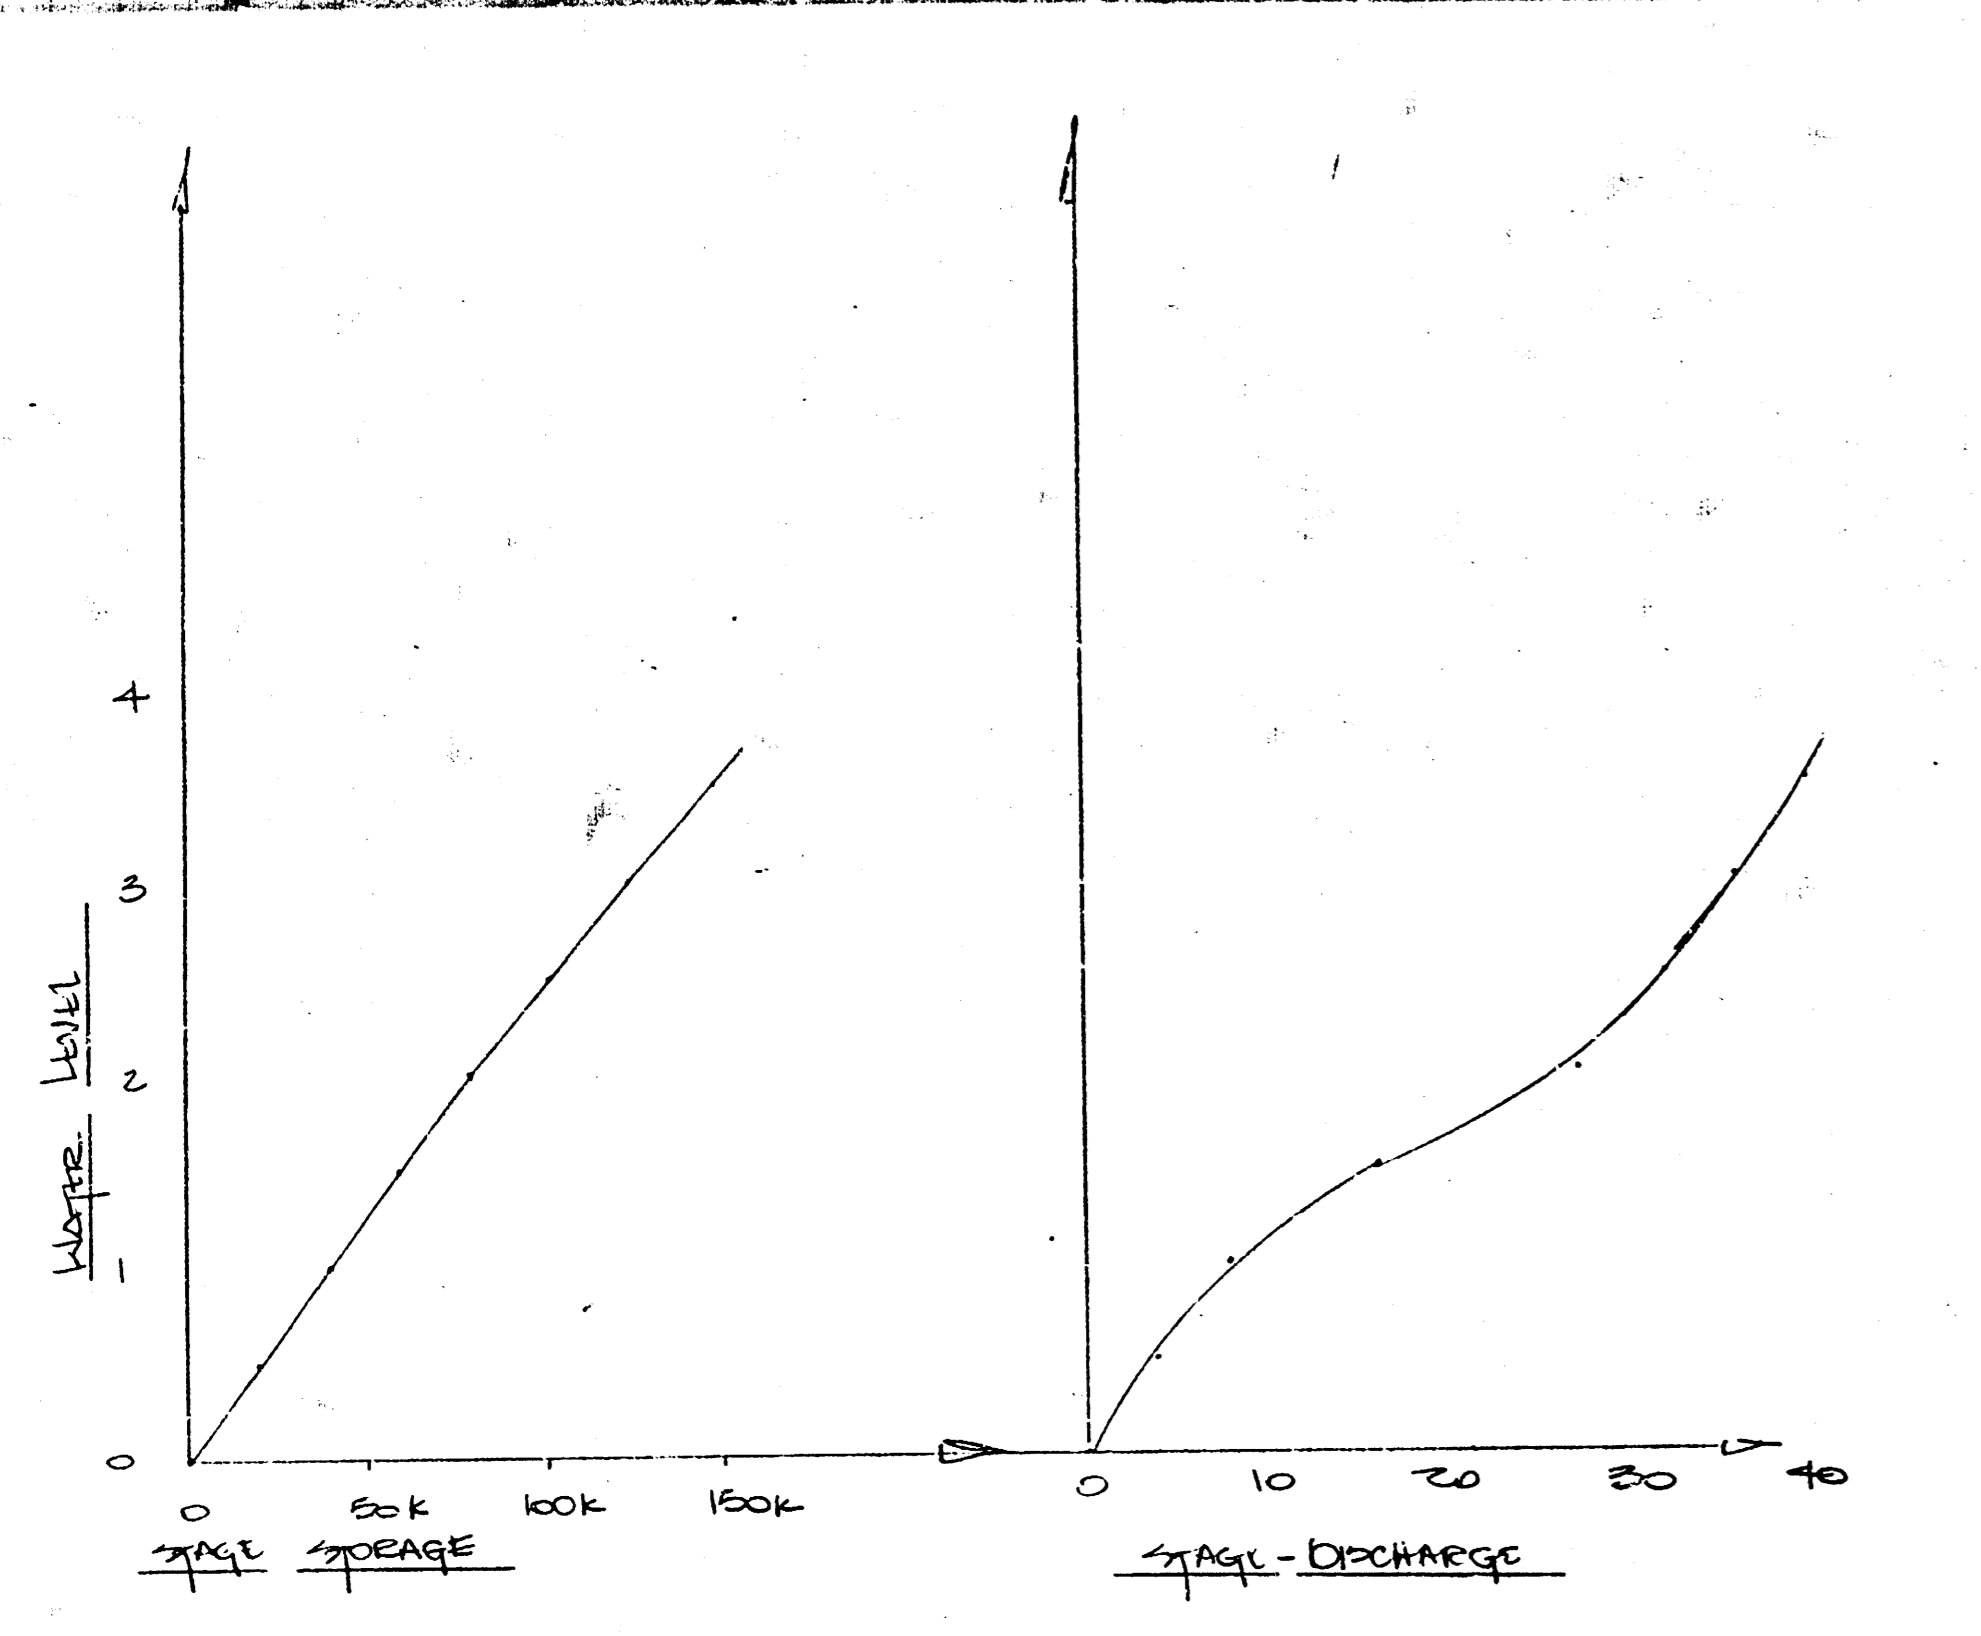


NORTHRIDGE INDUSTRIAL PARK
(DRAINAGE)

BAUGHMAN COMPANY, P.A.
SURVEYING & ENGINEERING
316/262-7771 • 330 LAURA • WICHITA, KANSAS 67211

CONFIRMATION MEMO

PROJECT Northridge Industrial Park DATE June 6, 1983
JOB NO. _____ COPIES TO _____
TO Chris Breitenstein
FROM N. Brent Wooten
REFERENCE Drainage Concept

Preliminary Plat is scheduled for Subdivision for June 9, 1983.
The plan presented is a concept only till future development plans are defined. A detention site will be located on Lot 6 as indicated. The lots will drain to this site. The calculations are shown below.
DA = 29.2 Acres
Soil type for this area is Farnum soil type. Soil group is B. 55% of the area will be industrial and 45% will be cultivated. Average runoff group = 80. For the antecedent storm moisture condition II (6" rainfall) runoff amount = 3.78 inches.
Volume of detention = (3.78/12)(29.2 Acres) = 9 AC. - FT.
Consider a pond site depth of 3 foot. Volume / 3 FT. = 3 Acre-foot surface area or approximately a 260' x 510' site.

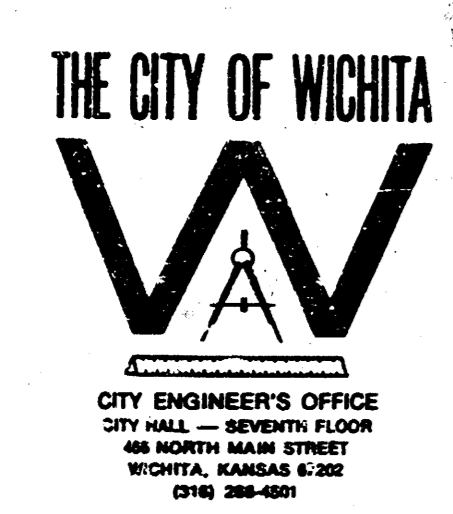

THE CITY OF WICHITA
CITY ENGINEER'S OFFICE
CITY HALL - SEVENTH FLOOR
400 NORTH MAIN STREET
WICHITA, KANSAS 67202
316/268-6201

June 14, 1988

Mr. Don Arnold, Jr.
John T. Arnold Asso.
150 N. Main, Suite 501
Wichita, KS 67202

Dear Mr. Arnold:
As per our discussion on the drainage plan for Northridge Industrial Park, the City concurs with the proposed revision on the attached drainage plan, provided that sufficient drainage easement is obtained to allow for any cross lot drainage to occur.

Sincerely,
Vicky Huang
Vicky Huang, P.E.
Subdivision Engineer

VH:sm/5148A

