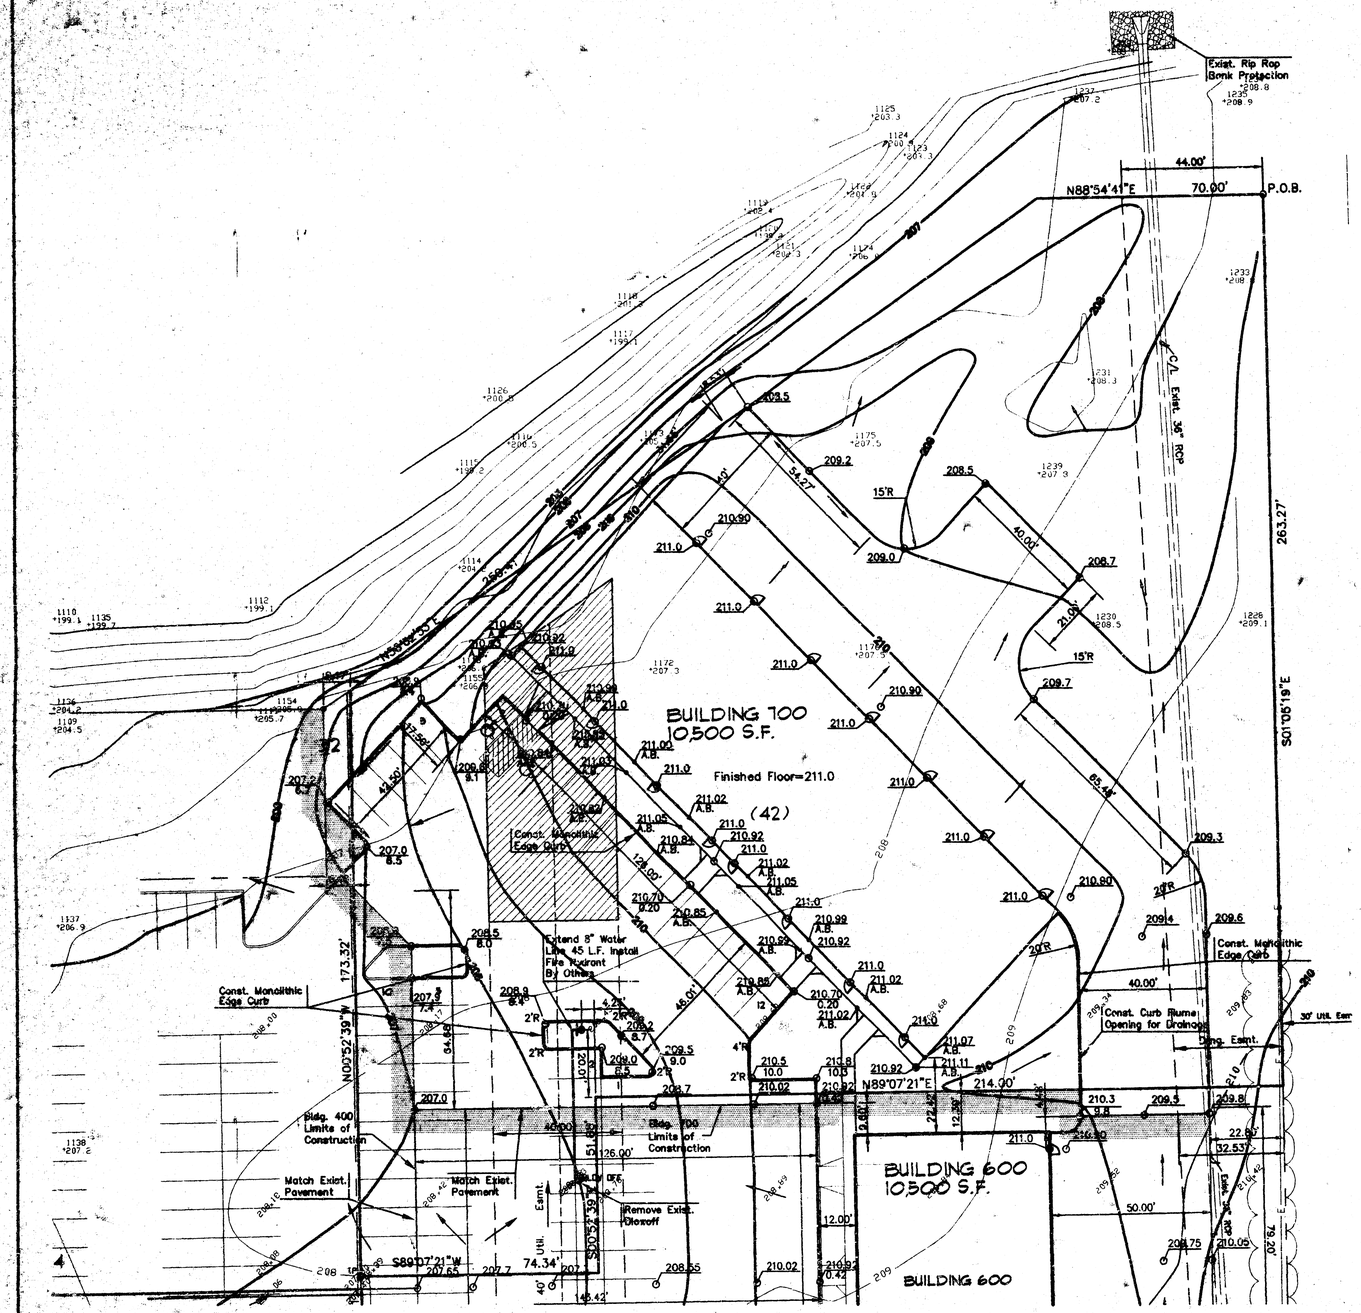

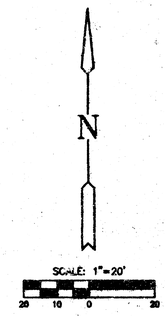

NORTHROCK BUSINESS PARK
PARCEL 600

A tract of land lying in a portion of Lot 1, Block 5, STONHEDGE, an Addition to Wichita, Sedgwick County, Kansas, more particularly described as follows:

Beginning at the Northeast corner of said Lot 1, Block 5; thence S 01° 05' 19" E, 263.27 feet along the East line of said Lot 1, Block 5; thence S 89° 07' 21" W, 214.00 feet; thence S 00° 52' 39" E, 51.88 feet; thence S 89° 07' 21" W, 74.34 feet, thence N 00° 52' 39" W, 173.32 feet, thence N 58° 02' 53" E, 259.41 feet along the North line of said Lot 1; thence N 88° 54' 41" E, 70.00 feet along the North line of said Lot 1 to the point of beginning.

Building 700 Construction Limits

Revised 9/27/96
Revised 2/8/96
Revised 2/1/96
Revised 1/16/96

MID-KANSAS ENGINEERING CONSULTANTS, INC.
411 N. WEBB ROAD
WICHITA, KS. 67206
316-684-9600

NORTHROCK BUSINESS PARK
PROJECT NAME

SITE GRADING BUILDING 700
SHEET TITLE

GJA	FAF	GJA
DESIGN BY:	DRAWN BY:	CHECKED BY:
OCTOBER 1995	GRADING:	1 / 8
DATE	JOB NO.	SUBSECTION