


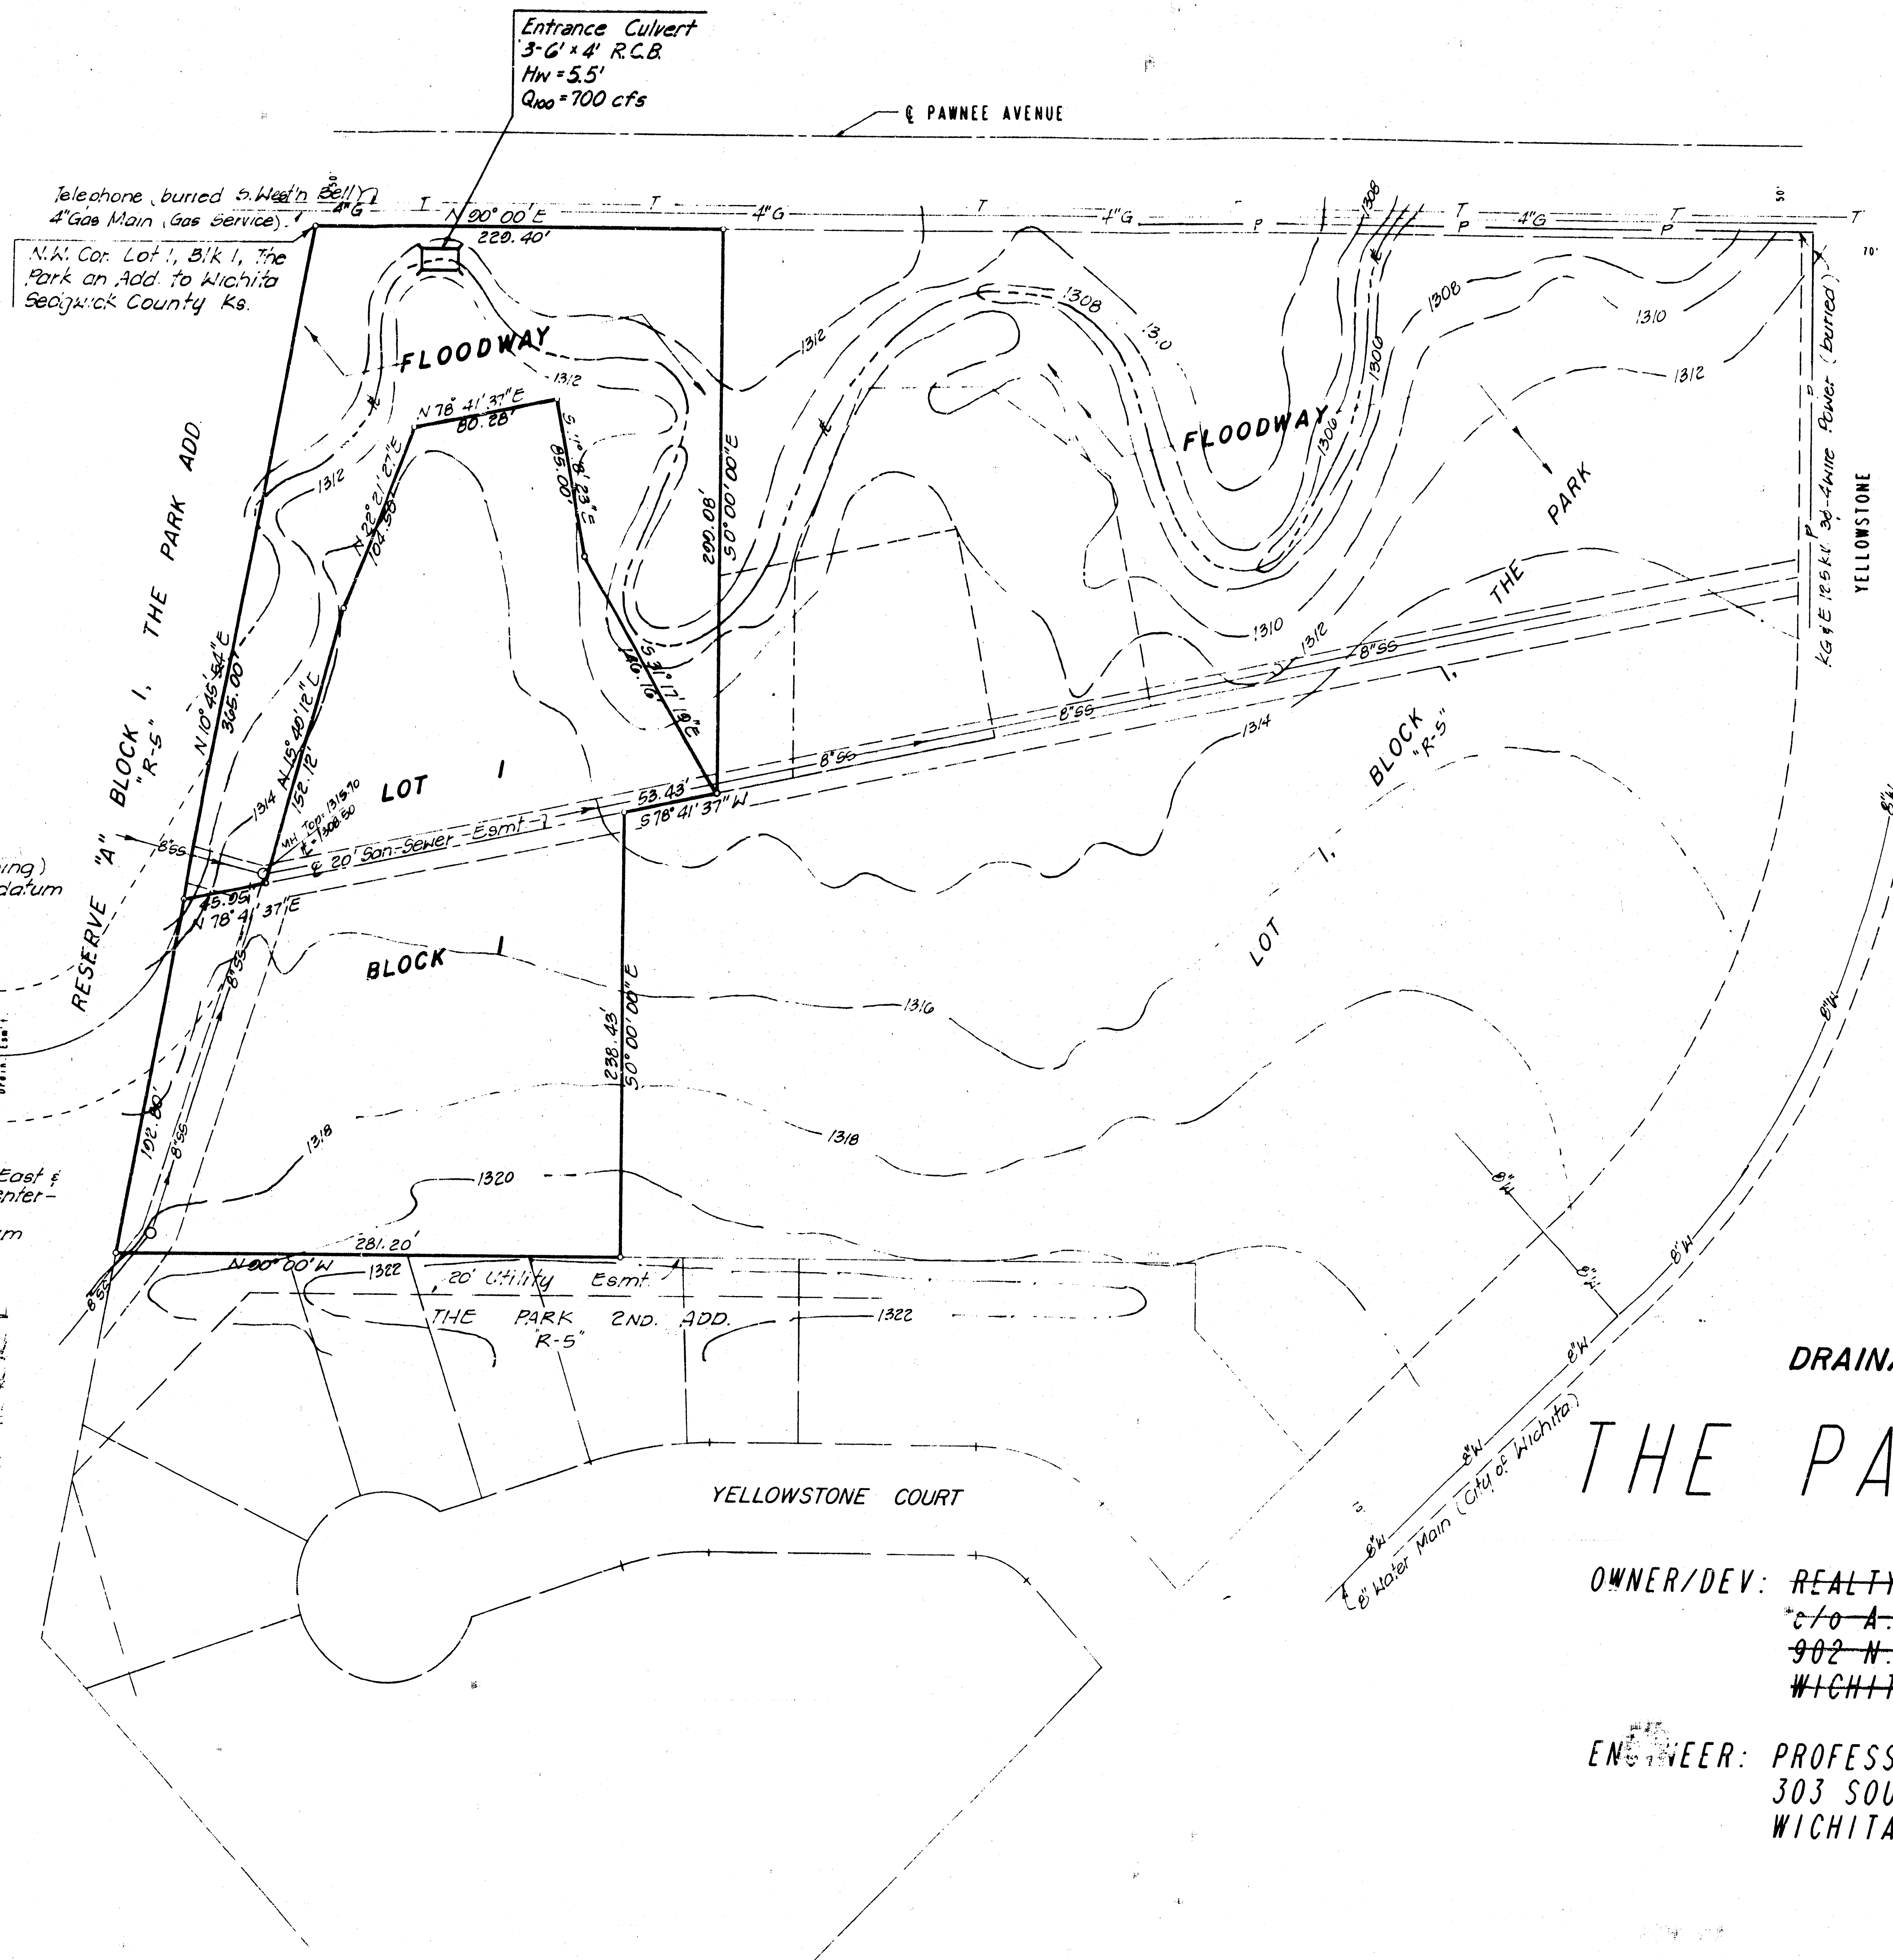

DRAINAGE PLAN

THE PARK CHATEAU

OWNER/DEV: REALTY ONE CORP.
c/o A. J. SOERRIES
902 N. WEST STREET
WICHITA, KS 67203

MARK A. CHAPPELLE
500 S. HOLLAND
STE. 512
WICHITA, KS. 67207

ENGINEER: PROFESSIONAL ENGINEERING CONSULTANTS, P.A.
303 SOUTH TOPEKA
WICHITA, KS. 67202

