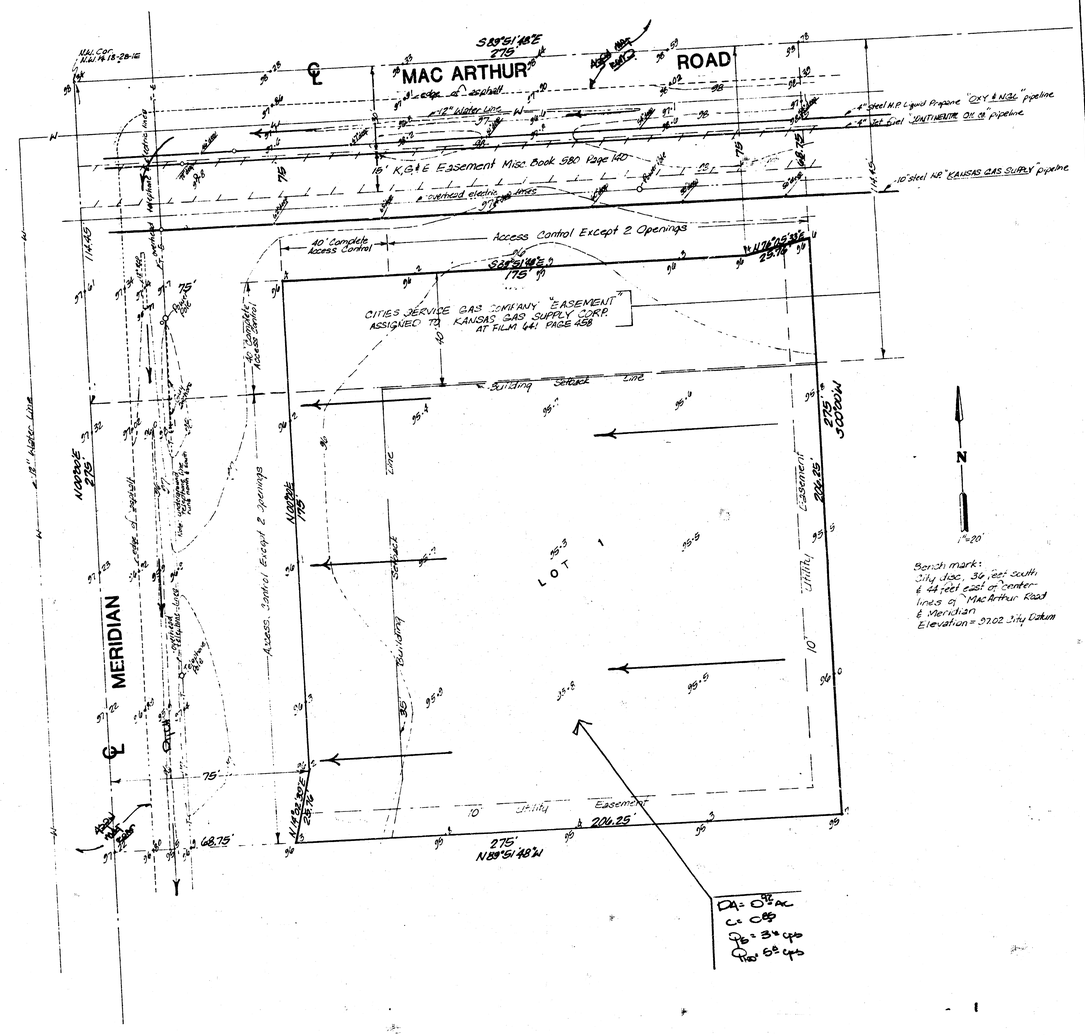

SKETCH PLAT

QUIKTRIP 1ST ADDITION

The west 275 feet of the north 275 feet of the Northwest Quarter of the Northwest Quarter of the Northwest Quarter of Section 18, Township 28 South, Range 1 East of the Sixth Principal Meridian, Sedgwick County, Kansas.

OWNER: QUIKTRIP CORP

DRAINAGE PLAN

BAUGHMAN COMPANY, P.A.
SURVEYING & ENGINEERING
316 262-1271 • 315 ELLIS • WICHITA, KANSAS 67211