

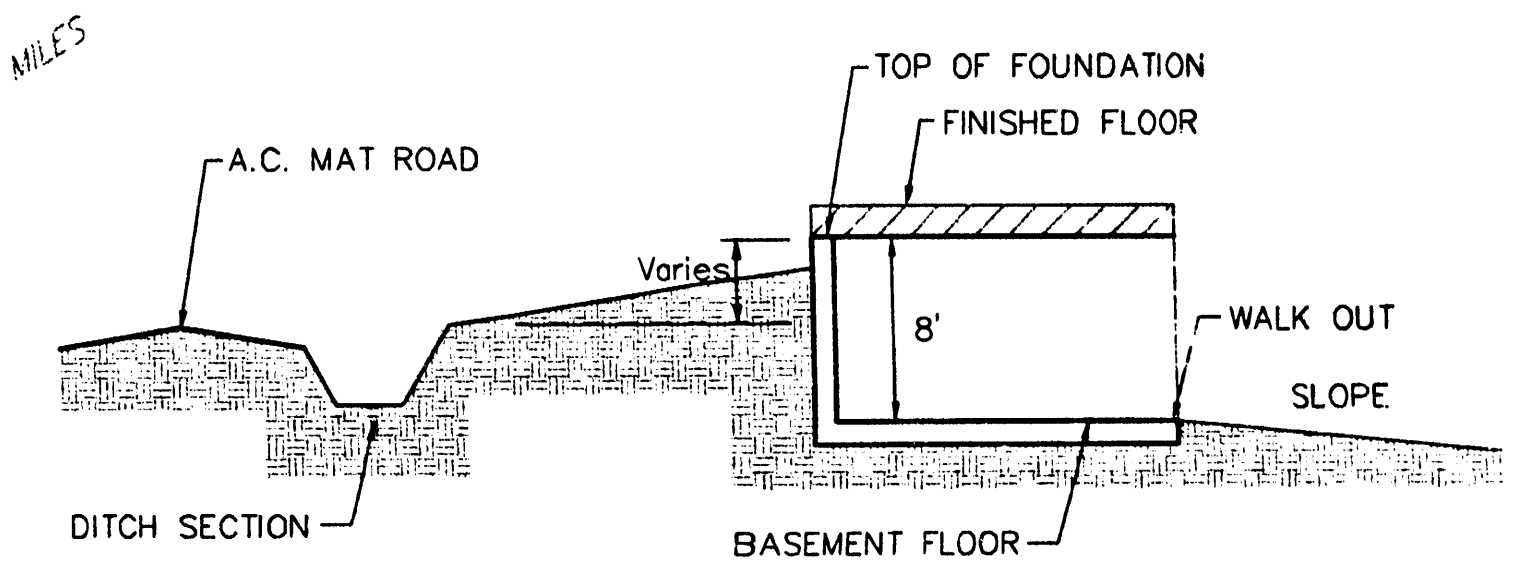


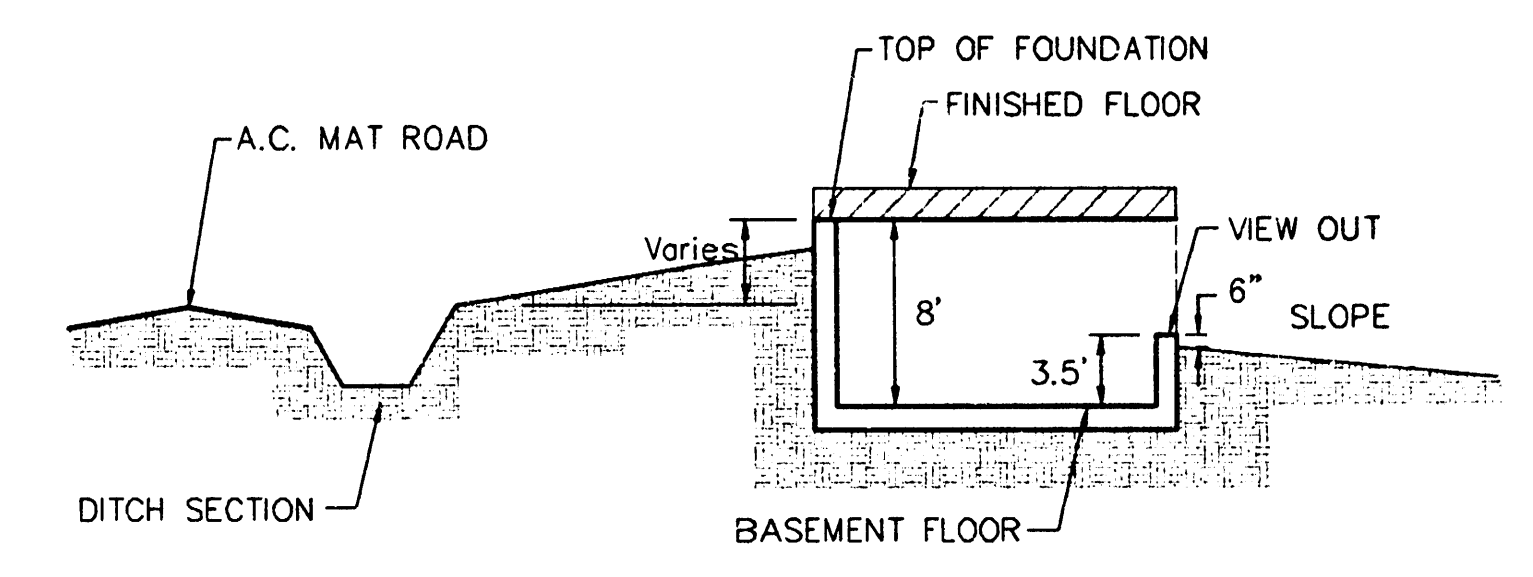

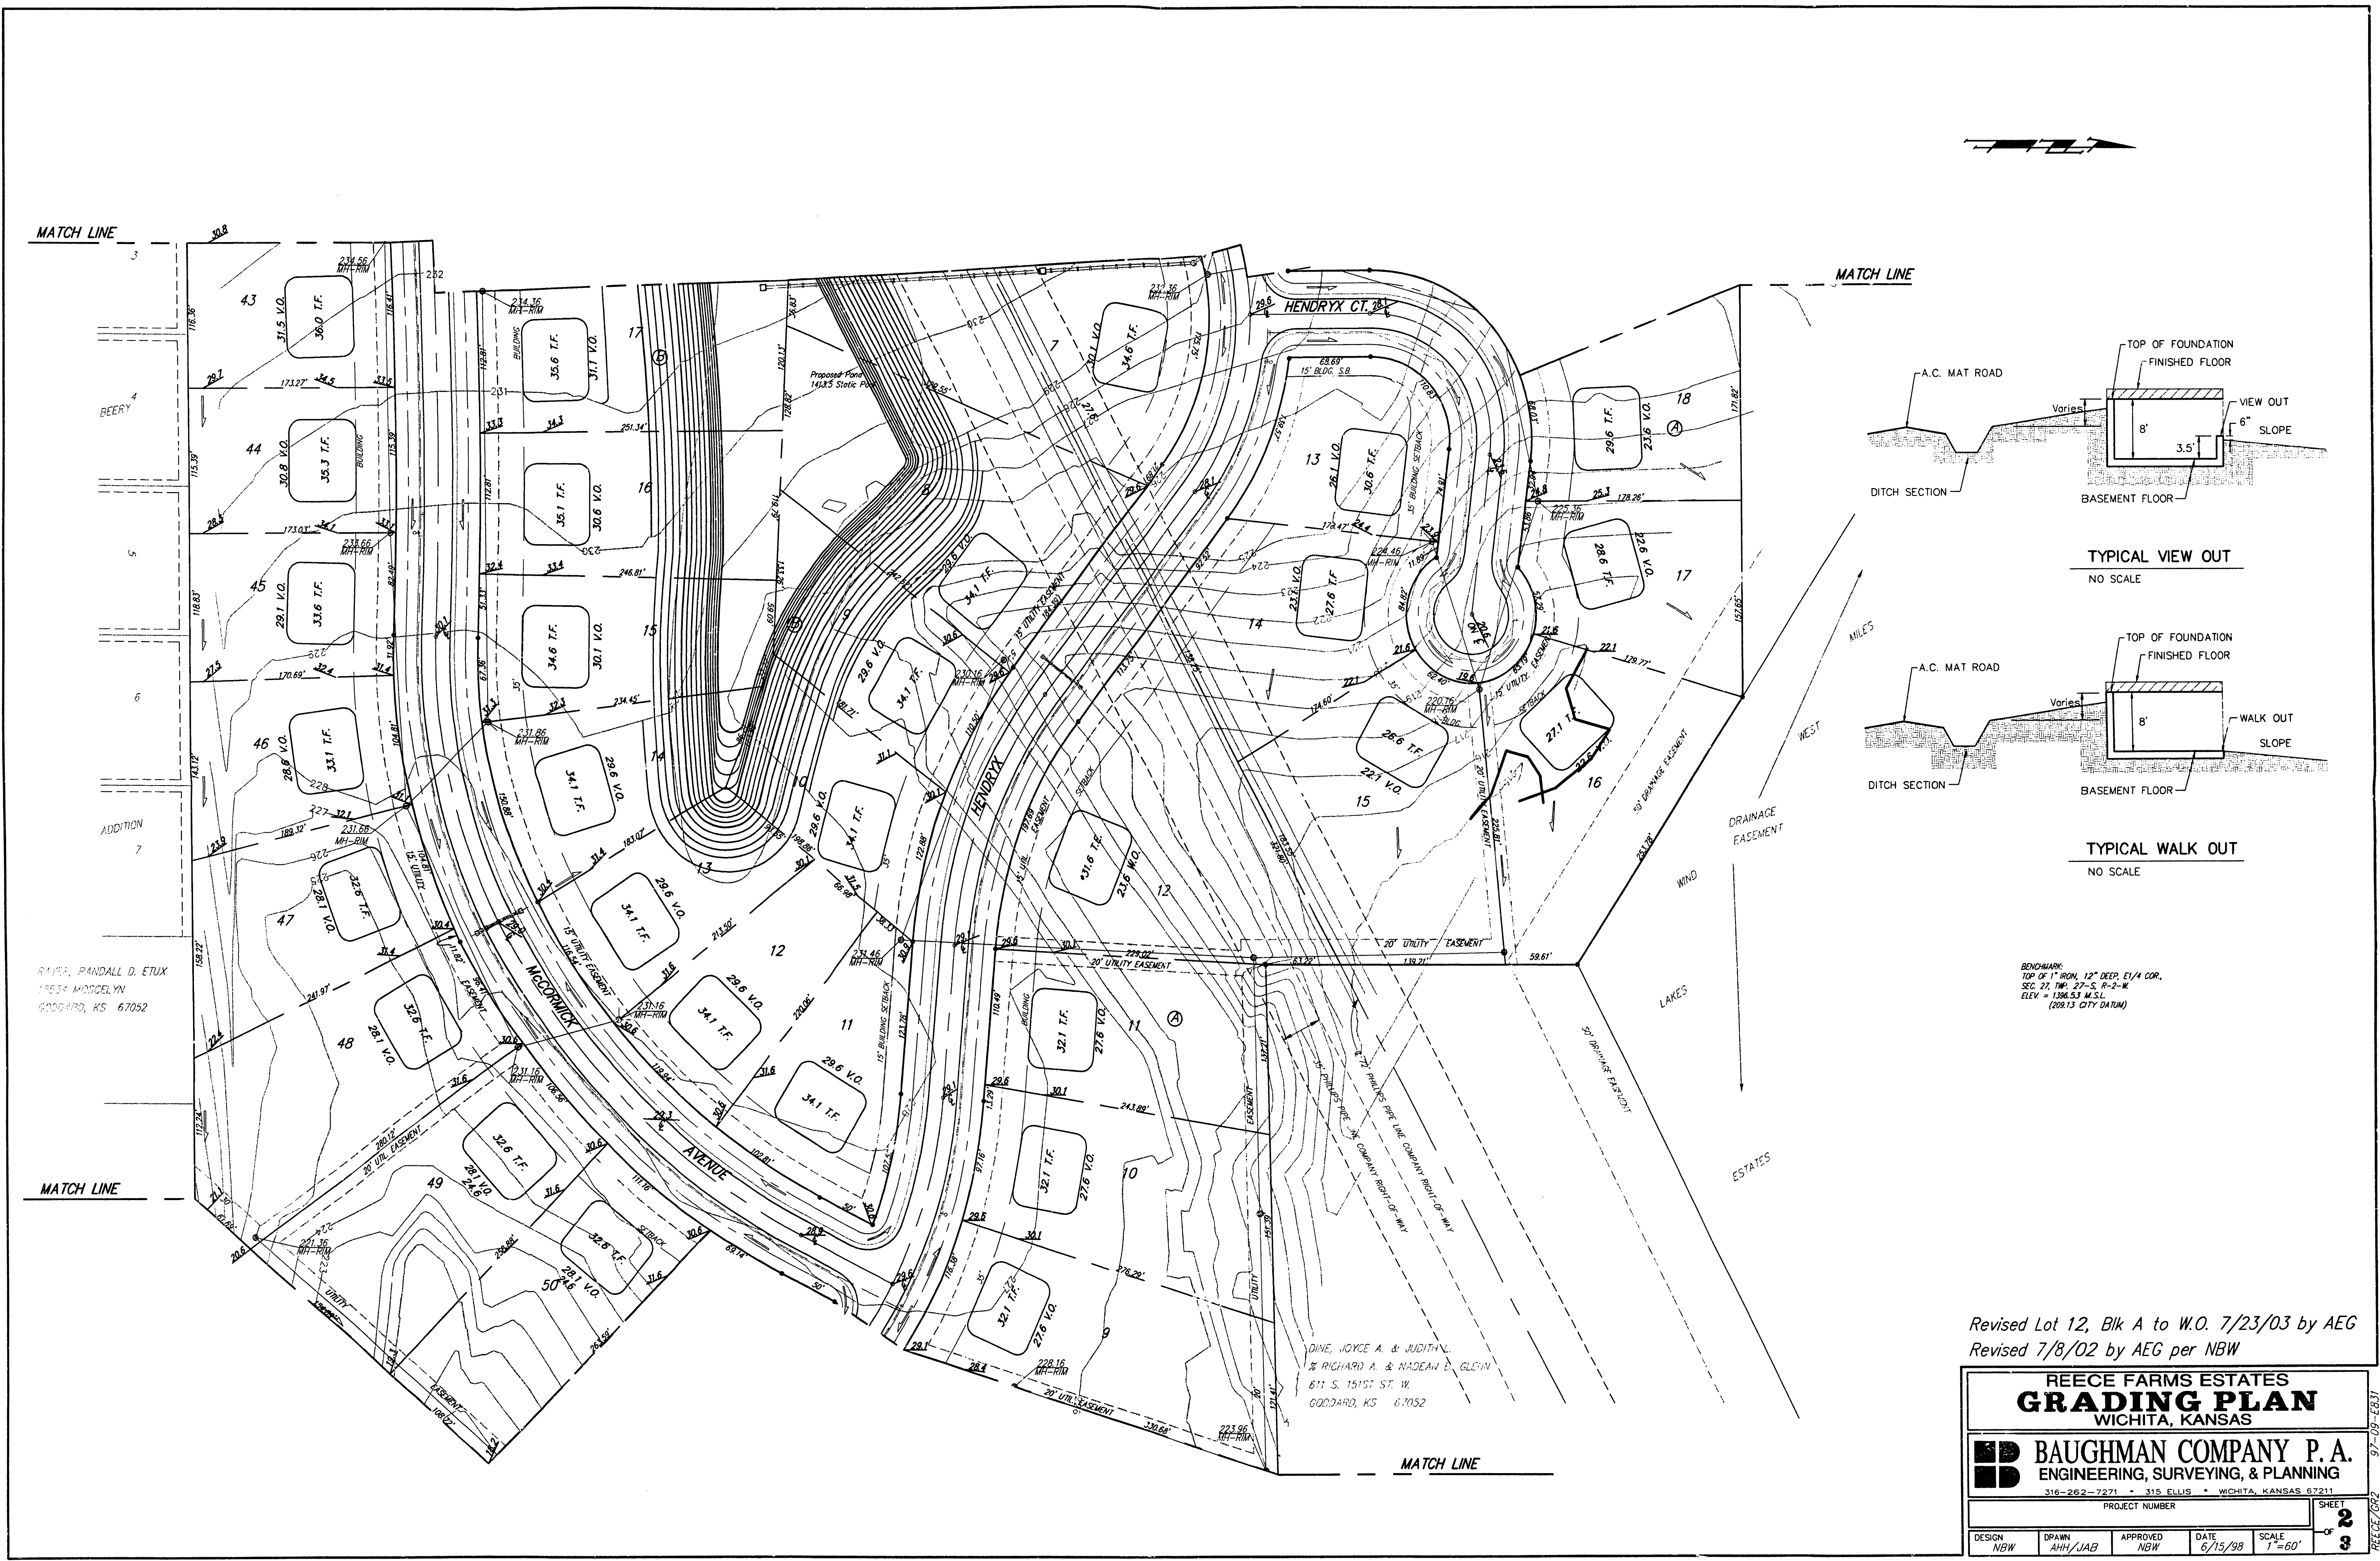

BENCHMARK:
TOP OF 1" IRON, 12" DEEP, E1/4 COR.,
SEC. 27, T1N, 27S, R-2-W
ELEV. = 1285.53 M.S.L.
(200.13 CITY DATUM)

Revised Lot 12, Blk A to W.O. 7/23/03 by AEG
Revised 7/8/02 by AEG per NBW

REECE FARMS ESTATES
GRADING PLAN
WICHITA, KANSAS

BAUGHMAN COMPANY P. A.
ENGINEERING, SURVEYING, & PLANNING
316-262-7271 • 315 ELLIS • WICHITA, KANSAS 67211


DESIGN NBW	DRAWN AHU/JAB	APPROVED NBW	DATE 6/15/98	SCALE 1"=60'
---------------	------------------	-----------------	-----------------	-----------------


SHEET 2 OF 3

REECE FARMS ESTATES 97-09-0333

MATCH LINE

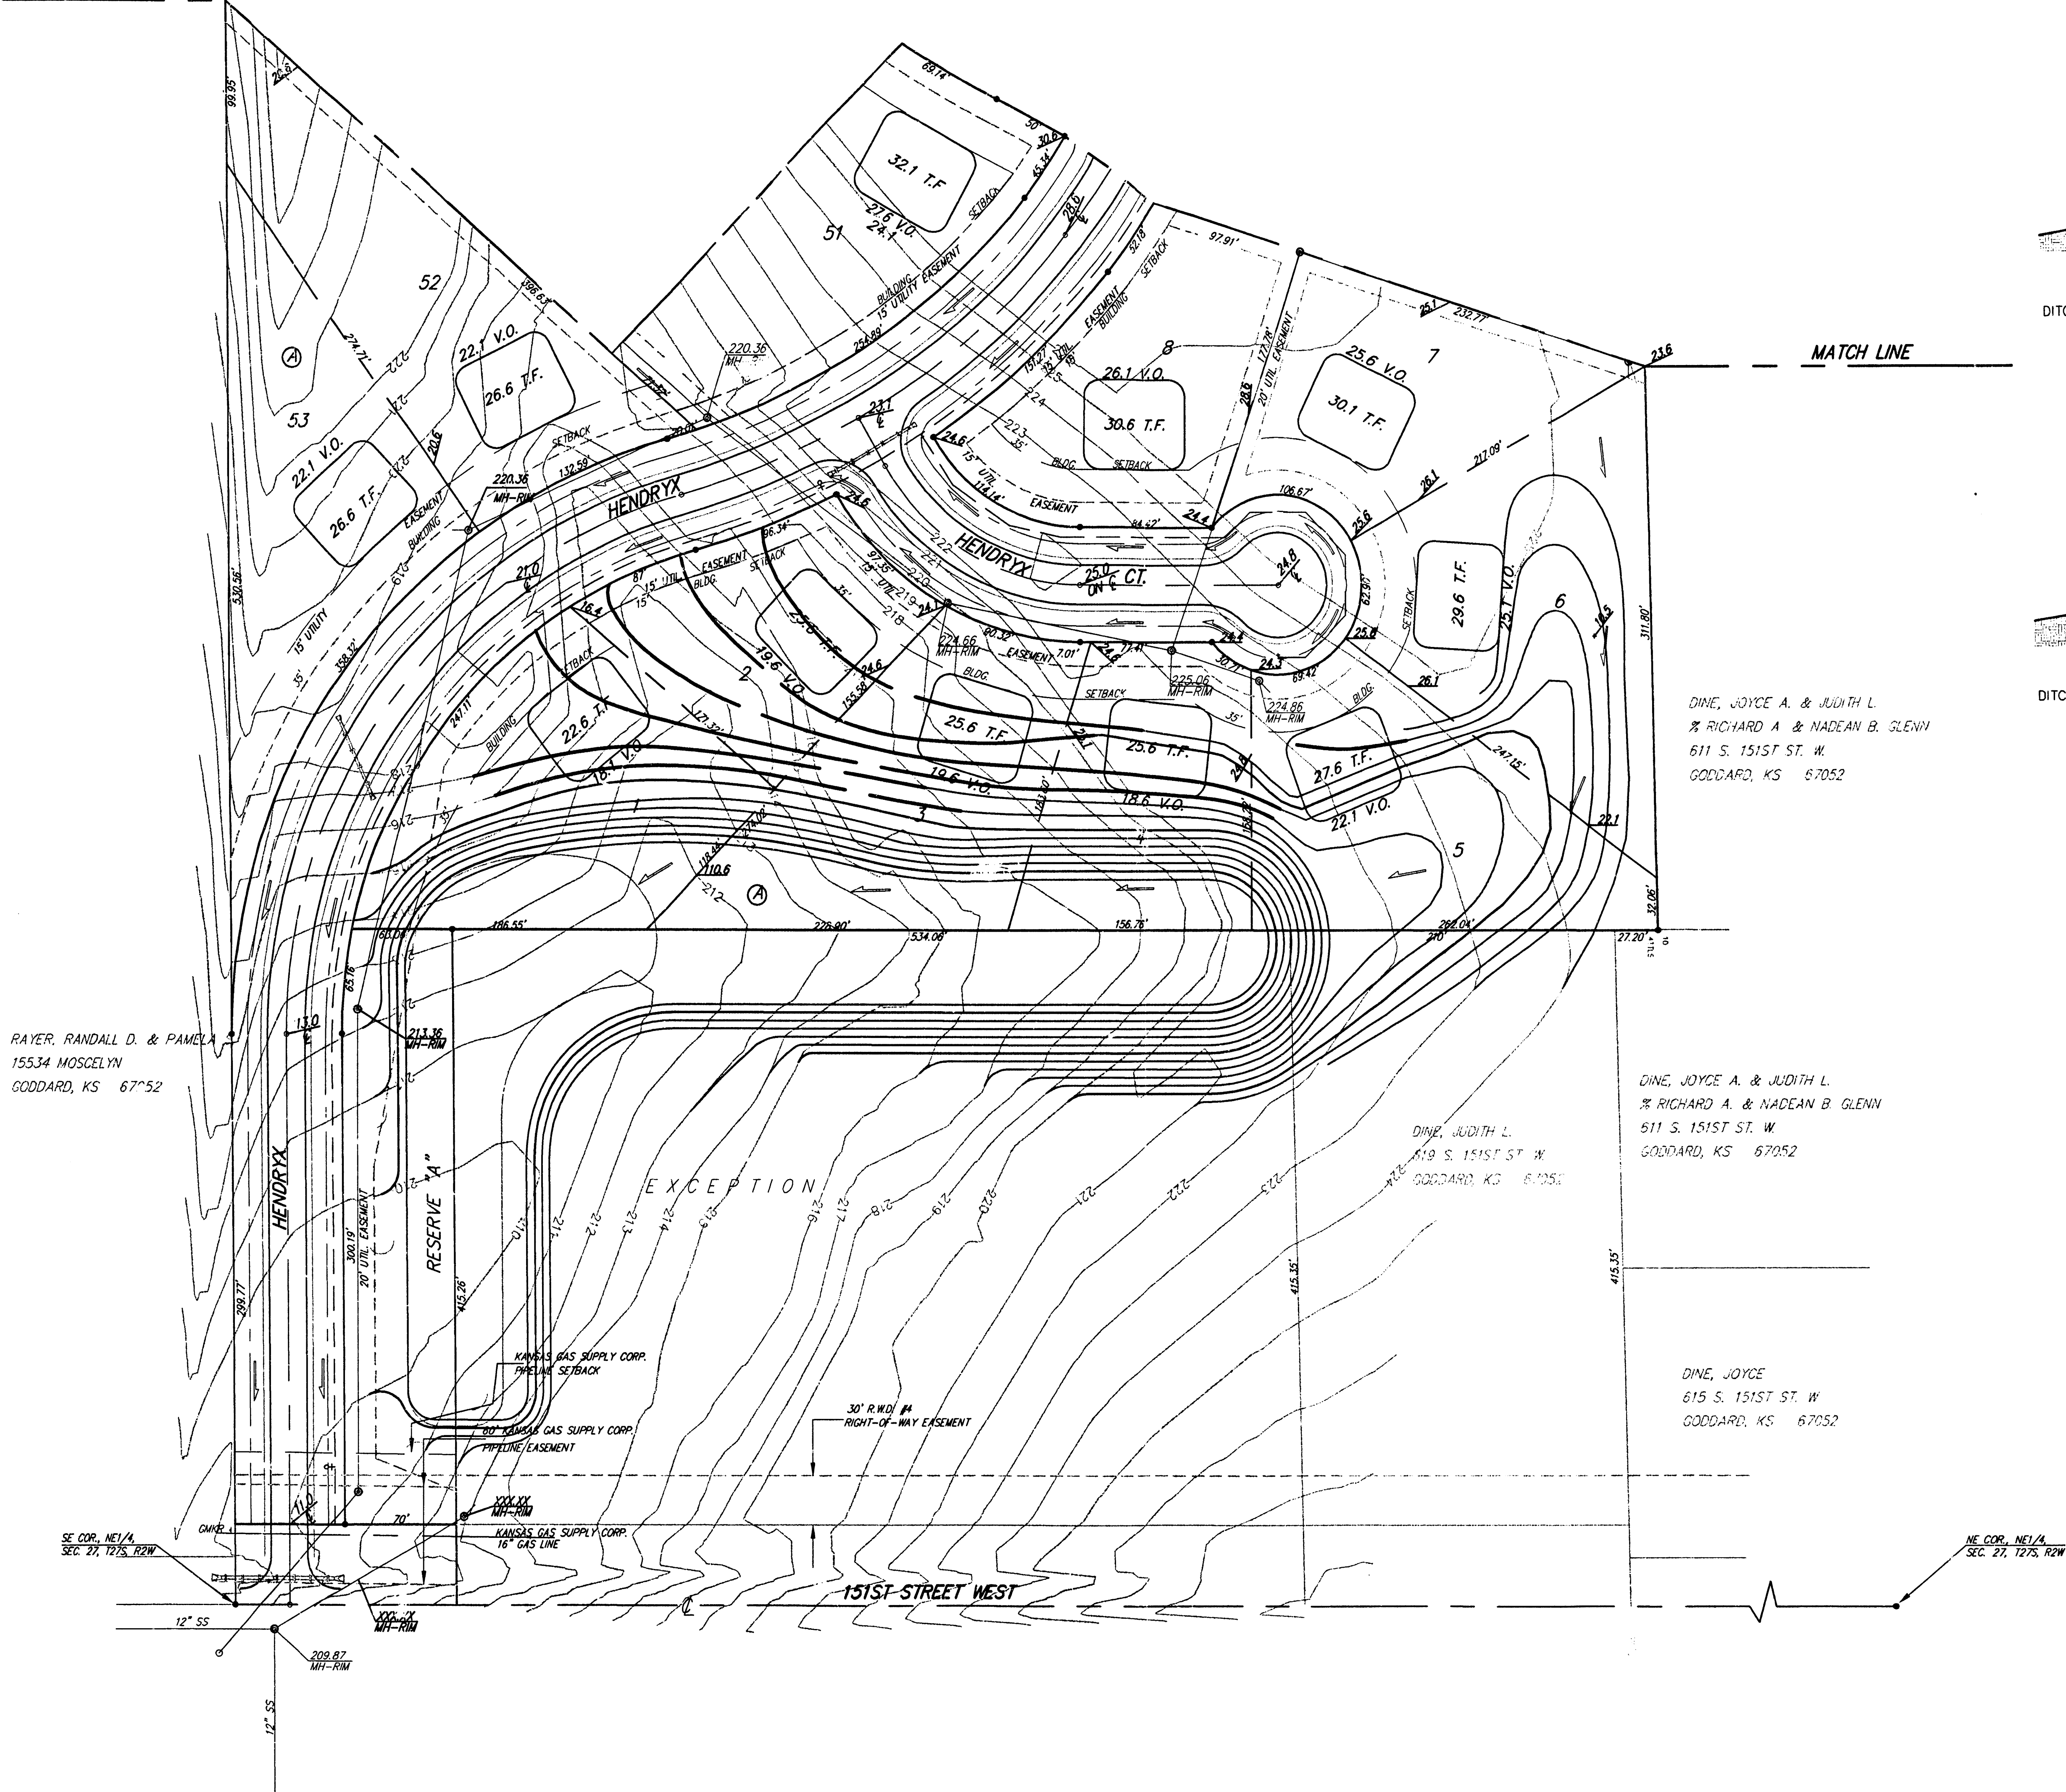


RAYE, RANDALL D. & PAMELA
15534 MOSCERYN
GODDARD, KS 67052


DINE, JUDITH L.
619 S. 151ST ST. W
GODDARD, KS 67052

DINE, JOYCE A. & JUDITH L.
RICHARD A. & NADAN B. GLENN
611 S. 151ST ST. W
GODDARD, KS 67052

DINE, JOYCE
615 S. 151ST ST. W
GODDARD, KS 67052

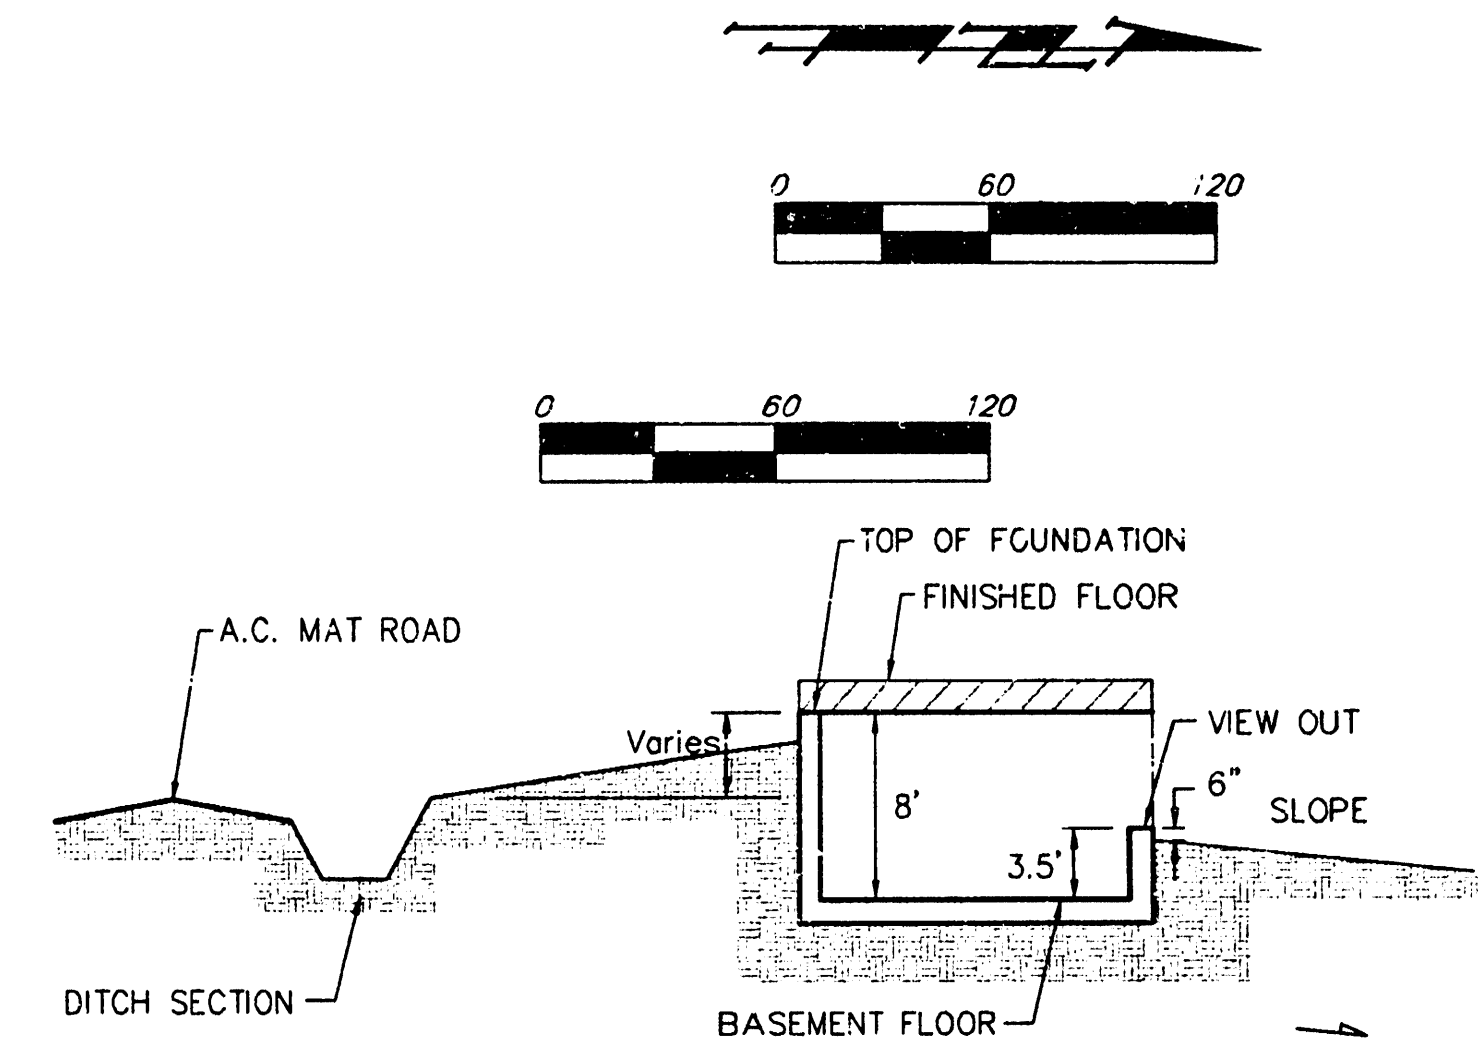

TYPICAL VIEW OUT
NO SCALE

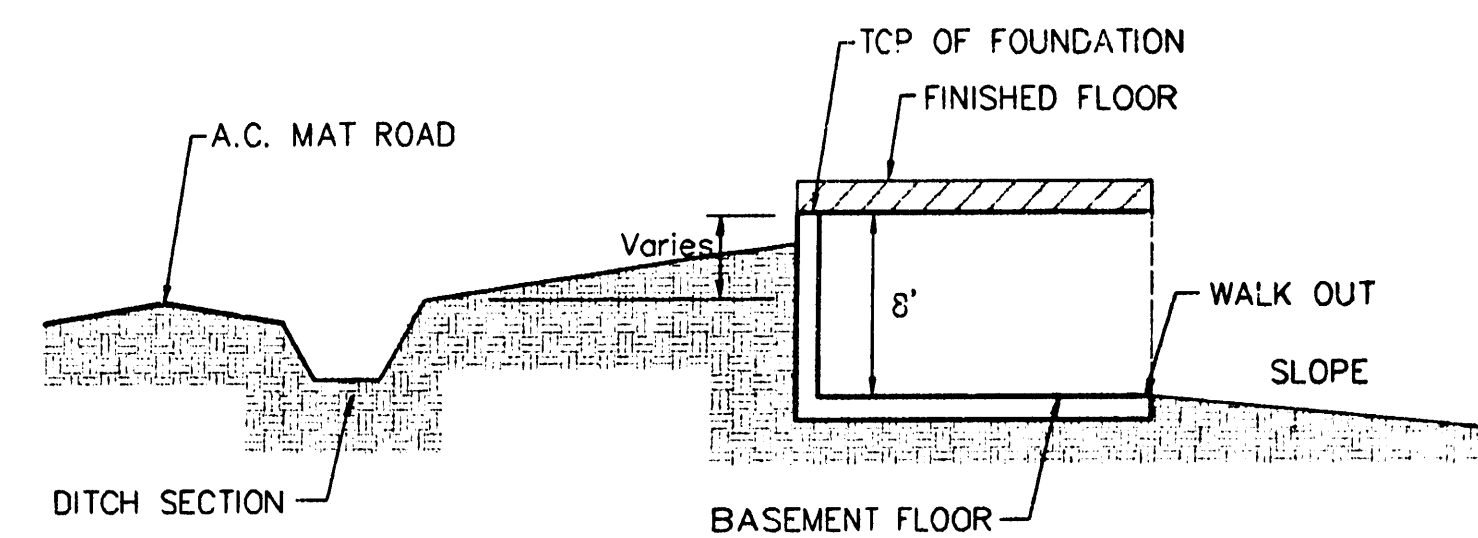

TYPICAL WALK OUT
NO SCALE

BENCHMARK:
TOP OF 1" IRON, 12" DEEP 1/4 COR.
SEC. 27, TWP. 27-S, R-2-W
ELEV. = 1206.51 M.S.L.
(2001.5 CITY DATUM)

MINIMUM BUILDING PAD ELEVATION FOR LOWEST OPENING TO THE STRUCTURES			
LOT	BLOCK	ELEVATION	
		CITY DATUM	MSL
1-22	B	228.6	1416
19-28	A	223.6	1411
1,3,4,5	A	222.6	1410

REECE FARMS ESTATES
GRADING PLAN
WICHITA, KANSAS

BAUGHMAN COMPANY P. A.
ENGINEERING, SURVEYING, & PLANNING
316-262-7271 • 315 ELLIS • WICHITA, KANSAS 67211

DESIGN NBW	DRAWN AHJ/JAB	APPROVED NBW	DATE 6/15/98	SCALE 1"=60'	PROJECT NUMBER	SHEET 3 OF 3
---------------	------------------	-----------------	-----------------	-----------------	----------------	-----------------------

97-09-E831
REECE (08)