


REPROCO 2ND ADDITION
(Drainage)

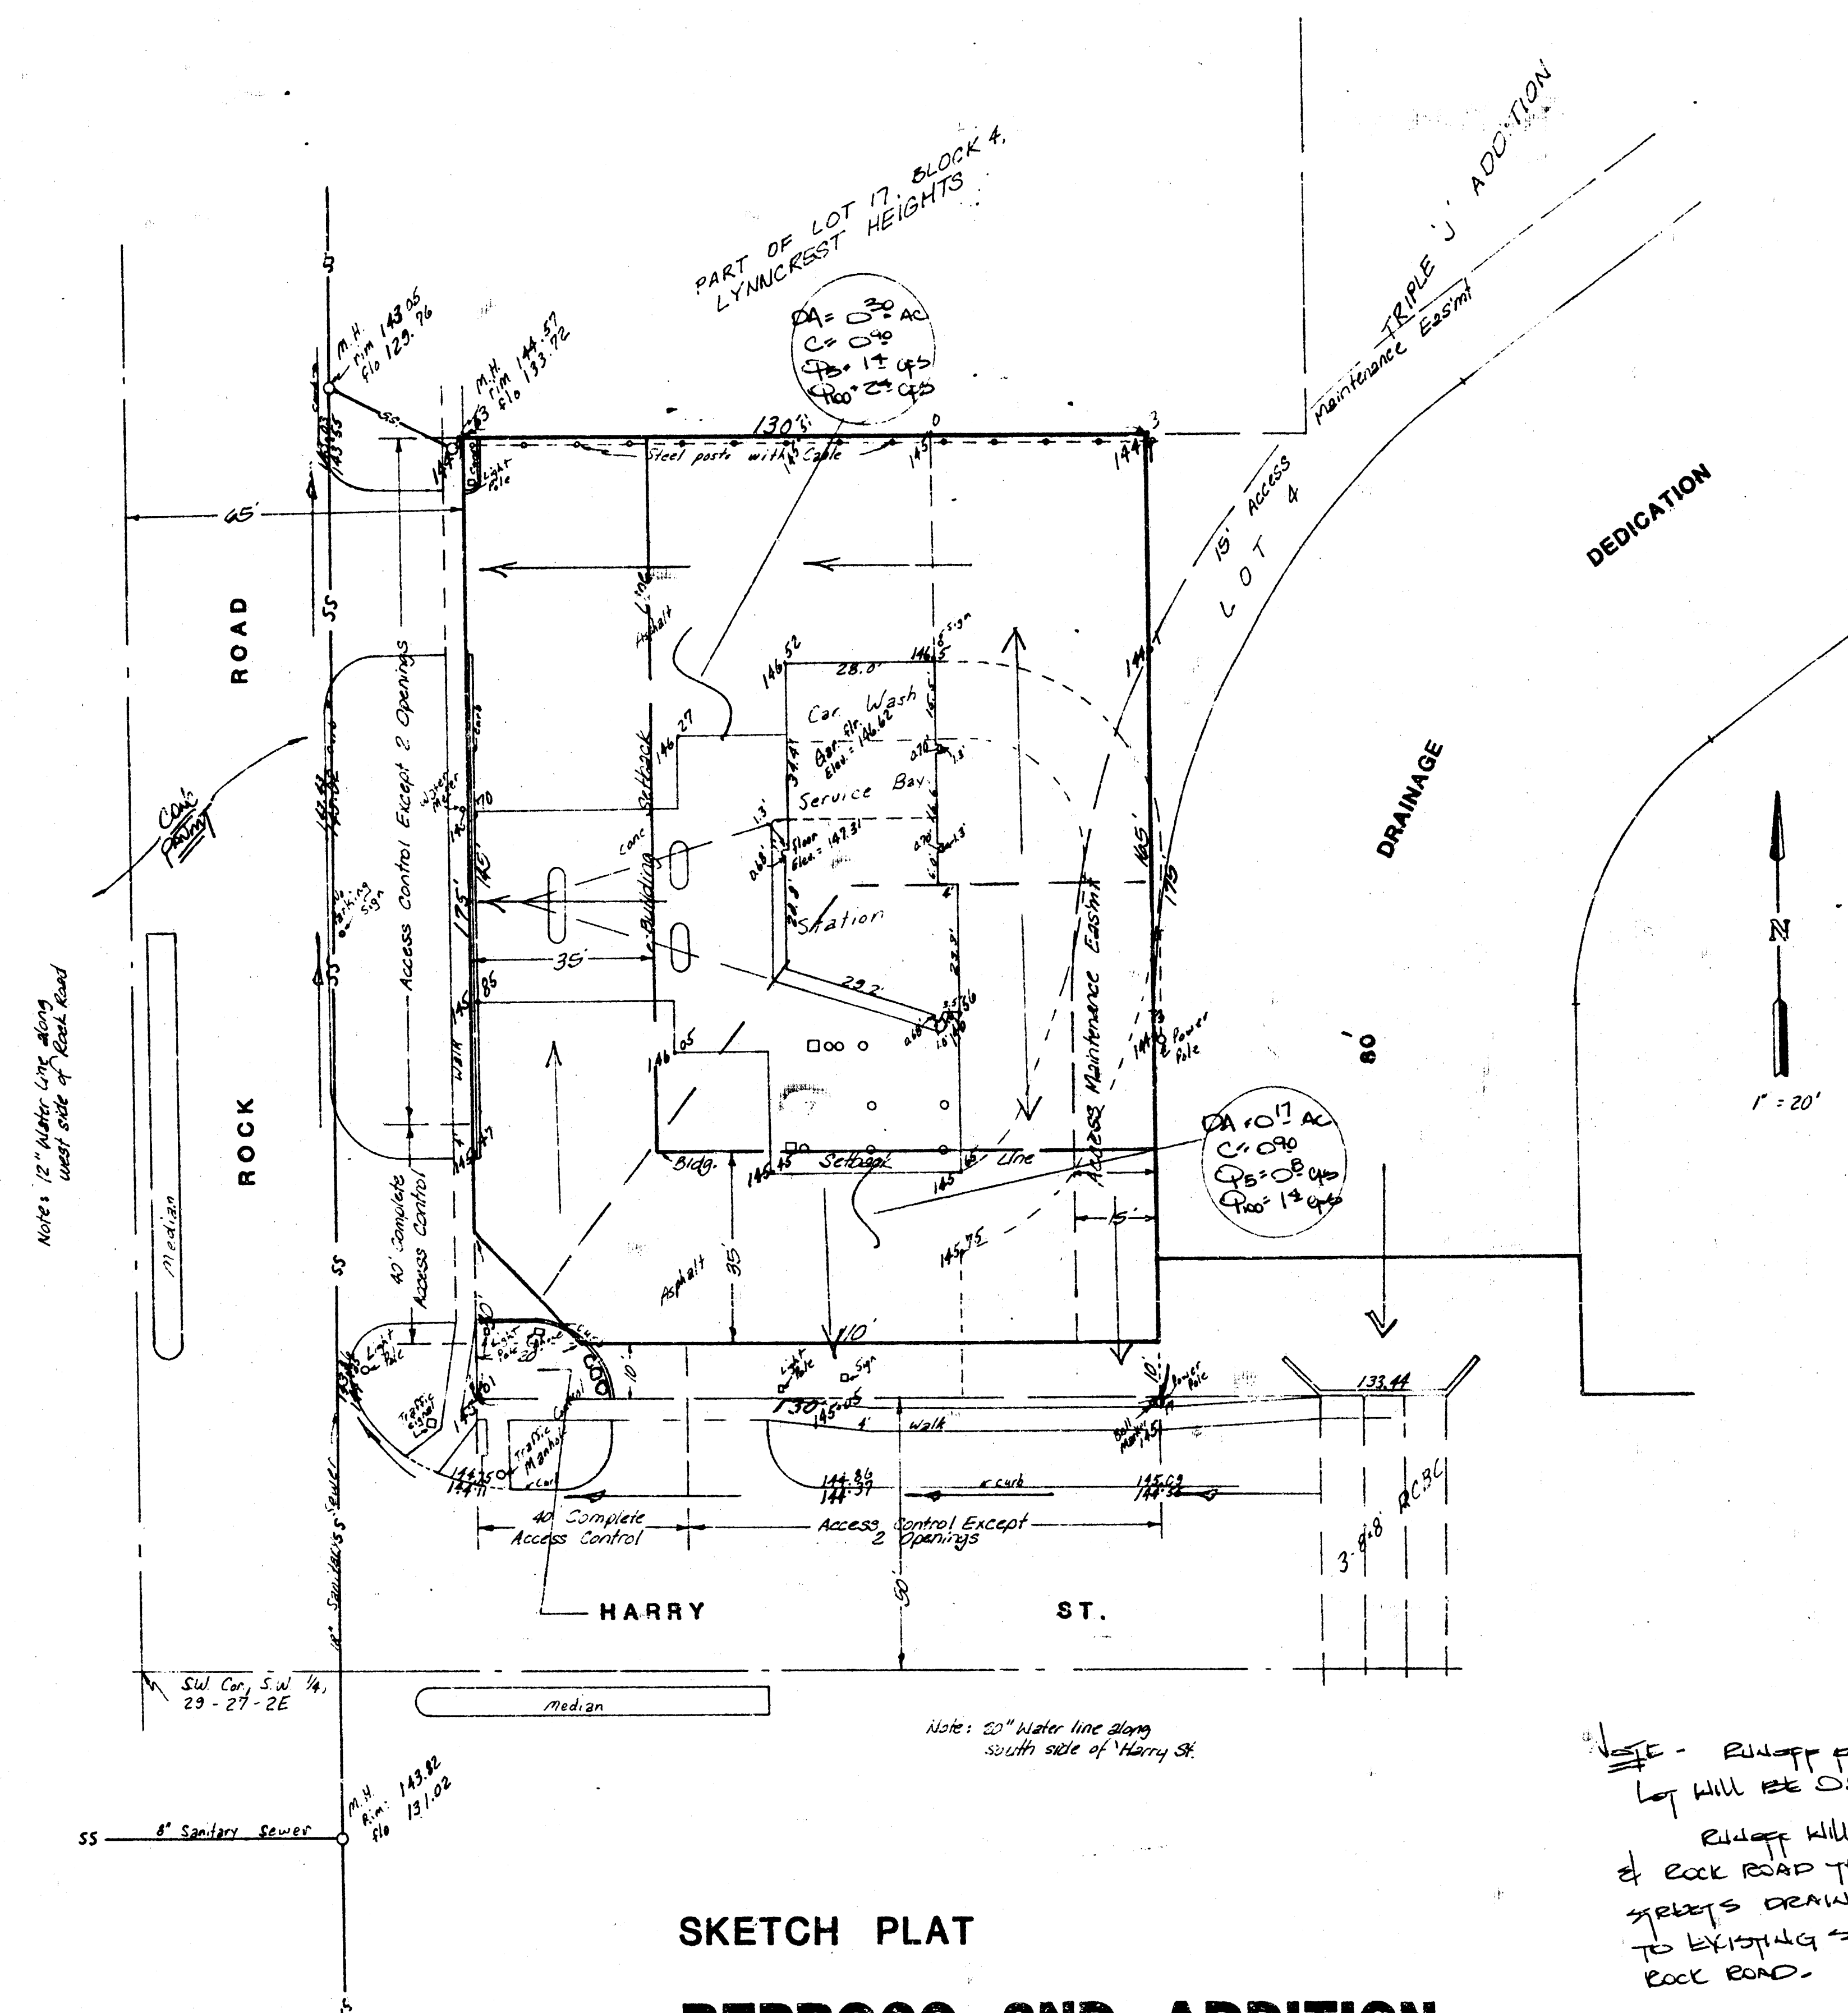

SKETCH PLAT

REPROCO 2ND ADDITION

Part of Lot 17, Block 4, Lyncrest Heights
Addition, Wichita, Kansas.

OWNER: REPROCO INC.
A DELAWARE CORPORATION.

FINAL DRAINAGE PLAN

elld.

TO EXISTING STORM SEWERS IN
ROCK ROAD.

4/20/84
BAUGHMAN COMPANY, P.A.
SURVEYING & ENGINEERING
316/262-7271 • 320 LAURA • WICHITA, KANSAS 67201