
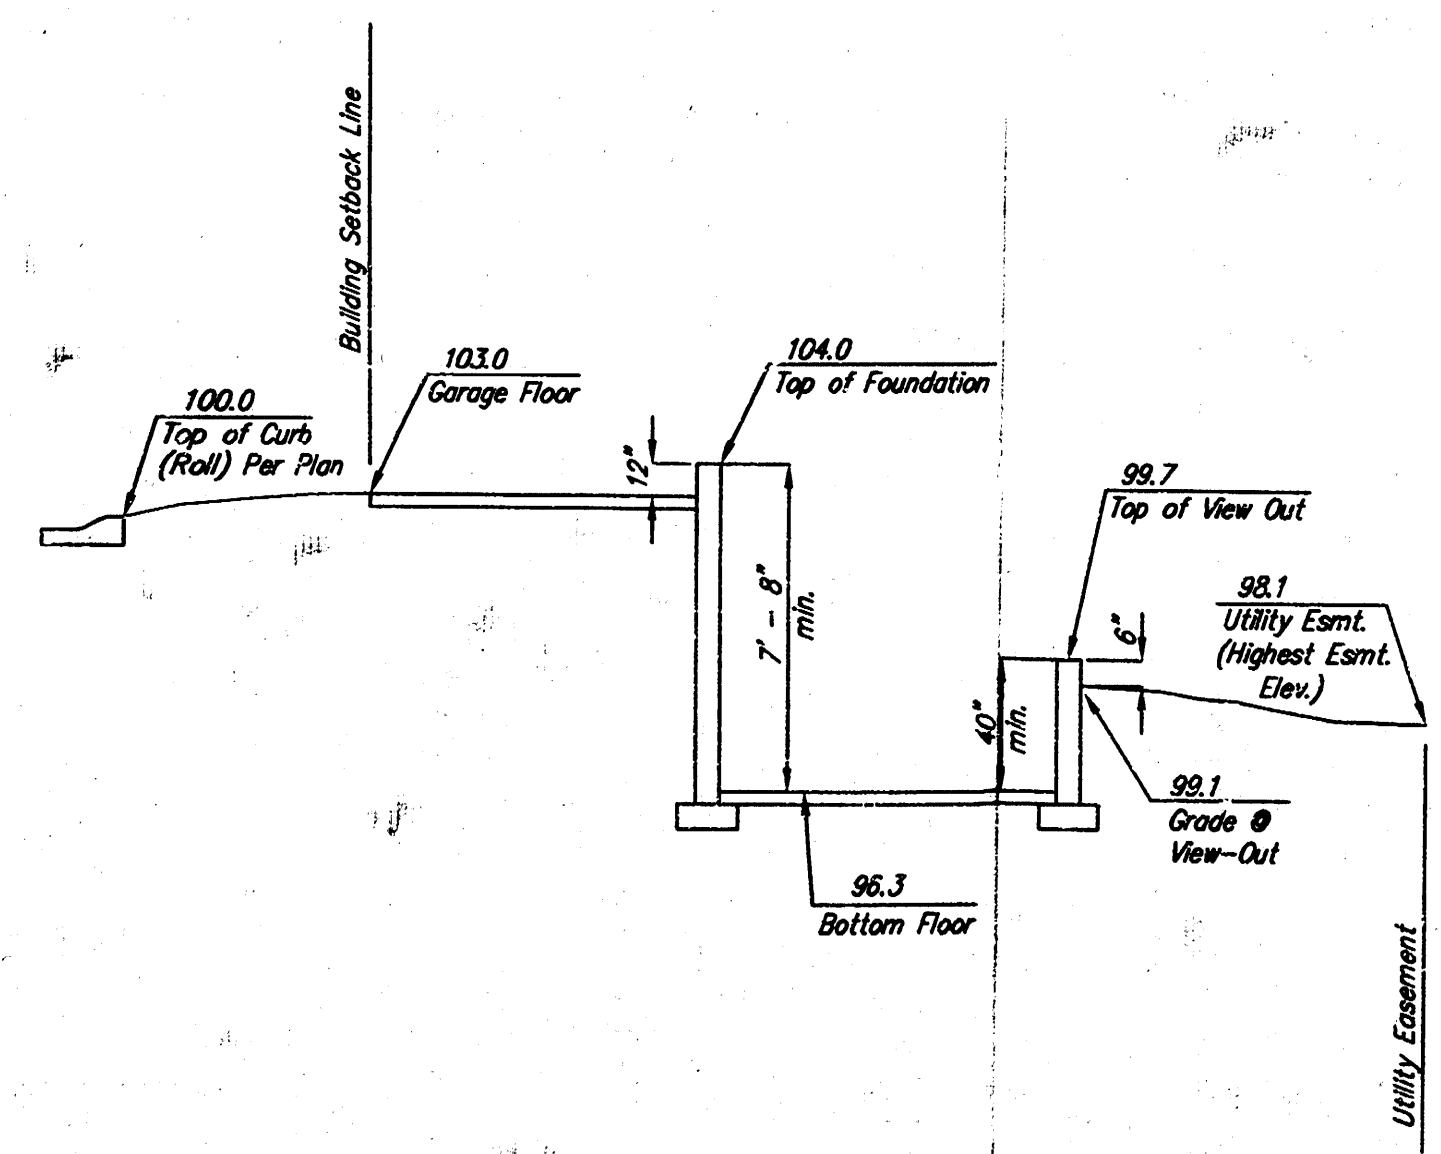


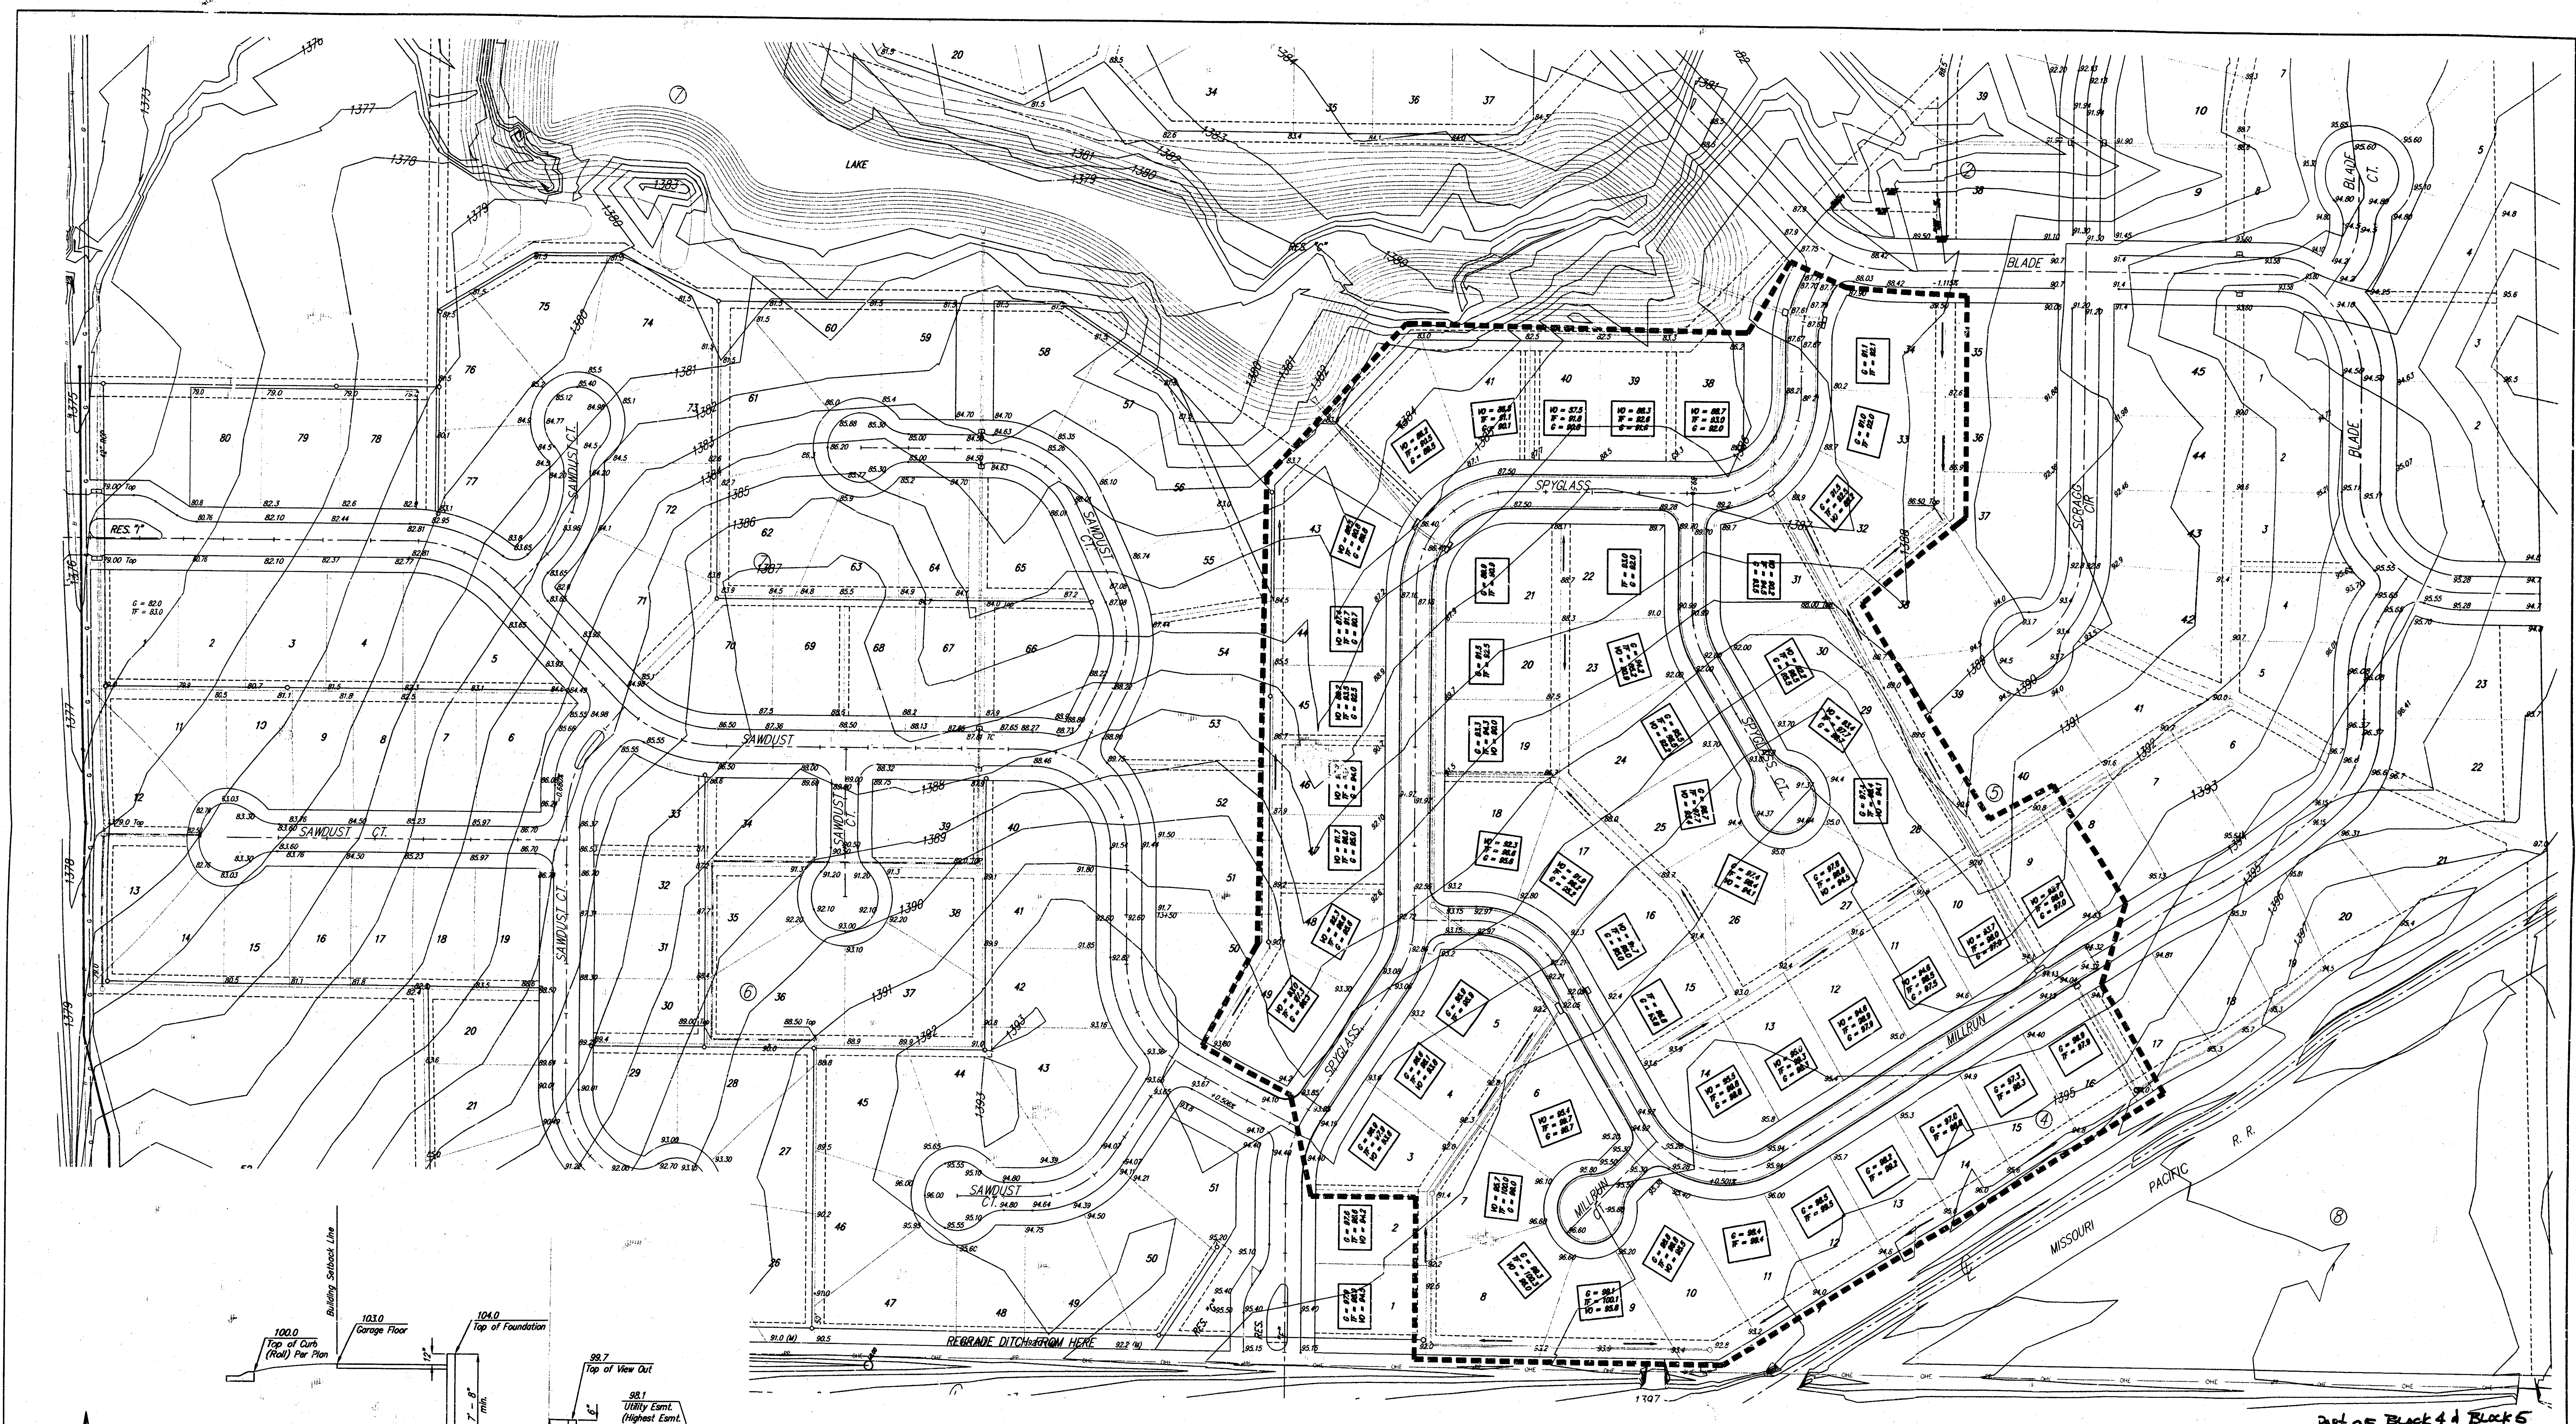

SCALE 1" = 80'

Section Through Typical View-Out Lot

**APPROVED
DRAINAGE PLAN**

--- BOUNDARY FOR REVISED GRADING PLAN.

BENCH MARKS
 " " SOUTHWEST CORNER OF HEADWALL OF RCBC ON THE WEST SIDE OF ROCK 1060' NORTH OF THE INTERSECTION OF ROCK ROAD AND 45TH STREET NORTH
 ELEVATION: 1379.84 (MSL)
 " " NORTHEAST CORNER OF HEADWALL OF RCBC ON THE EAST SIDE OF ROCK ROAD, WILLOWBEND 2ND ADDITION.
 ELEVATION: 1374.39 (MSL)

REVISED: FEBRUARY 13, 2003

**SAWMILL CREEK ADDITION
GRADING PLAN
WICHITA, KANSAS**

Ruggles & Bohm, P.A.
Engineering, Surveying, Land Planning
924 North Main
Wichita, Kansas 67203
(316) 264-8003
(316) 264-4521 fax
E-mail: info@rbkansas.com

DESIGN	CMB	SHEET 1 OF 2
DRAWN	EJG	
REVIEW		
UTILITY		
DRAWING FILE Sawmill Grading	PROJECT NUMBER	DATE JAN 11, 2001

Part of Block 4 & Block 5