

Section Through Typical View-Out Lot



SCALE 1" = 80'

**APPROVED
DRAINAGE PLAN**

--- BOUNDARY FOR REVISED GRADING PLAN.

BENCH MARKS



- SOUTHWEST CORNER OF HEADWALL OF RCBC ON THE WEST SIDE OF ROCK 1060' NORTH OF THE INTERSECTION OF ROCK ROAD AND 45TH STREET NORTH
ELEVATION: 1379.84 (MSL)
- NORTHEAST CORNER OF HEADWALL OF RCBC ON THE EAST SIDE OF ROCK ROAD, WILLOWBEND 2ND ADDITION.
ELEVATION: 1374.39 (MSL)

REVISED: FEBRUARY 13, 2003

**SAWMILL CREEK ADDITION
GRADING PLAN
WICHITA, KANSAS**


	Ruggles & Bohm, P.A. Engineering, Surveying, Land Planning		DESIGN CMB	SHEET 1 OF 2
	924 North Main Wichita, Kansas 67203 www.rbkansas.com	(316) 264-8000 (316) 264-4521 fax E-mail: info@rbkansas.com	DRAWN EJG REVIEW UTILITY	

part of Block 4 & Block 5

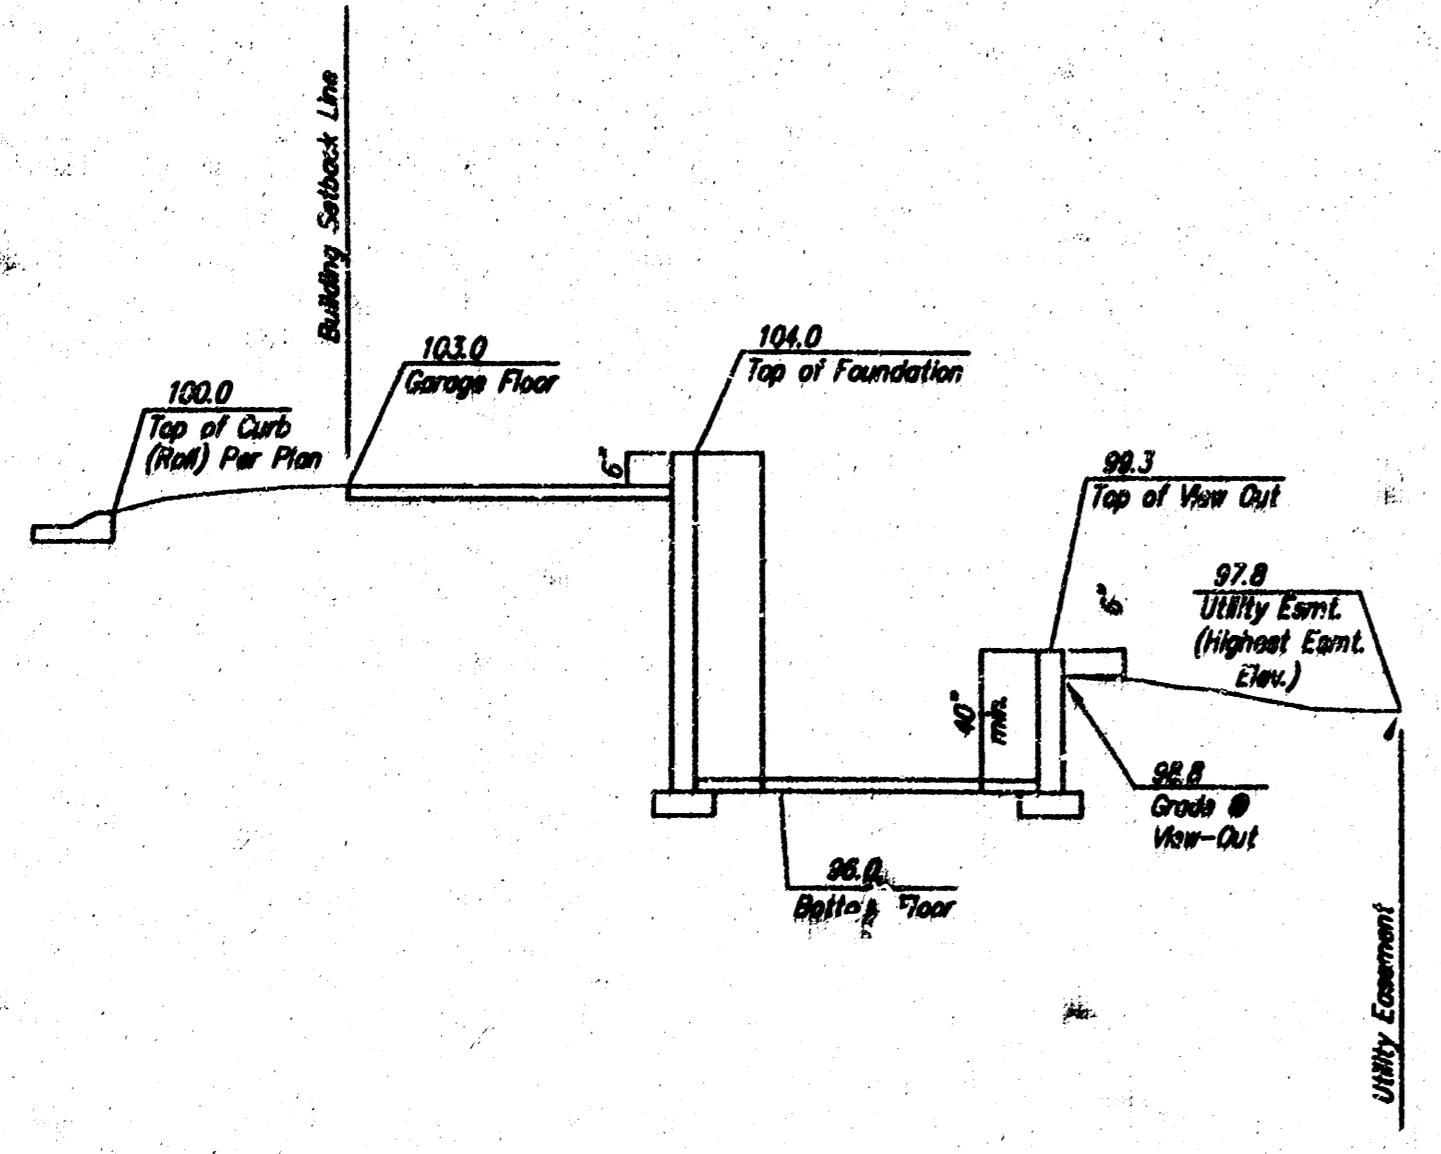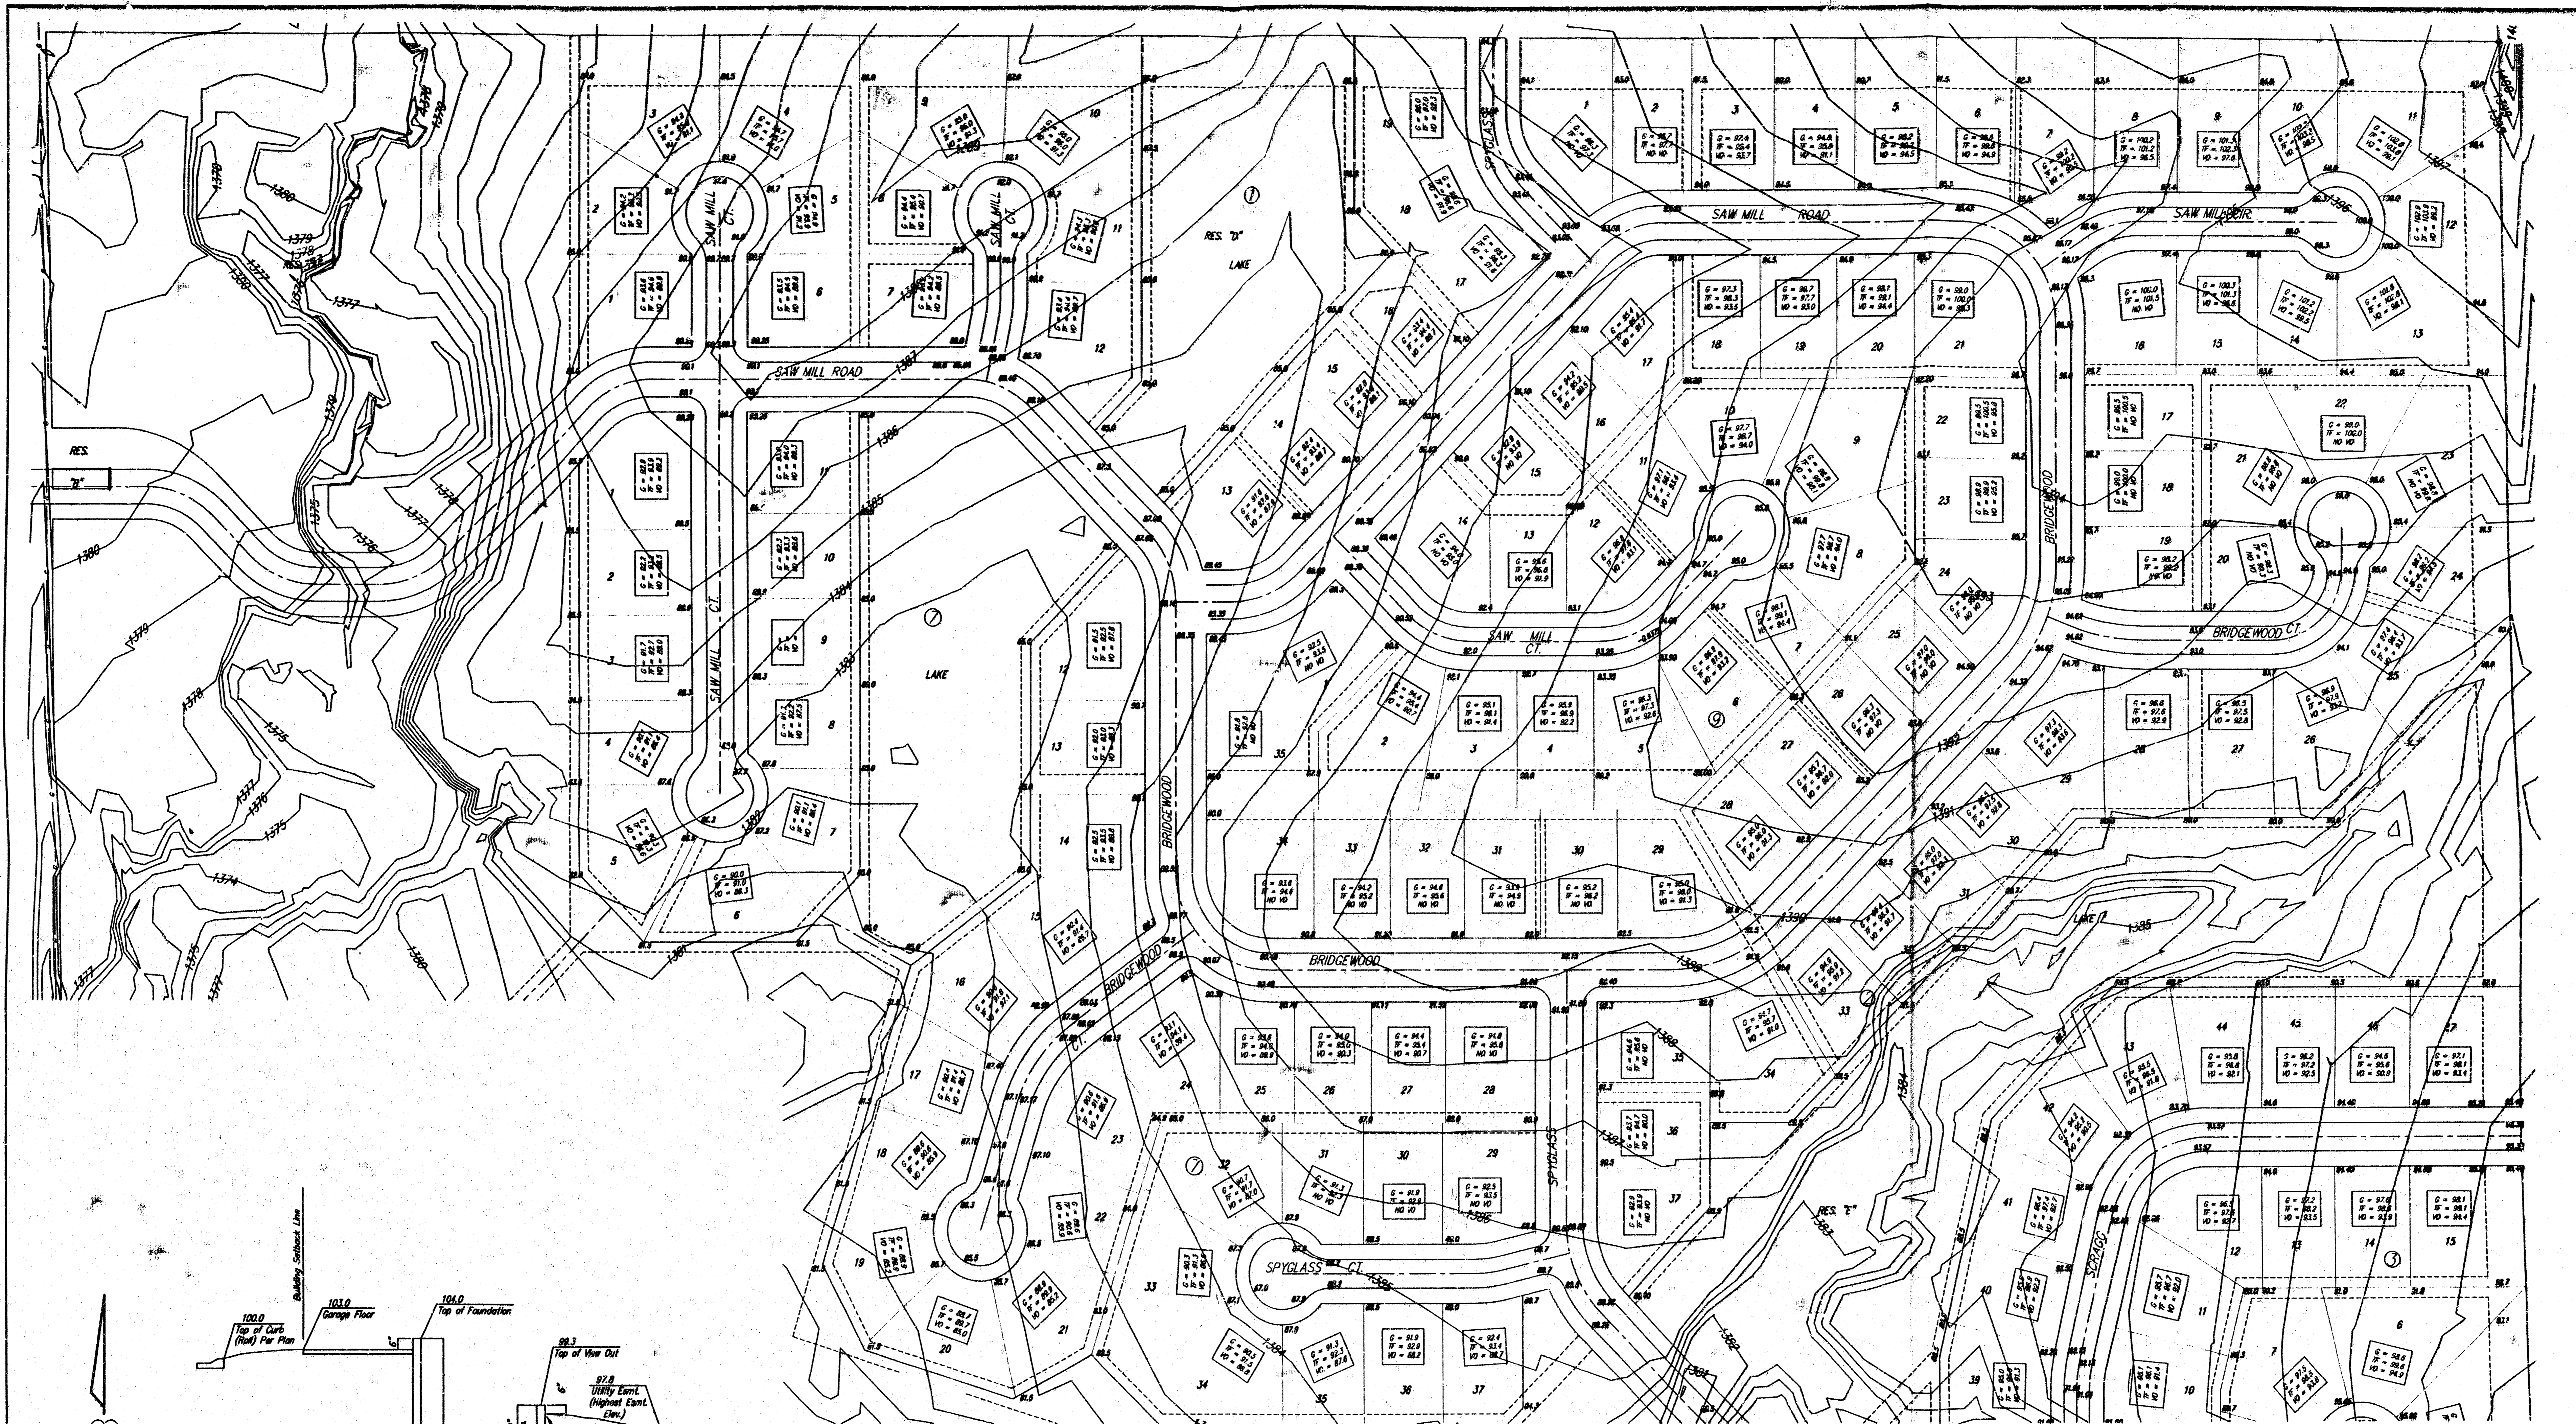

Section Through Typical View-Out Lot

SCALE 1" = 80'

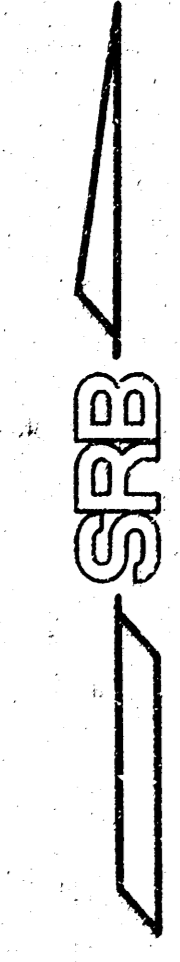

**Sawmill Creek
Grading Plan
WICHITA, KANSAS**

SRB	224 NORTH MAIN WICHITA, KANSAS 67203 www.srb1.com	316-264-8008 FAX: 316-4-8211 E-mail: srb@srb1.com
SAVOY, RUGGLES & BOHM, P.A. ENGINEERING & SURVEYING		
PROJECT NUMBER		
DESIGN CMB	DRAWN EJG	UTILITY REVIEW DATE Jan. 11, 2001

SHEET
2
OF
2