


SCHOLFIELD-HATCHETT ADDITION
(Drainage)

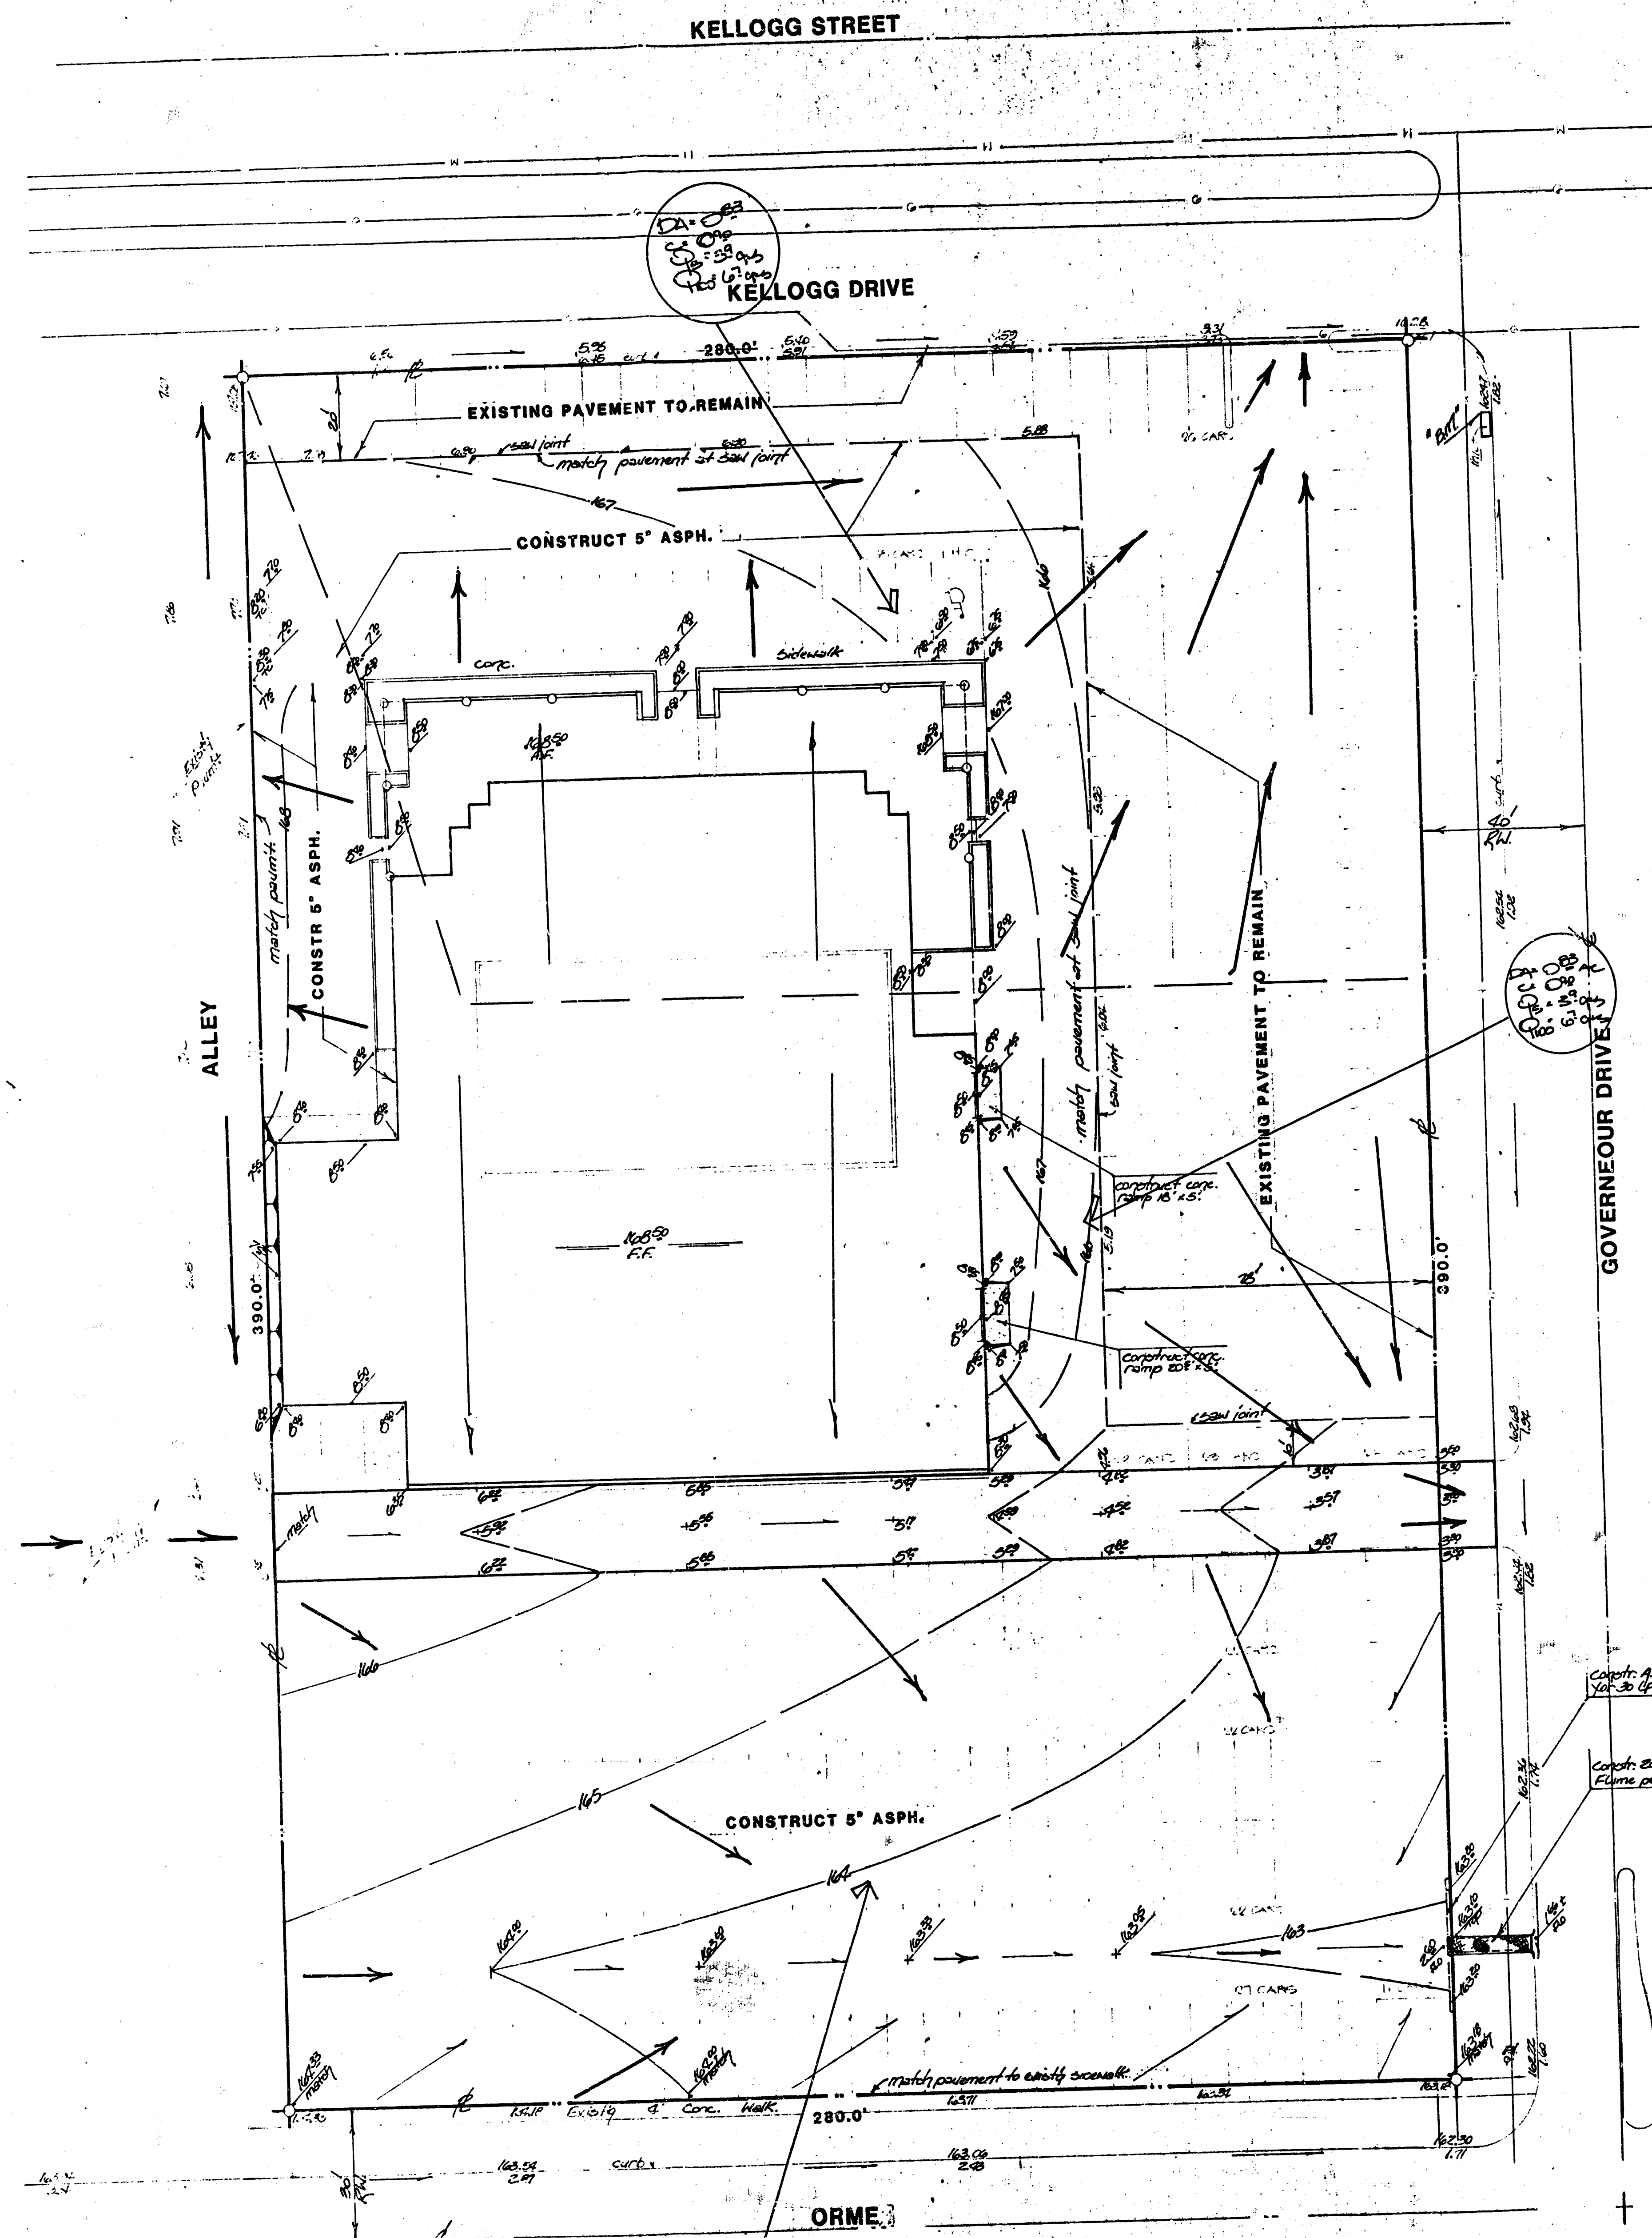

SITE PLAN

Survey Mark - 1/4\"/>

DRAINAGE & GRADING PLAN

General Notes
The lot will drain according to the grading plan provided herein. The areas indicated will discharge to the streets either thru driveways or flumes. Runoff for the total site is used as 0.50

prints issued
9-1-79


revisions

date drawn



JEFF KREHBIEL
ASSOCIATES, aia
architecture · planning

1300 east lewis wichita, kansas 67211
(316) 267-8223

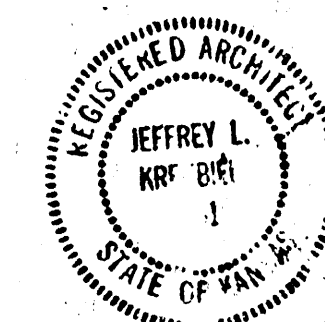

new dealership for
SCHOLFIELD HONDA
7017 E. KELLOGG
wichita, kansas

sheet title

SITE GRADING

sheet

SG-1

of 1 sheets

