





Bench Marks:
1. Cut on top of west curb on
south end of Hillside
43.1 feet south of 1/4 of Orme
Elev. 510.72 = Datum

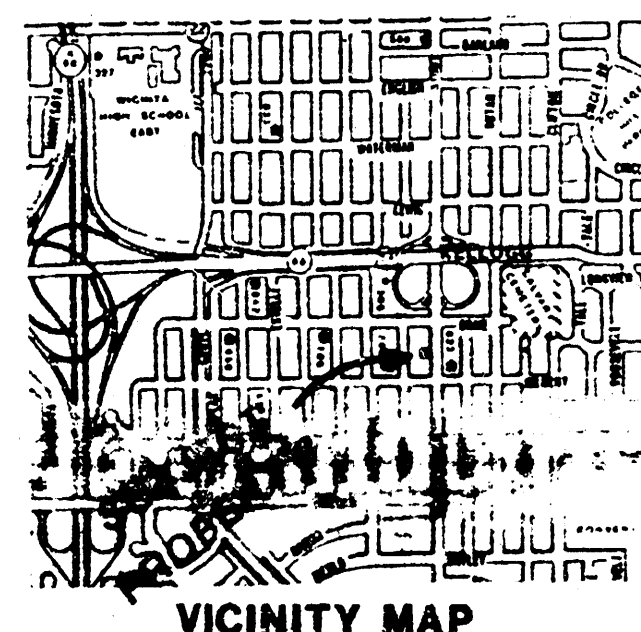

VICINITY MAP

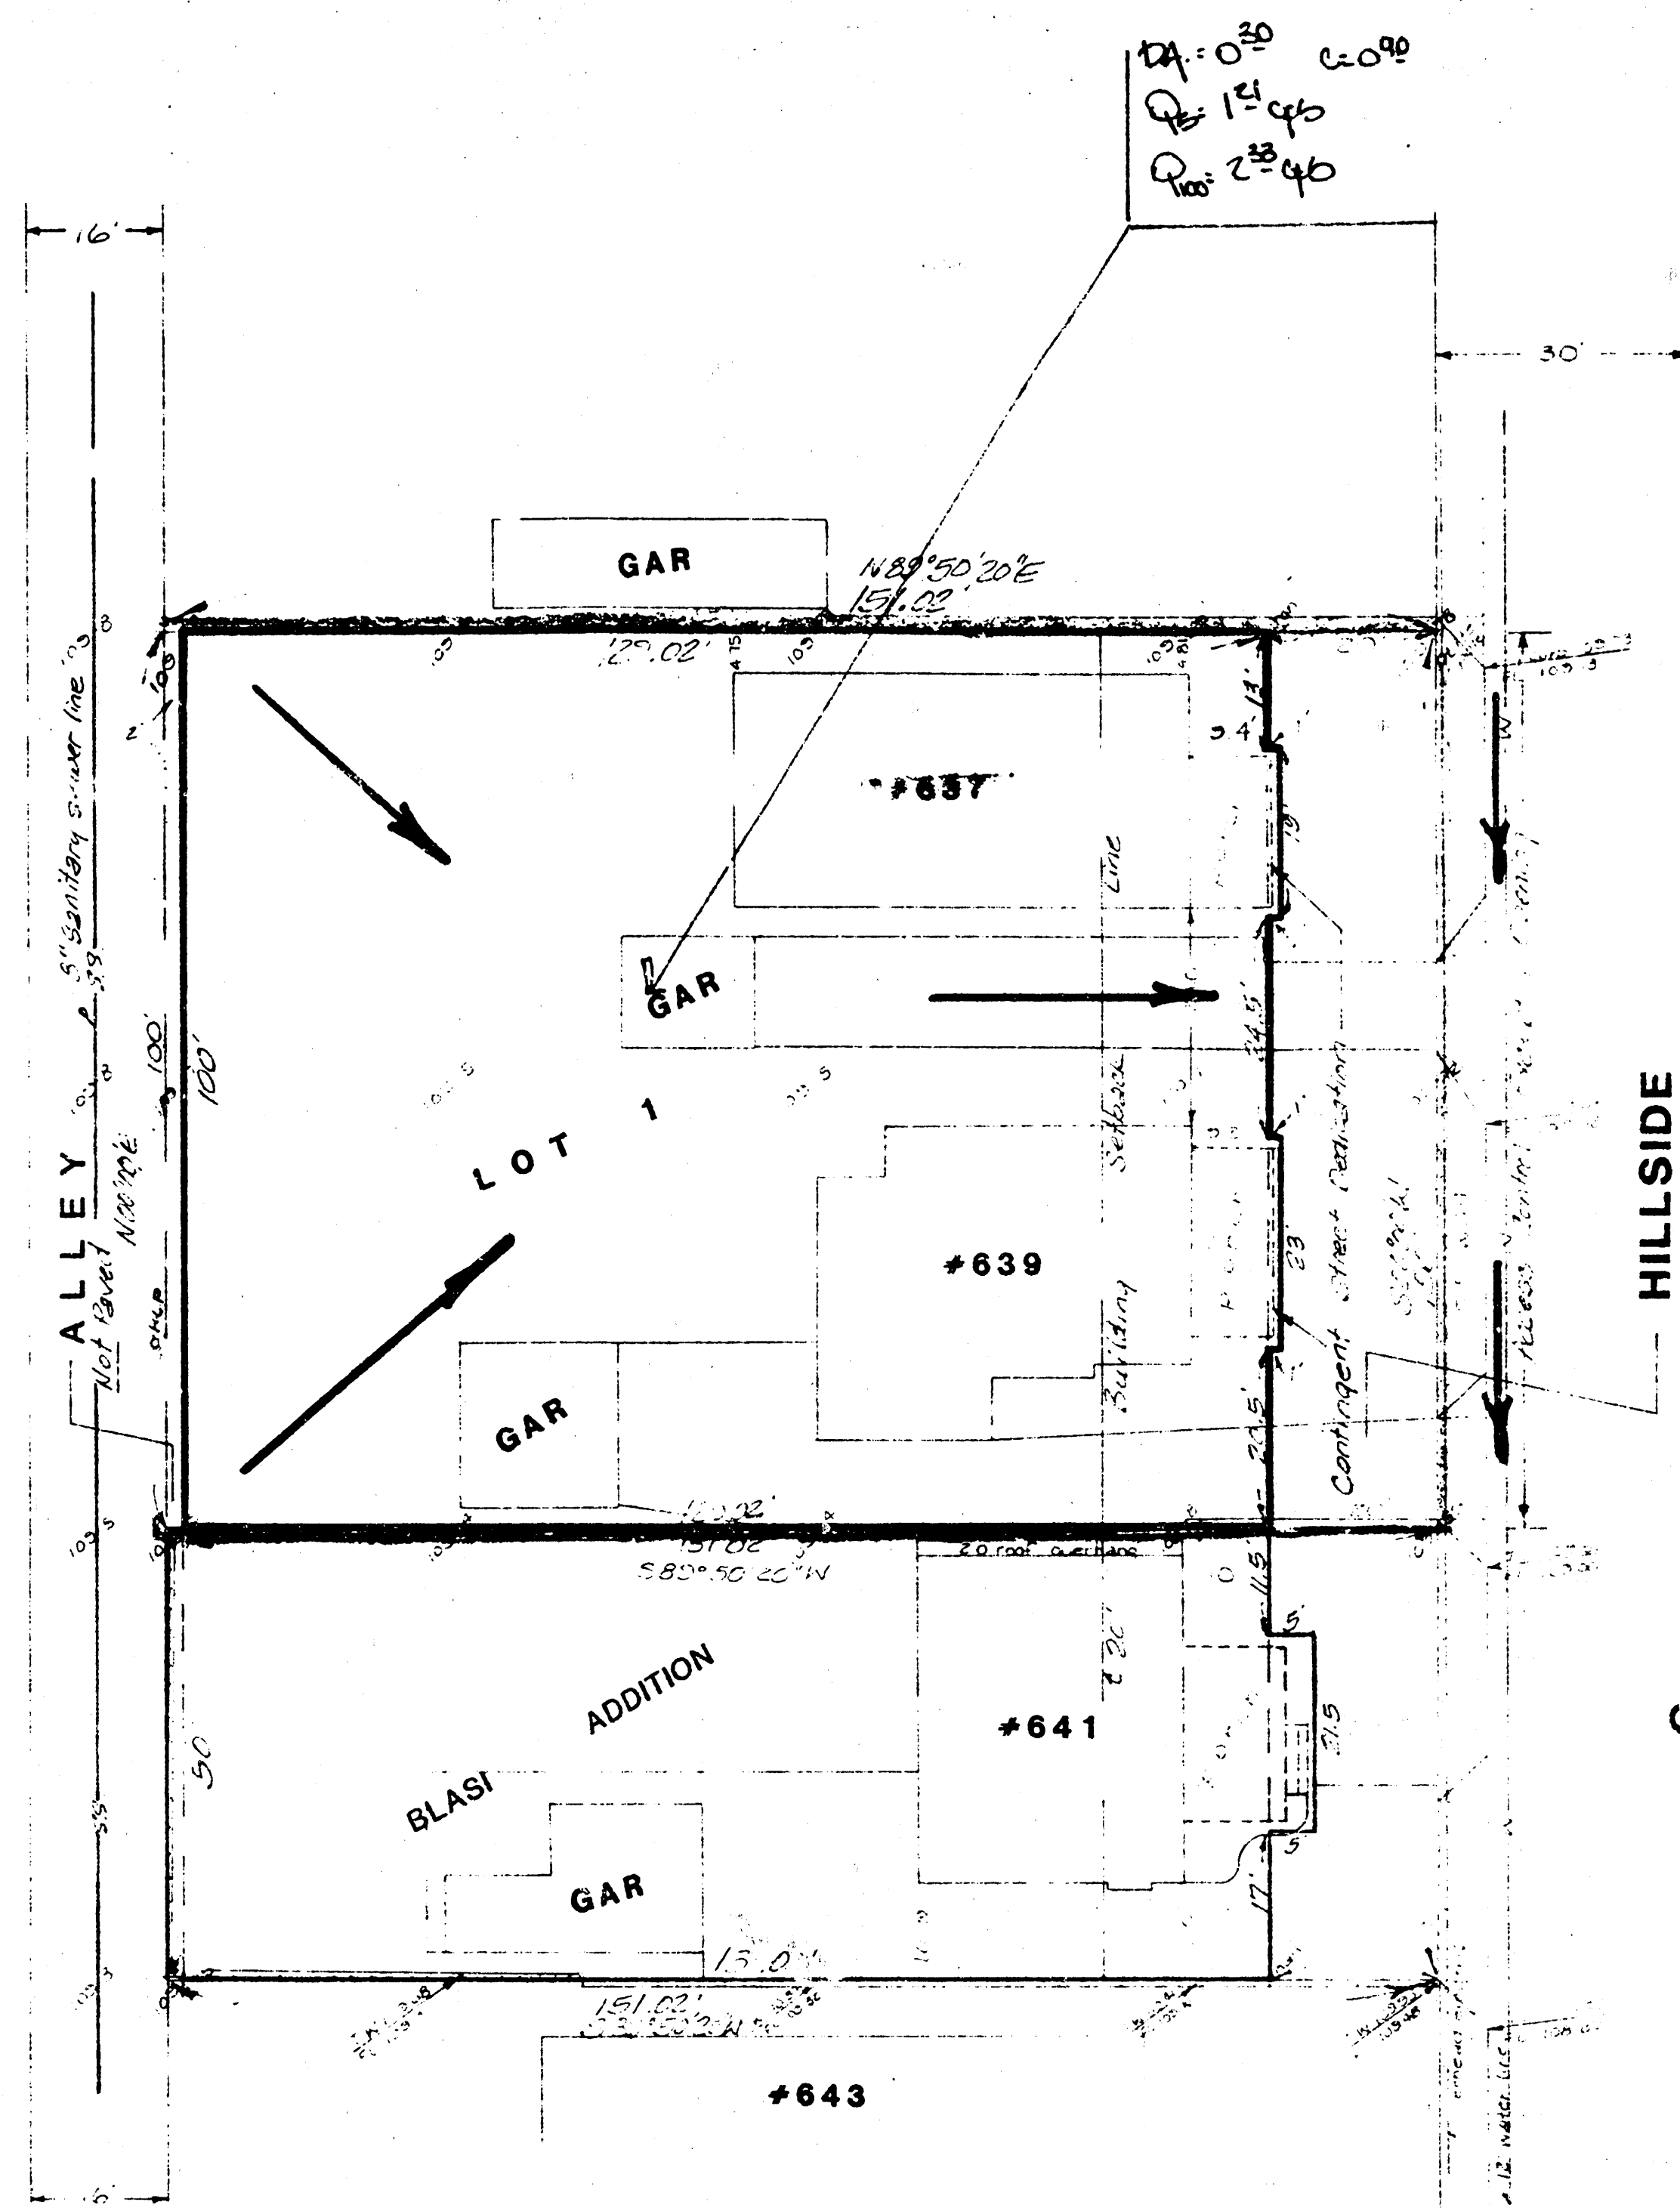

SKETCH PLAT

SCHUYLER ADDITION

LOTS 73, 75, 77, AND 79, BLOCK 8, SUNNY-SIDE ADDITION, WICHITA, KANSAS

OWNERS:

MARK W. AND ERIN S. SCHUYLER

APPROVED
DRAINAGE PLAN

DRAINAGE PLAN

BAUGHMAN COMPANY, P.A.
SURVEYING & ENGINEERING
316262-7271 • 315 ELLIS • WICHITA, KANSAS 67211