


SECURITY STORAGE PROPERTIES ADDITION
(DRAINAGE)

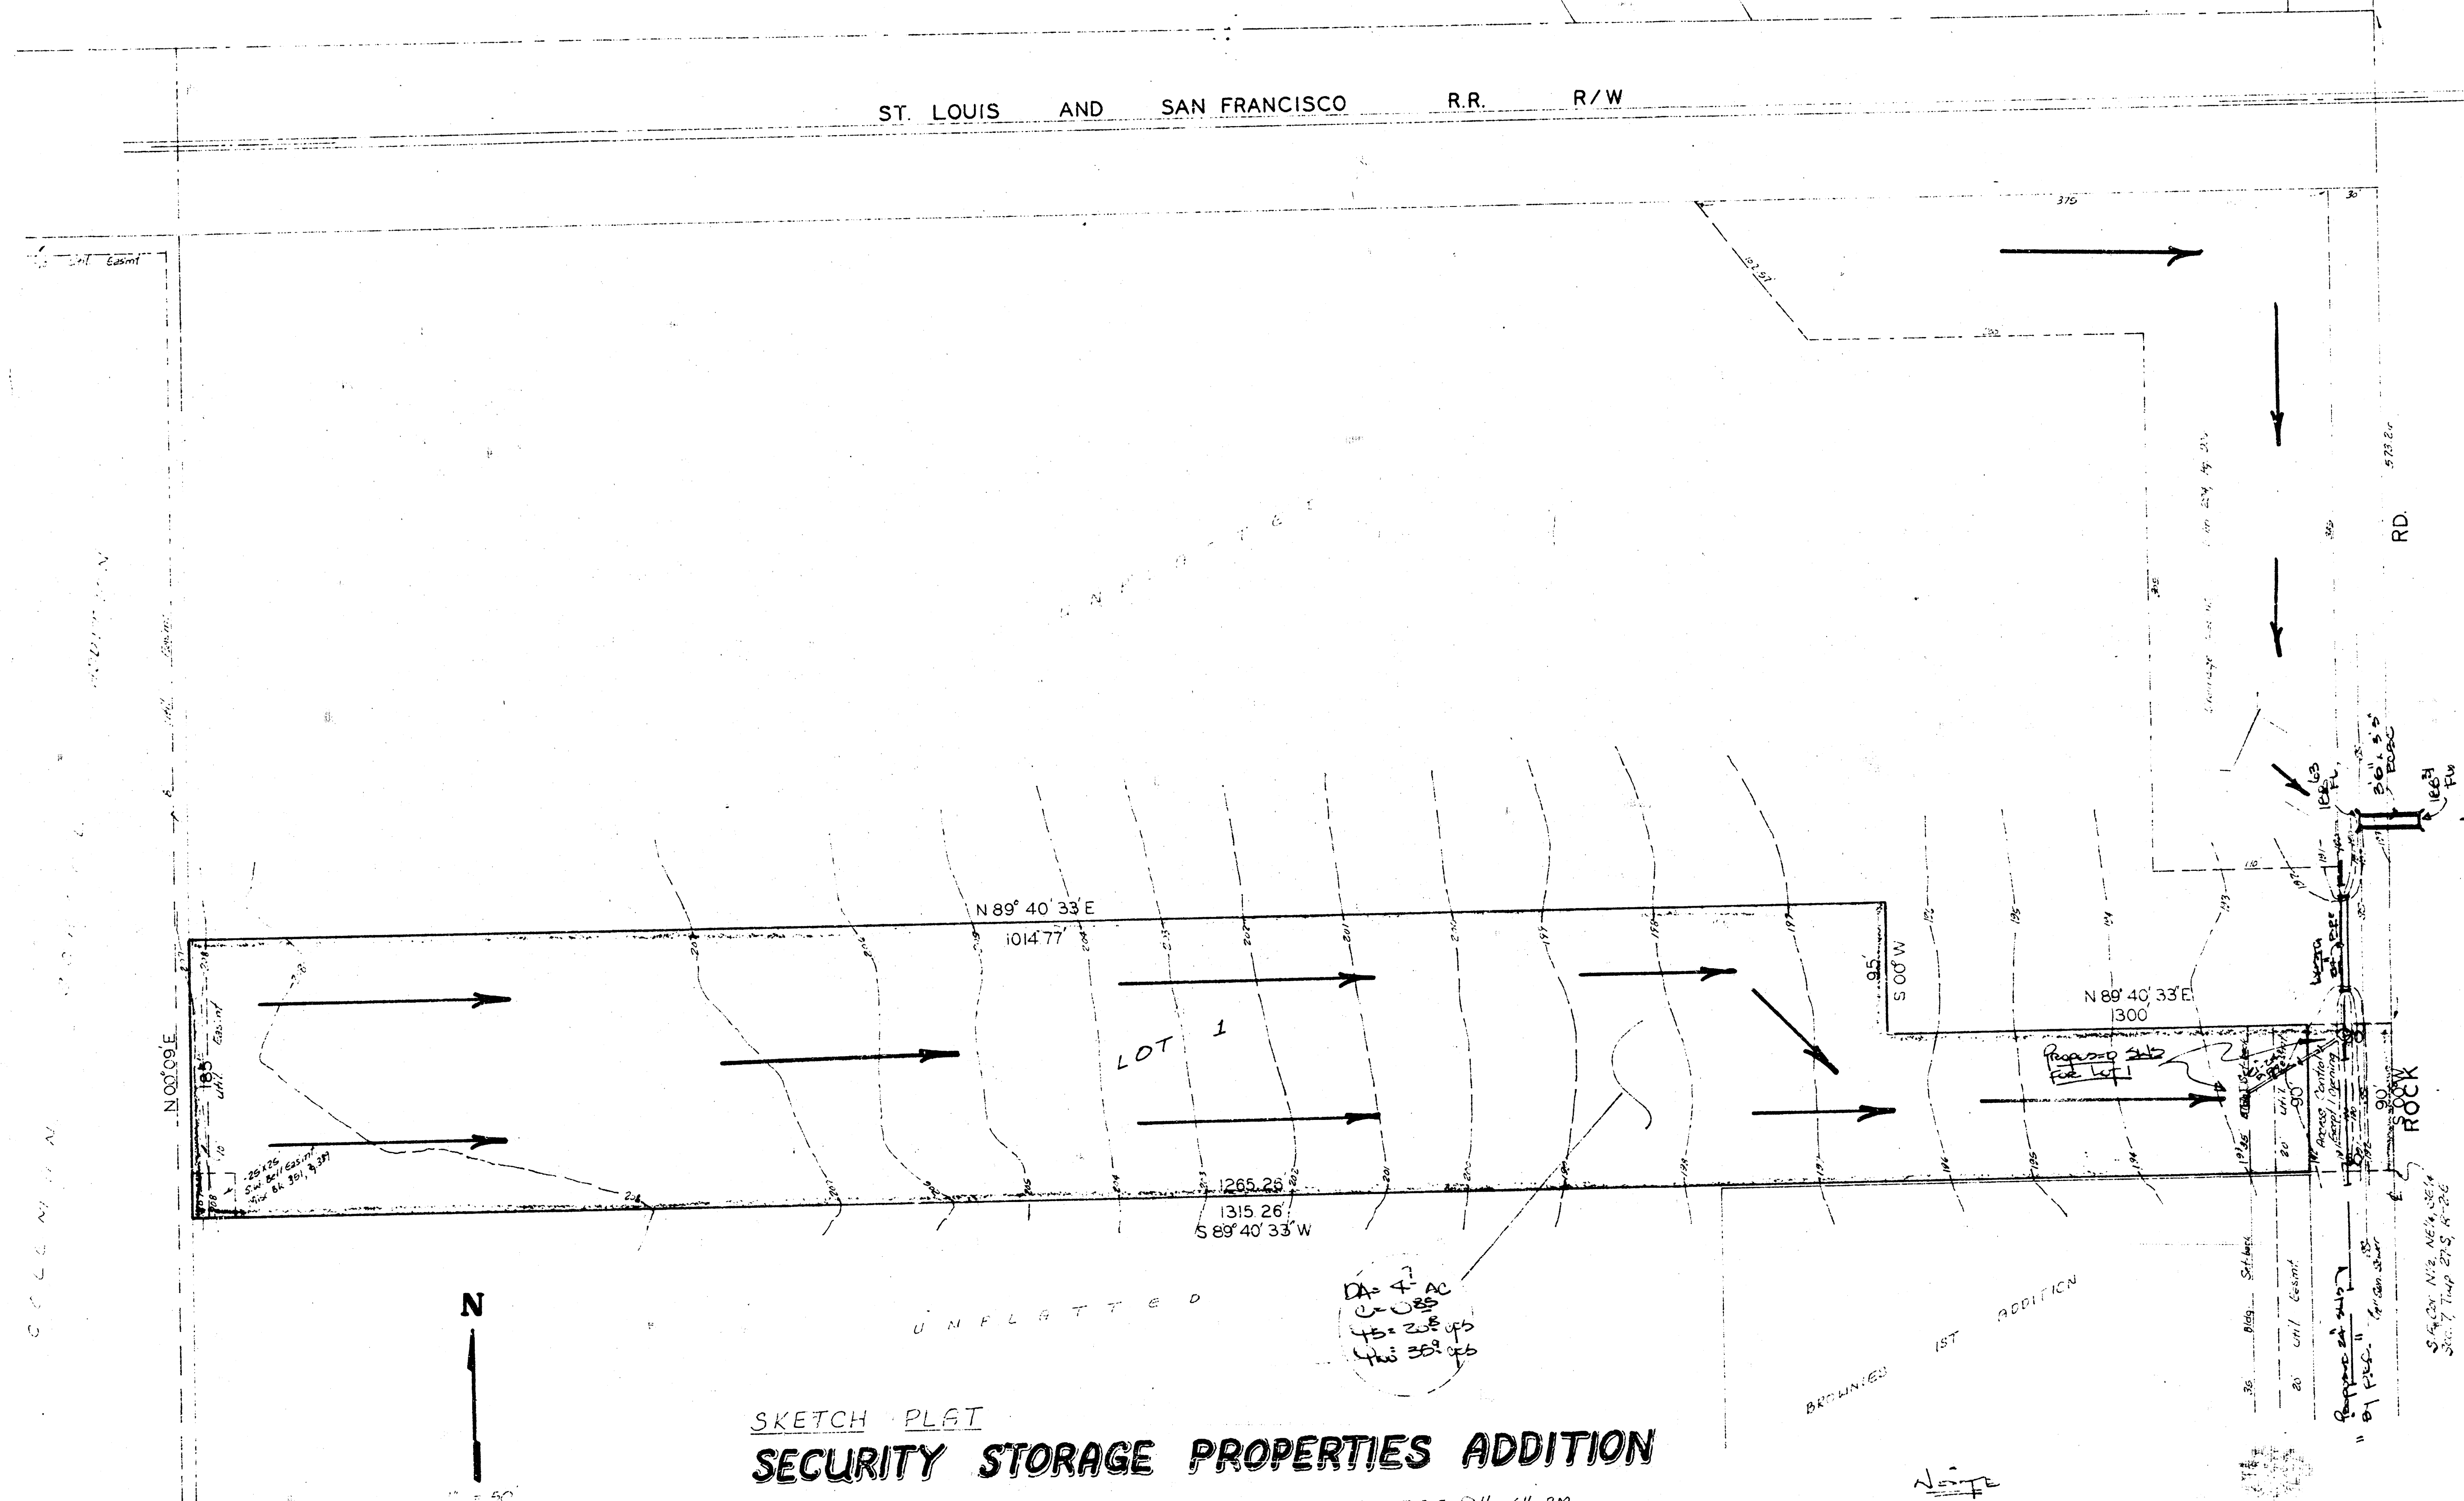

SKETCH PLAT SECURITY STORAGE PROPERTIES ADDITION

Beginning at the SE Cor of the N1/2 of the NE1/4 of the SE1/4 of Sec 7 Twp 37S R 2E of the 6th PM, Sedgwick County, Kansas, thence north 300 feet, thence north 35 feet, thence west to the west line of the N1/2 of the NE1/4 of the SE1/4 of said Sec 7, thence south to the S.W. Corner of the N1/2 of the NE1/4 of the SE1/4 of said Sec 7, thence east to the point of beginning.

SECURITY STORAGE PROPERTIES, A KANSAS GENERAL PARTNERSHIP
Stephen L. Clark
Bill Ford

FINAL DRAINAGE PLAN

- Note
- 1- LOT 1 WILL DRAIN EAST AS INDICATED.
 - 2- FROM SELLER WILL BE EXPENDITURE FROM THE PROPOSED 24" PIPE TO THE LOT TO DISCHARGE ALL RUNOFF FROM THE LOT.
 - 3- NO DISCHARGE RUNOFF WILL BE DIRECTED TO ROCK ROAD FROM THE LOT THROUGH THE CREEKWAY.
 - 4- FROM SELLER (LOTS & LOCATION) WILL BE CO-ORDINATED AT THE TIME OF DEVELOPMENT & TO CO-ORDINATE WITH THE ROCK ROAD IMPROVEMENTS BY BAUGHMAN COMPANY, P.A.

BAUGHMAN COMPANY, P.A.
SURVEYING & ENGINEERING
316-262-7271 • 3301 LAURA • WICHITA, KANSAS 67211