


SEVEN-UP ADDITION
(Drainage)

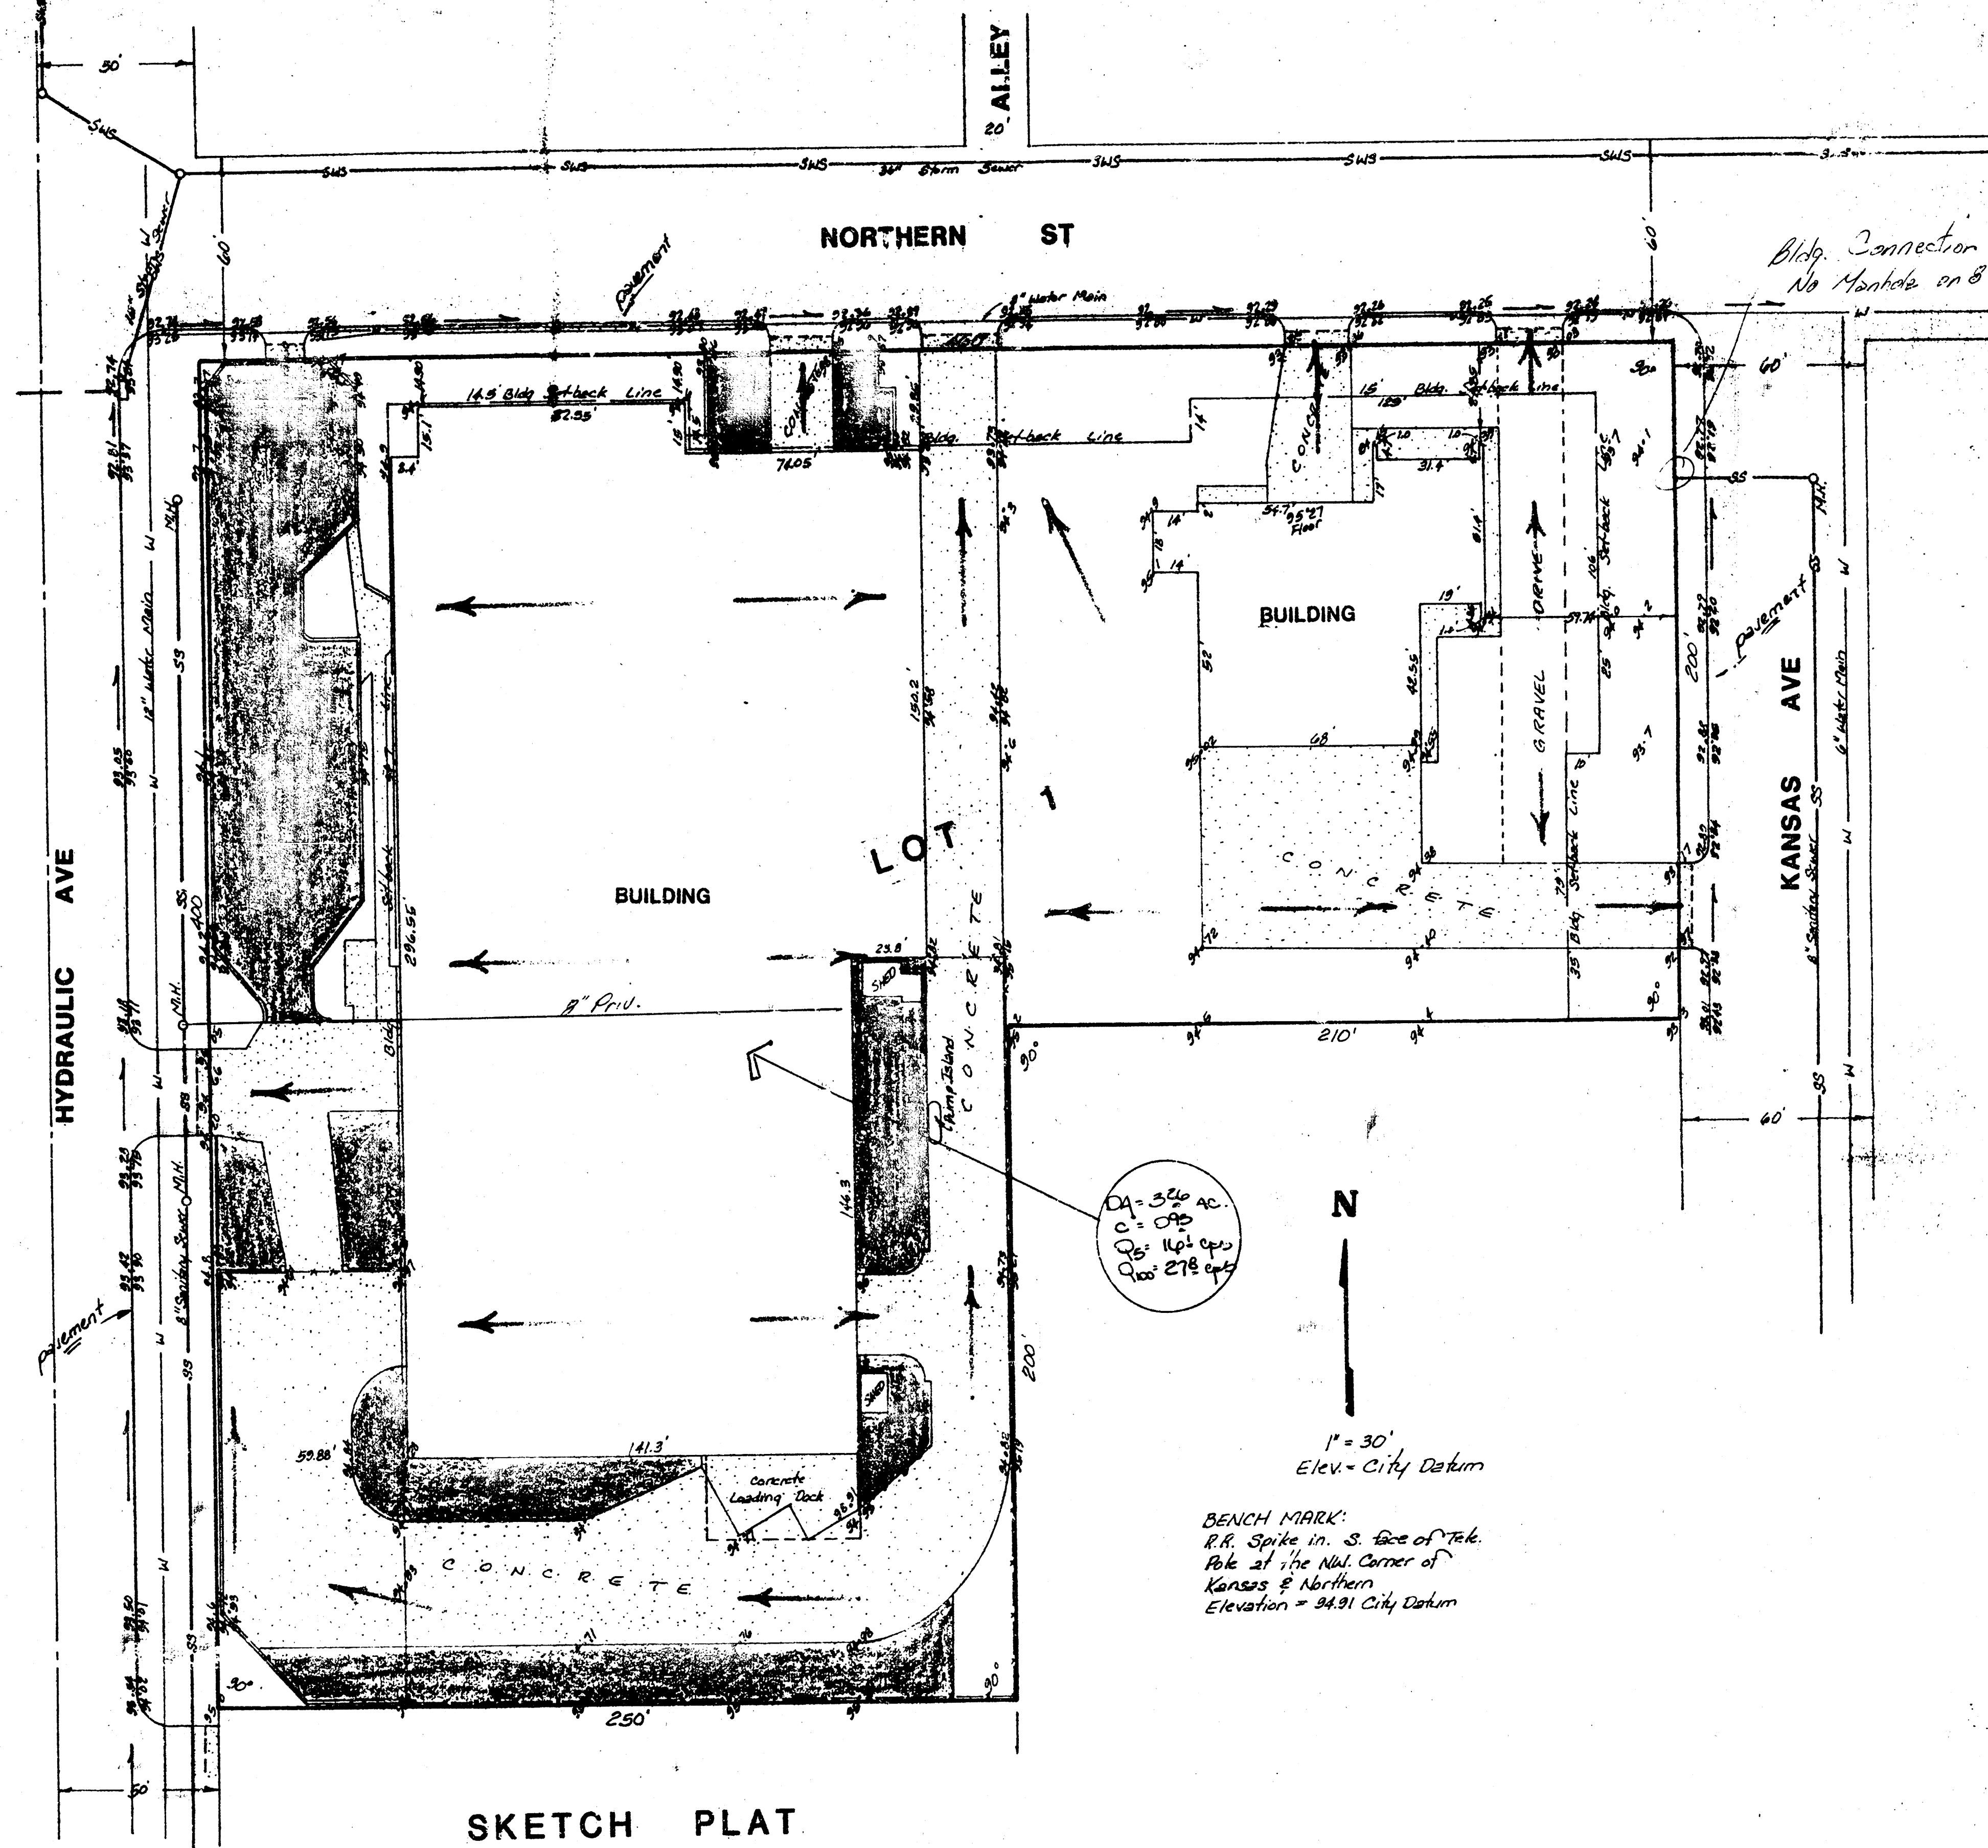

SKETCH PLAT

SEVEN-UP ADDITION

LOT 1 AND THE N1/2 OF LOT 2,
BLOCK B, INDUSTRIAL ADDITION

SEVEN-UP WICHITA BOTTLING CO., INC.
SCOTT T. CULBERTSON, PRESIDENT

GENERAL NOTE

The industrial developed lot (3.26 acres) will drain as it does presently to the streets around the lot thru 7 driveways. Storm sewer inlet is presently discharging hydraulic at the intersection as indicated on the topography.

DRAINAGE PLAN

BAUGHMAN COMPANY, P.A.
SURVEYING & ENGINEERING
316/262-7271 • 330 LAURA • WICHITA, KANSAS 67211

12 SEP 8