


Drainage Plan SHAVER ADDITION Wichita, Sedgwick County, Kansas






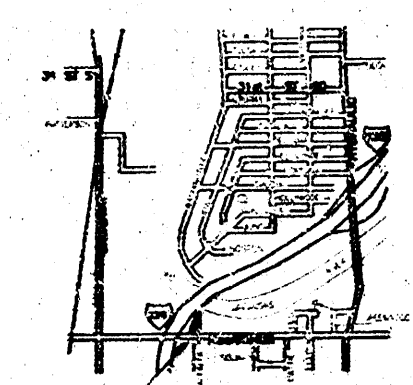

INSET MAP
NOT TO SCALE

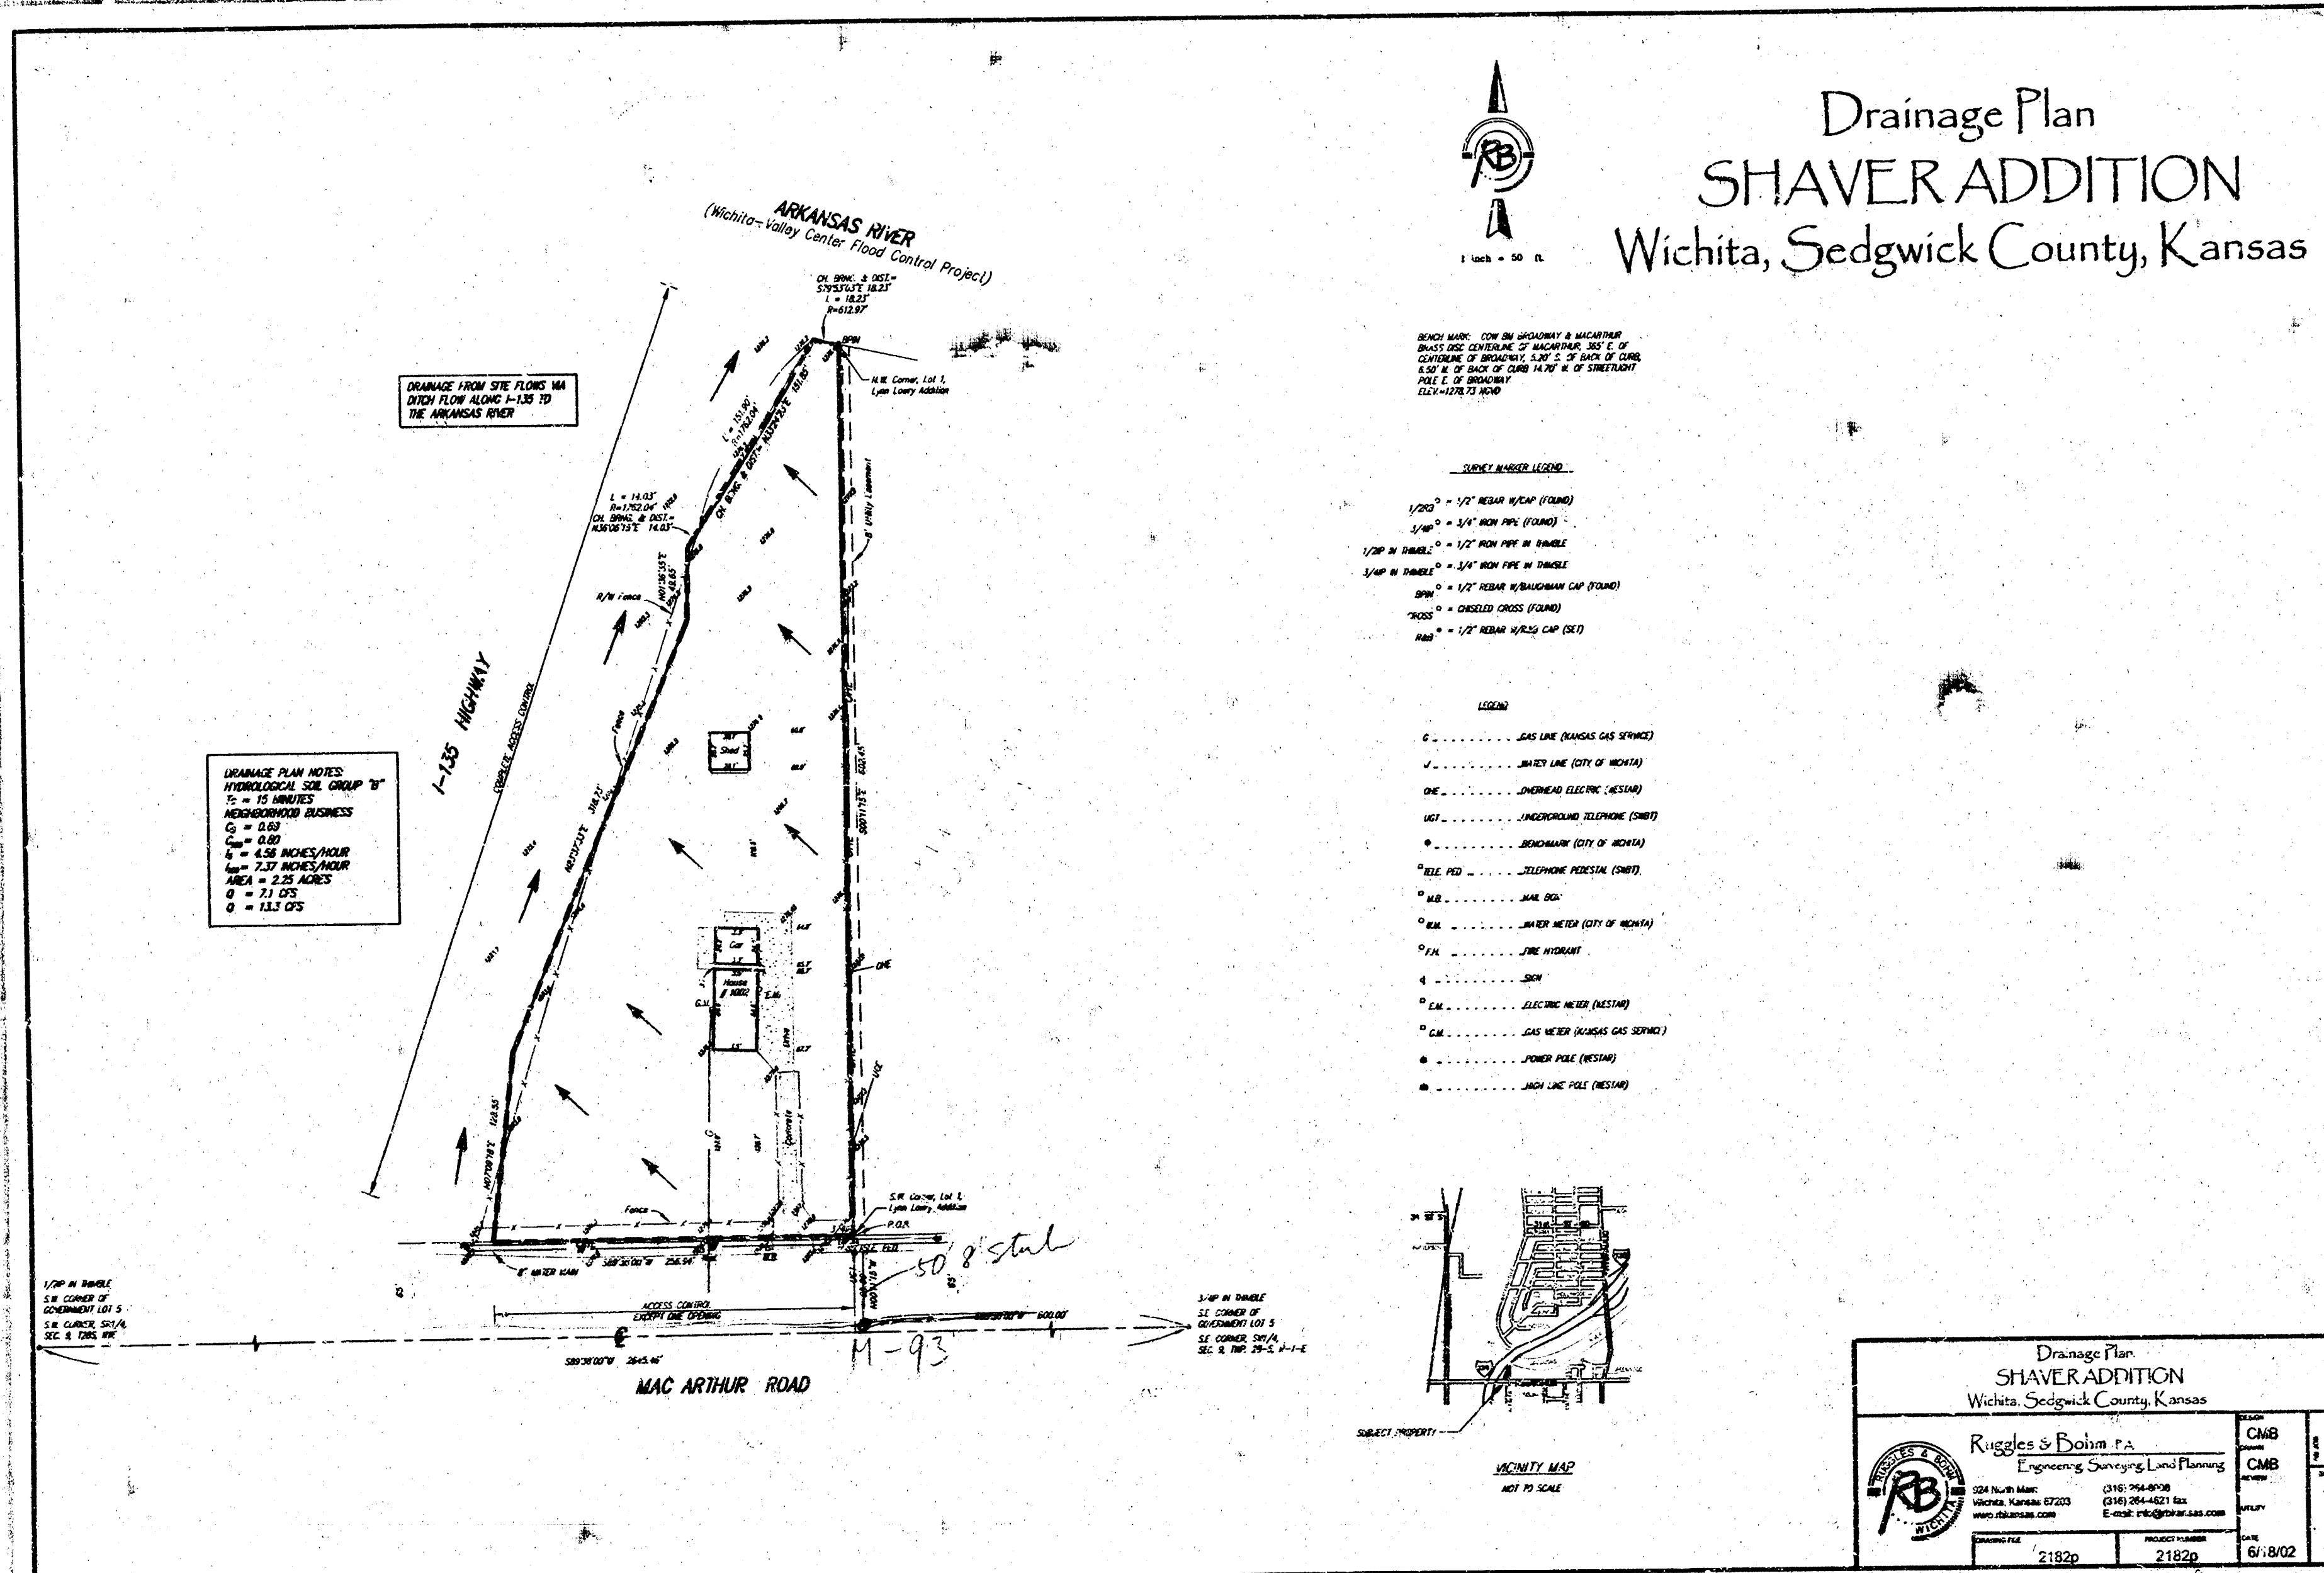

DRAINAGE PLAN NOTES:


Drainage Plan SHAVER ADDITION Wichita, Sedgwick County, Kansas	
