


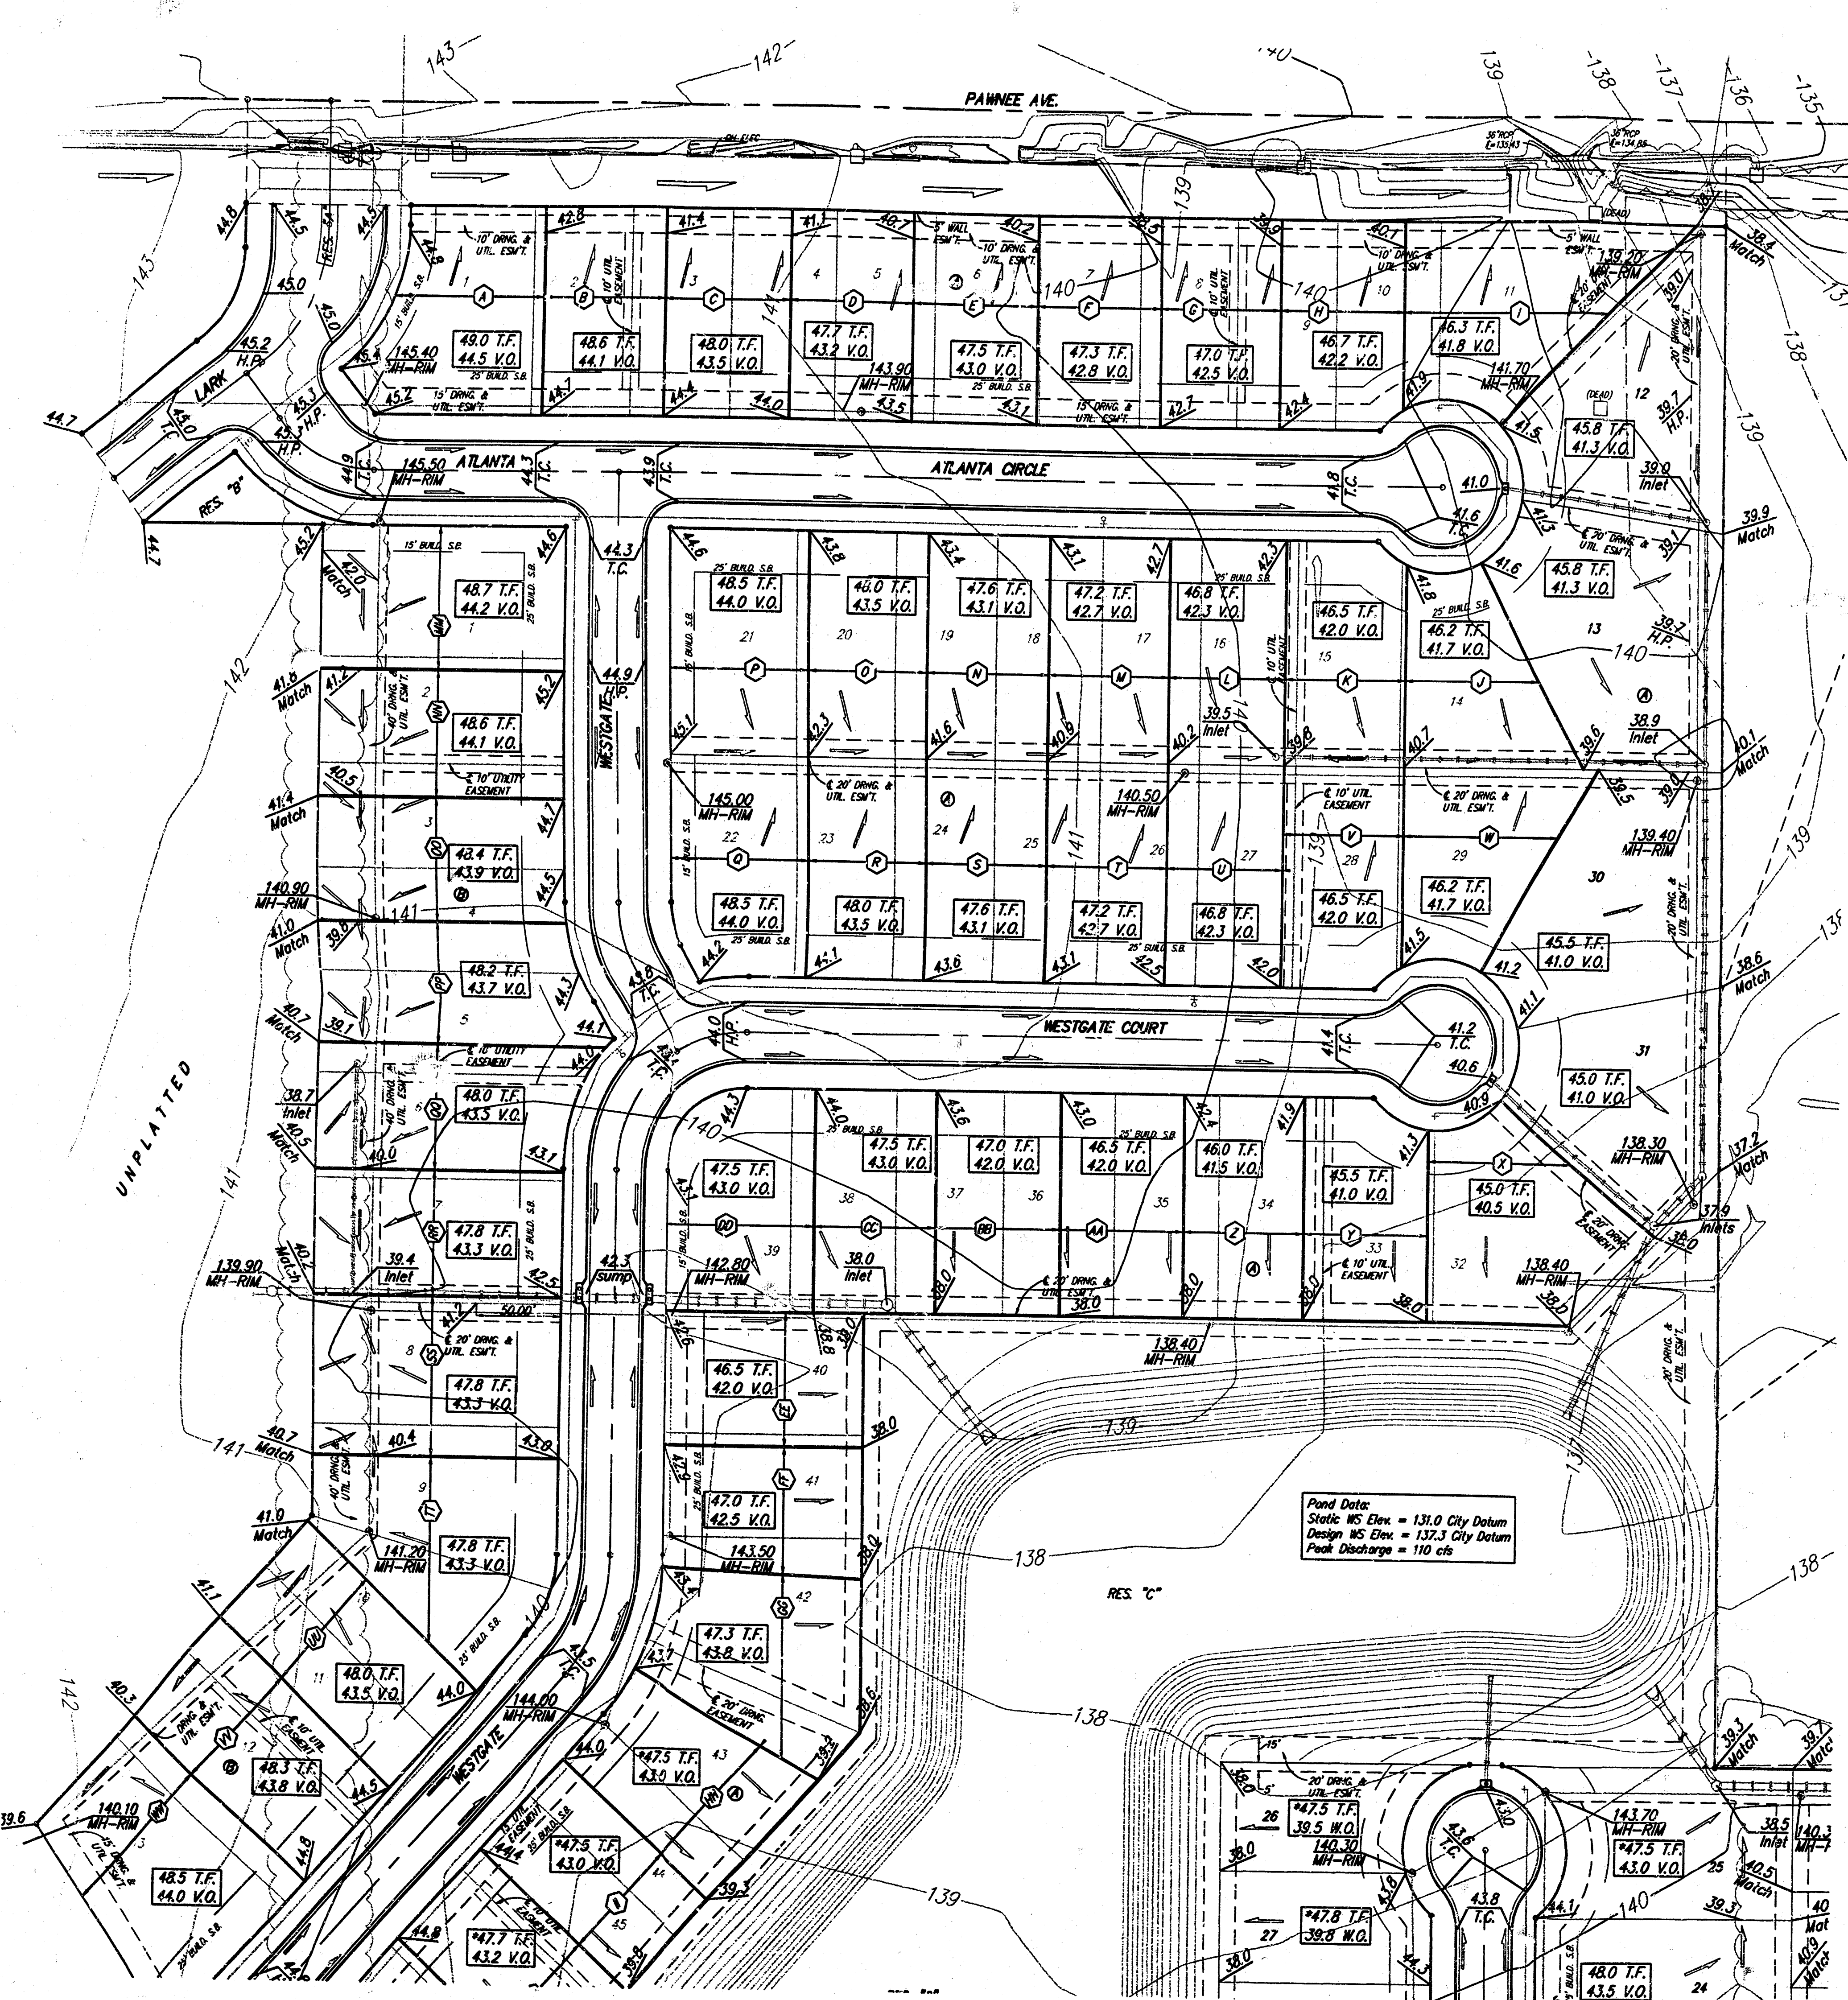

Lot Split Legal Descriptions

Legal Description "A"
 Lot 1, Block A, Southern Ridge Addition, Wichita, Sedgewick County, Kansas, except the west 6.47 feet of Lot 1 in said Block A.

Legal Description "B"
 Lot 2, Block A, Southern Ridge Addition, Wichita, Sedgewick County, Kansas, except the west 20.47 feet of Lot 2 in said Block A.

Legal Description "C"
 Lot 3, Block A, Southern Ridge Addition, Wichita, Sedgewick County, Kansas, except the west 34.47 feet of Lot 3 in said Block A.

Legal Description "D"
 Lot 4, Block A, Southern Ridge Addition, Wichita, Sedgewick County, Kansas, except the west 46.47 feet of Lot 4 in said Block A.






















Lot Split Designation

Legal Description "A"
 Lot 26, Block A, Southern Ridge Addition, Wichita, Sedgewick County, Kansas, except the west 41.00 feet thereof, TOGETHER with the west 53.00 feet of Lot 27 in said Block A.































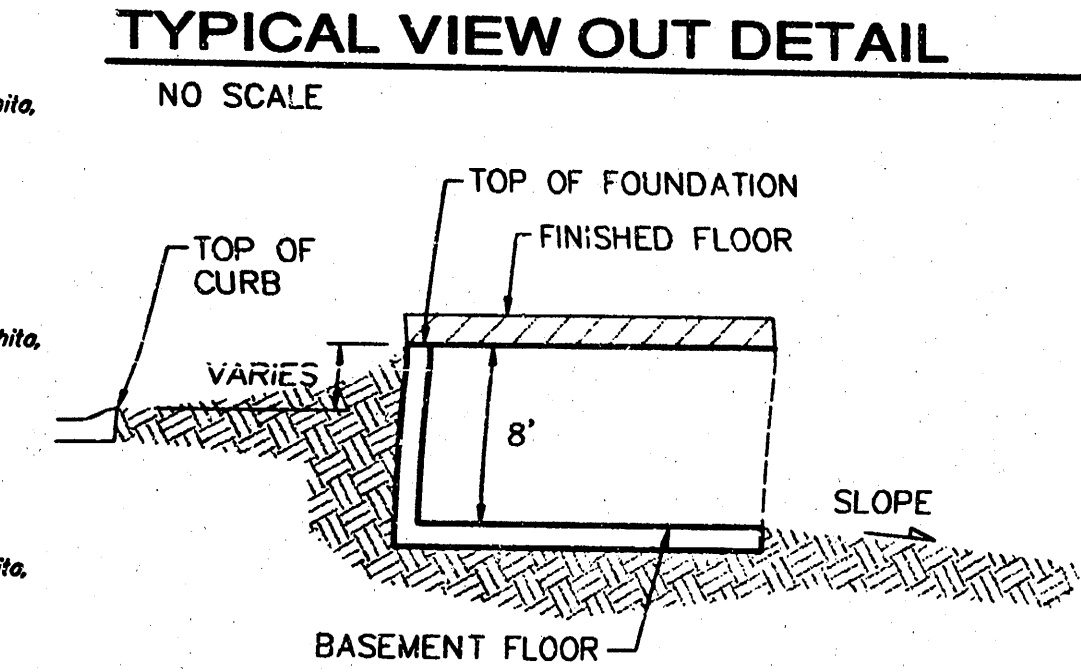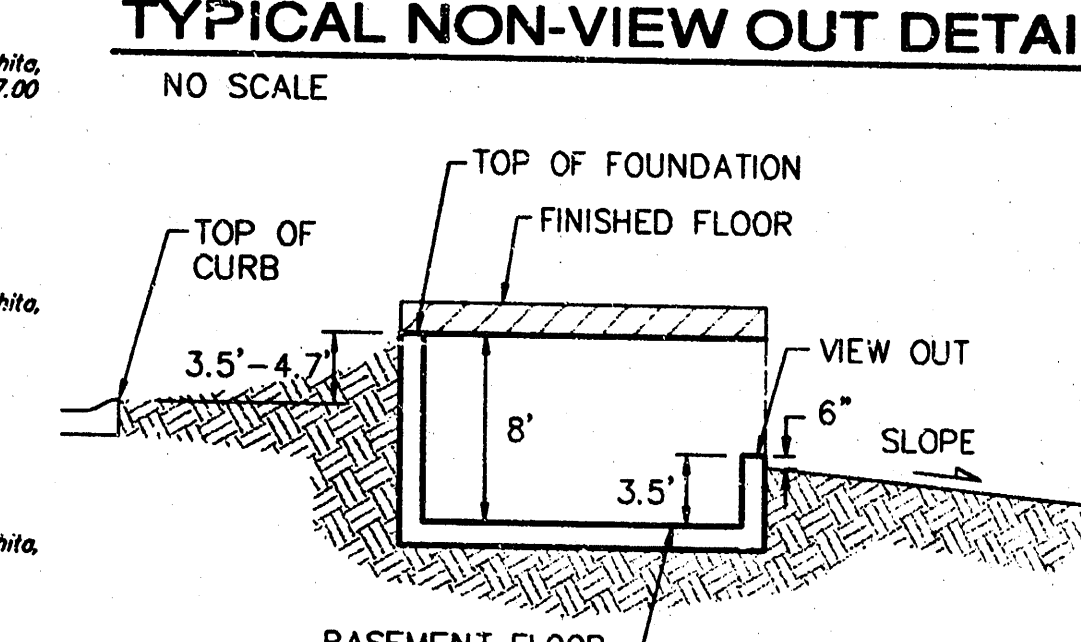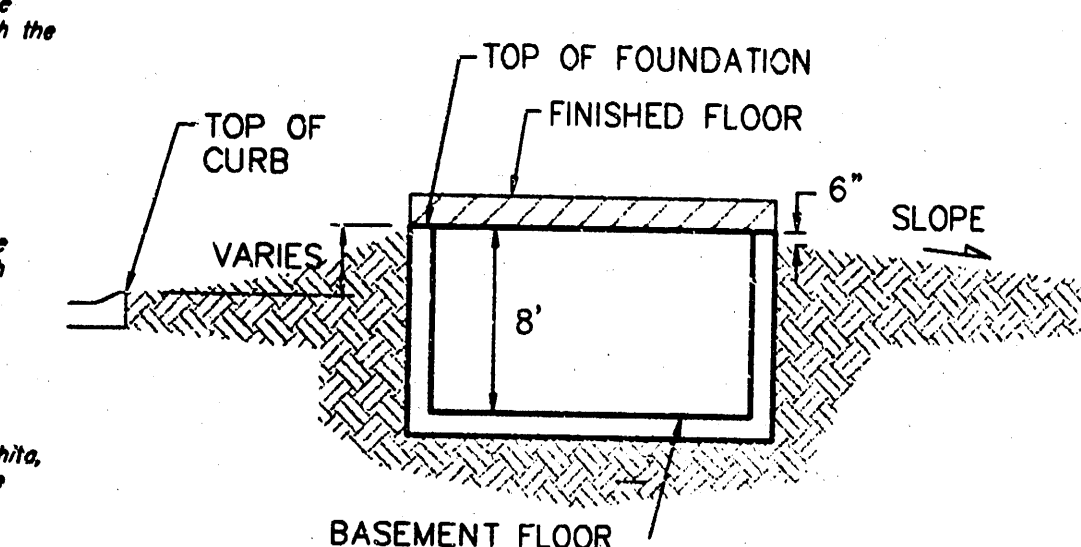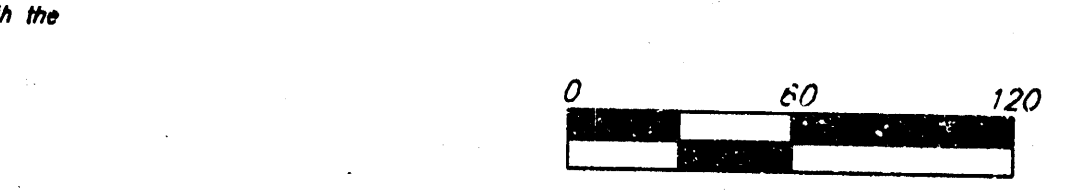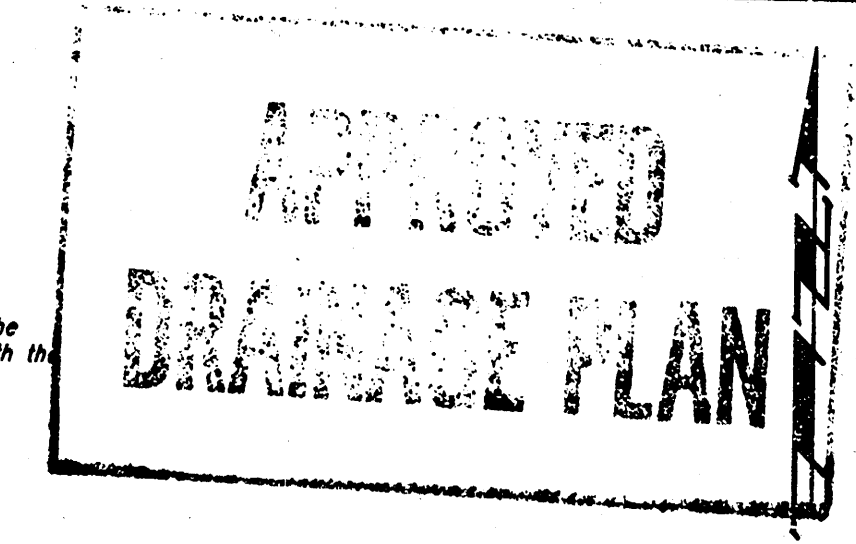

MINIMUM BUILDING PAD ELEVATIONS FOR LOWEST OPENING TO THE STRUCTURES

LOT	BLOCK	ELEVATION CITY DATUM
31-48	A	138.0
34-48	C	138.0

BENCHMARK:
 City of Wichita Benchmark Disc - SW Corner of the intersection of Pawnee & Mole Rd.
 44' South of centerline
 48.8' West of centerline
 12' East of fence
 65' SW of Sec. corner from Elev. = 135.12 City Datum
 1322.52 NGVD29

NOTES:
 Proposed Top of Foundation Elevations Are Shown On Plans. Contractor to Set Finished Floor Elevations.

All Street Elevations Shown on Plans Are for Top of Curb (Full-Height).

This Grading Plan is Designed with View-Outs. Elevations Shown at Rear of House (XXX V.O.).

Lot dimensions have been omitted on this plan, refer to the recorded plat for this information.

* May Require Extra Deep Foundation
 Revised 9/23/03 by AEG, Lot 31, Block C.
 Revised 7/23/03 by SMD PER NEW, pad elevations
 Revised 6/20/03 by SMD PER NEW, pad elevations
 Revised 6/4/03 by SMD PER NEW, pad elevations
 Revised 5/22/03 by BLG, lot split legal
 Revised 5/6/03 by AEG per HGW
 Revised 16 December 2002 by AEG/BLG
 Revised 11 November 2002





SOUTHERN RIDGE ADDITION
GRADING PLAN
 WICHITA, KANSAS

BAUGHMAN COMPANY P.A.
 ENGINEERING, SURVEYING, & PLANNING

315-262-7271 • 315 ELLIS • WICHITA, KANSAS 67211

PROJECT NUMBER: _____ SHEET: **1** OF **2**

DESIGN: BLG/AEG DRAWN: BLG/SMD APPROVED: _____ DATE: 01-02-03 SCALE: NOTED

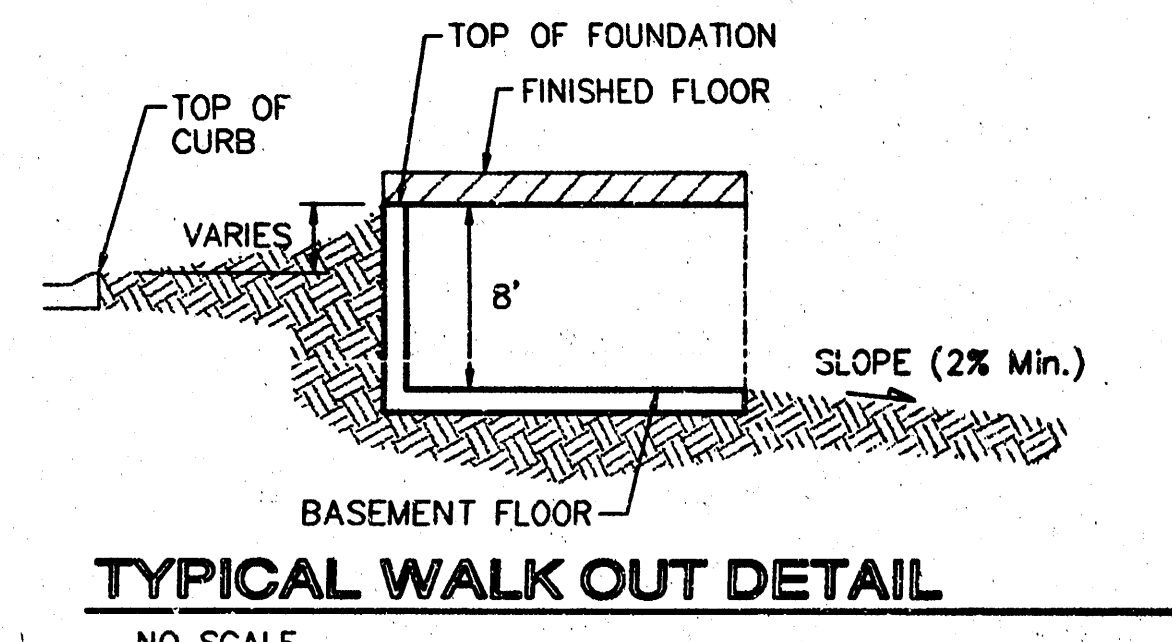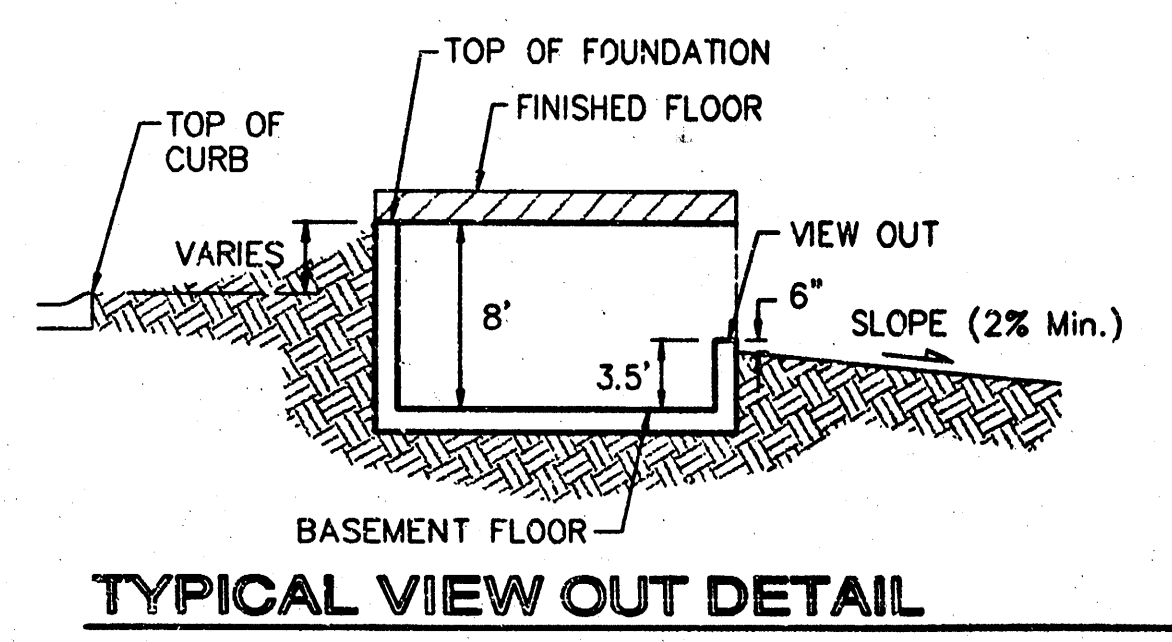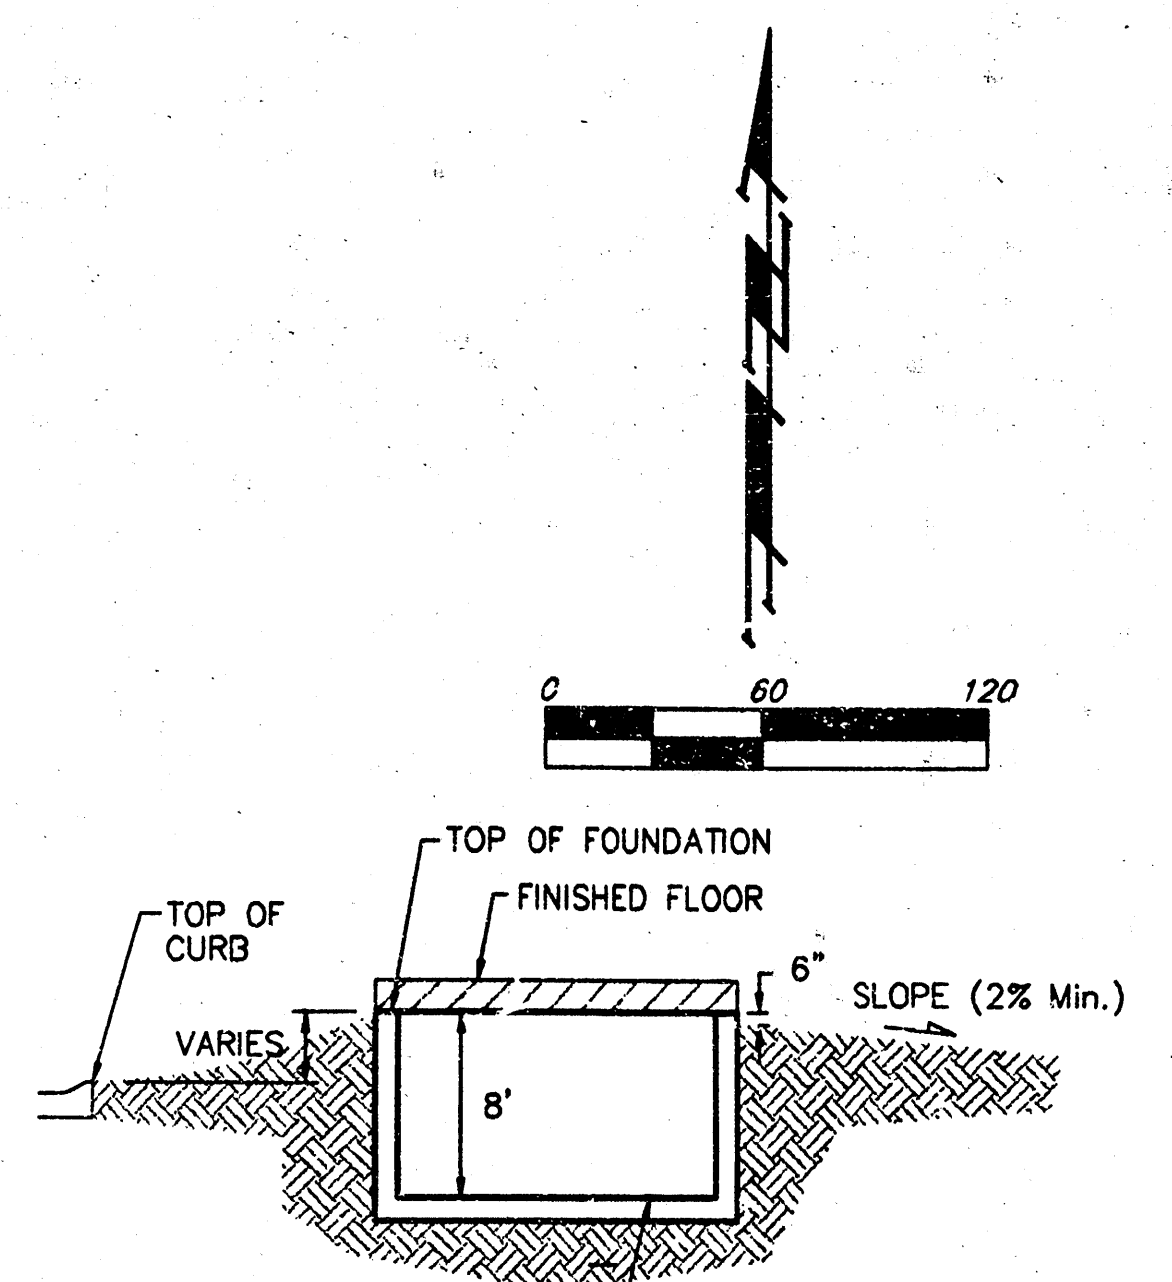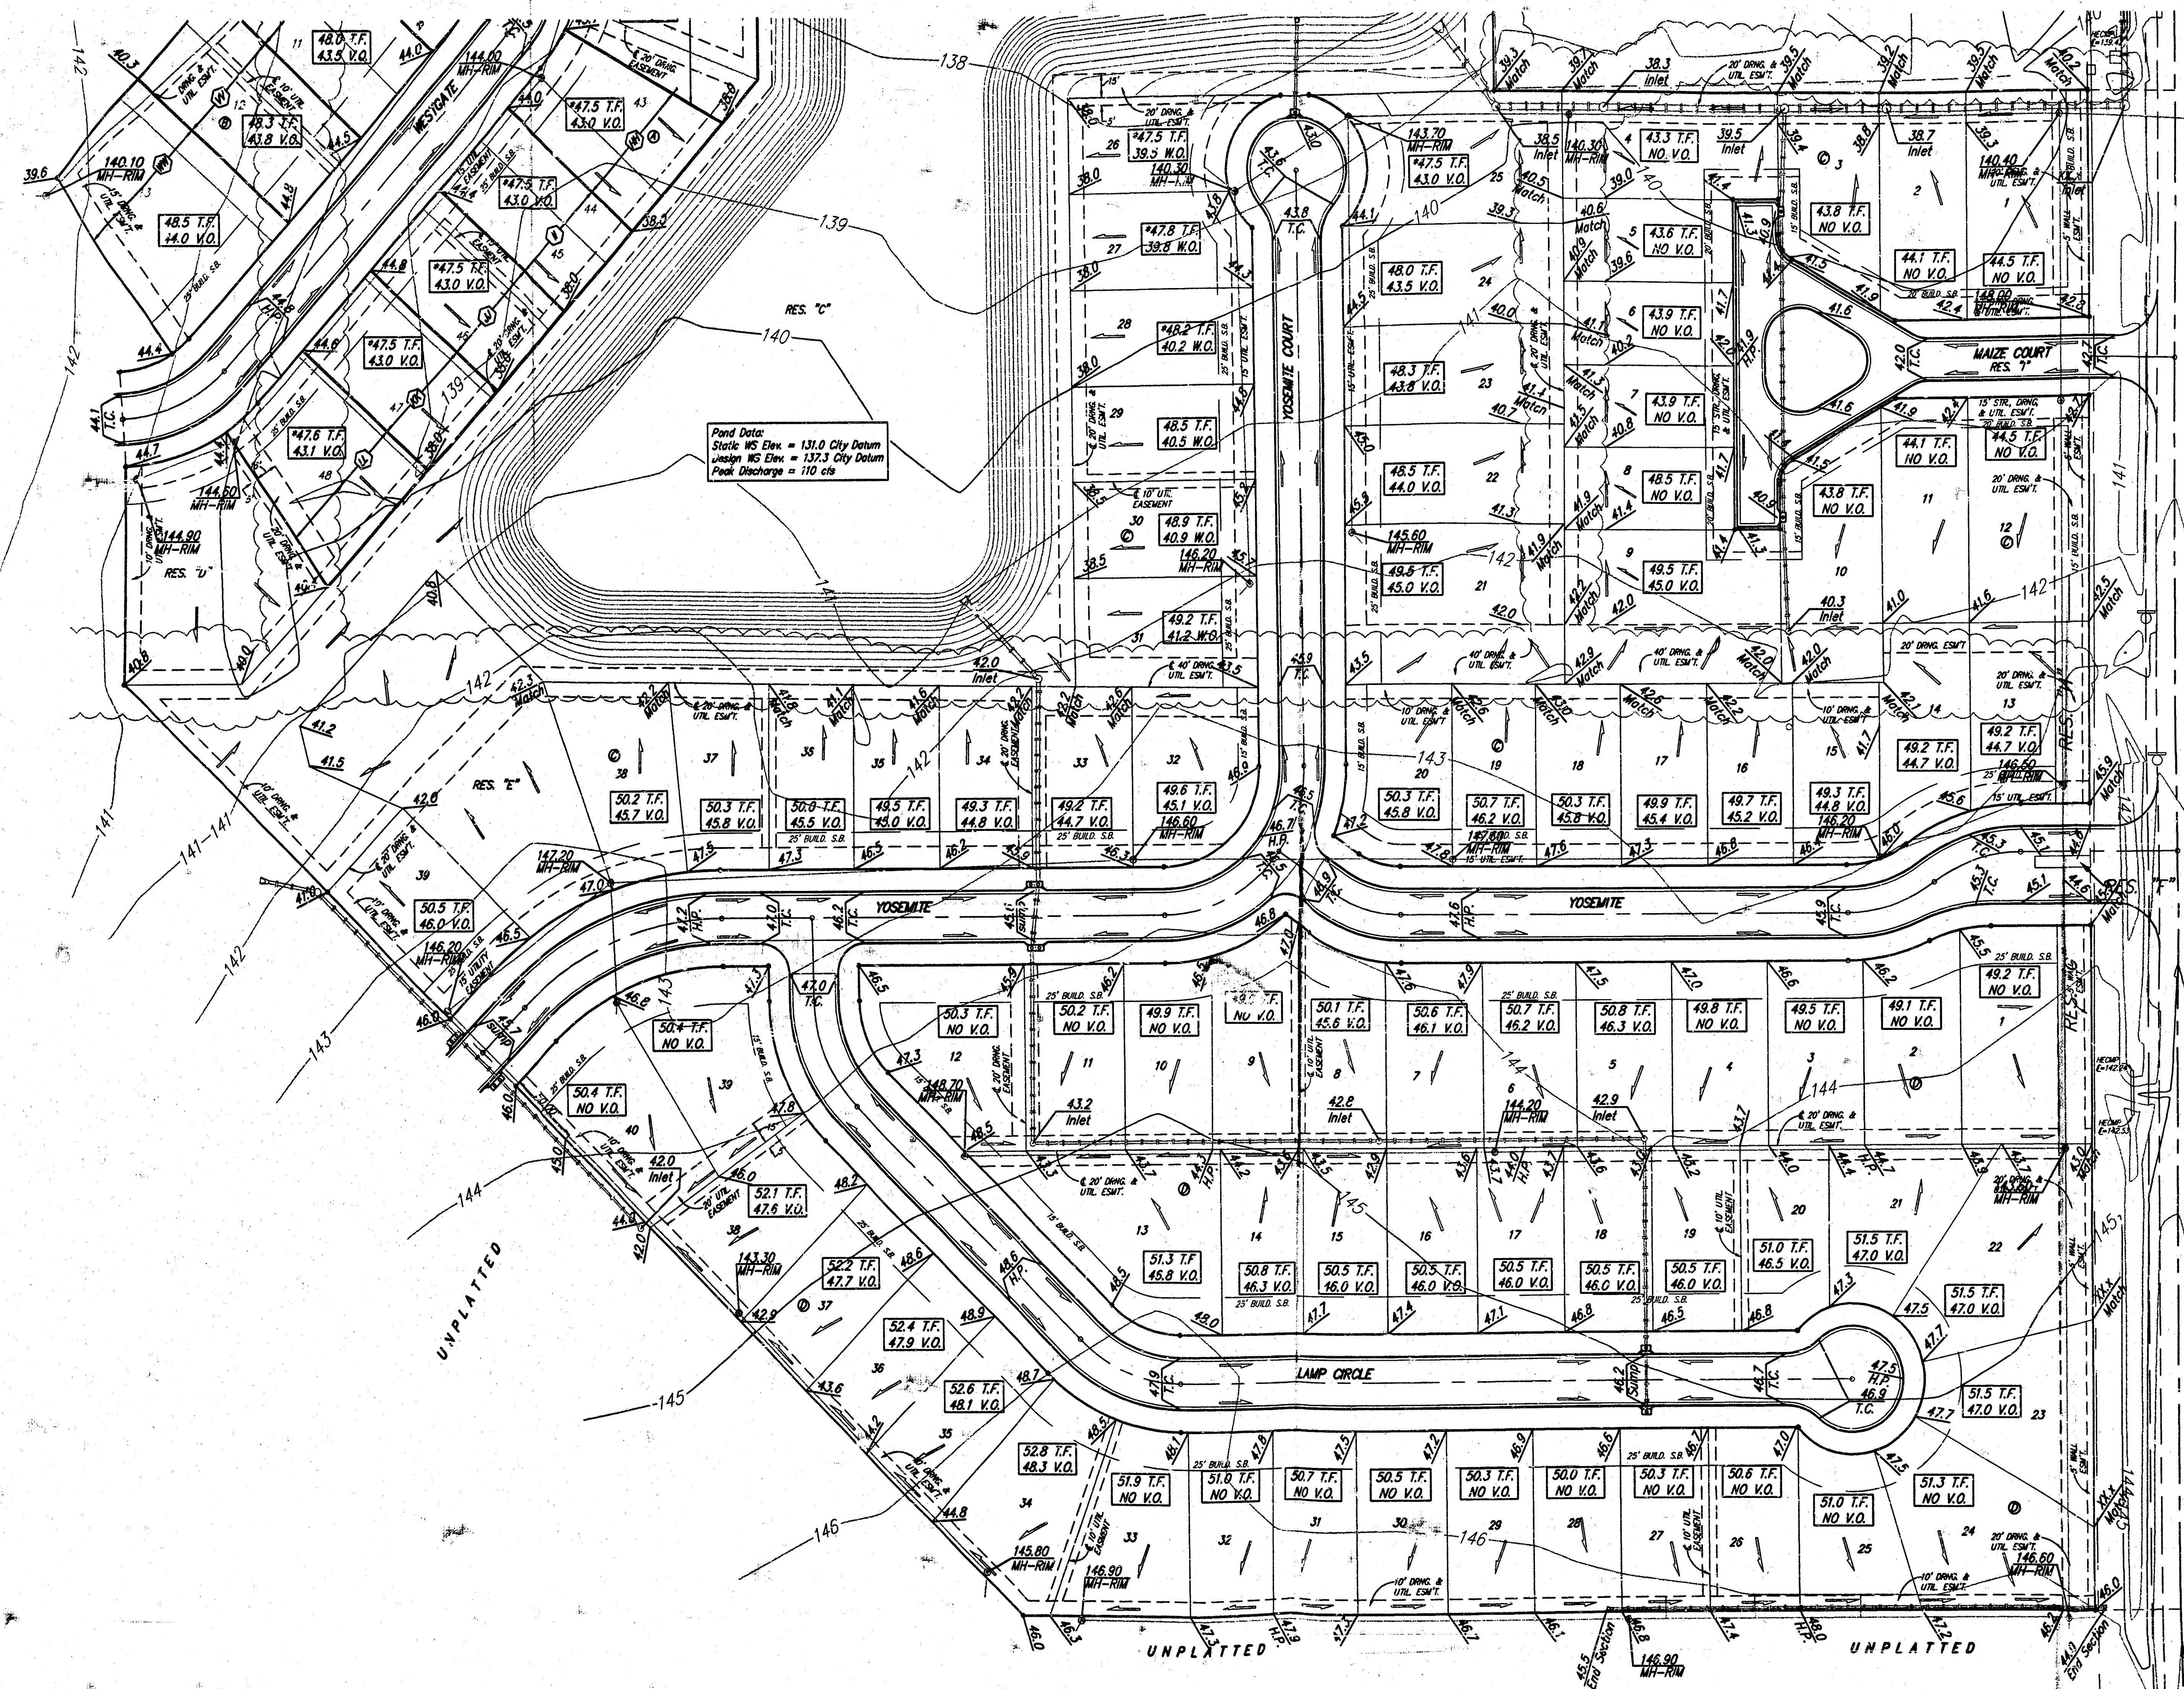

MINIMUM BUILDING PAD ELEVATIONS FOR LOWEST OPENING TO THE STRUCTURES

LOT	BLOCK	ELEVATION
31-48	A	138.0
31-48	C	138.0

BENCHMARK:
SW Corner of the Intersection of
Yosemite & Maize Rd.
44' South of centerline
12' East of fence
65' SW of Sec. corner Iron
Elev. = 135.12 City Datum
1322.52 MGD29

NOTES:
Proposed Top of Foundation Elevations Are Shown On Plans. Contractor to Set Finished Floor Elevations.
All Street Elevations Shown on Plans Are for Top of Curb (Full-Height).
This Grading Plan is Designed with View-Outs. Elevations Shown at Rear of House (XX.X V.O.).
Lot dimensions have been omitted on this plan, refer to the recorded plat for this information.
* May Require Extra Deep Foundation

Revised 6/4/03 by SMD PER NSM, pad elevations
Revised 5/22/03 by BLG, lot split legals
Revised 5/6/03 by AEG per NSM
Revised 16 December 2002 by AEG/BLG
Revised 11 November 2002

SOUTHERN RIDGE ADDITION
GRADING PLAN
WICHITA, KANSAS

BAUGHMAN COMPANY P.A.
ENGINEERING, SURVEYING, & PLANNING
316-262-7271 • 316 ELLIS • WICHITA, KANSAS 67261

PROJECT NUMBER: 07-02-03
DATE: 07-02-03
SCALE: NOTED

DESIGN: BLG/AEG
DRAWN: BLG
APPROVED: [Signature]
DATE: 07-02-03
SCALE: NOTED

SHEET 2 OF 2