

STARK'S 2ND ADDITION
(Drainage)

BAUGHMAN COMPANY, P.A.
SURVEYING & ENGINEERING
316/262-7271 • 330 LAURA • WICHITA, KANSAS 67211

CONFIRMATION
MEMO

PROJECT STARK'S 2ND ADDITION

DATE 2-20-84

JOB NO.

COPIES TO:

TO Chris Breitenstein

FROM N. Brent Wooten

REFERENCE Final Drainage Plan

Final plat is scheduled for subdivision for March 1, 1984.


The lot will be developed for commercial with a runoff factor of 0.85 used. Lot 1 will drain to Central thru the driveway. Lot 2 will drain to Central or Doris thru the driveways. Central drains east and north on Doris to existing storm sewer located at Elm which is one block to the north.

OK

PAGE 1 OF 1

drainage plan 2-20-84

Bench mark:
City dist. 34 feet east & 42
feet north of centerline inter-
section of Hoover & Central
Elevation = 123.29 City Datum

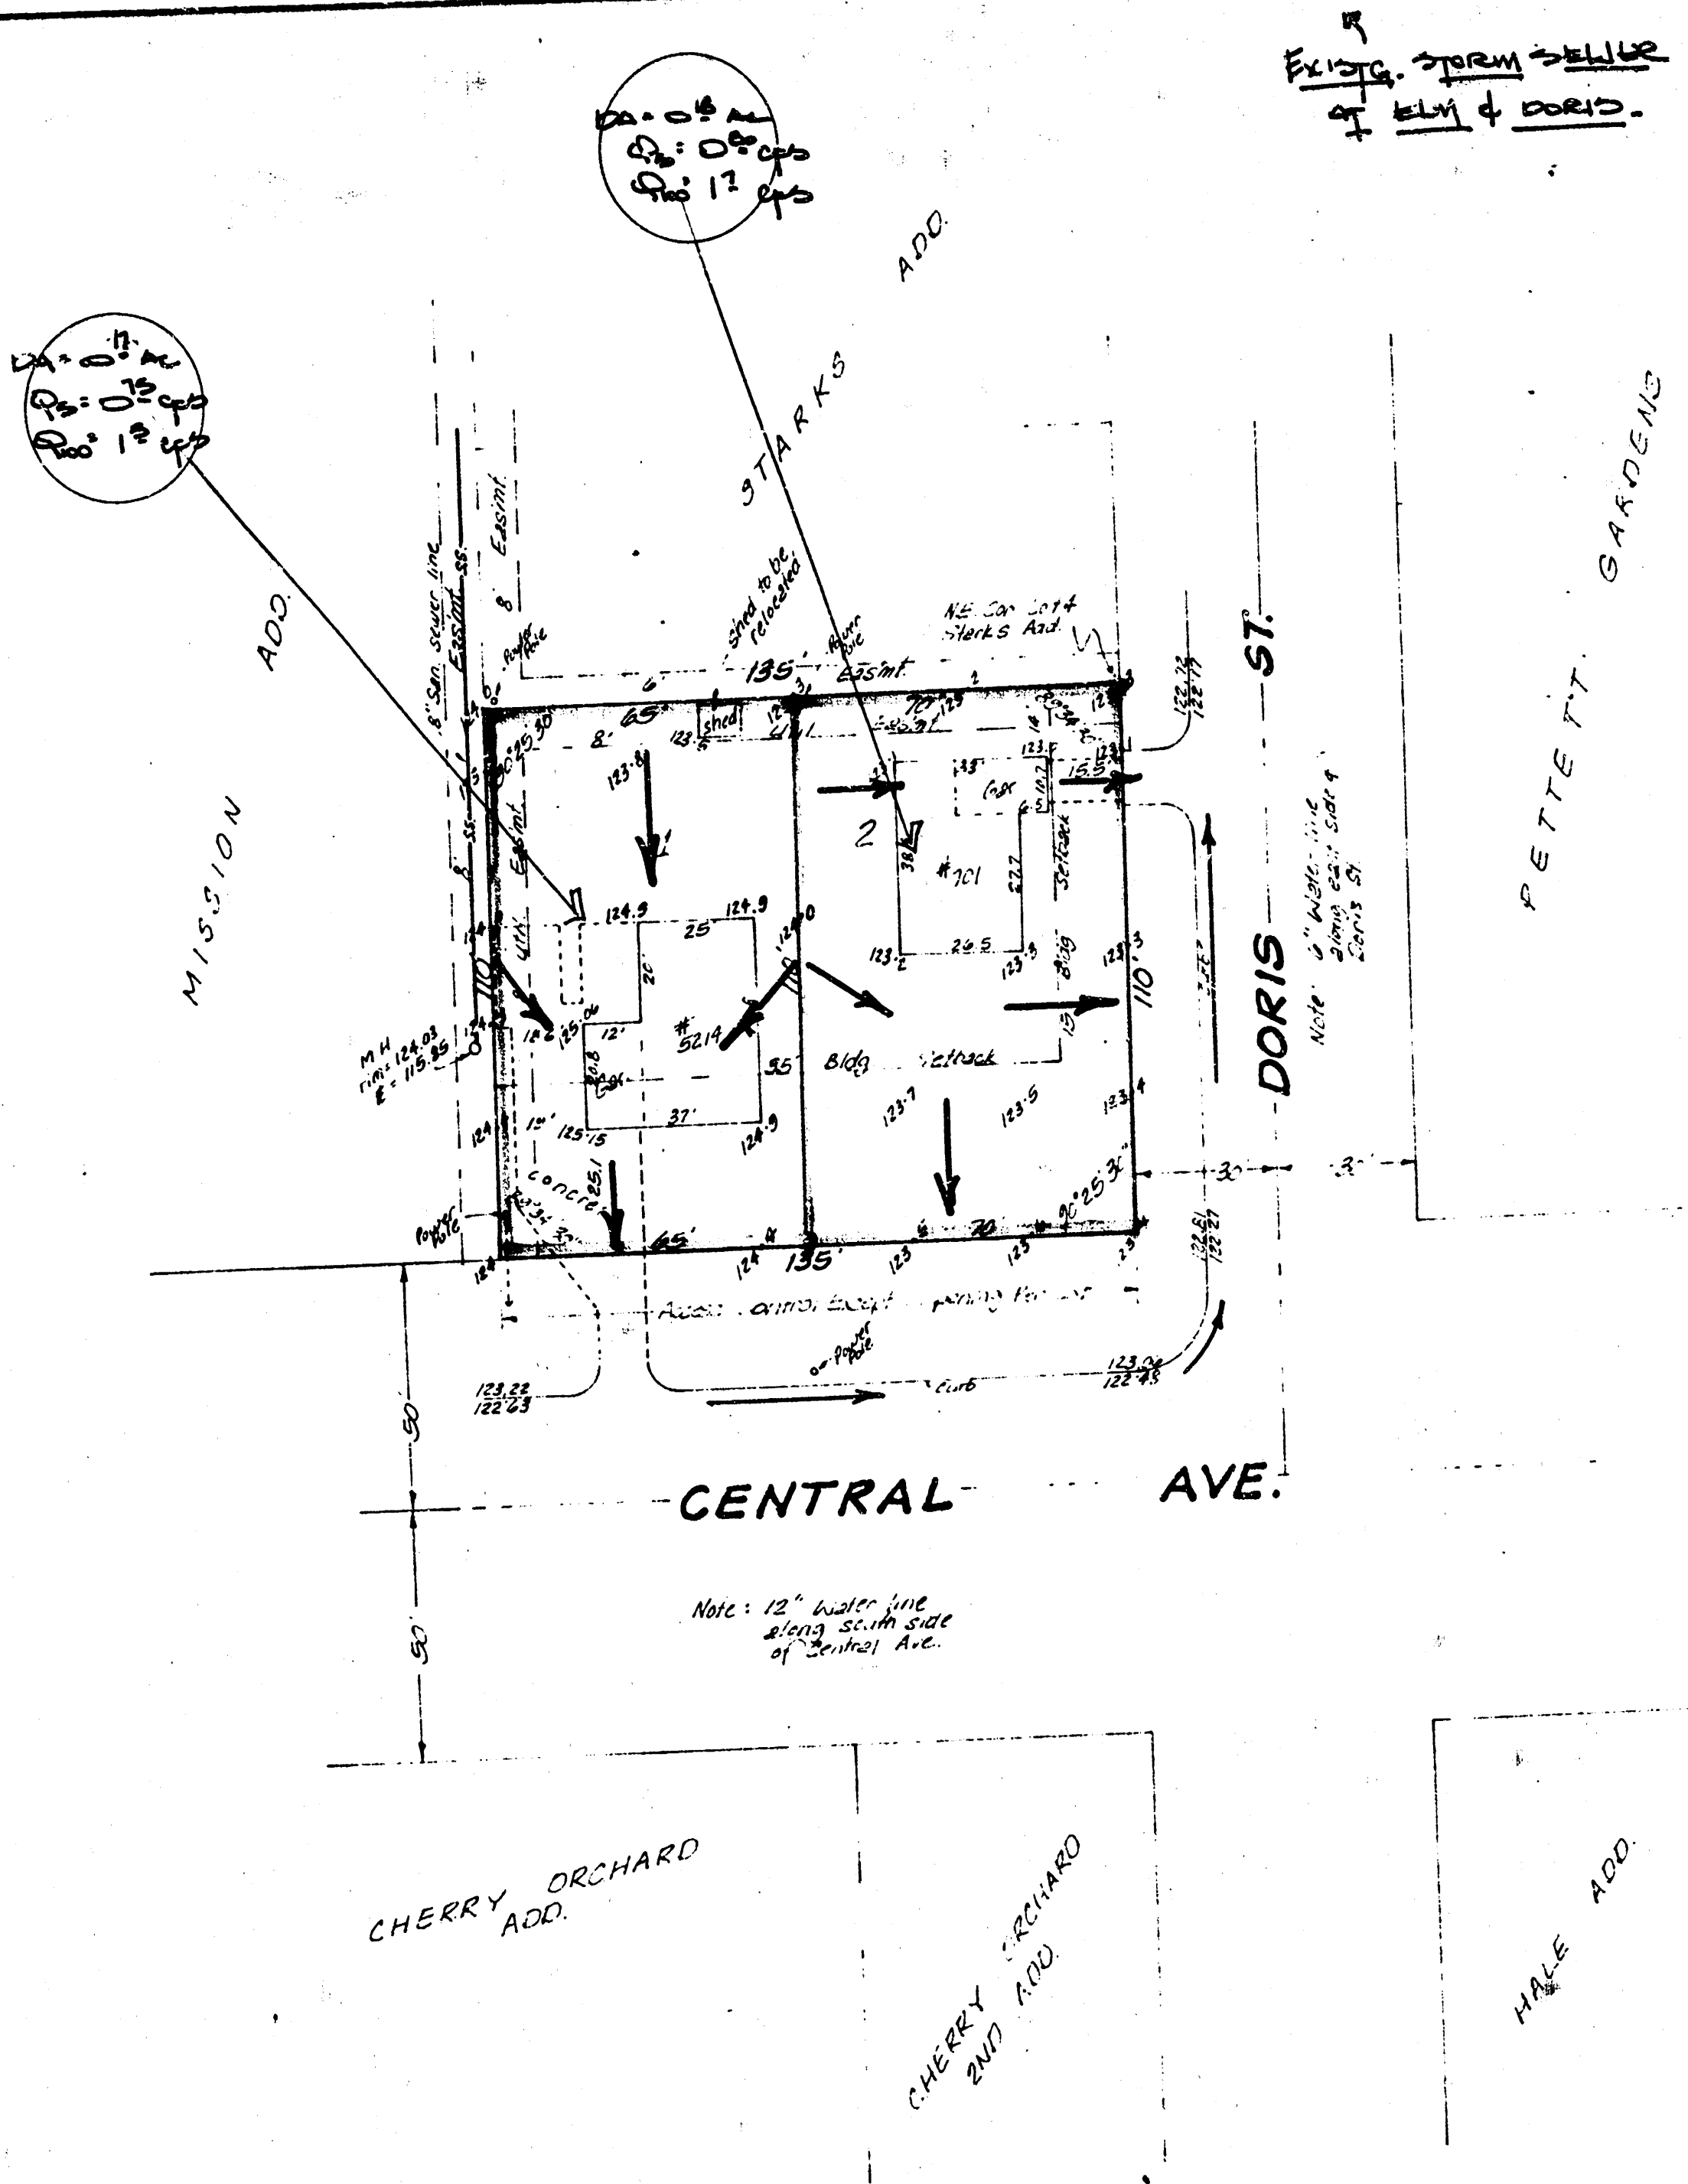

SKETCH PLAT
STARK'S 2ND ADDITION

LOTS 3 & 4, STARK'S ADDITION
TO WICHITA, SEDGWICK COUNTY,
KANSAS

LEWIS C. STARK

BAUGHMAN COMPANY, P.A.
SURVEYING & ENGINEERING
316/262-7271 • 330 LAURA • WICHITA, KANSAS 67211

FEB 17, 1984