


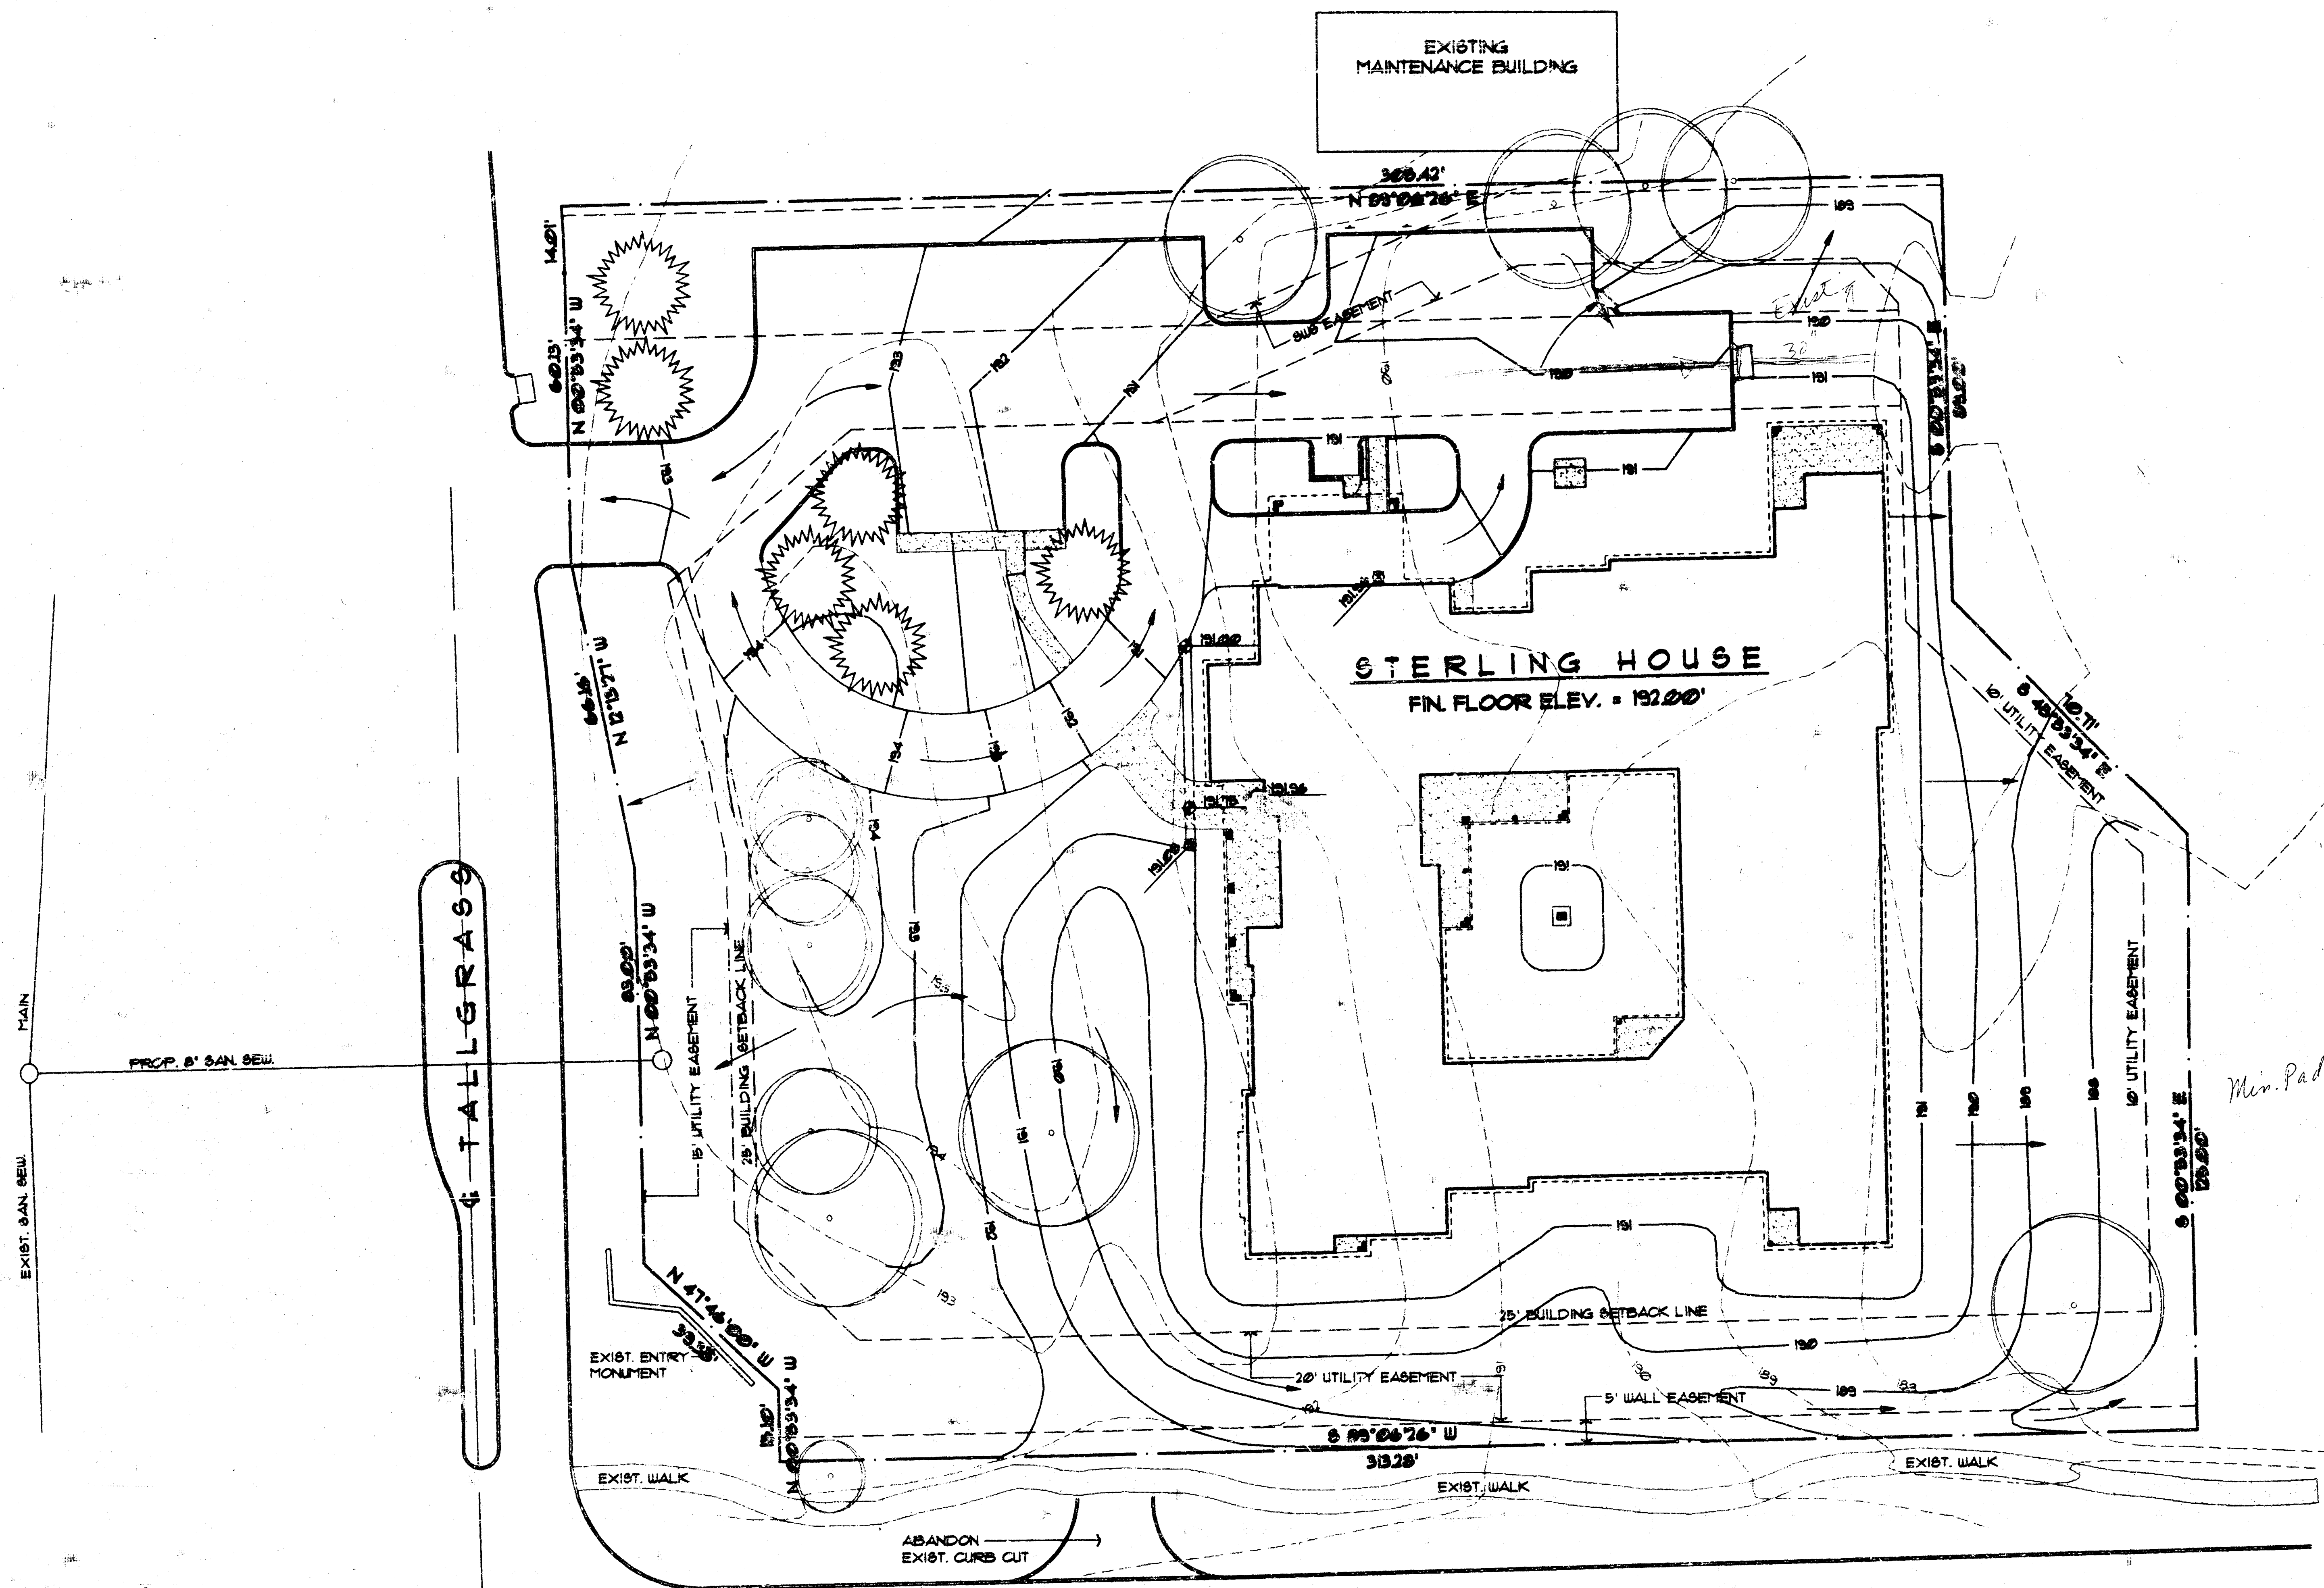

21st STREET NORTH

SITE GRADING PLAN

1" = 20' = 5'




STERLING HOUSE
DRAINAGE & UTILITY PLAN

MID-KANSAS ENGINEERING CONSULTANTS, INC.
3500 N. ROCK ROAD #200
WICHITA, KANSAS 67228
PH. 620-5566

Drawn by	GJA
Checked by	GJA
Date	7/92
Job No.	SITE-2
Sheet	1
Total	1

SITE GRADING PLAN
Sheet
SHT

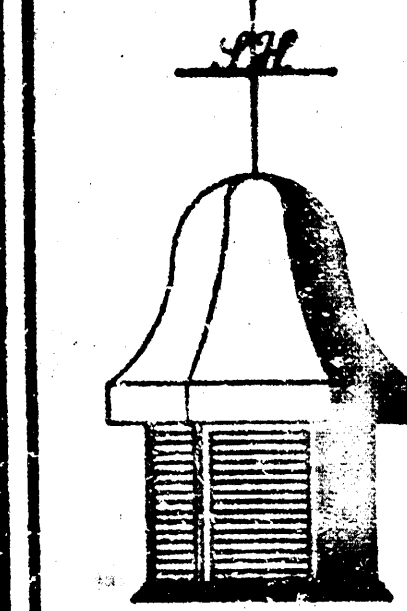

STERLING G
H O U S E

WICHITA, KANSAS

© 1992 STERLING HOUSE
COPYRIGHTED MATERIAL
REPRODUCTION OR TRANSMISSION
IN ANY FORM OR BY ANY MEANS
WITHOUT PERMISSION IS PROHIBITED

COPYRIGHT © 1992
Wilson Darnell Associates, P.A.

print issued

WDA No. 92-053

Drawn by DS

Sheet CS

Wilson Darnell Associates, P.A.
architecture
interiors
planning
128 North Olive
Wichita, Kansas 67208
316-267-2000