


SUTHERLAND SIXTH ADDITION
(Drainage)

WALNUT ST.

HANDLEY AVE.

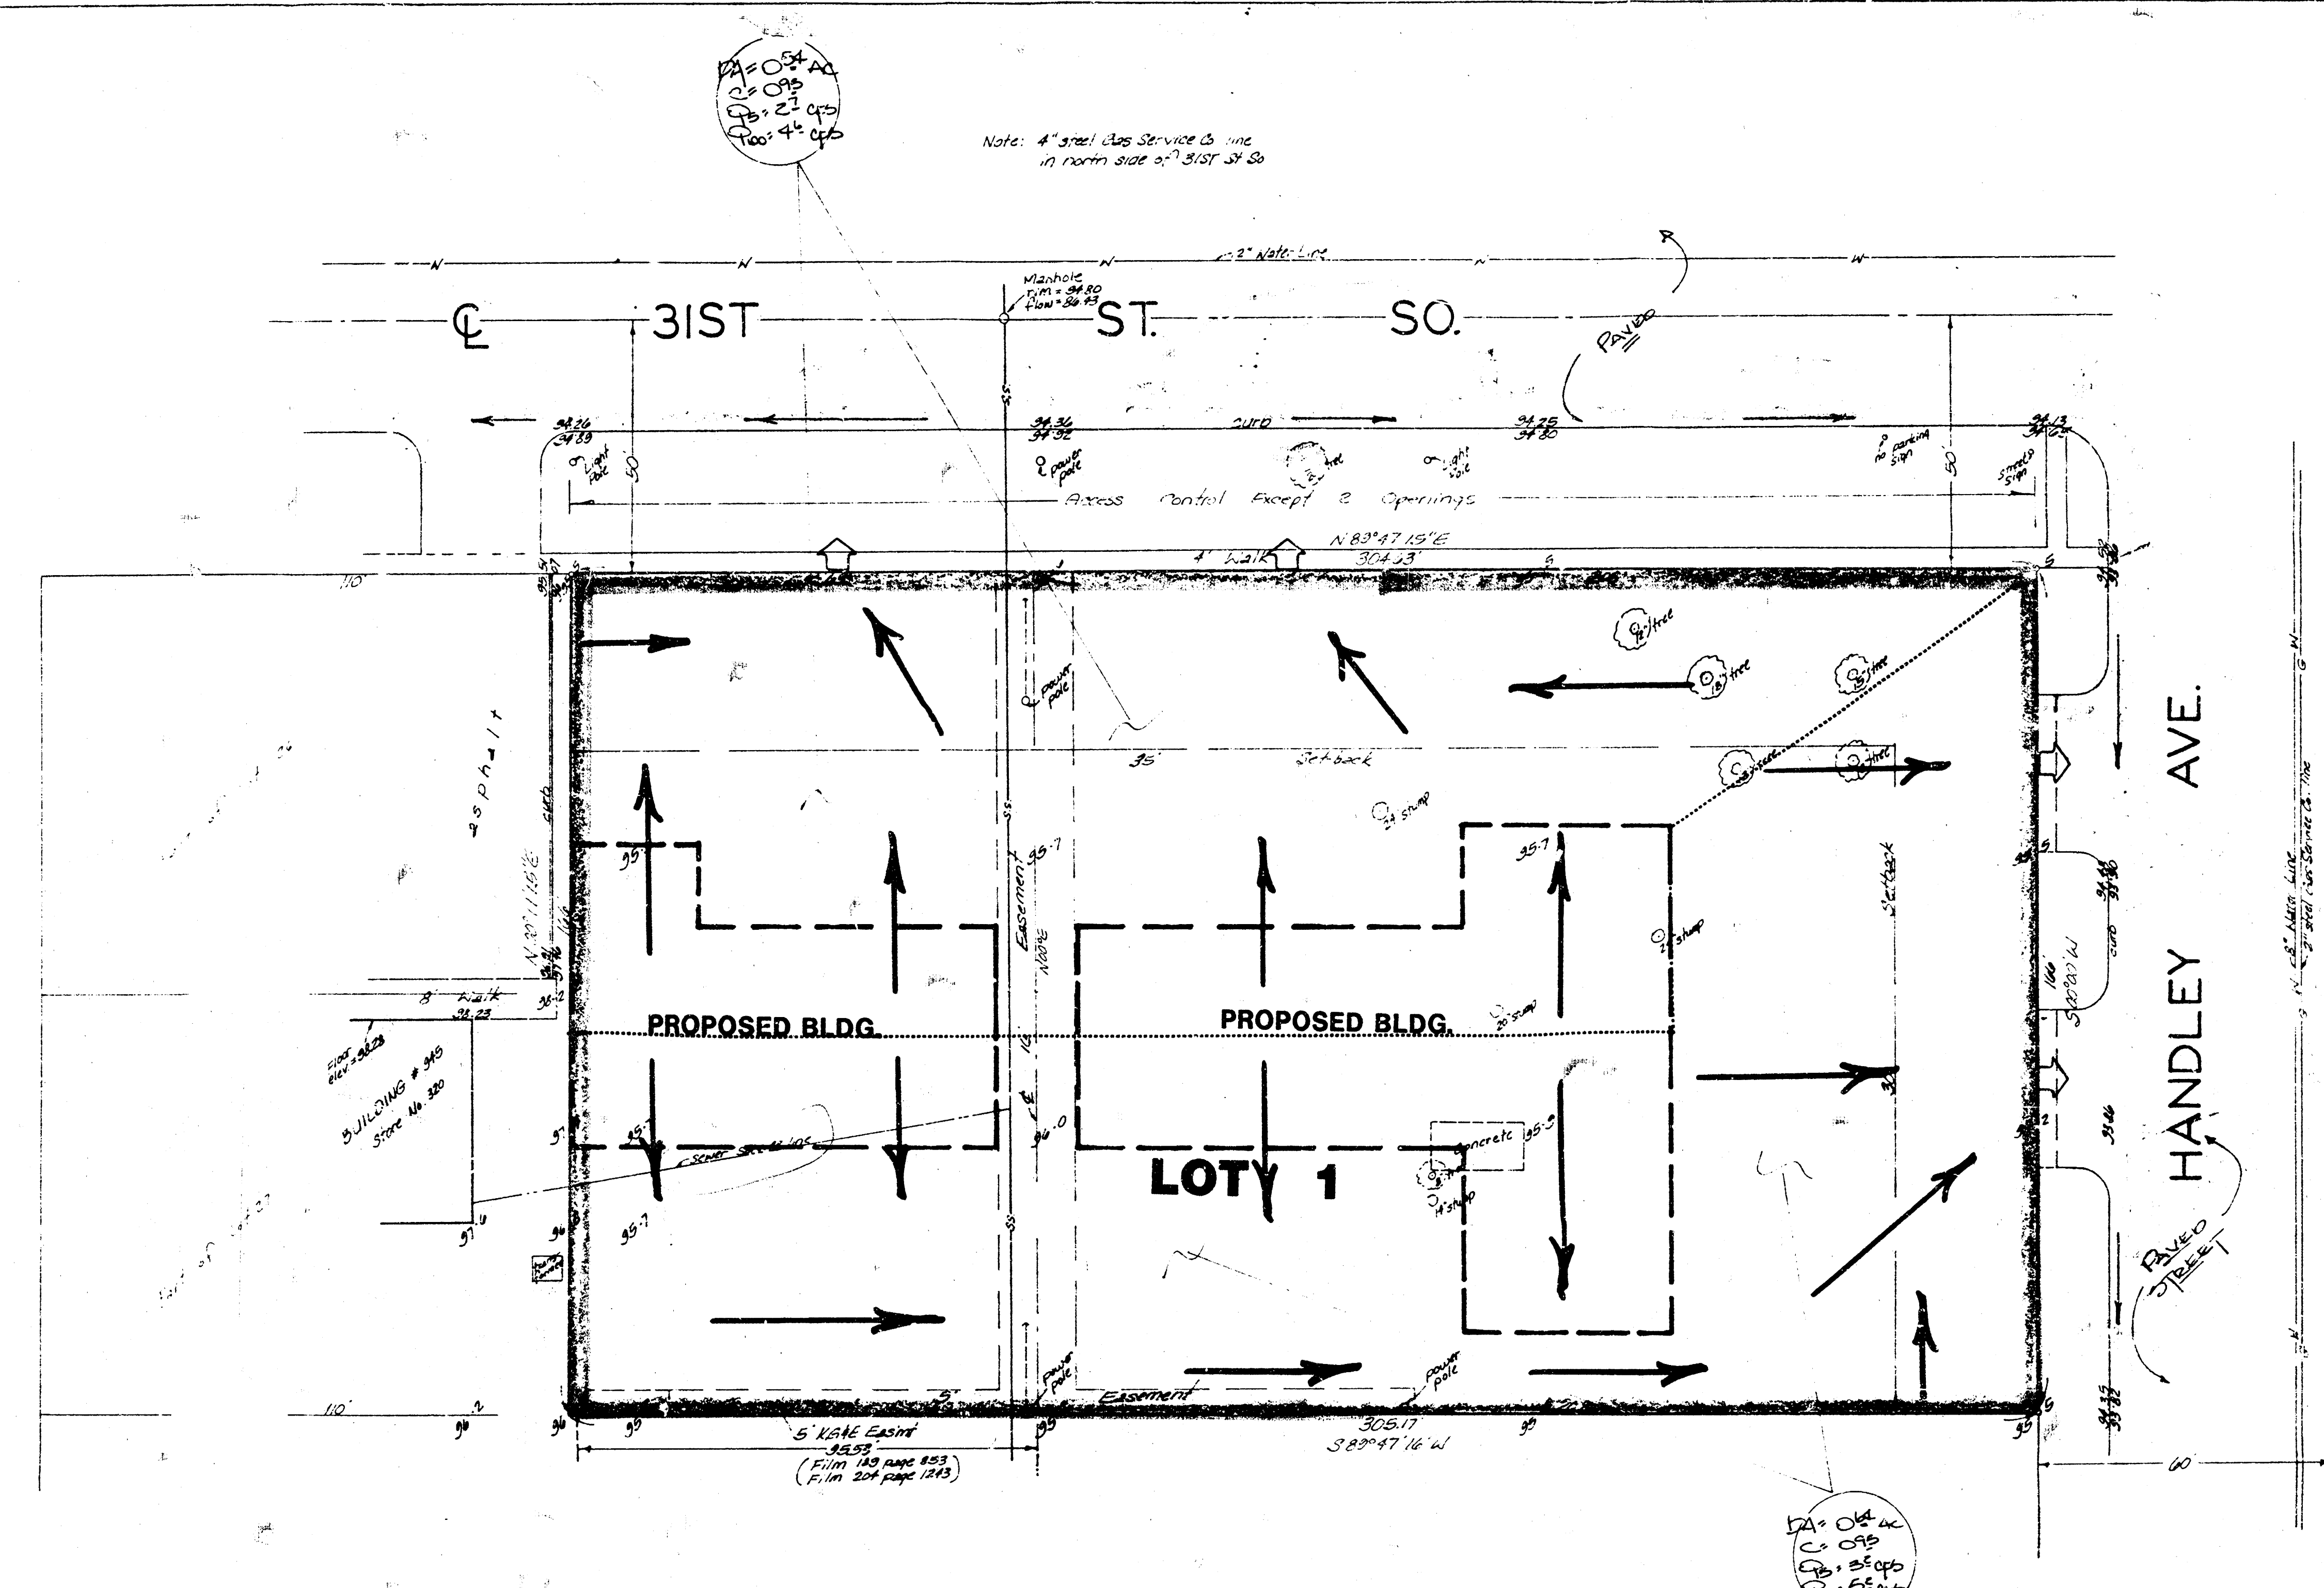


SKETCH PLAT

SUTHERLAND SIXTH ADDITION

LOTS 26 AND 27, EXCEPT THE WEST 110 FEET THEREOF, ALL OF LOTS 24 AND 25,
SLEAZE 2ND. ADDITION TO WICHITA, SEDGWICK COUNTY, KANSAS.

H. STAN CHILTON

DRAINAGE PLAN

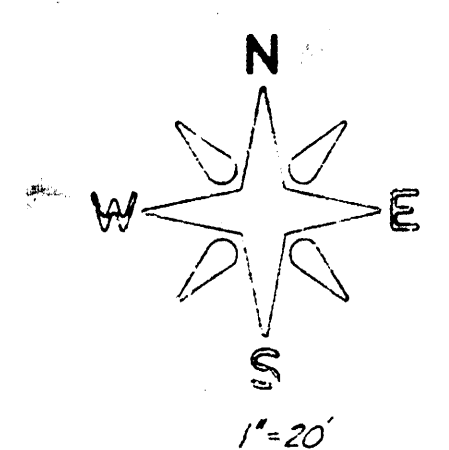

Bench mark:
Railroad spike in south end of
Highland park at the S.W. corner
of 31st St. & Silver St.
Elevation = 95.35 City Datum

NOTE:
Runoff factor for the commercial site = 0.15.
Runoff will drain to 31st St. So. & Handley
Discharge will be then denied (if possible)
or flumes if necessary.
31st St. drains basically east and south
on Handley. The closest storm sewers
are located at 33rd St. So.

BAUGHMAN COMPANY, P.A.
SURVEYORS
316/262-7271 • 230 LAURA • WICHITA, KANSAS 67211