


SUTHERLAND LUMBER NORTH ADDITION
(Drainage)

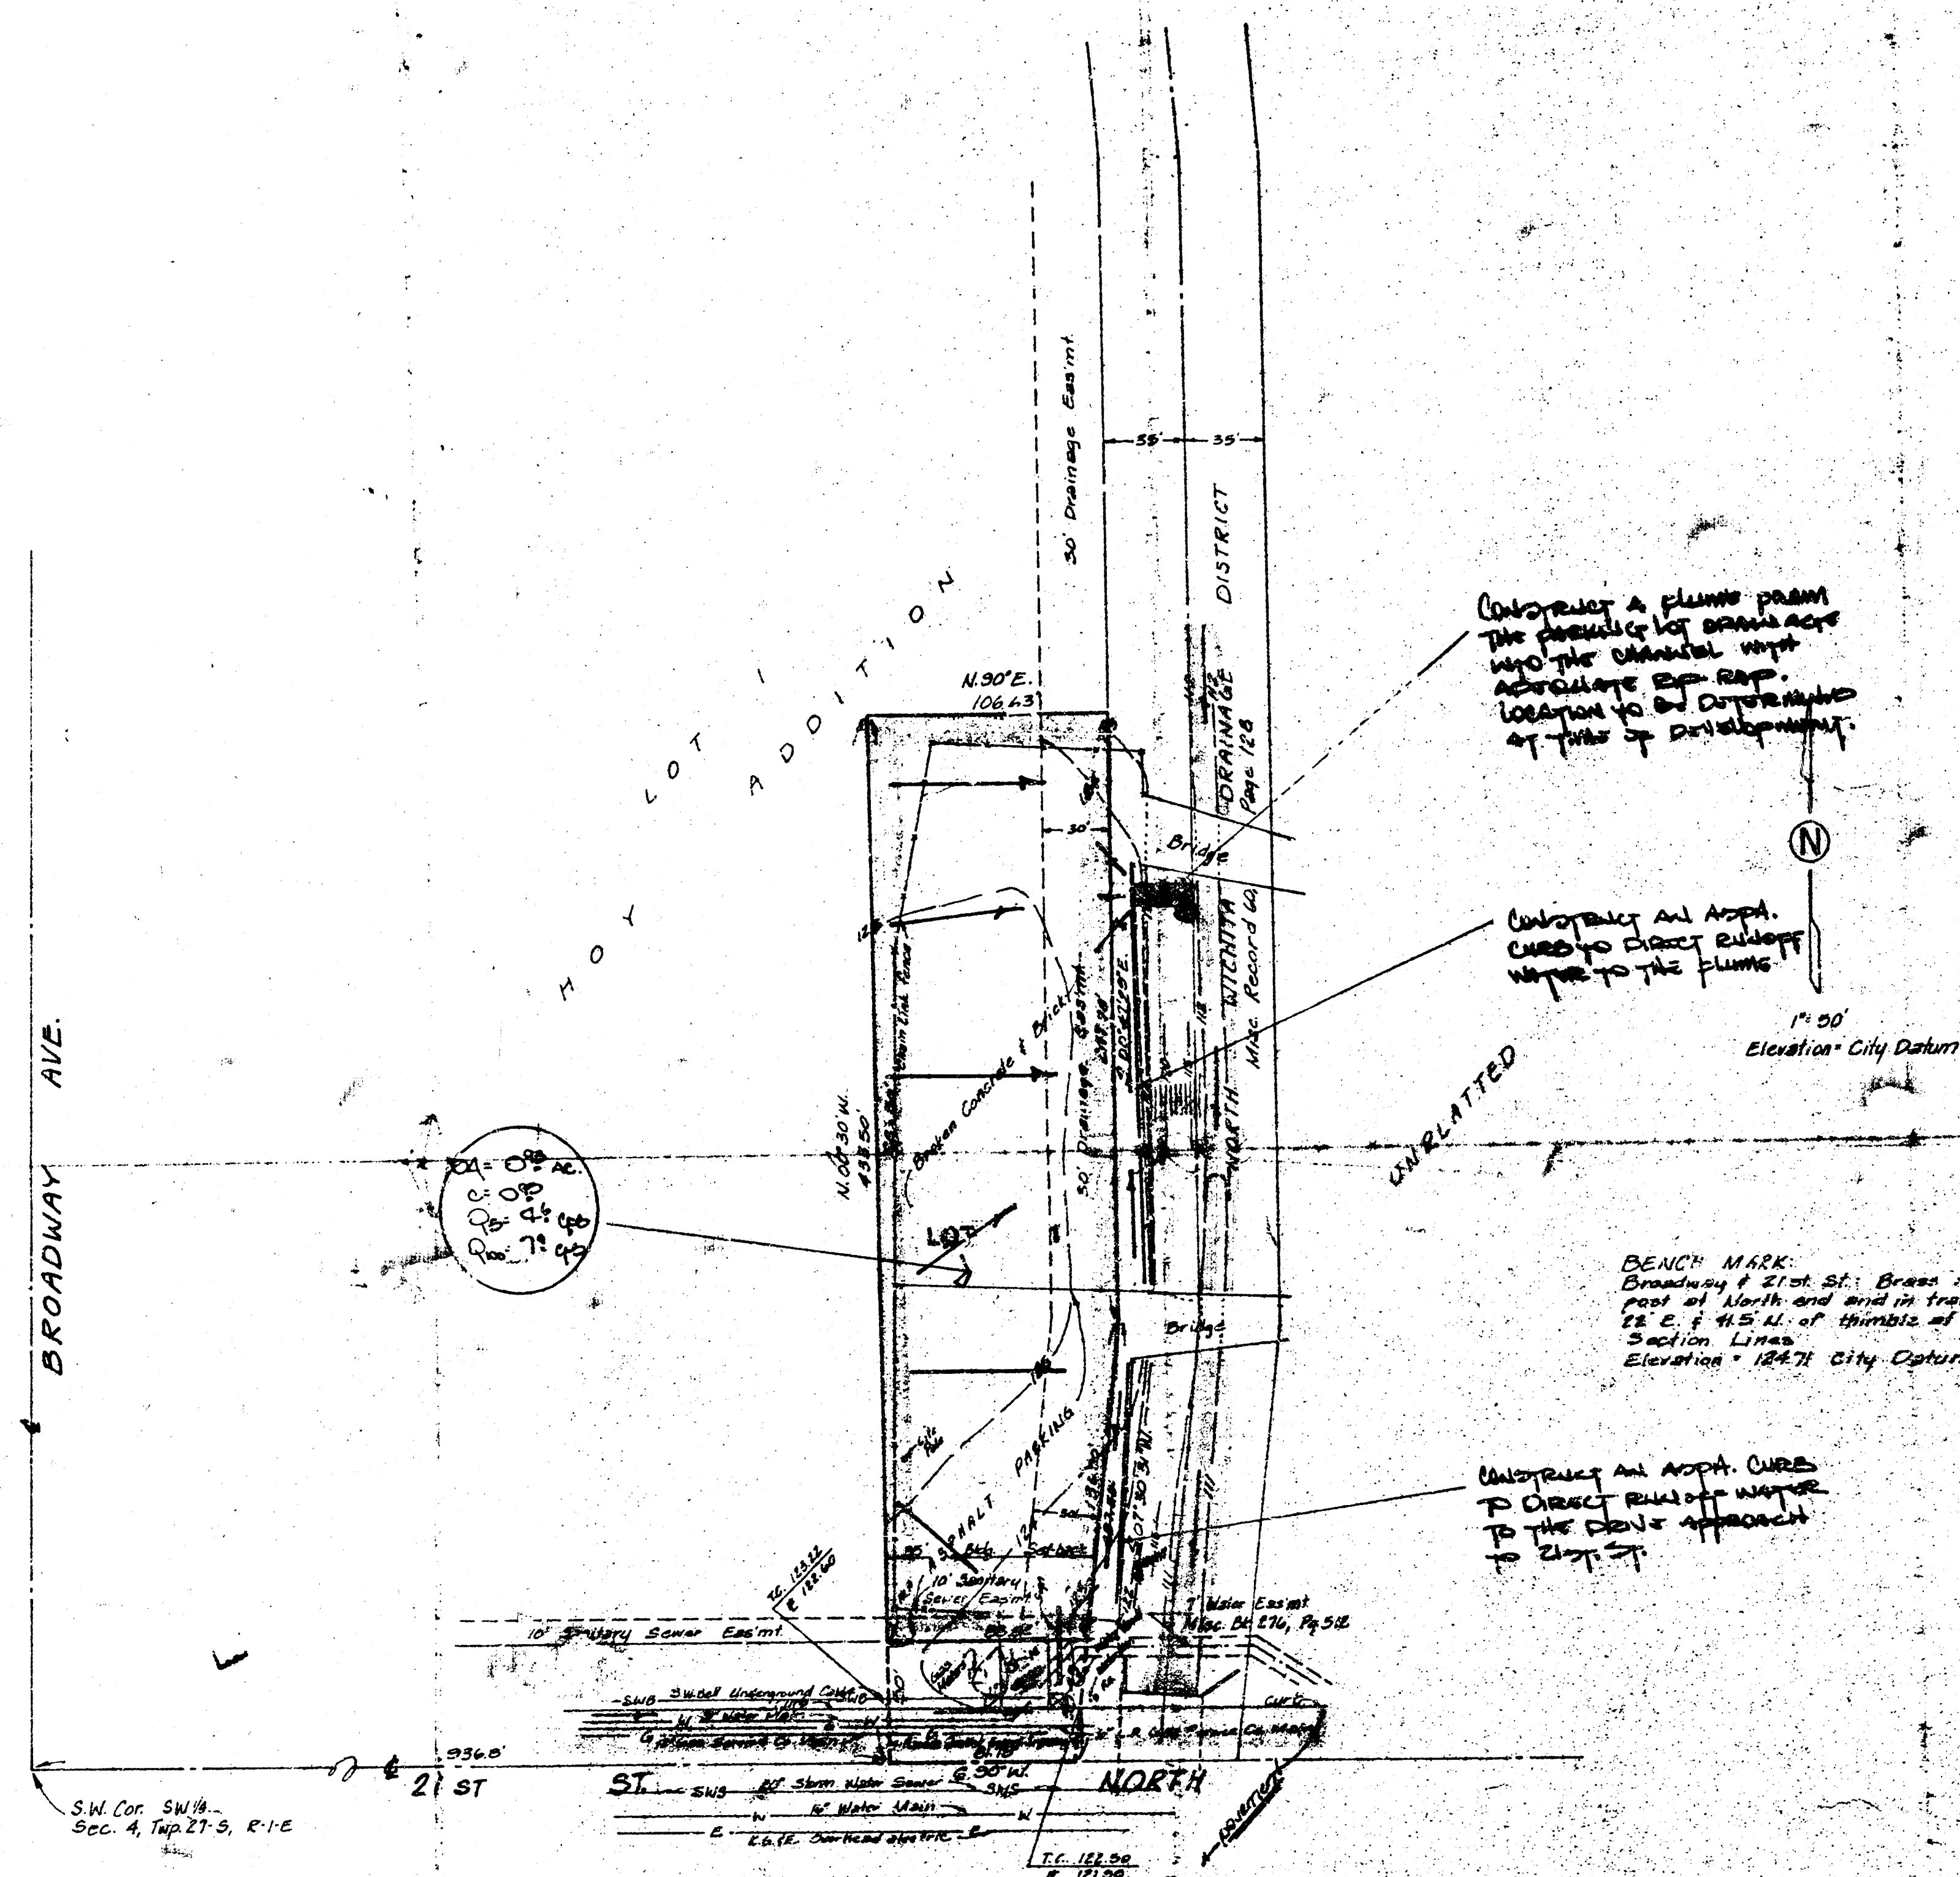

SKETCH PLAT

SUTHERLAND LUMBER NORTH

PART OF THE 3 1/2 OF THE 6 1/4 OF THE 8 1/4 OF
SEC. 4, TWP. 27-3, R. 1-E

SUTHERLAND LUMBER, A KANSAS LIMITED PARTNERSHIP

DRAINAGE PLAN

RECEIVED
DEC 4 1985
REG. GN DIVISION

LAUGHMAN COMPANY, P.A.