


THUNDERBIRD 4TH ADDITION
(Drainage)

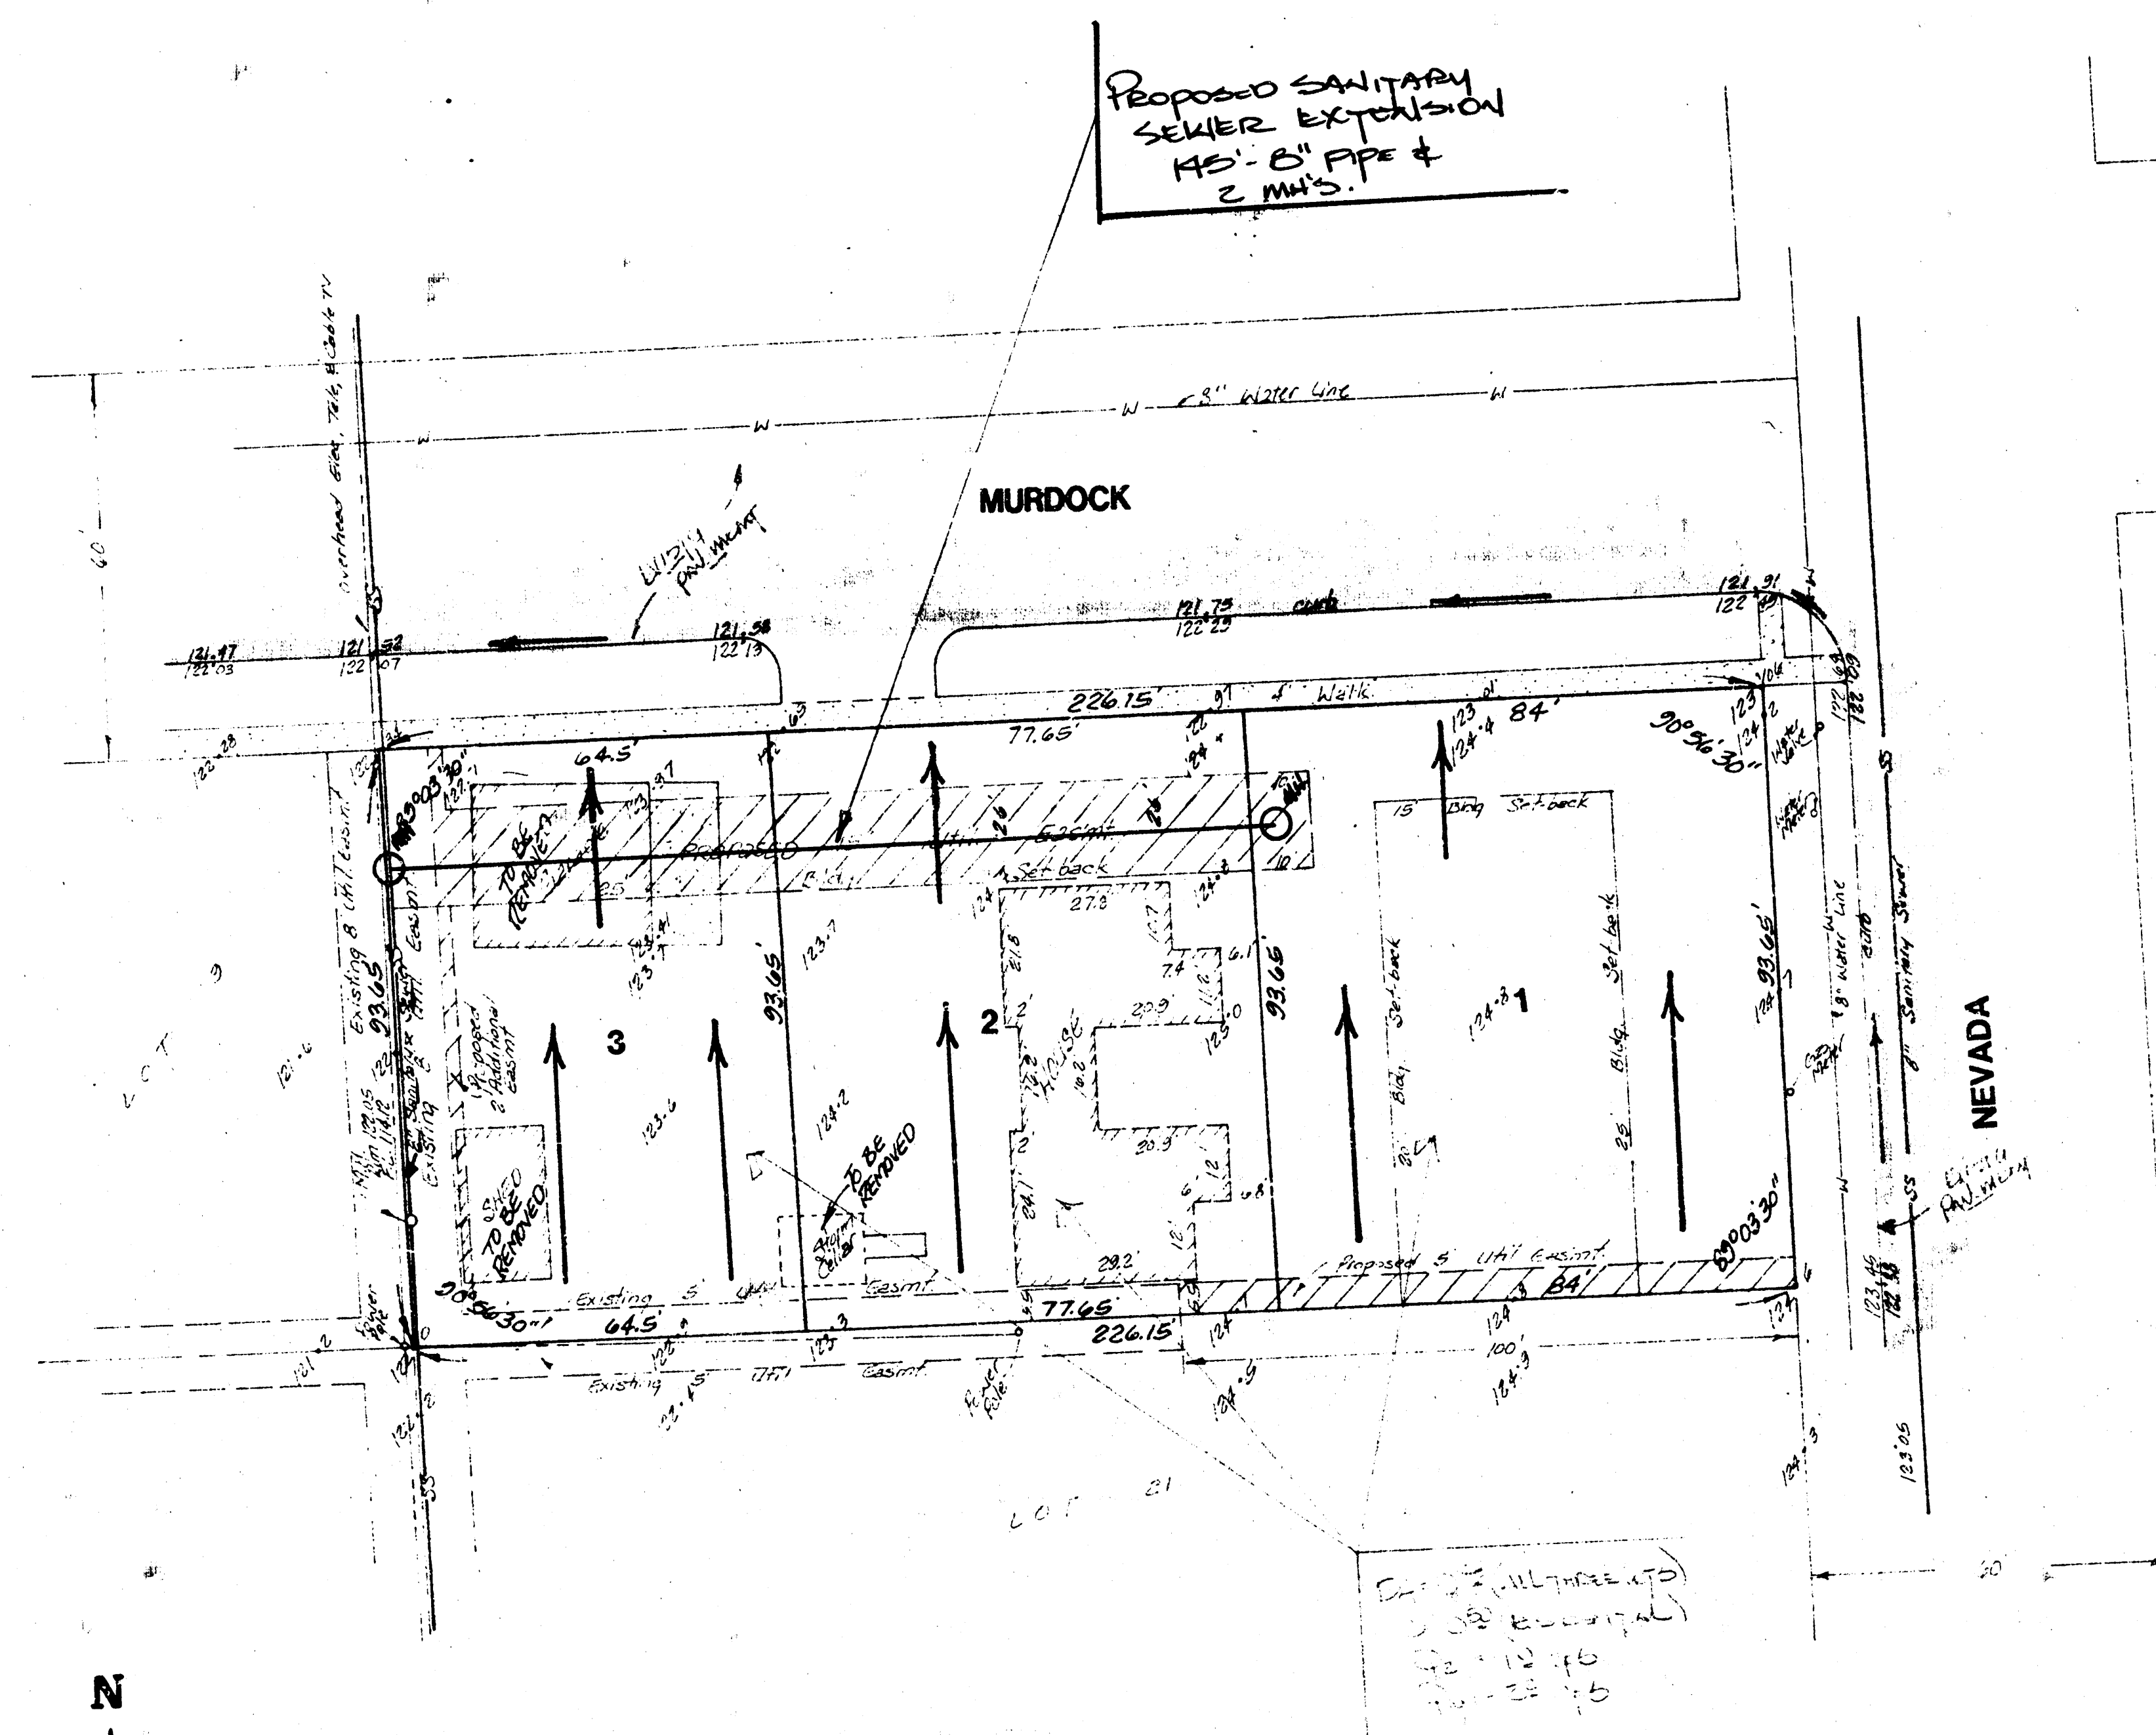

SKETCH PLAT
THUNDERBIRD 4TH ADDITION
LOT 22, REPLAT OF LOTS 3, 4, 5, 6, 7, 8, 9, CENTRAL
PLACE ADDITION, SEDGWICK COUNTY, KANSAS.

OWNER: DAVID W. ENTRIKEN

DRAINAGE PLAN C-1-85



1" = 20'
ELEV. = CITY DATUM

SEWAGE MARK:
CH. Standard Date: 11/3/82 W. of E. West of
E. of N. of N.
Elev. = 121.00 City Datum

SEWAGE MARK: (CH.)
W. of N. of N. over line at S.W. Cor. of
Murdock & Nevada
Elev. = 123.00 City Datum

GENERAL NOTES

The lots in this plat are to be residential lots with a runoff factor of 0.50 used in the calculations. The lots when developed will drain north to the pavement on Murdock which drains to the west. Discharge to the street will be thru driveways.

BAUGHMAN COMPANY, P.A.
SURVEYING & ENGINEERING
316-262-7271 • 300 LAURA • WICHITA, KANSAS 67211