


Timber Grove Lakes 2nd

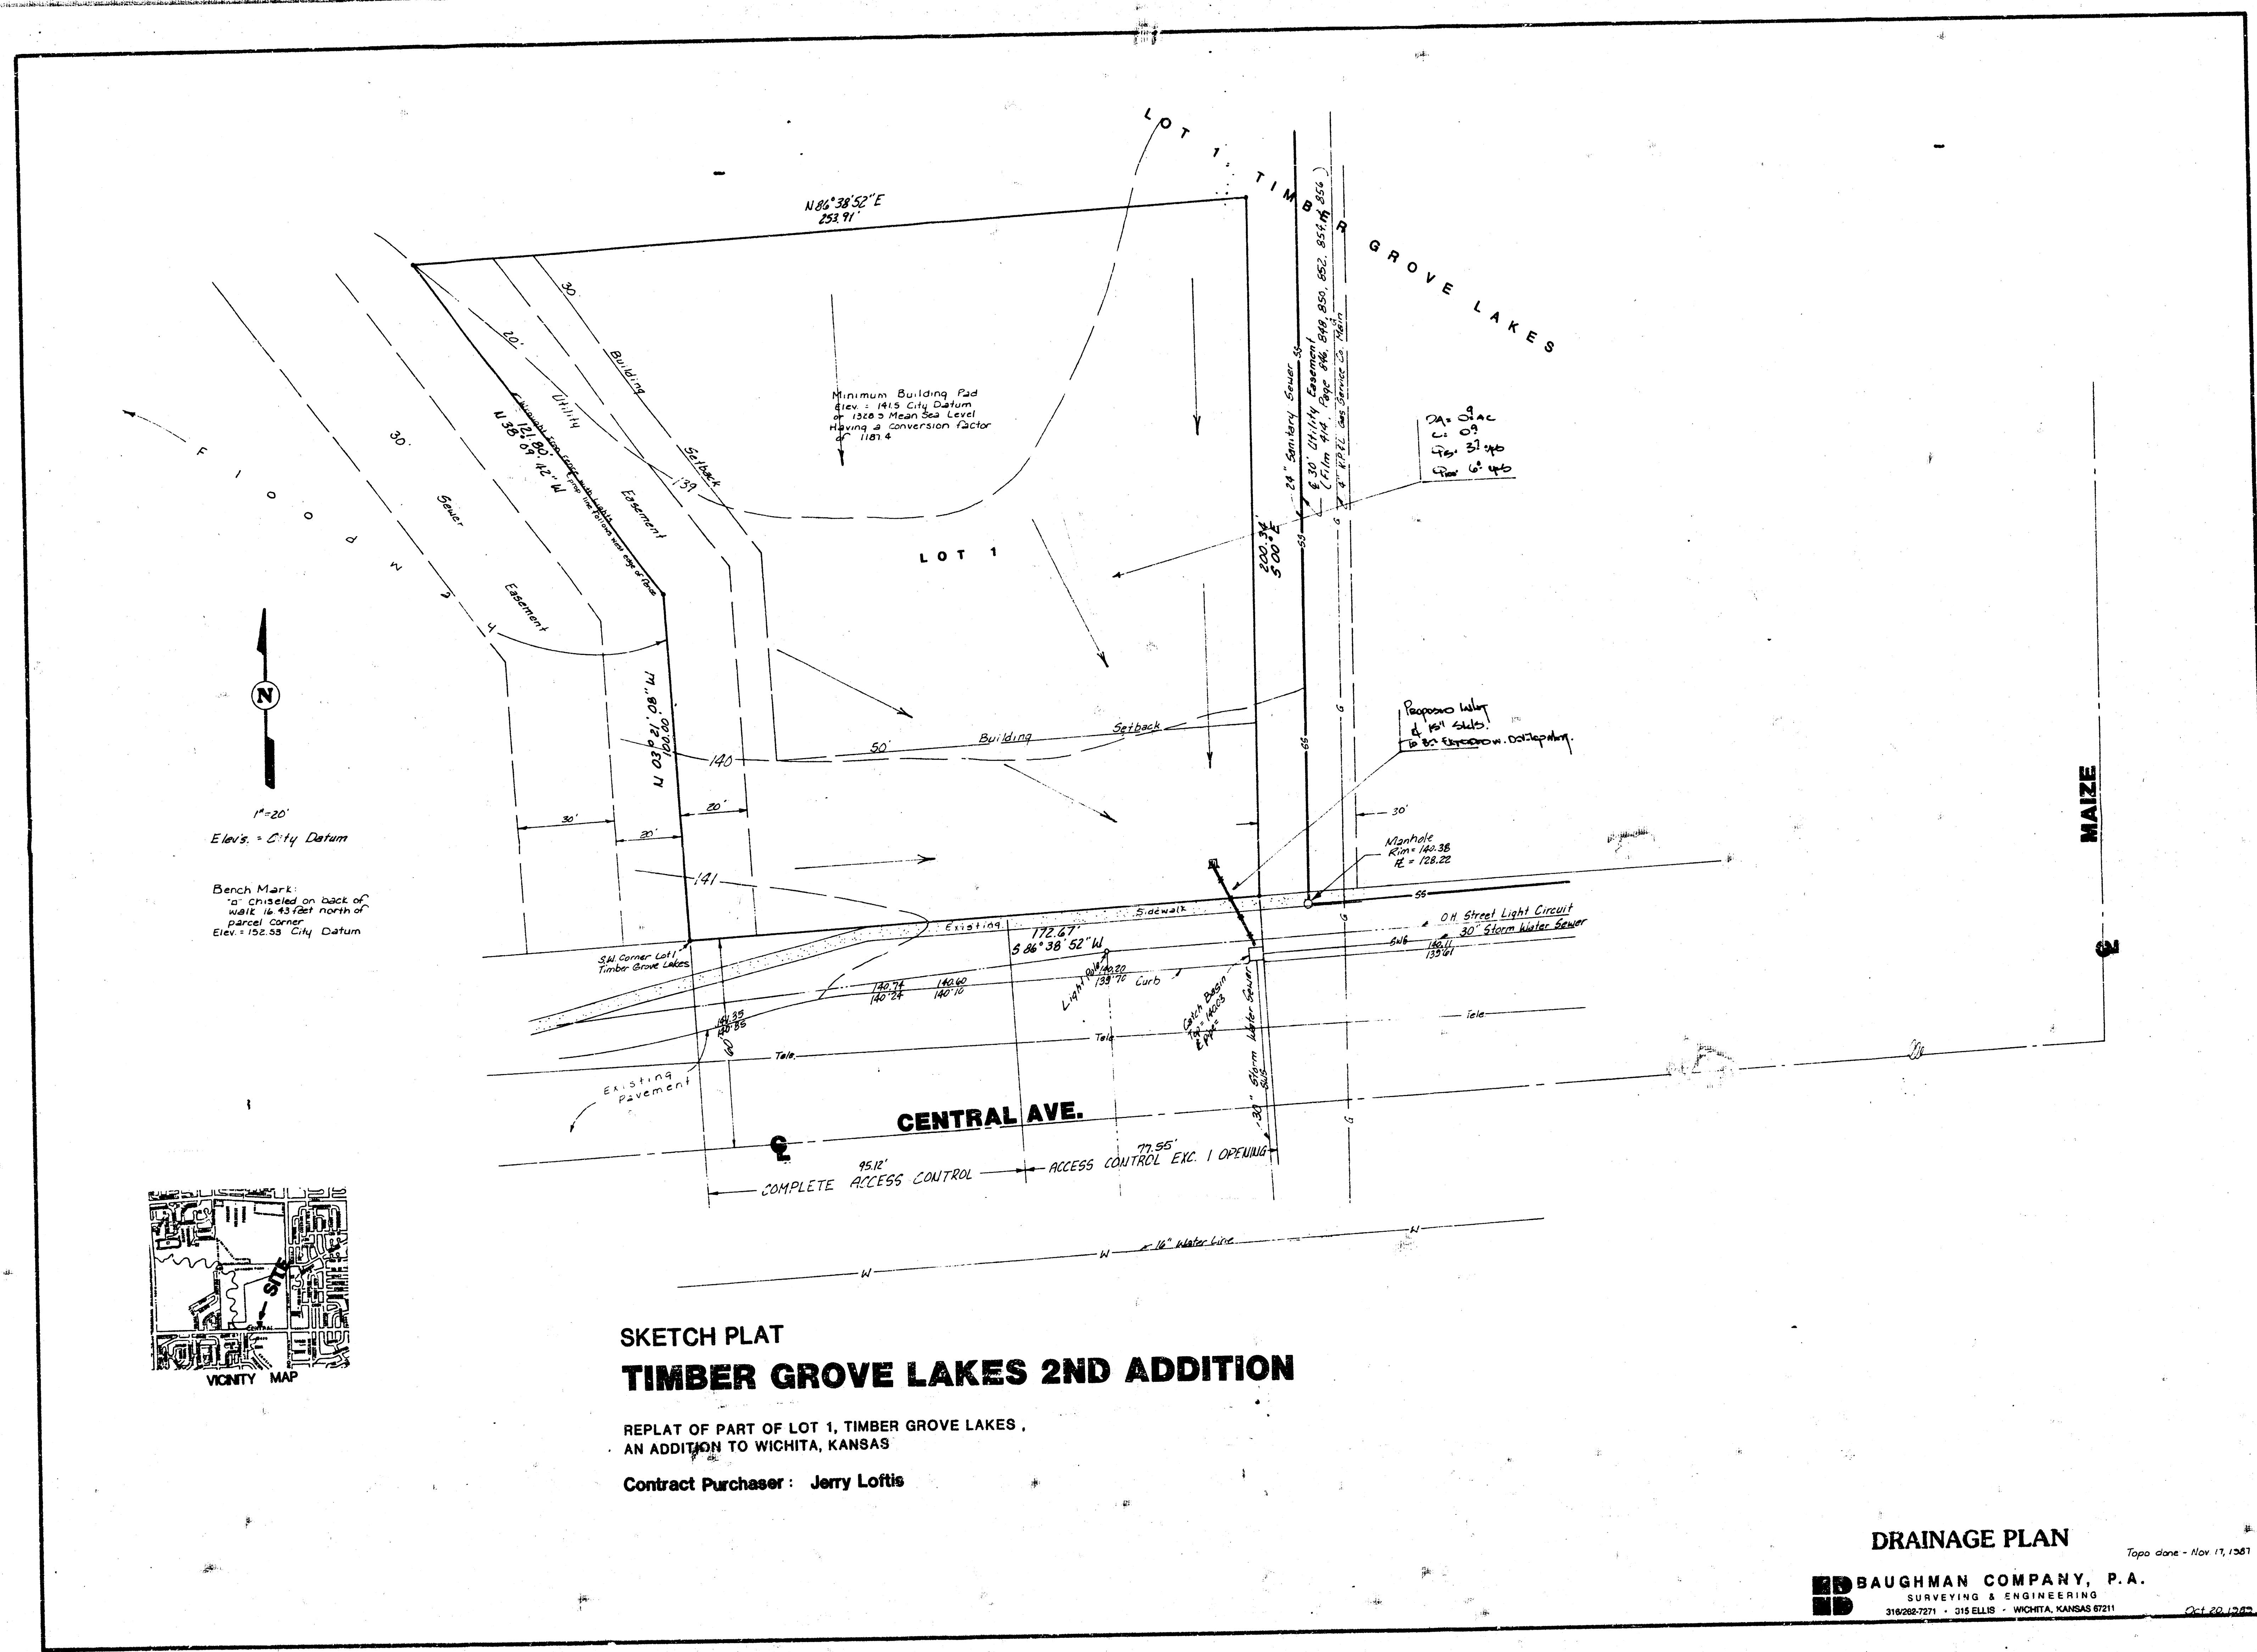

SKETCH PLAT
TIMBER GROVE LAKES 2ND ADDITION

REPLAT OF PART OF LOT 1, TIMBER GROVE LAKES,
 AN ADDITION TO WICHITA, KANSAS
 Contract Purchaser: Jerry Loftis

DRAINAGE PLAN

BAUGHMAN COMPANY, P.A.
 SURVEYING & ENGINEERING


