SKETCH PLAT

TRACHTMAN 2ND ADDITION

WICHITA, SEDGWICK COUNTY, KANSAS

LOTS 2 AND 3, TRACHTMAN ADDITION
BERNARD H. TRACHTMAN
& FLORENCE TRACHTMAN

SERVICE, INC.

THOMAS A. BISHOP, PRESIDENT

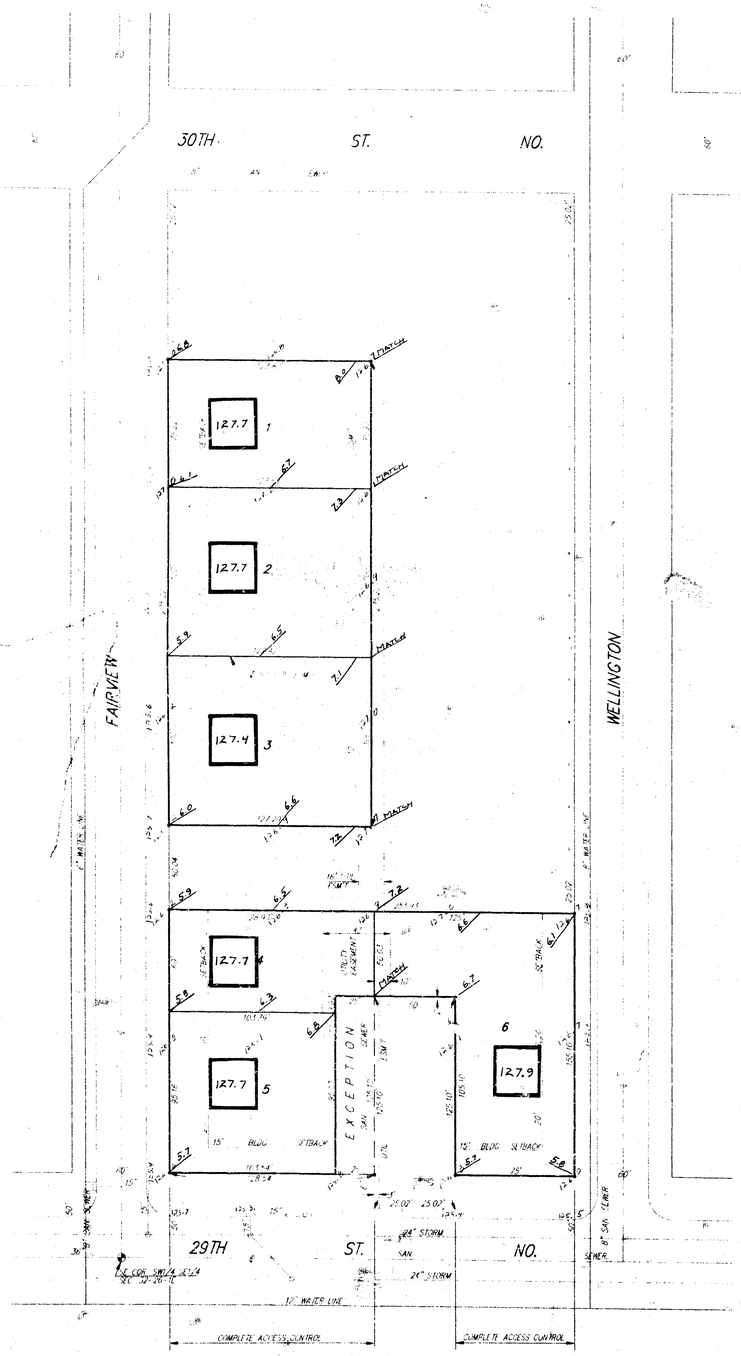

Scale 1" = 40'
B.M. Top iron in
manhole - E. 25th &
Fairview - El. 1254.7

Lot Grading Plan
Oct. 26. 93

APPROVED
DRAINAGE PLAN

BAUGHMAN COMPANY P. A.
ENGINEERING & SURVEYING
316/262-7271 • 315 ELLIS • WICHITA, KANSAS 67211

17 NOV 1992

SKETCH PLAT
TRACHTMAN 2ND ADDITION

WICHITA, SEDGWICK COUNTY, KANSAS

LOTS 2 AND 3, TRACHTMAN ADDITION
BERNARD H. TRACHTMAN
& FLORENCE TRACHTMAN

MENNONITE HOUSING REHABILITATION
SERVICE, INC.

THOMAS A. BISHOP, PRESIDENT
2145 N. TOPEKA
WICHITA, KANSAS 67214
PH: 265-7558

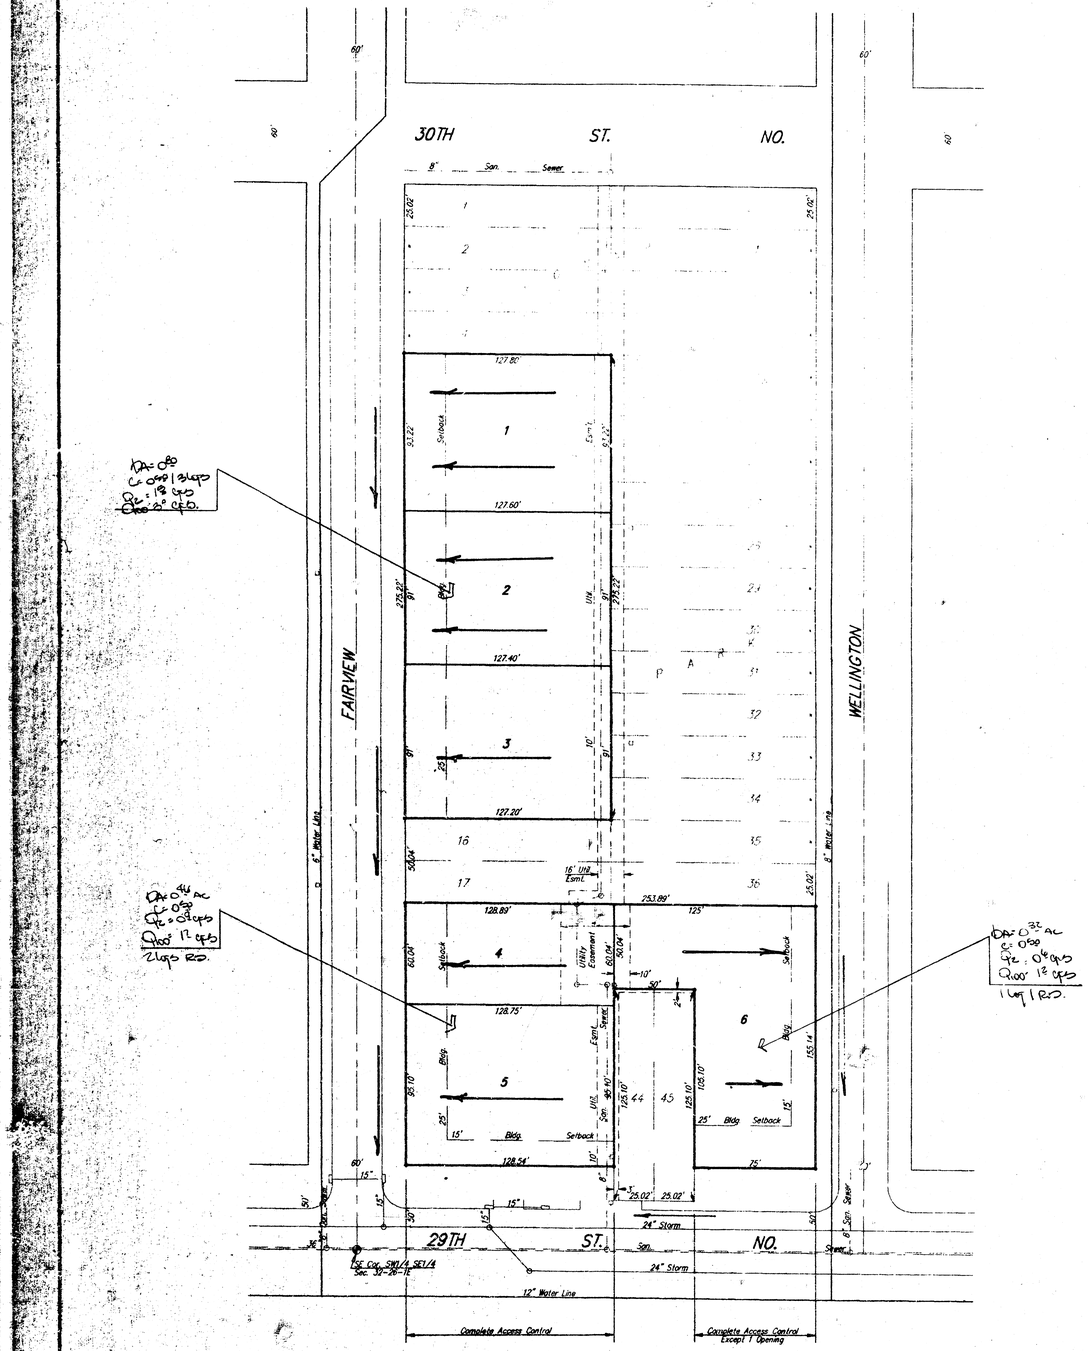

Scale: 1" = 40'
B.M. - Top Iron in Thimble - ℄ 29th & Fairview - El. 1254.47

DRAINAGE & UTILITY PLAN

BAUGHMAN COMPANY P. A.
ENGINEERING & SURVEYING
316/262-7271 • 315 ELLIS • WICHITA, KANSAS 67211

24 SEP 92