


SKETCH PLAT TRACHTMAN 2ND ADDITION

WICHITA, SEDGWICK COUNTY, KANSAS

LOTS 2 AND 3, TRACHTMAN ADDITION
BERNARD H. TRACHTMAN
& EUGENE TRACHTMAN

MEMORITE PAVING REHABILITATION
SERVICE, INC.

THOMAS A. BISHOP, PRESIDENT
2145 N. DOLKA
WICHITA, KANSAS 67214
TEL 265-7558

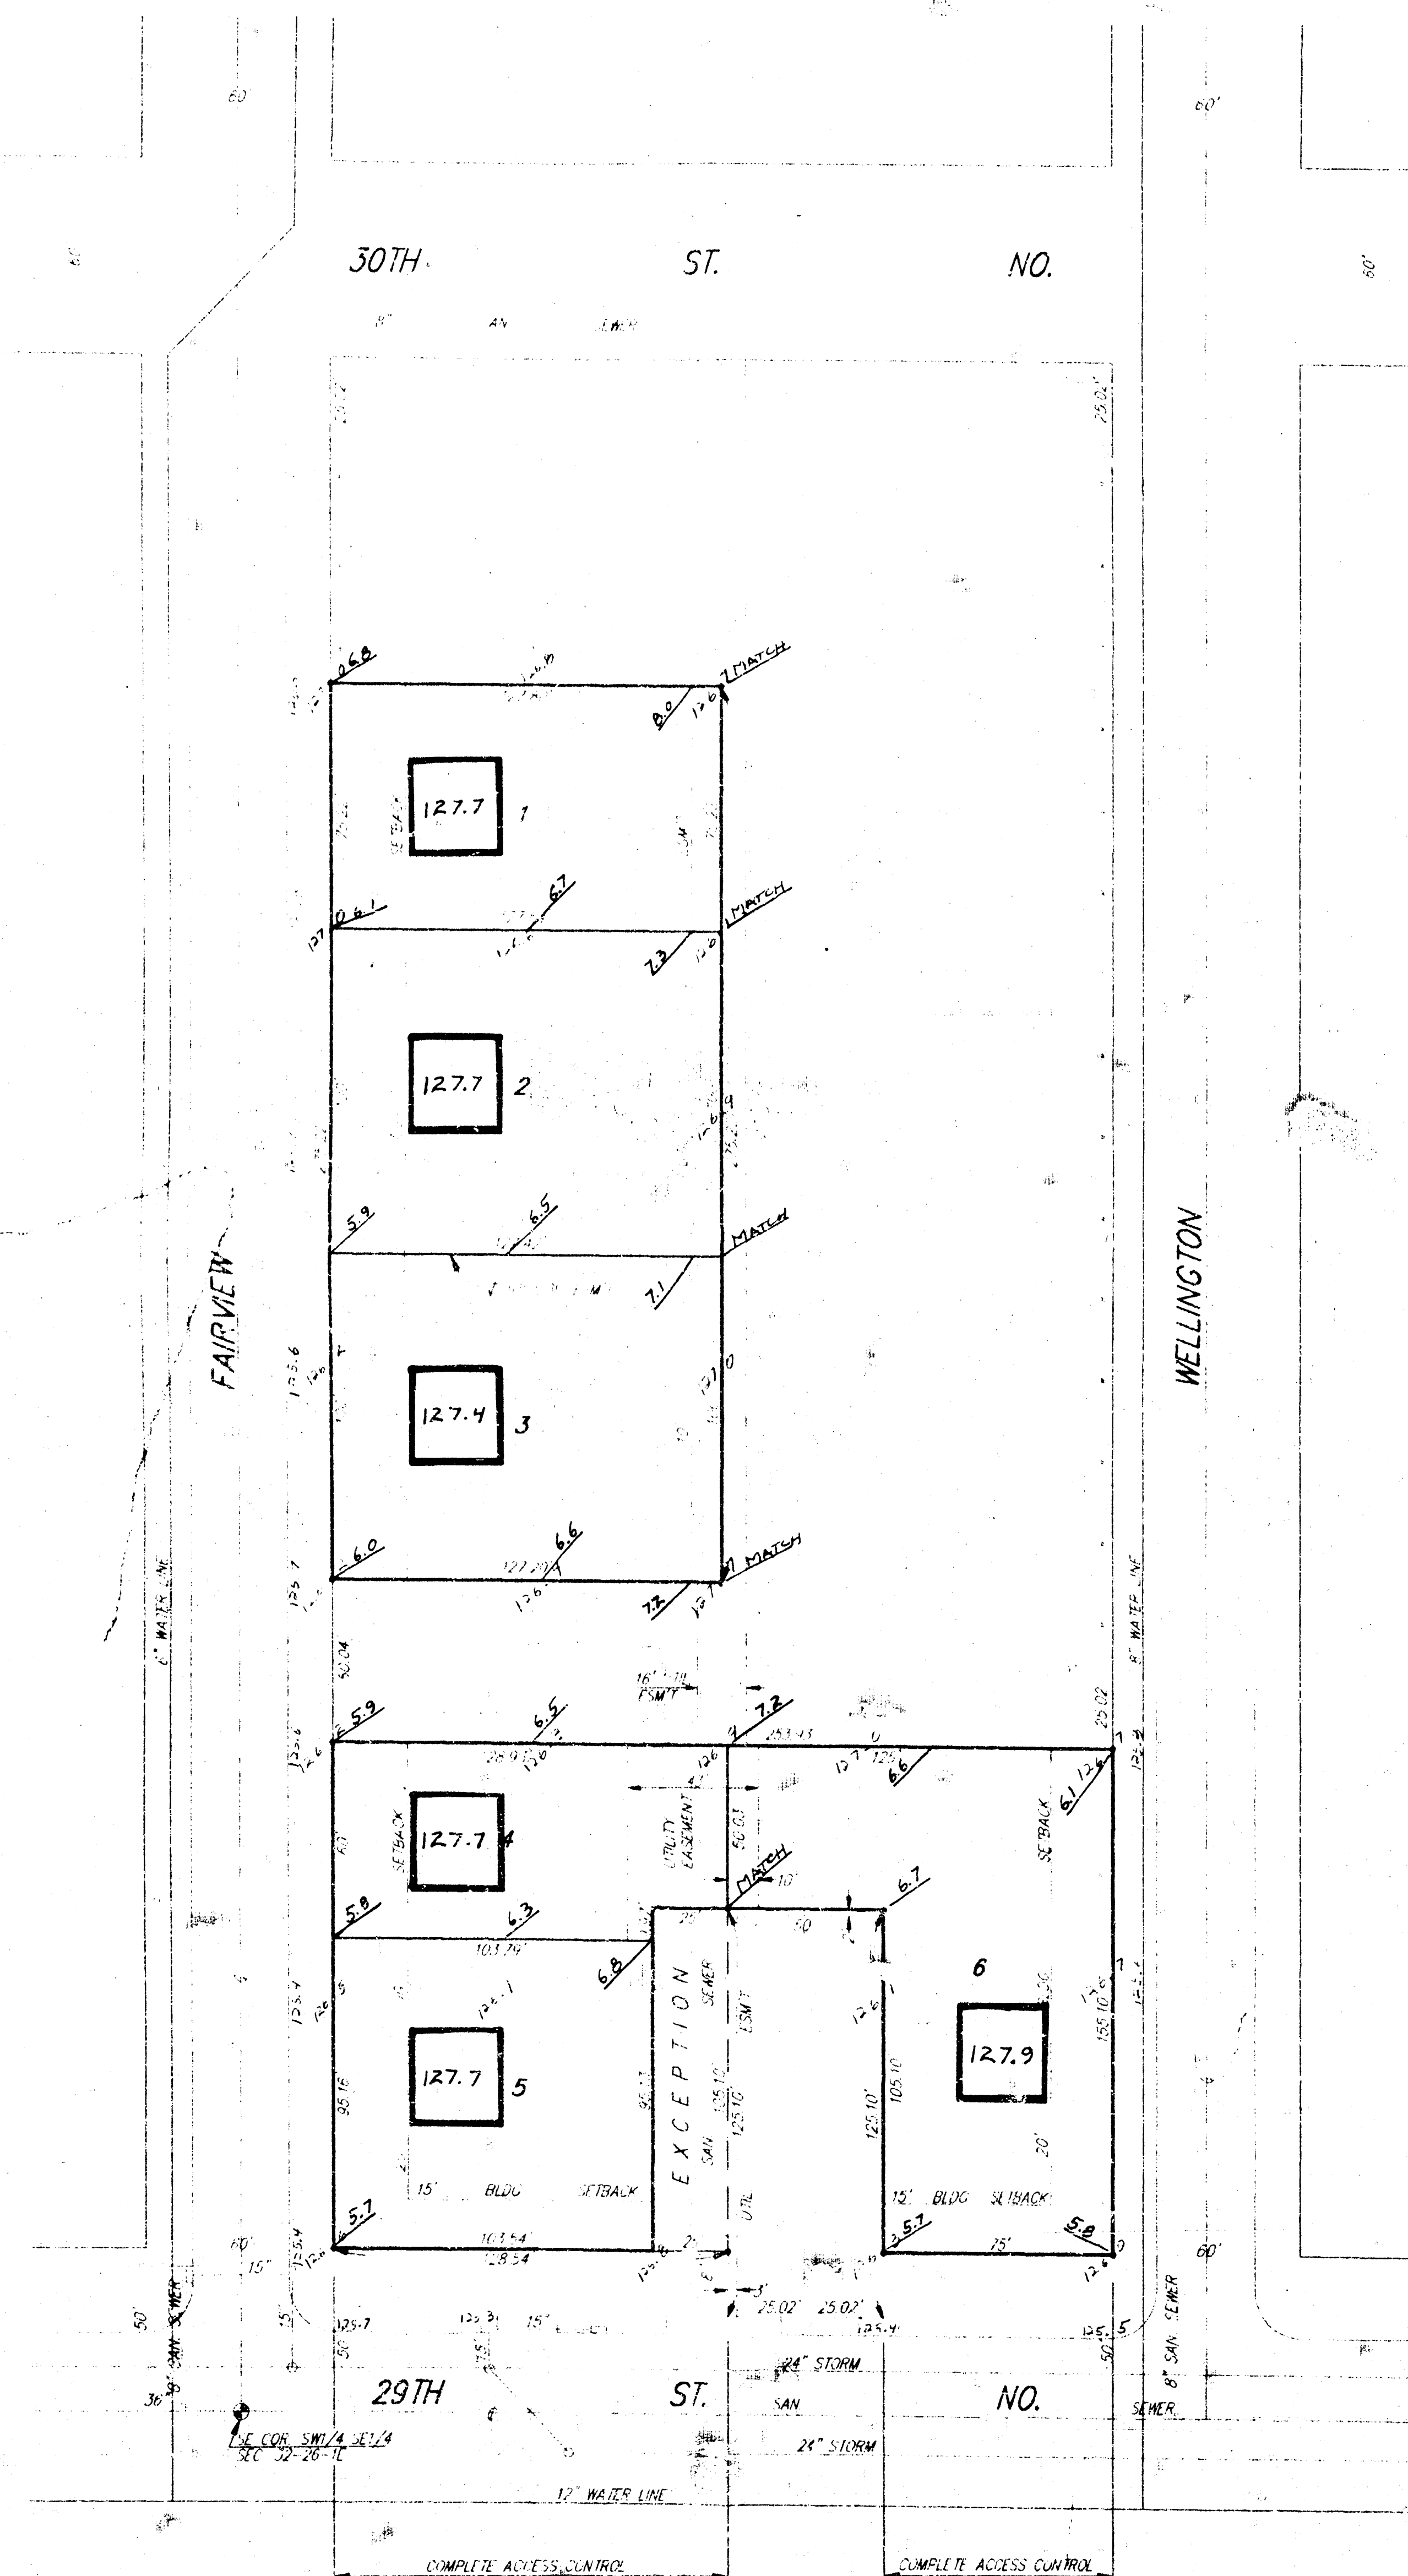

Lot Grading Plan
Oct. 26. 93

**APPROVED
DRAINAGE PLAN**




BAUGHMAN COMPANY P. A.
ENGINEERING & SURVEYING
315/262-7271 • 315 ELLIS • WICHITA, KANSAS 67211

17 NOV 1992

WICHITA, SEDGWICK COUNTY, KANSAS

THOMAS A. BISHOP, PRESIDENT
2145 N. TOPEKA
WICHITA, KANSAS 67214
PH: 265-7558

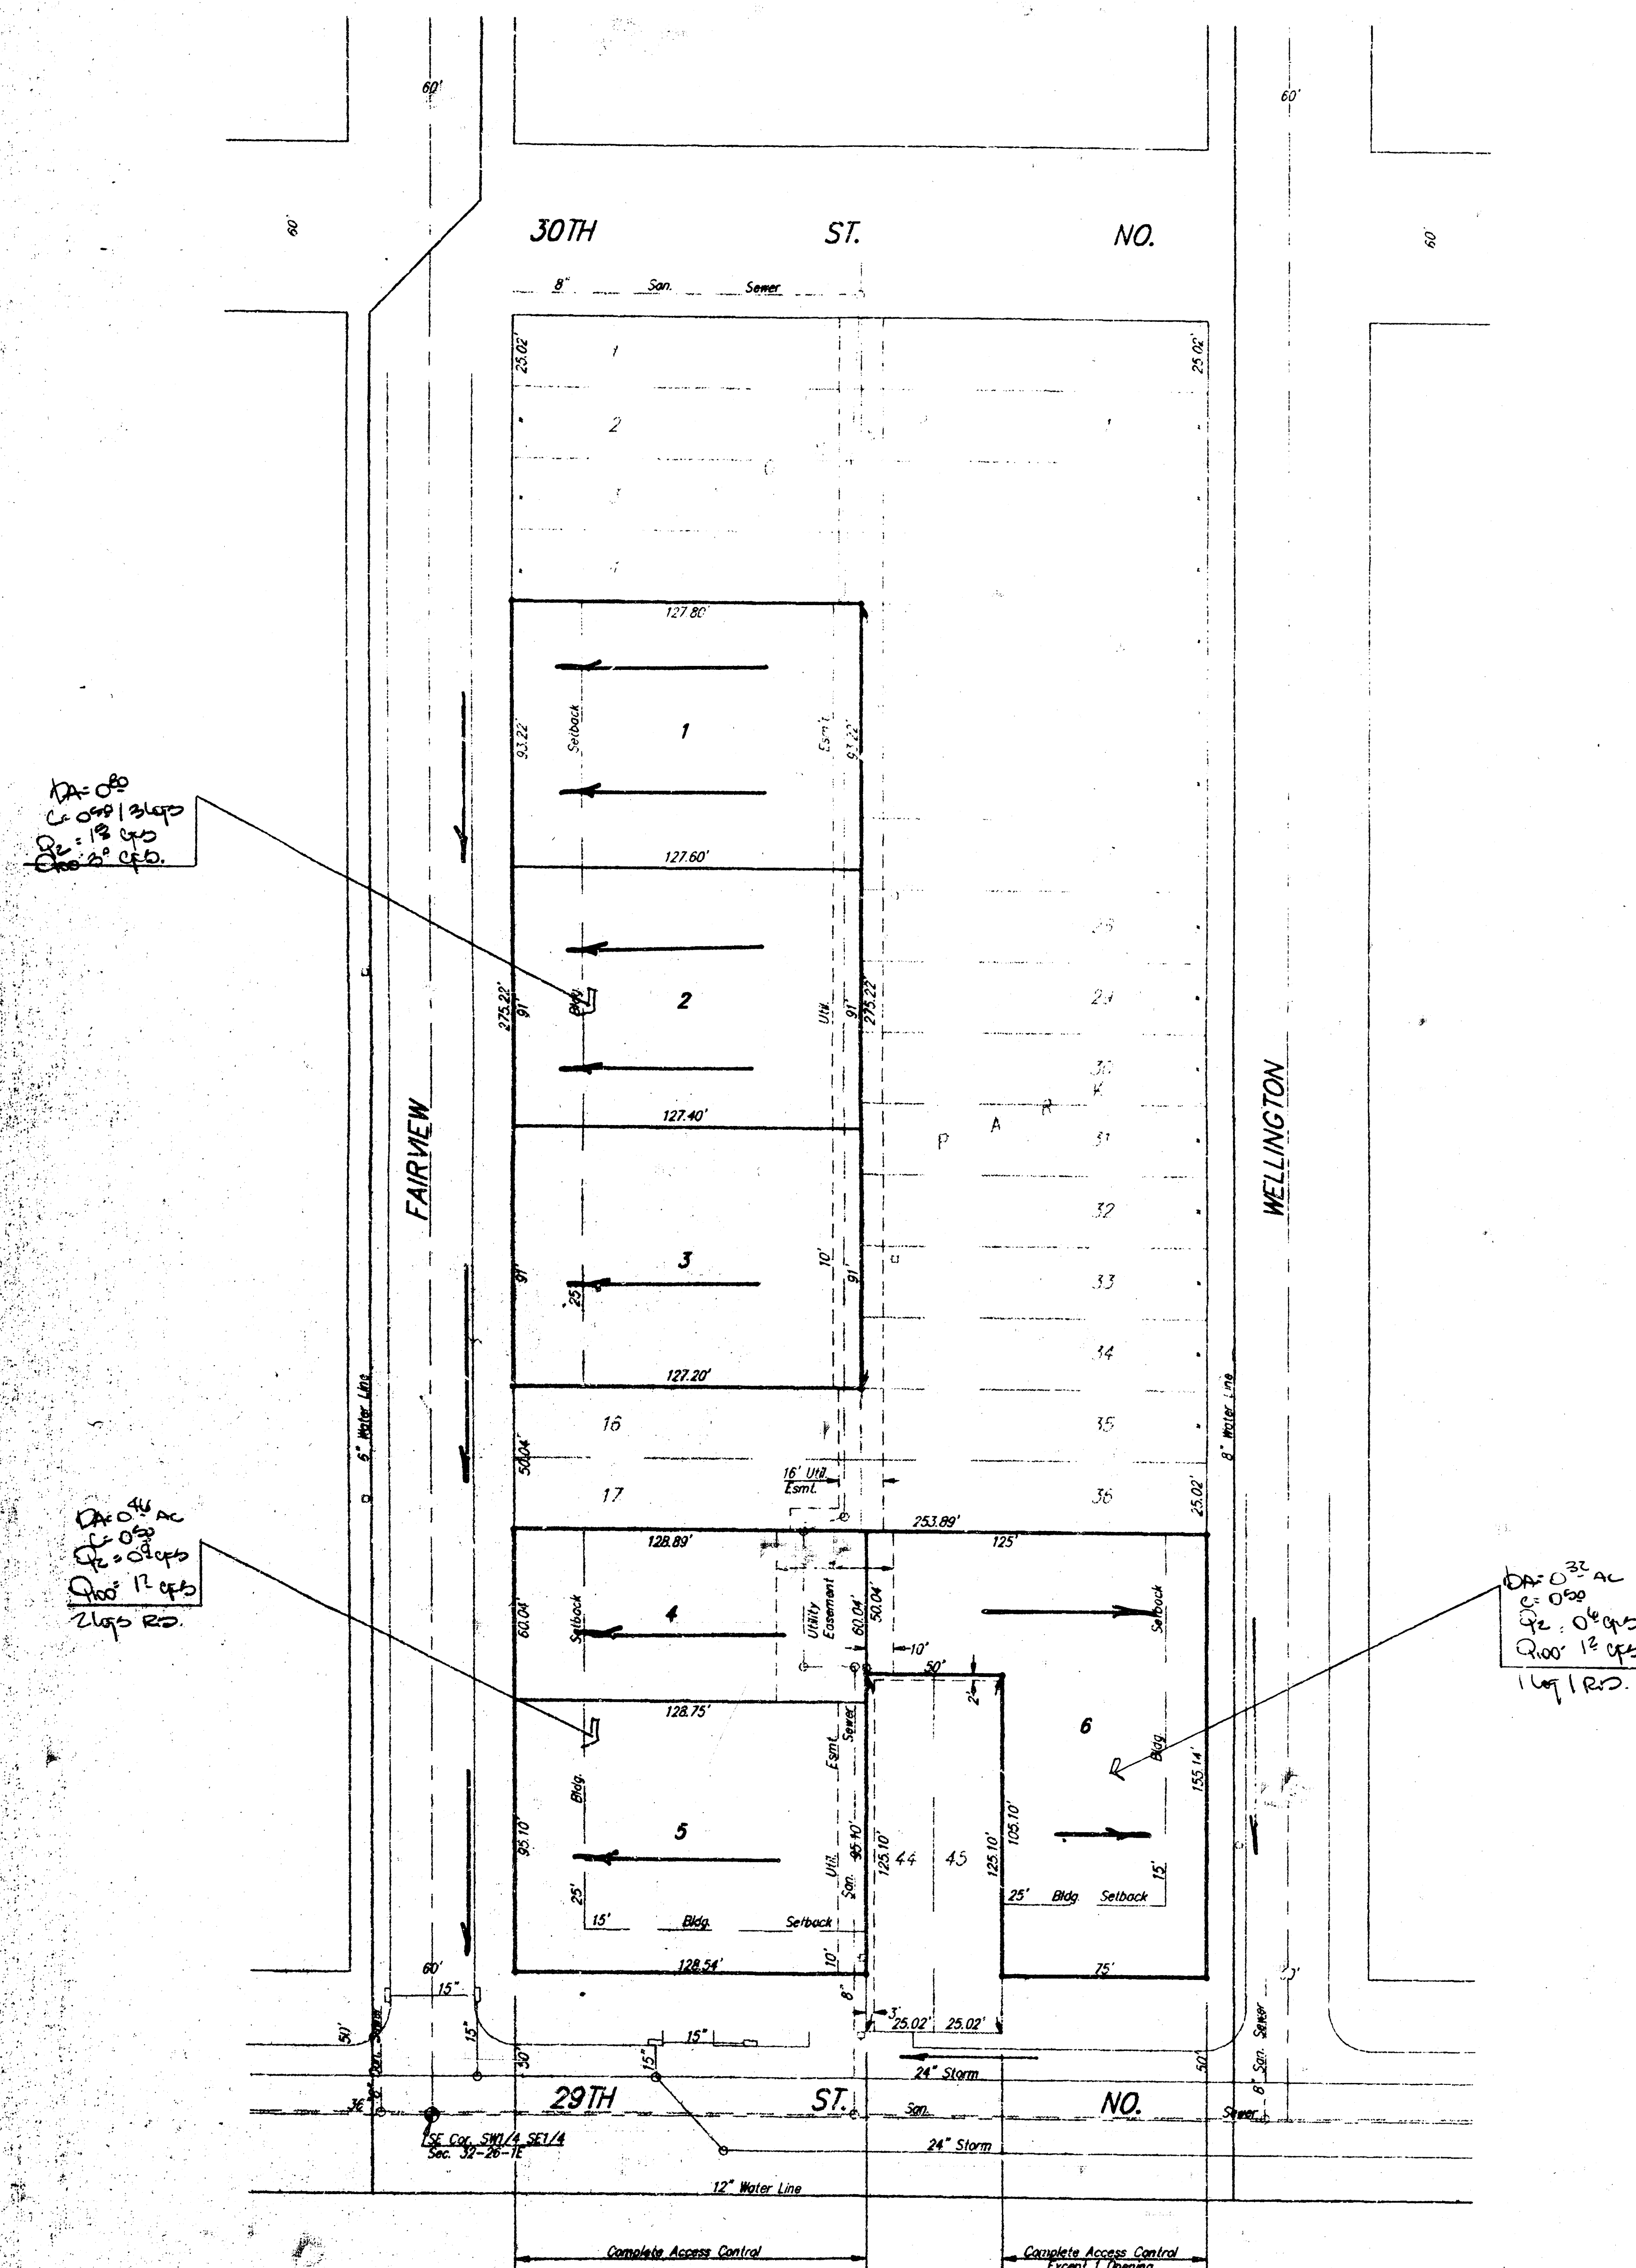

Scale: 1" = 40'
B.M. - Top Iron in
Thimble - & 29th
Fairview - El. 125.

DRAINAGE & UTILITY PLAN



BAUGHMAN COMPANY P. A.
ENGINEERING & SURVEYING
316/262-7271 • 315 ELLIS • WICHITA, KANSAS 67211

24 SEP 92