DRAINAGE PLAN
U.N.B. 2ND ADDITION
WICHITA, SEDGWICK COUNTY, KANSAS

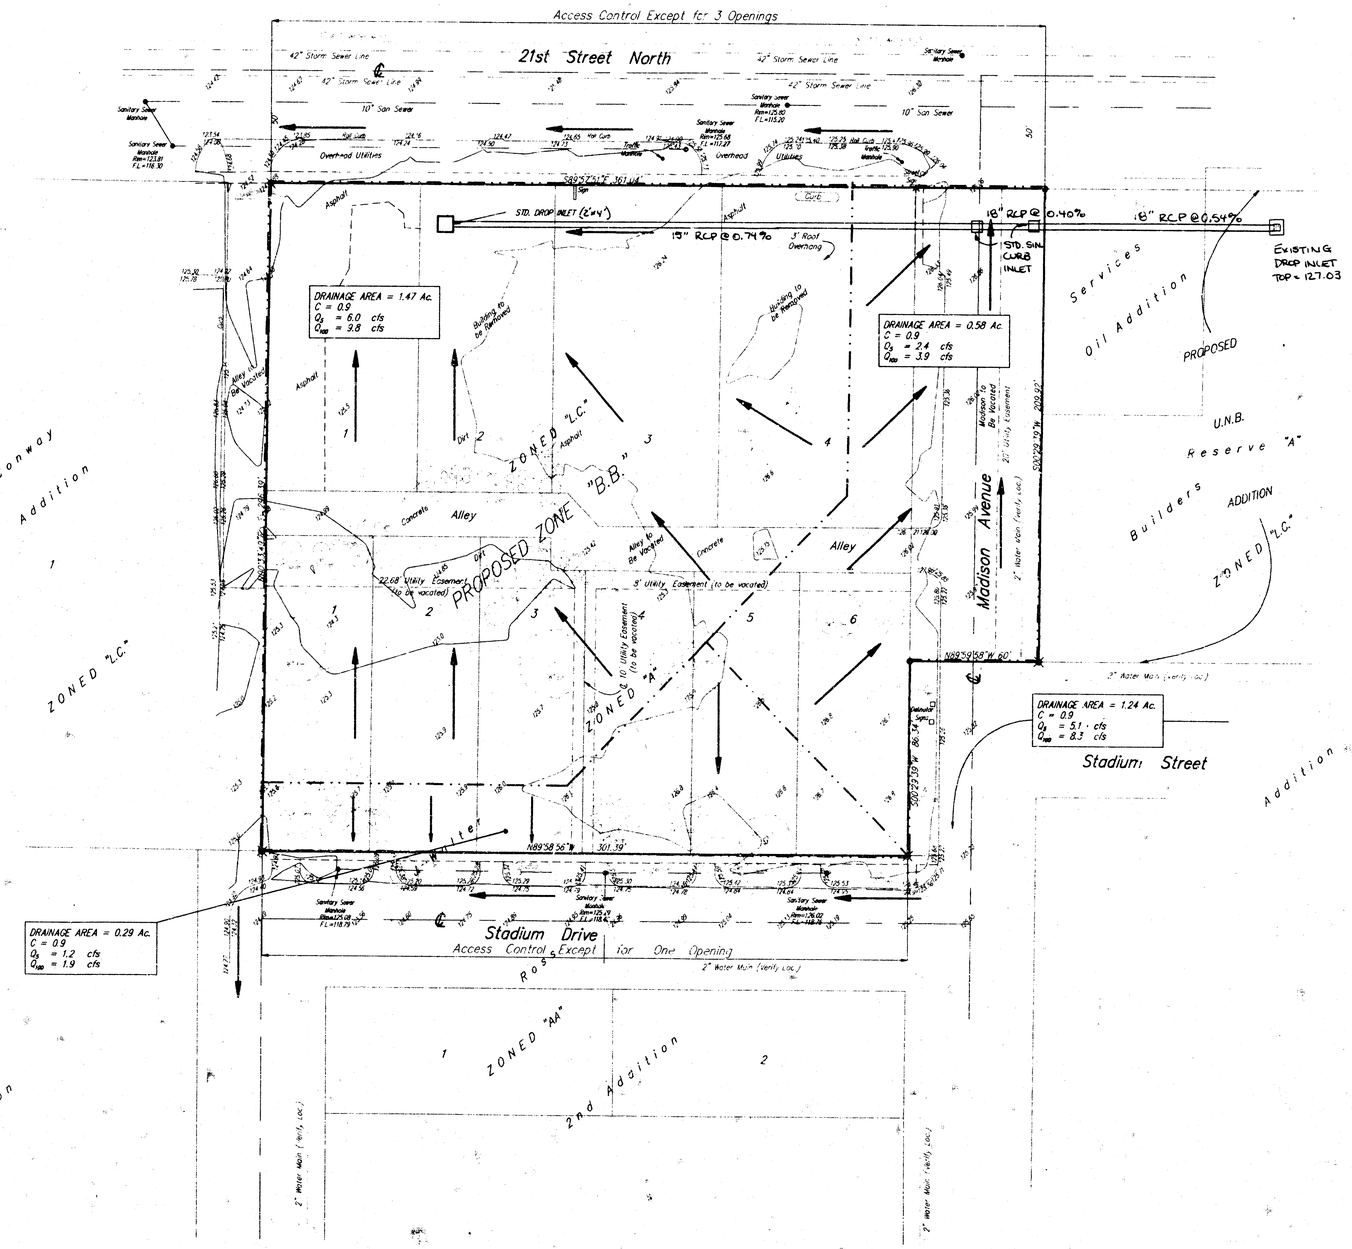

LEGEND

● = Baughman Rebar Set
✖ = 1/2" Iron Found
◆ = Iron Found

LEGAL DESCRIPTION

Lots 1, 2, 3, 4, Block 1, Elder Addition to Wichita, Sedgwick County, Kansas, including the 20 foot alley adjacent to the south, and Lots 1, 2, 3, 4, 5, 6, Block A, J. Walter Ross Second Addition, an addition to Wichita, Sedgwick County, Kansas, and Madison Avenue from the north line of Stadium to the south line of 21st Street North.

OWNER

City of Wichita
455 N. Main
Wichita, KS 67202

BENCHMARK

C.O.W. Brass Disc 41.08' South and 117.26' West of the centerlines of 21st Street North and Grove Street
Elevation = 1332.20 (City Datum)

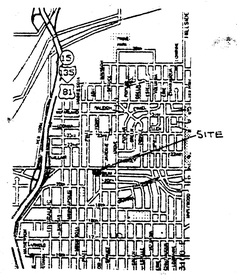

VICINITY MAP

MAY 19 1995

BAUGHMAN COMPANY P. A.
ENGINEERING, SURVEYING, & PLANNING
(316) 262-[illegible] • [illegible] • WICHITA, KANSAS 67211