Voges VW

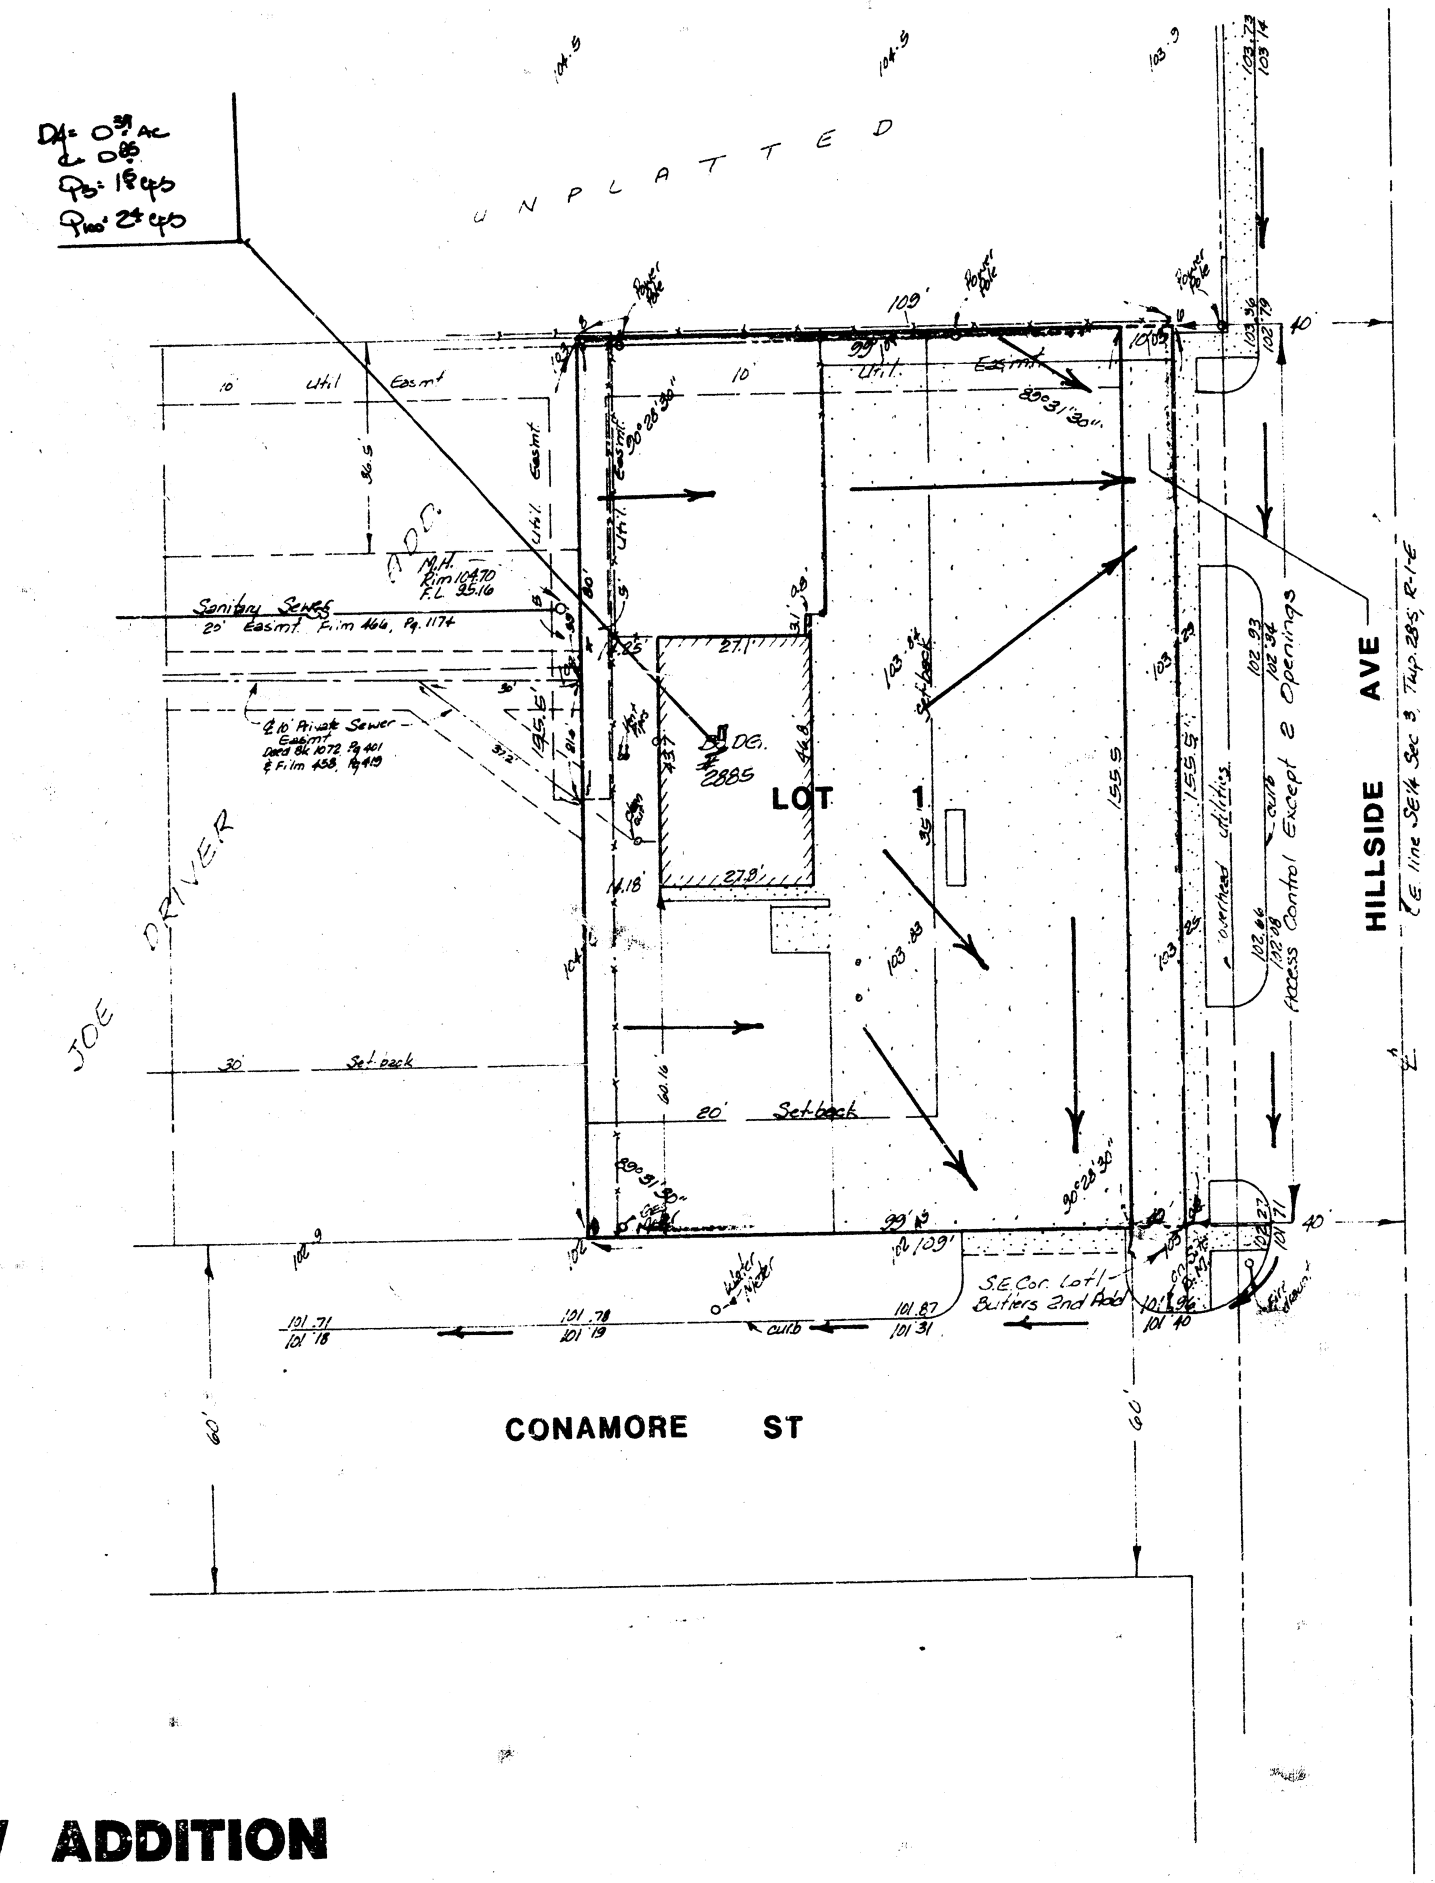

N

1" = 20'

ELEV. = CITY DATUM

BENCH MARK:
City Standard Disc. on N.E. Cor. of R.C.B. at Hillside & Wassall
Elev. = 104.498 City Datum

On Site B.M.
"□" square cut on top of curb on N. side of Conamore St. at N.W. Cor. of Hillside & Conamore
Elev. = 101.96 City Datum

SKETCH PLAT

VOGES VW ADDITION

LOTS 1 AND 2, EXCEPT THE WEST 150 FEET THEREOF,
BUTLERS 2ND ADDITION, SEDGWICK COUNTY, KANSAS

CHARLES L VOGES

DRAINAGE PLAN

BAUGHMAN COMPANY, P.A.
SURVEYING & ENGINEERING
316/262-7271 • 315 ELLIS • WICHITA, KANSAS 67211

8 SEP 1988