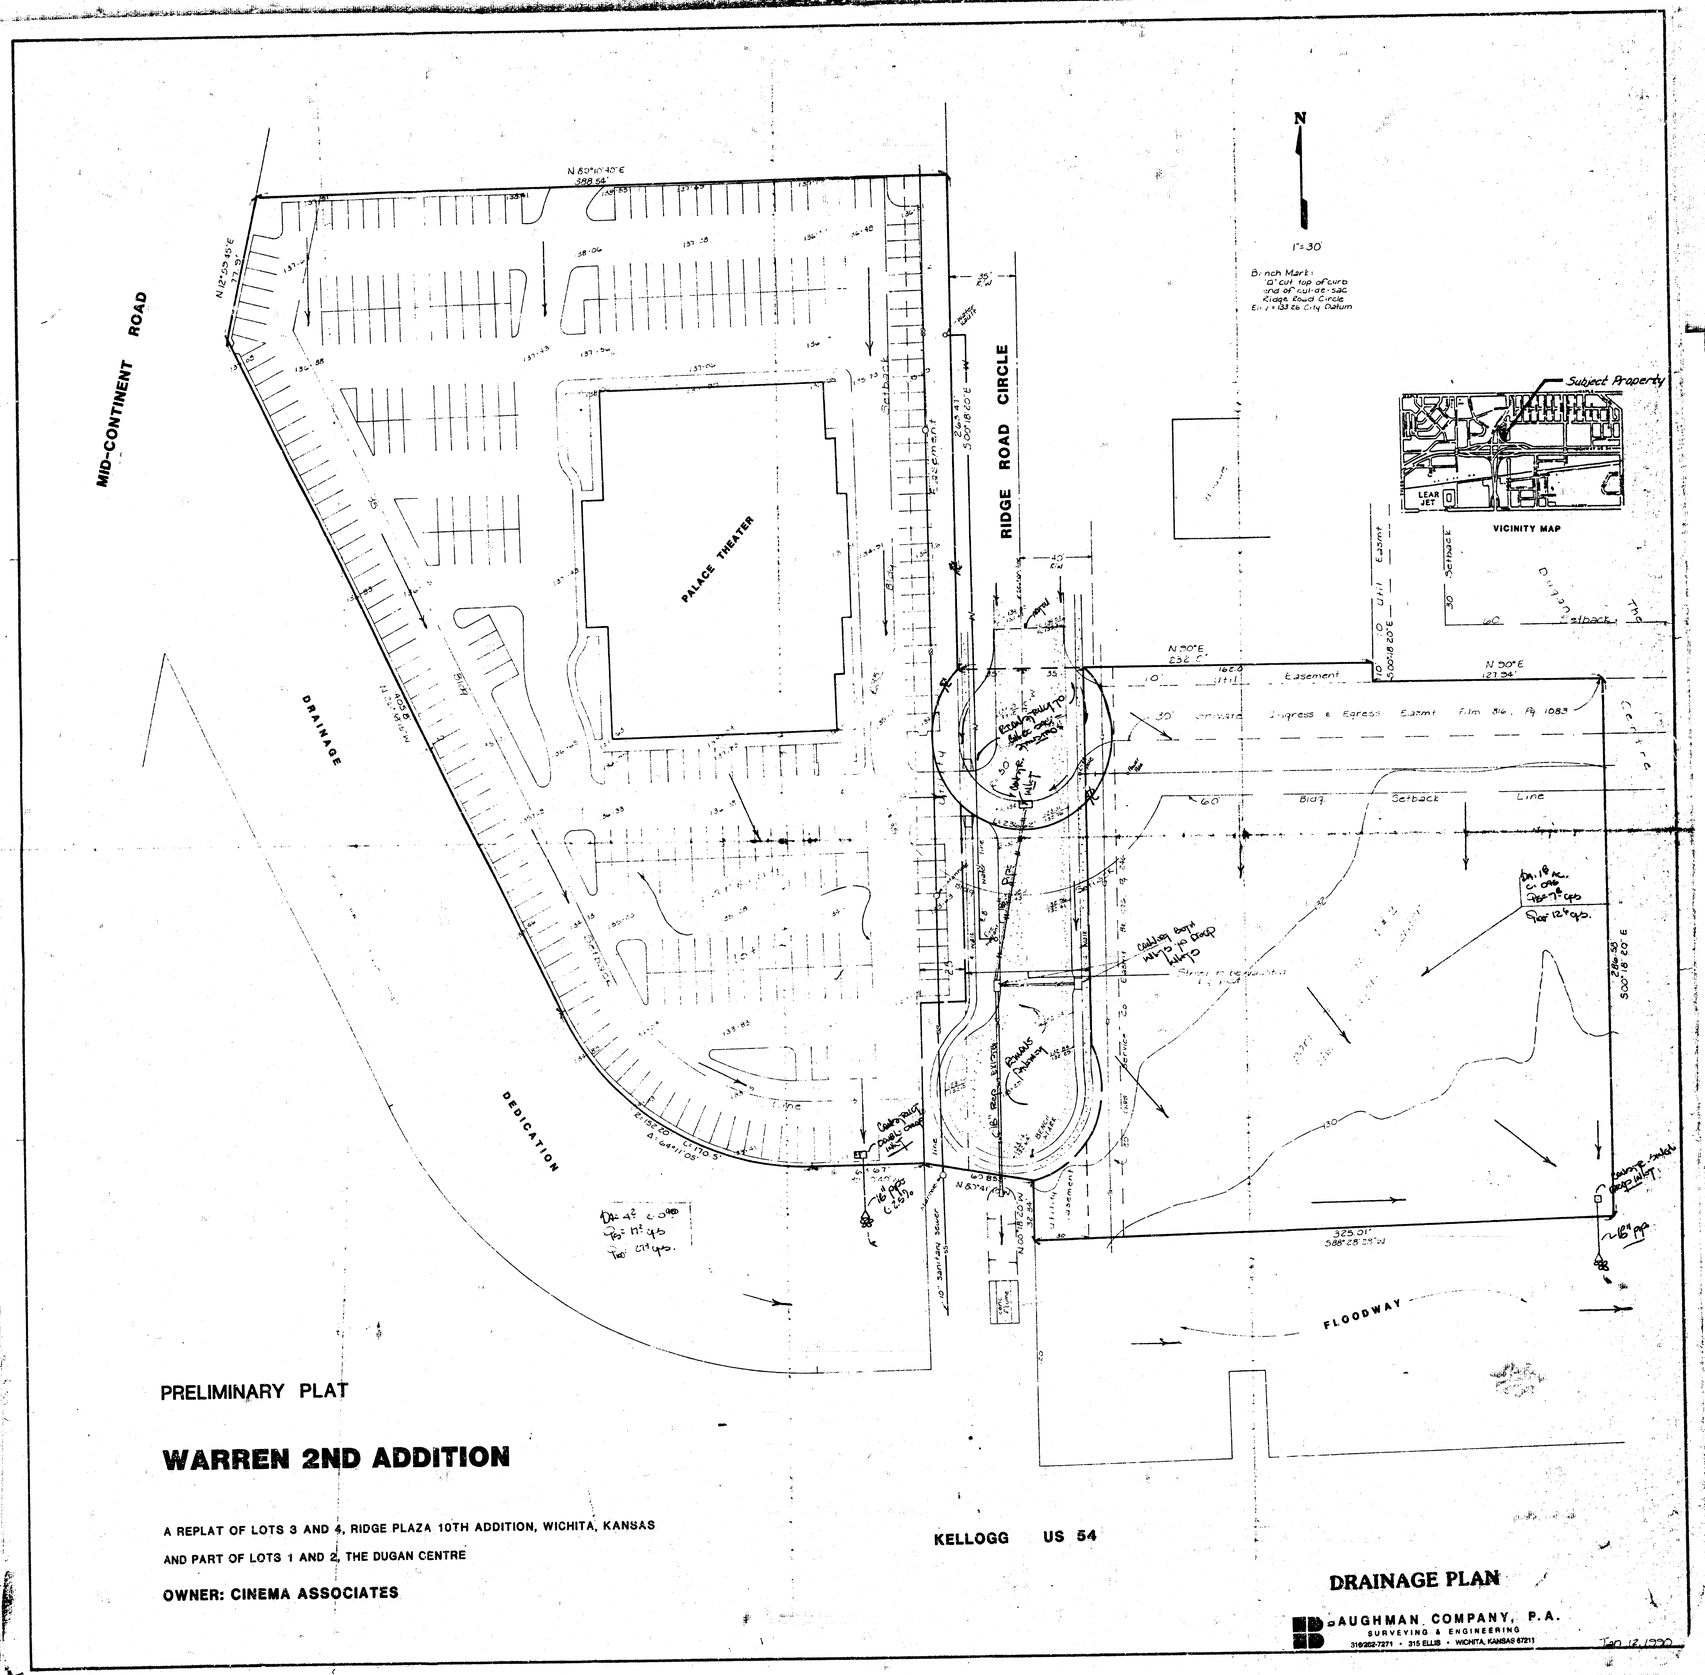
MID-CONTINENT ROAD
RIDGE ROAD CIRCLE
PALACE THEATER
DRAINAGE
DEDICATION
FLOODWAY
N 50°41'40"E
398.64'
N 12°53'40"E
127.93'
S00°18'20"E
264.41'
N 50°E
232.5'
N 50°E
127.34'
325.01'
S88°28'28"W
Easement
Ingress & Egress Easmt Film 816, Pg 1083
Bldg. Setback Line
Setback
Util. Easmt
Centre
Dugan
Subject Property
LEAR JET
VICINITY MAP
N
1"=30'
Bench Mark:
0' cut top of curb
end of cul-de-sac
Ridge Road Circle
El. = 1336 City Datum
Sanitary Sewer
Curb Inlet
Drop Inlet
Curb Inlet
Drop Inlet
Curb Inlet
Drop Inlet