


NOTES:

- 1.) BENCH MARK: CITY STANDARD B.M. 45' N. & 45' E. OF CENTERLINE OF ROCK ROAD AND 21ST ST. NO. ELEV. 214.57 CITY DATUM.
- 2.) A DRAINAGE CONCEPT PLAN SHALL BE PREPARED AND SUBMITTED BY MID KANSAS ENGINEERING CONSULTANTS.
- 3.) SETBACKS, LANDSCAPE BUFFERS AND WALL REQUIREMENTS ARE AS PER WILSON PROPERTY C.U.P. DP-191.
- 4.) SHADED AREAS IN 21ST ST. & ROCK ROAD REPRESENT EXISTING RAISED MEDIANS.
- 5.) TOPOGRAPHY FROM SURVEY PREPARED BY M.K.E.C., OCTOBER 1988.

LEGEND

- UTP UNDERGROUND TELEPHONE
- W WATER LINE
- S SEWER LINE
- G GAS LINE
- S.W.A STORM WATER SEWER
- C.T.V CABLE TV (BURIED)
- L.P LIGHT POLE (STREET)
- P.A POWER POLE

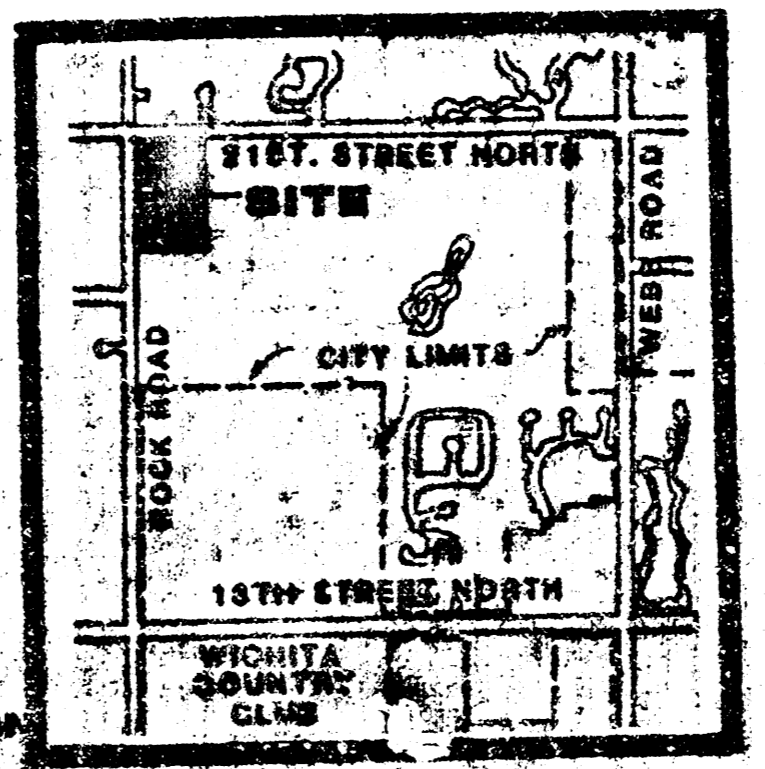

What is drainage calculation, size of pipe, etc.



SCALE: 1"=20'
CONTOUR INTERVAL= 1'

TOTAL ACRES: 9.40
TOTAL S.F.- 409,466
EXISTING & PROPOSED ZONING - L.C.

DRAINAGE & UTILITY PLAN (UNDER WILSON PROPERTY C.U.P. DP-191)

WILSON ESTATES ADDITION