



PRELIMINARY PLAT
WONG 2ND ADDITION
 WICHITA, SEDGWICK COUNTY, KANSAS

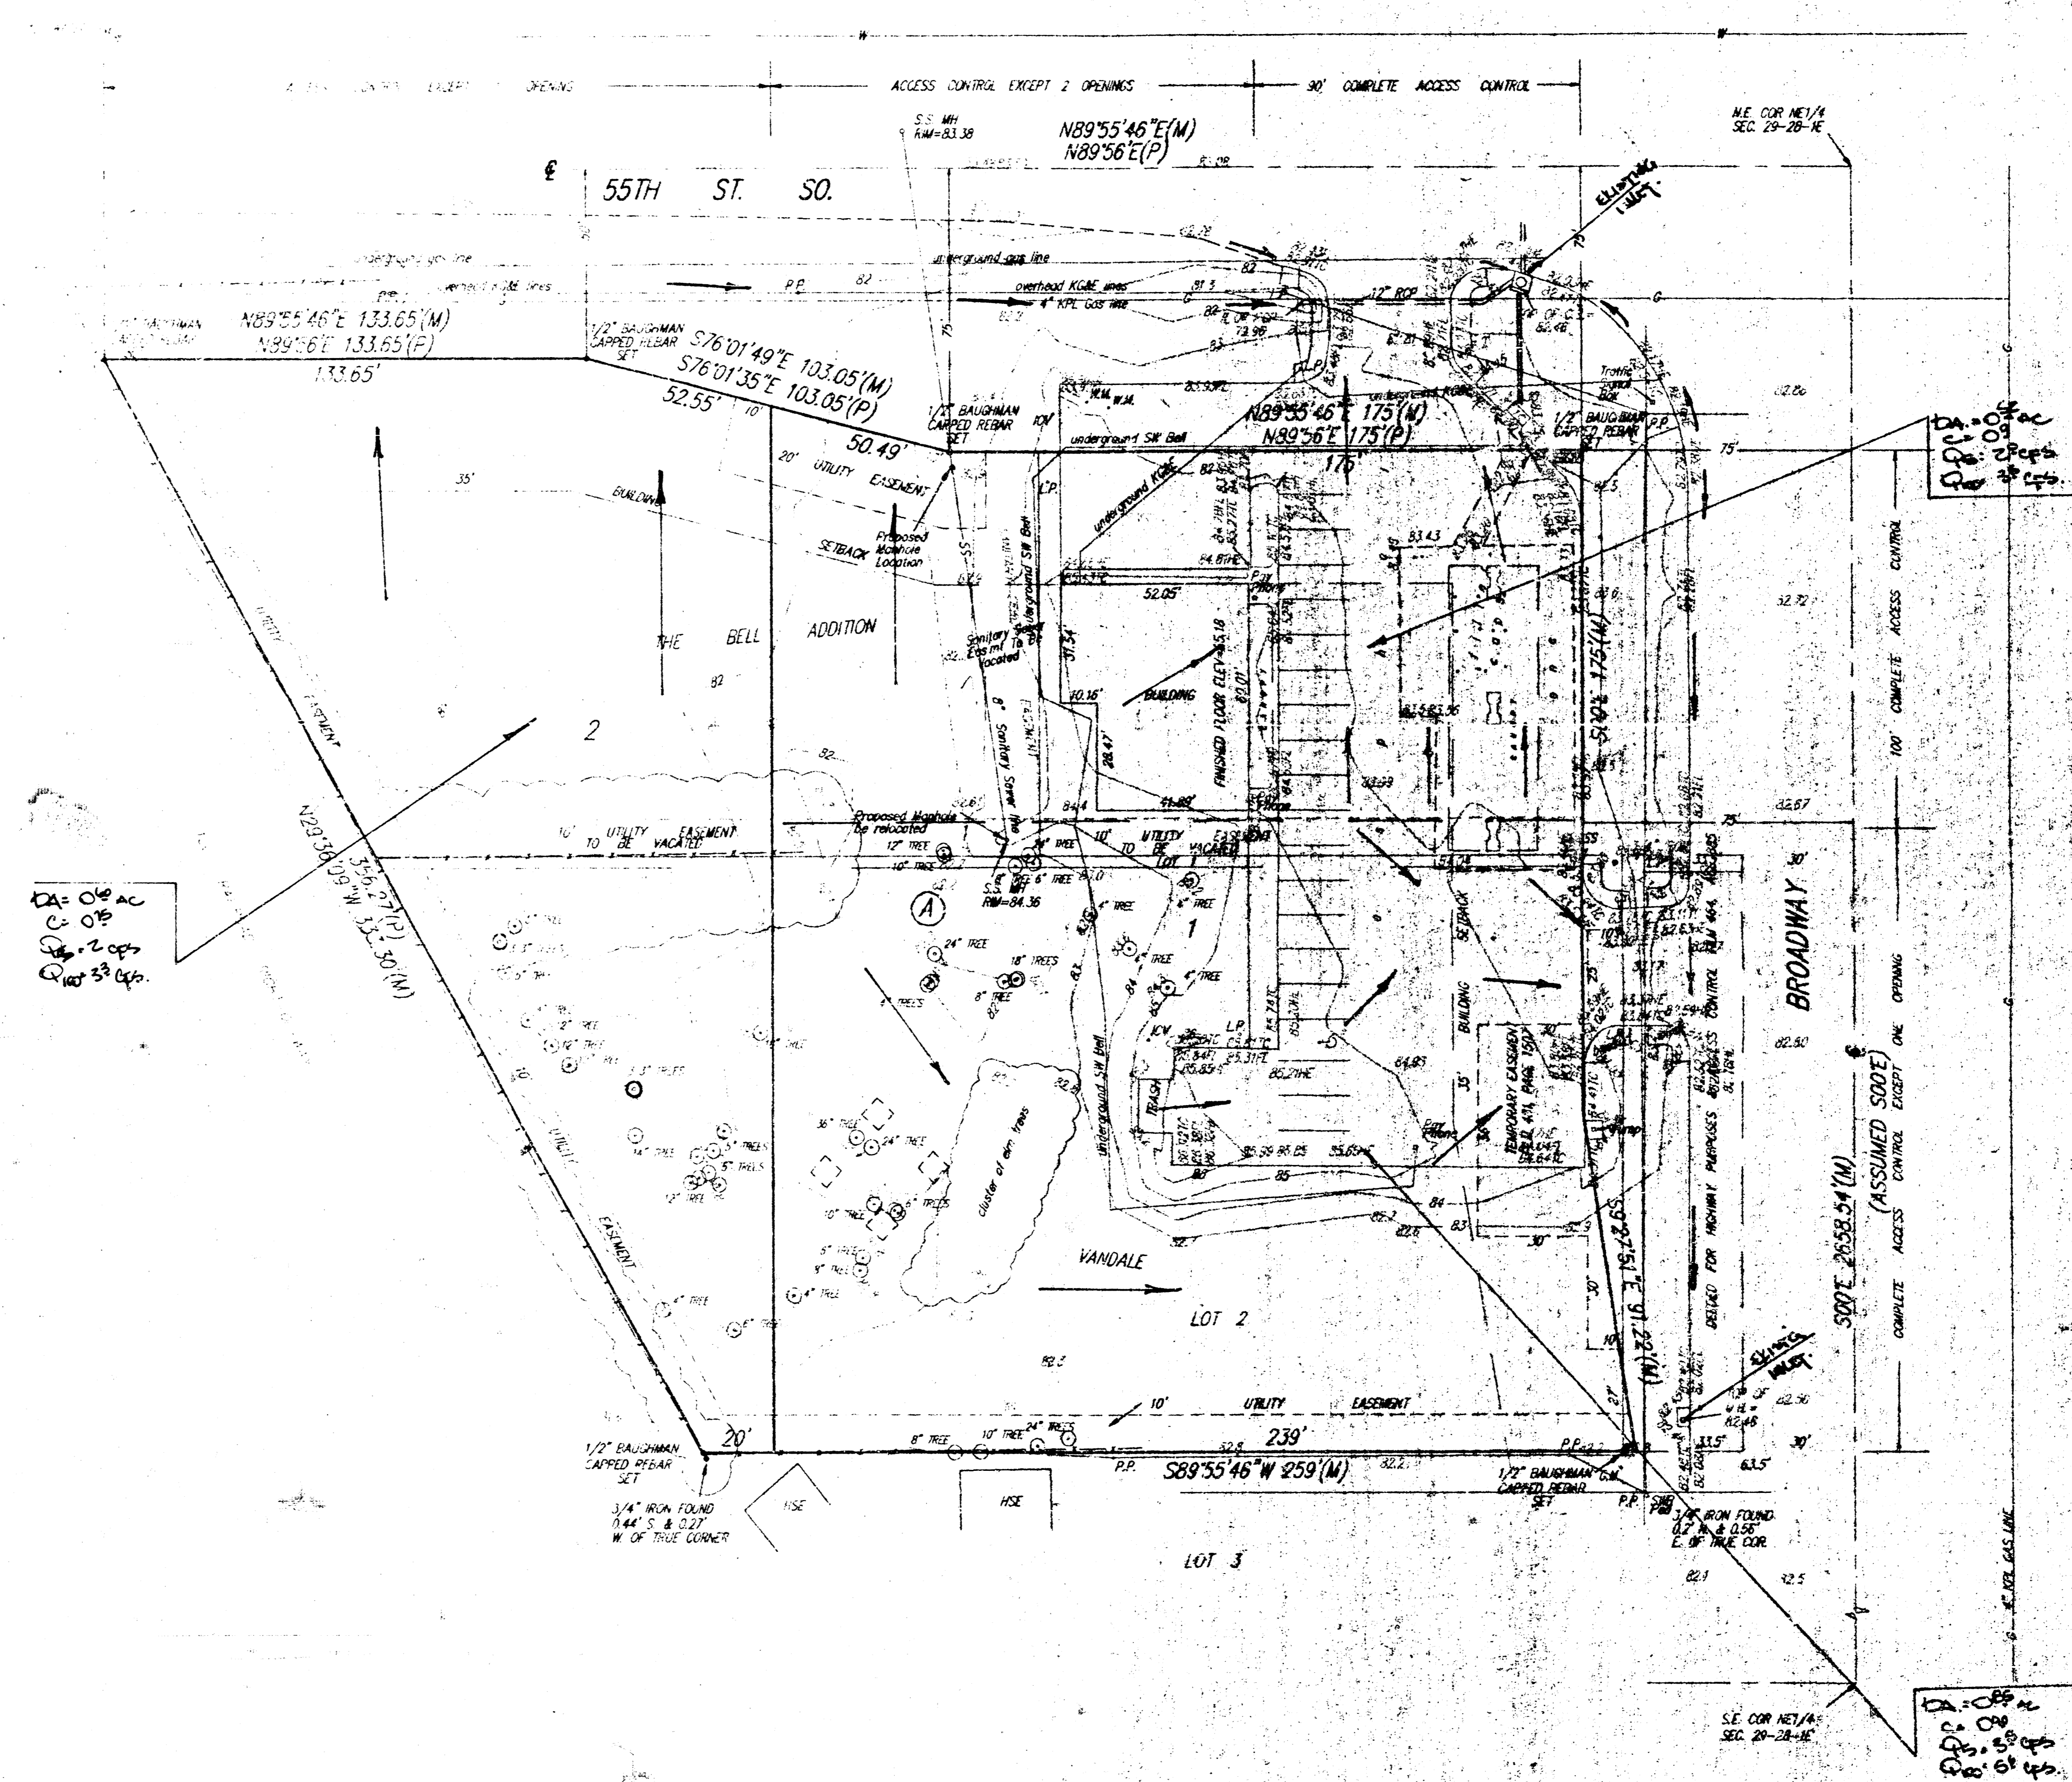

DATE: 06/06/04
 BY: [Signature]
 CHECKED: [Signature]



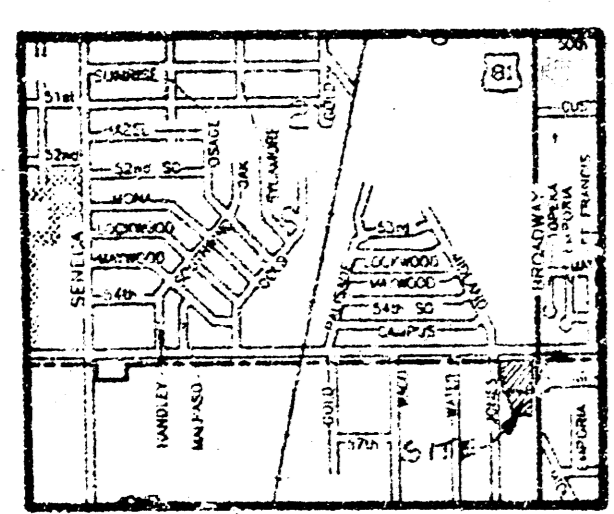

North Arrow
 Scale: 1" = 100'
 Survey Data: [Illegible]