


WOOLCOTT FIRST ADDITION
(Drainage)

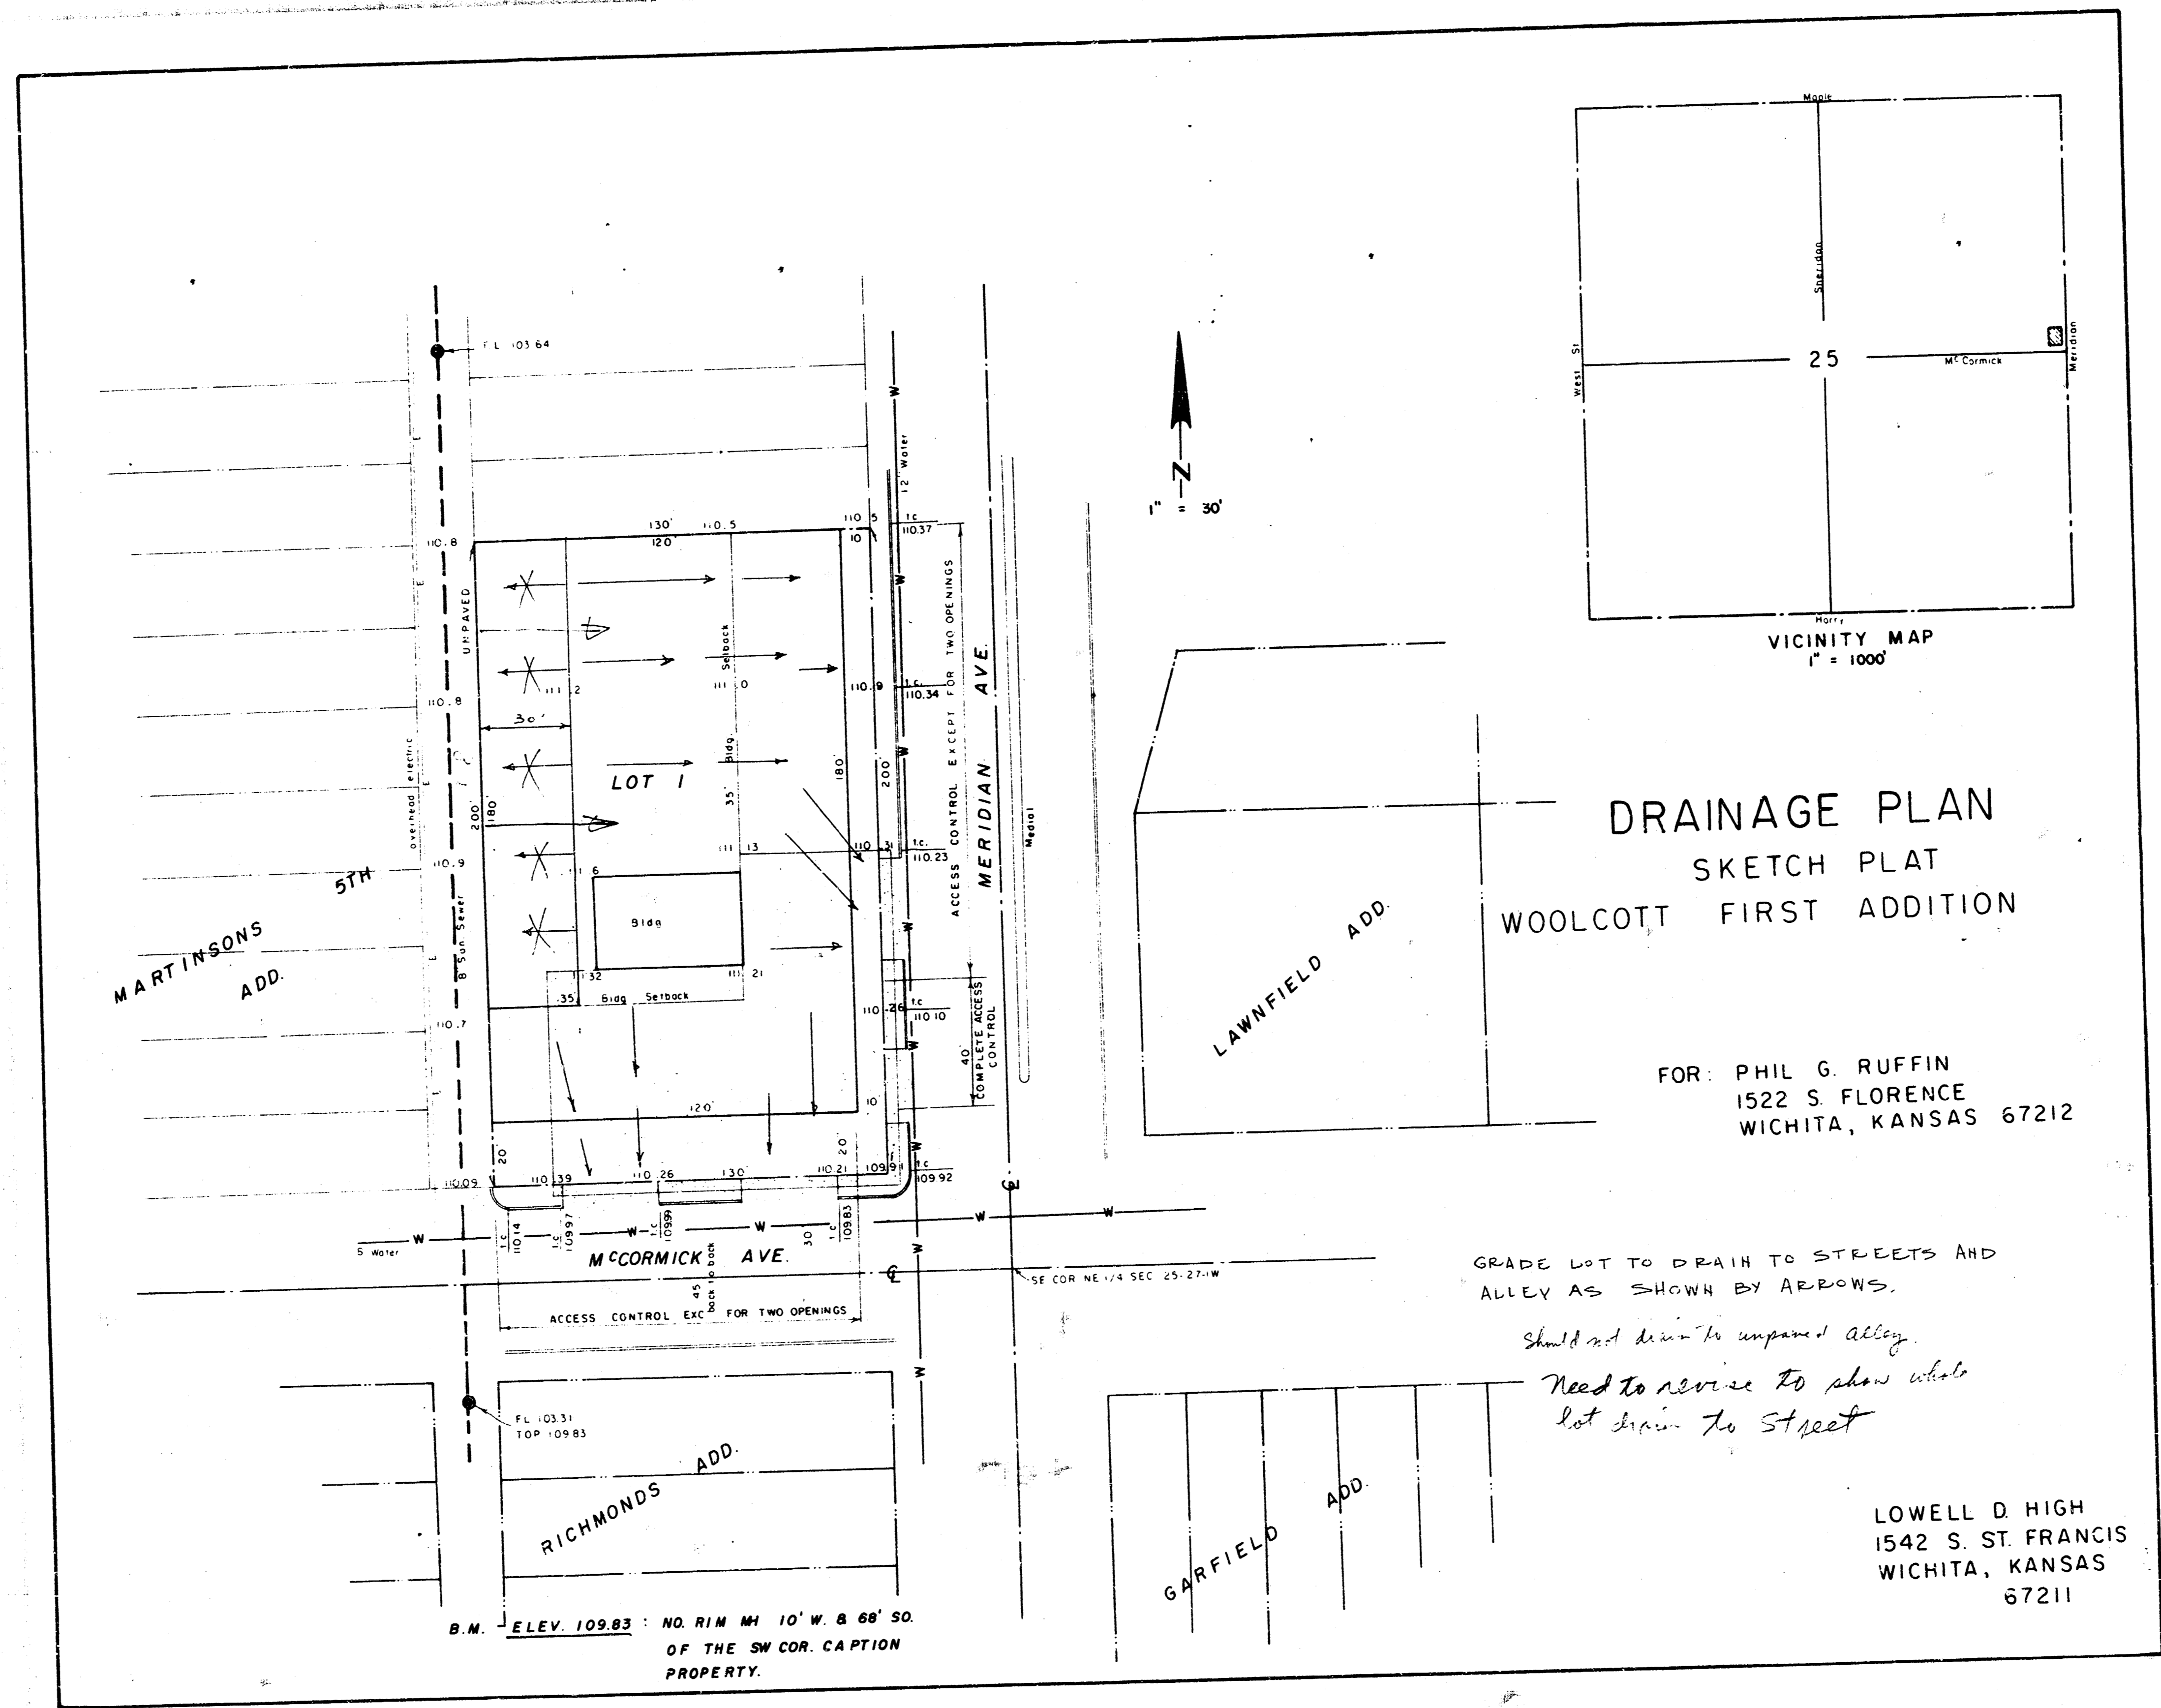

DRAINAGE PLAN
 SKETCH PLAT
 WOOLCOTT FIRST ADDITION

FOR: PHIL G. RUFFIN
 1522 S. FLORENCE
 WICHITA, KANSAS 67212

GRADE LOT TO DRAIN TO STREETS AND
 ALLEY AS SHOWN BY ARROWS.
Should not drain to unpaved alley.
*Need to revise to show whole
 lot drain to street*

LOWELL D. HIGH
 1542 S. ST. FRANCIS
 WICHITA, KANSAS
 67211

B.M. ELEV. 109.83 NO. RIM 10' W. & 68' SO.
 OF THE SW COR. CAPTION
 PROPERTY.