


OF-3


OF-2

OF-1

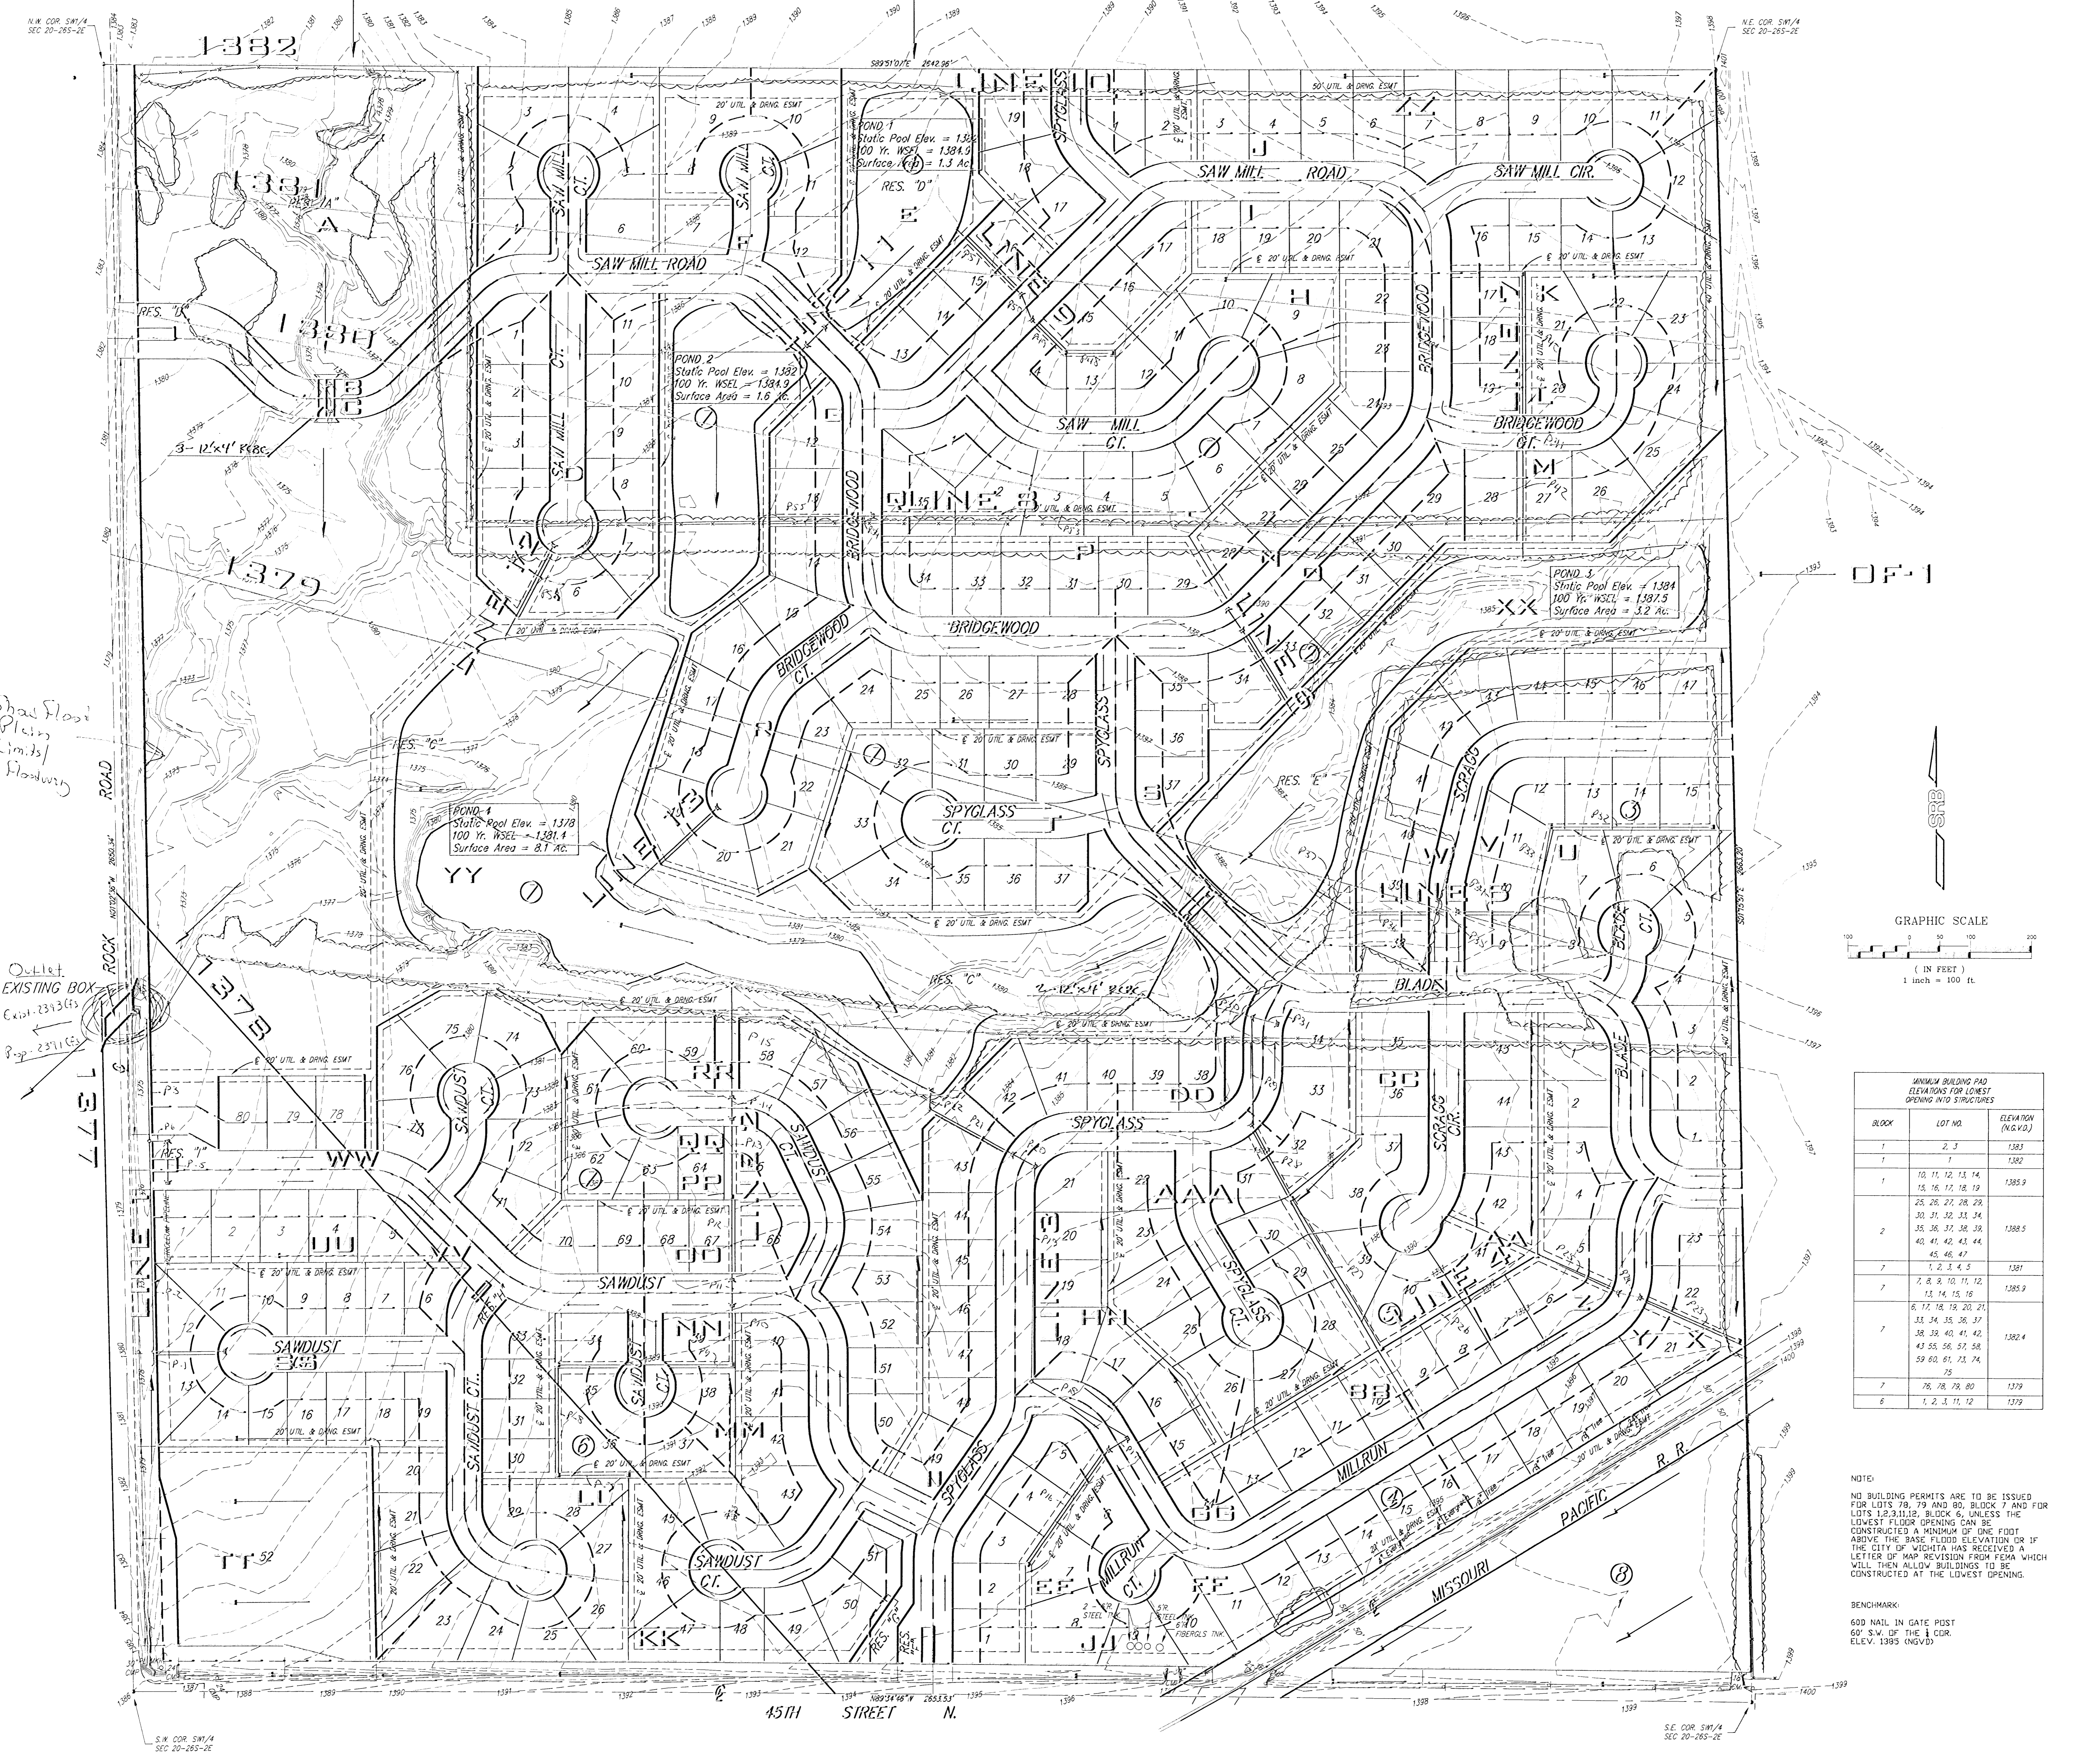

Shed Floor  
Plum Limits  
Flowing

Outlet  
EXISTING BOX  
Exist. 2343 (G)  
Prop. 2371 (G)

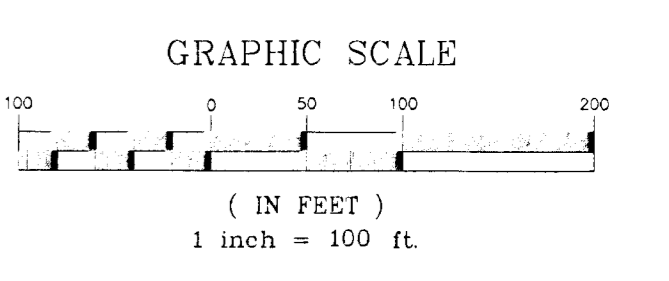

BLOCK	LOT NO.	ELEVATION (NGVD)
1	2, 3	1383
1	1	1382
1	10, 11, 12, 13, 14, 15, 16, 17, 18, 19	1385.9
2	25, 26, 27, 28, 29, 30, 31, 32, 33, 34, 35, 36, 37, 38, 39, 40, 41, 42, 43, 44, 45, 46, 47	1388.5
7	1, 2, 3, 4, 5	1381
7	7, 8, 9, 10, 11, 12, 13, 14, 15, 16	1385.9
7	76, 78, 79, 80	1379
6	1, 2, 3, 11, 12	1379

NOTE:  

BENCHMARK:  
60D NAIL IN GATE POST  
60' S.W. OF THE 1/4 COR.  

NOTE:  
All storm water drain systems shown on this plan are designed to carry the 100 year frequency rainfall event. The Consulting Engineer may reduce the size of pipes to the 2 year frequency rainfall event during design provided that the street and lot grading allows for conveyance of the 100 year frequency rainfall event without damage to any properties located outside the street right-of-way. All calculations shall be submitted to the City Engineer for approval prior to construction of the storm water sewer system.

# DRAINAGE PLAN SAWMILL CREEK ADDITION