
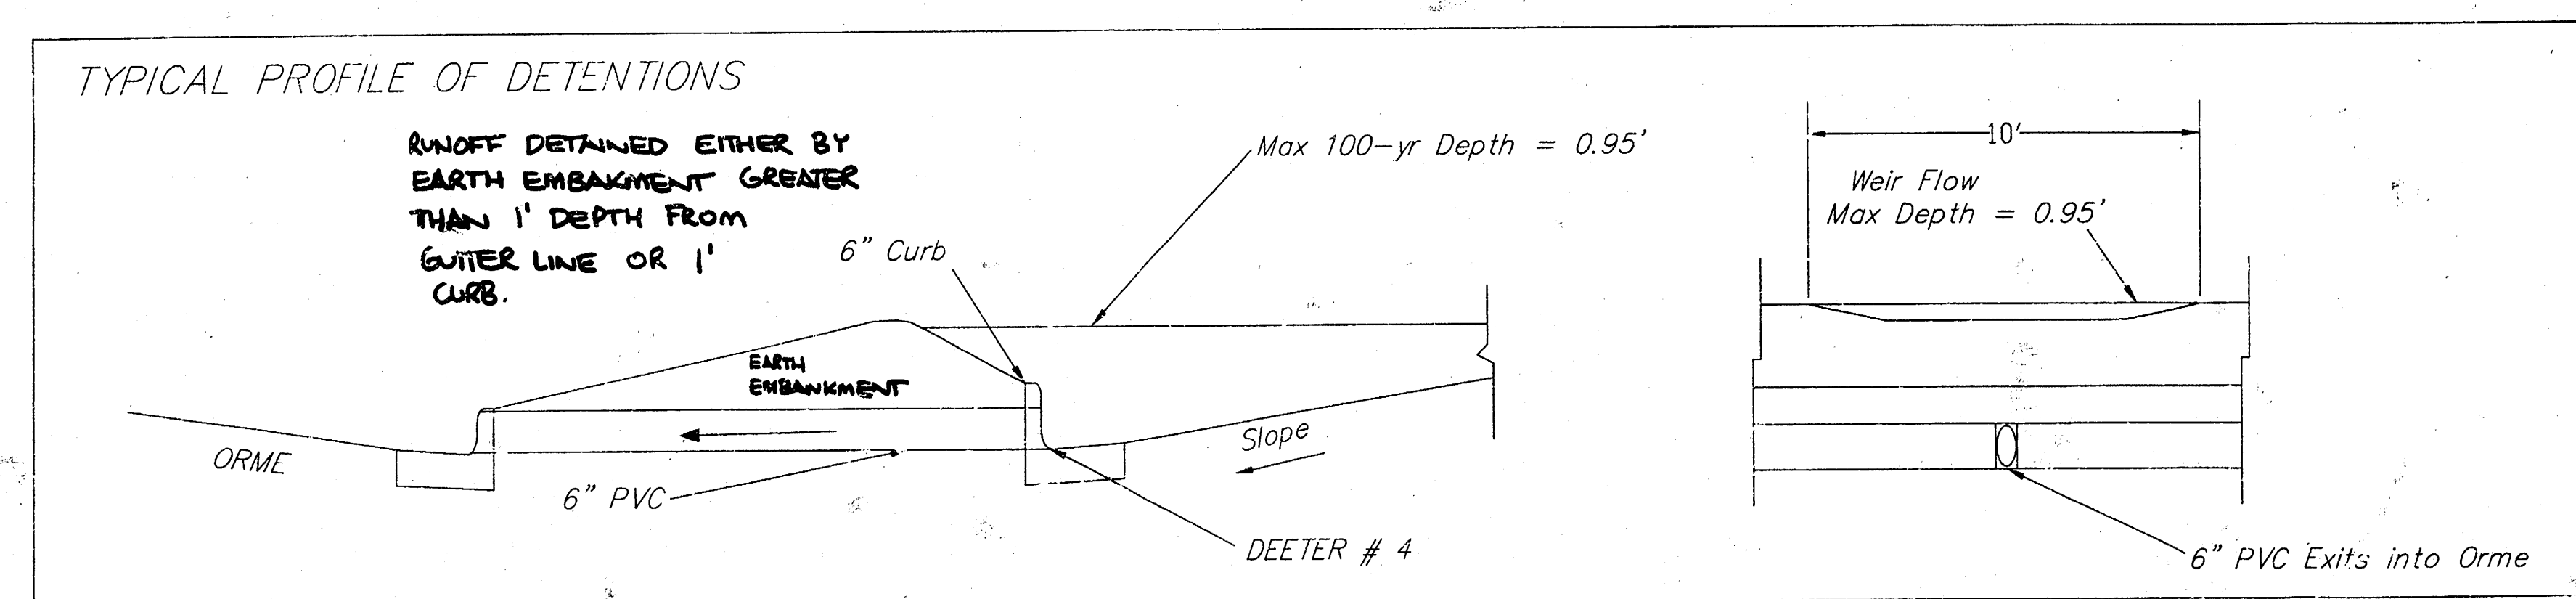



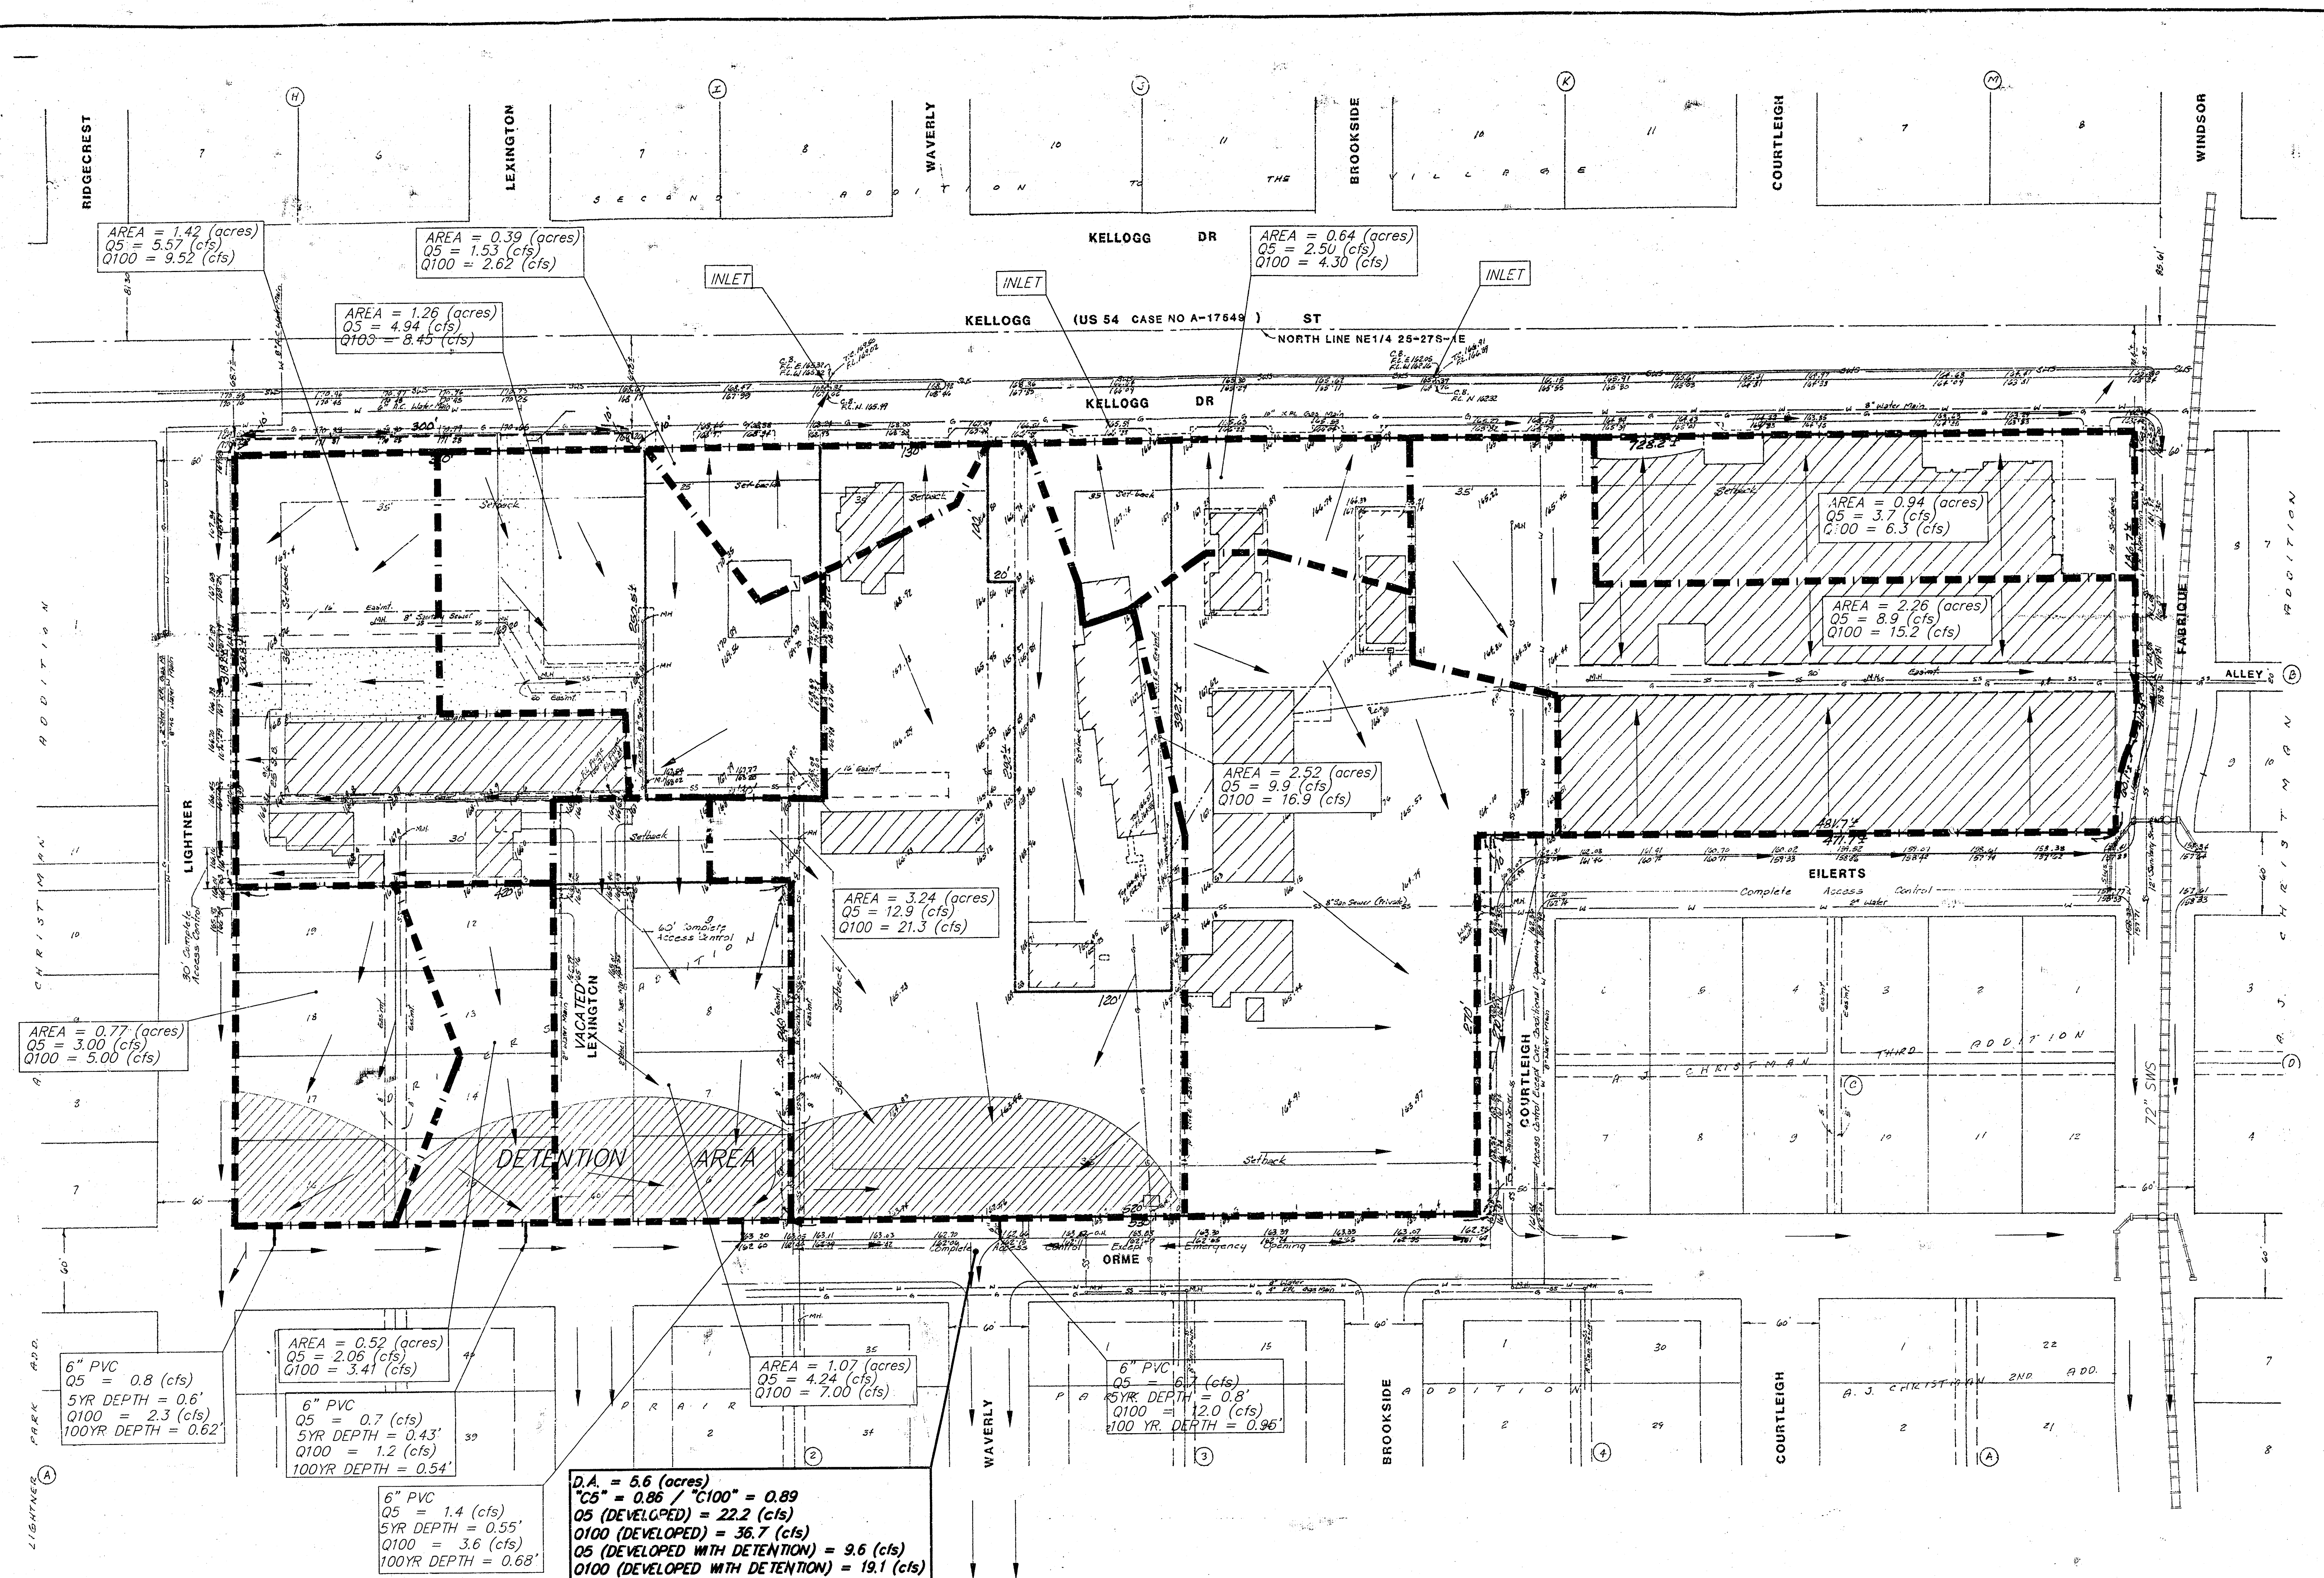


DRAINAGE PLAN

DAVIS MOORE 5TH & 13TH ADDITIONS

Owner: D. and M. Investments, a partnership

This proposed Drainage Plan will detain the peak runoff from existing paved areas and the new Davis Moore 13th Addition by detaining the runoff in the parking lot before discharging off the property. Under this plan, the 100 year storm will discharge 17.6 (cfs) less with the proposed detention.

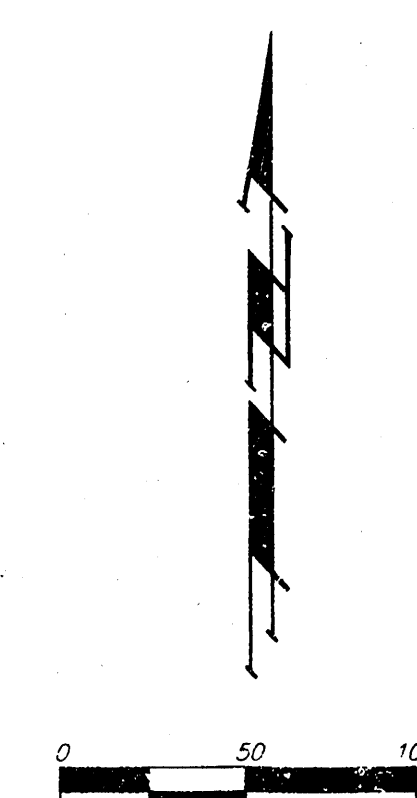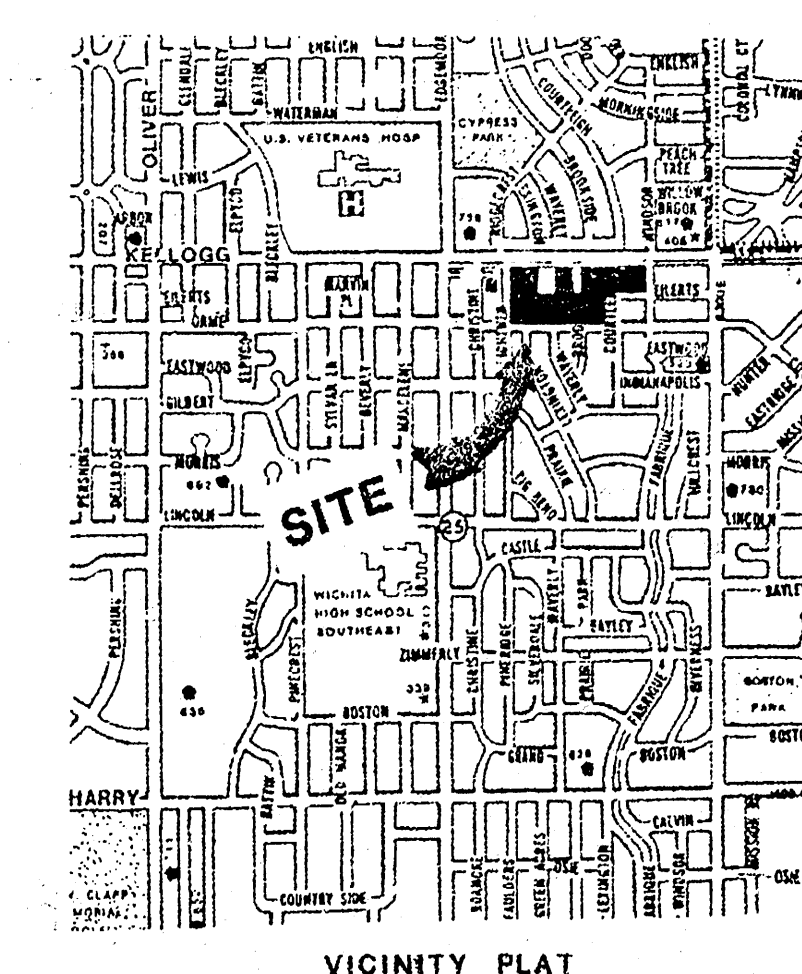

REVISED 11 FEB 1999
Revised 10 Feb 1999
Revised 26 Jan 1999

BAUGHMAN COMPANY P.A.
ENGINEERING, SURVEYING, & PLANNING
316-262-7271 • 316-262-7272 • 316-262-7273 • 316-262-7274