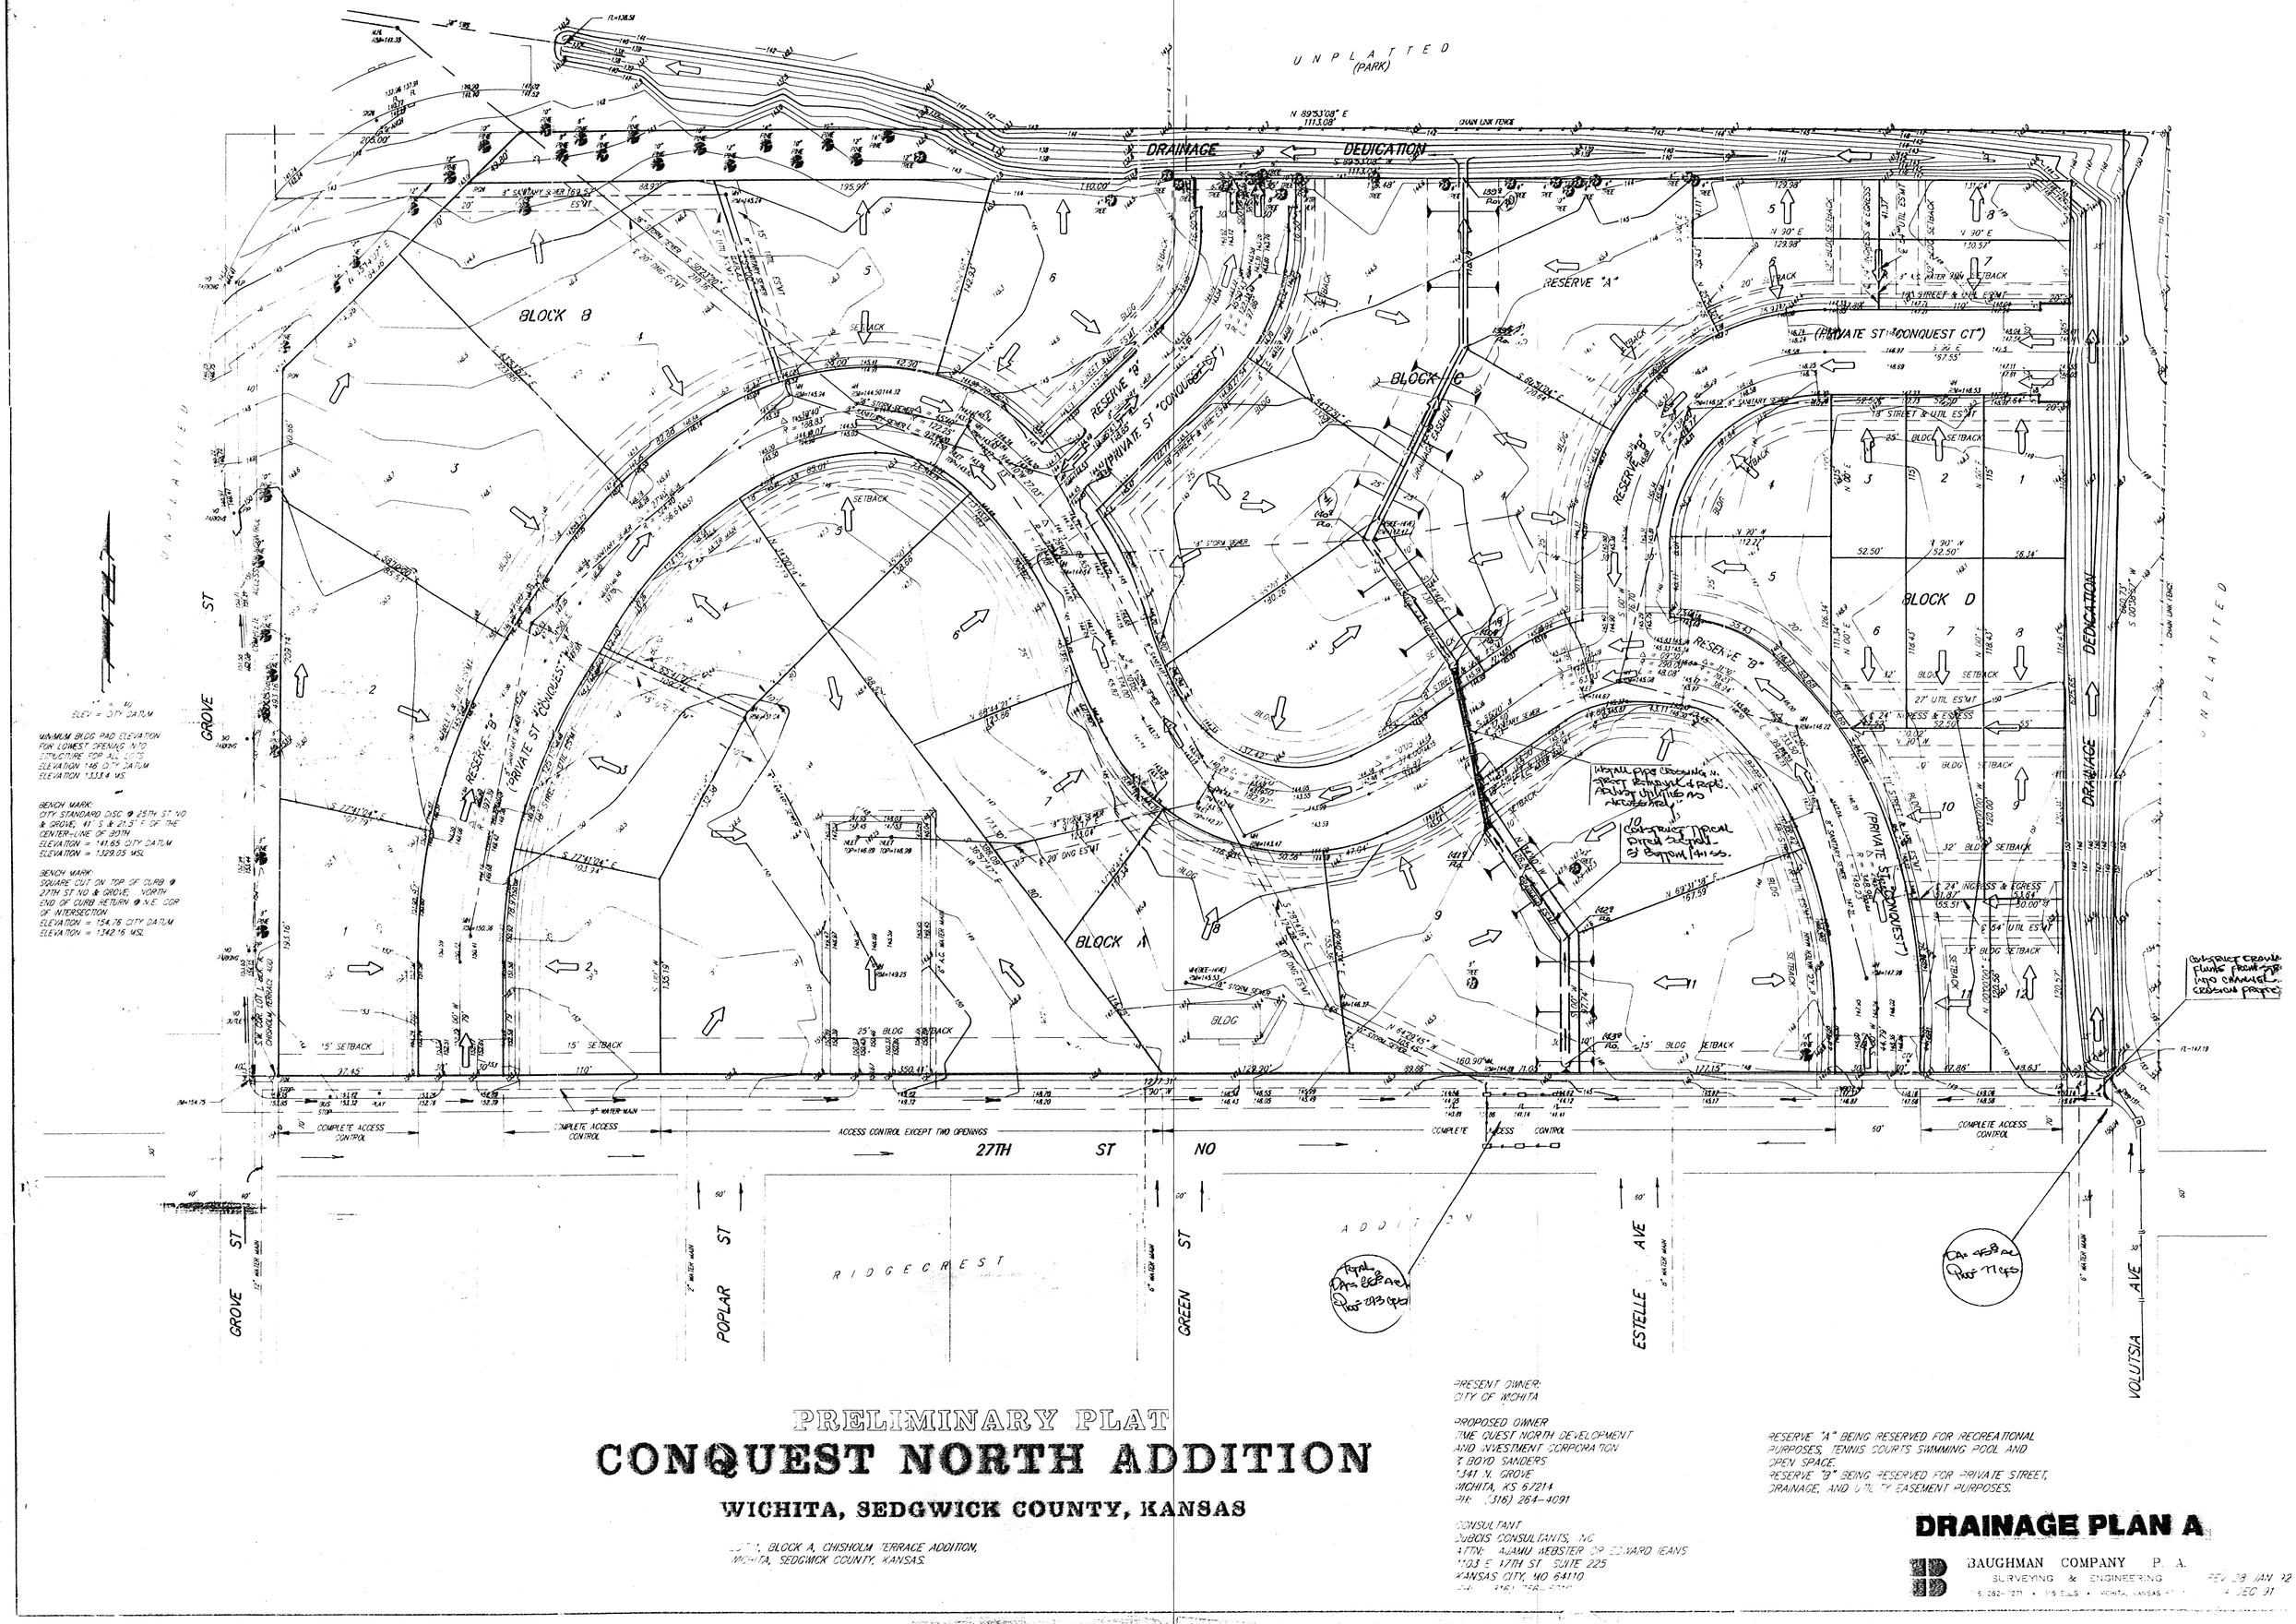

PRELIMINARY PLAT

CONQUEST NORTH ADDITION

WICHITA, SEDGWICK COUNTY, KANSAS

LOT 1, BLOCK A, CHISHOLM TERRACE ADDITION, WICHITA, SEDGWICK COUNTY, KANSAS.

PRESENT OWNER:
CITY OF WICHITA

PROPOSED OWNER
TIME QUEST NORTH DEVELOPMENT AND INVESTMENT CORPORATION
% BOYD SANDERS
1341 N. GROVE
WICHITA, KS 67214
PH: (316) 264-4091

CONSULTANT
DUBOIS CONSULTANTS, INC.
ATTN: AJAMU WEBSTER OR EDWARD JEANS
1103 E. 17TH ST. SUITE 225
KANSAS CITY, MO 64110
PH: (816) 753-8700

RESERVE "A" BEING RESERVED FOR RECREATIONAL PURPOSES, TENNIS COURTS SWIMMING POOL AND OPEN SPACE.
RESERVE "B" BEING RESERVED FOR PRIVATE STREET, DRAINAGE, AND UTILITY EASEMENT PURPOSES.

DRAINAGE PLAN A

BAUGHMAN COMPANY P. A.
SURVEYING & ENGINEERING
REV. 28 JAN 92
DEC 91