SW7

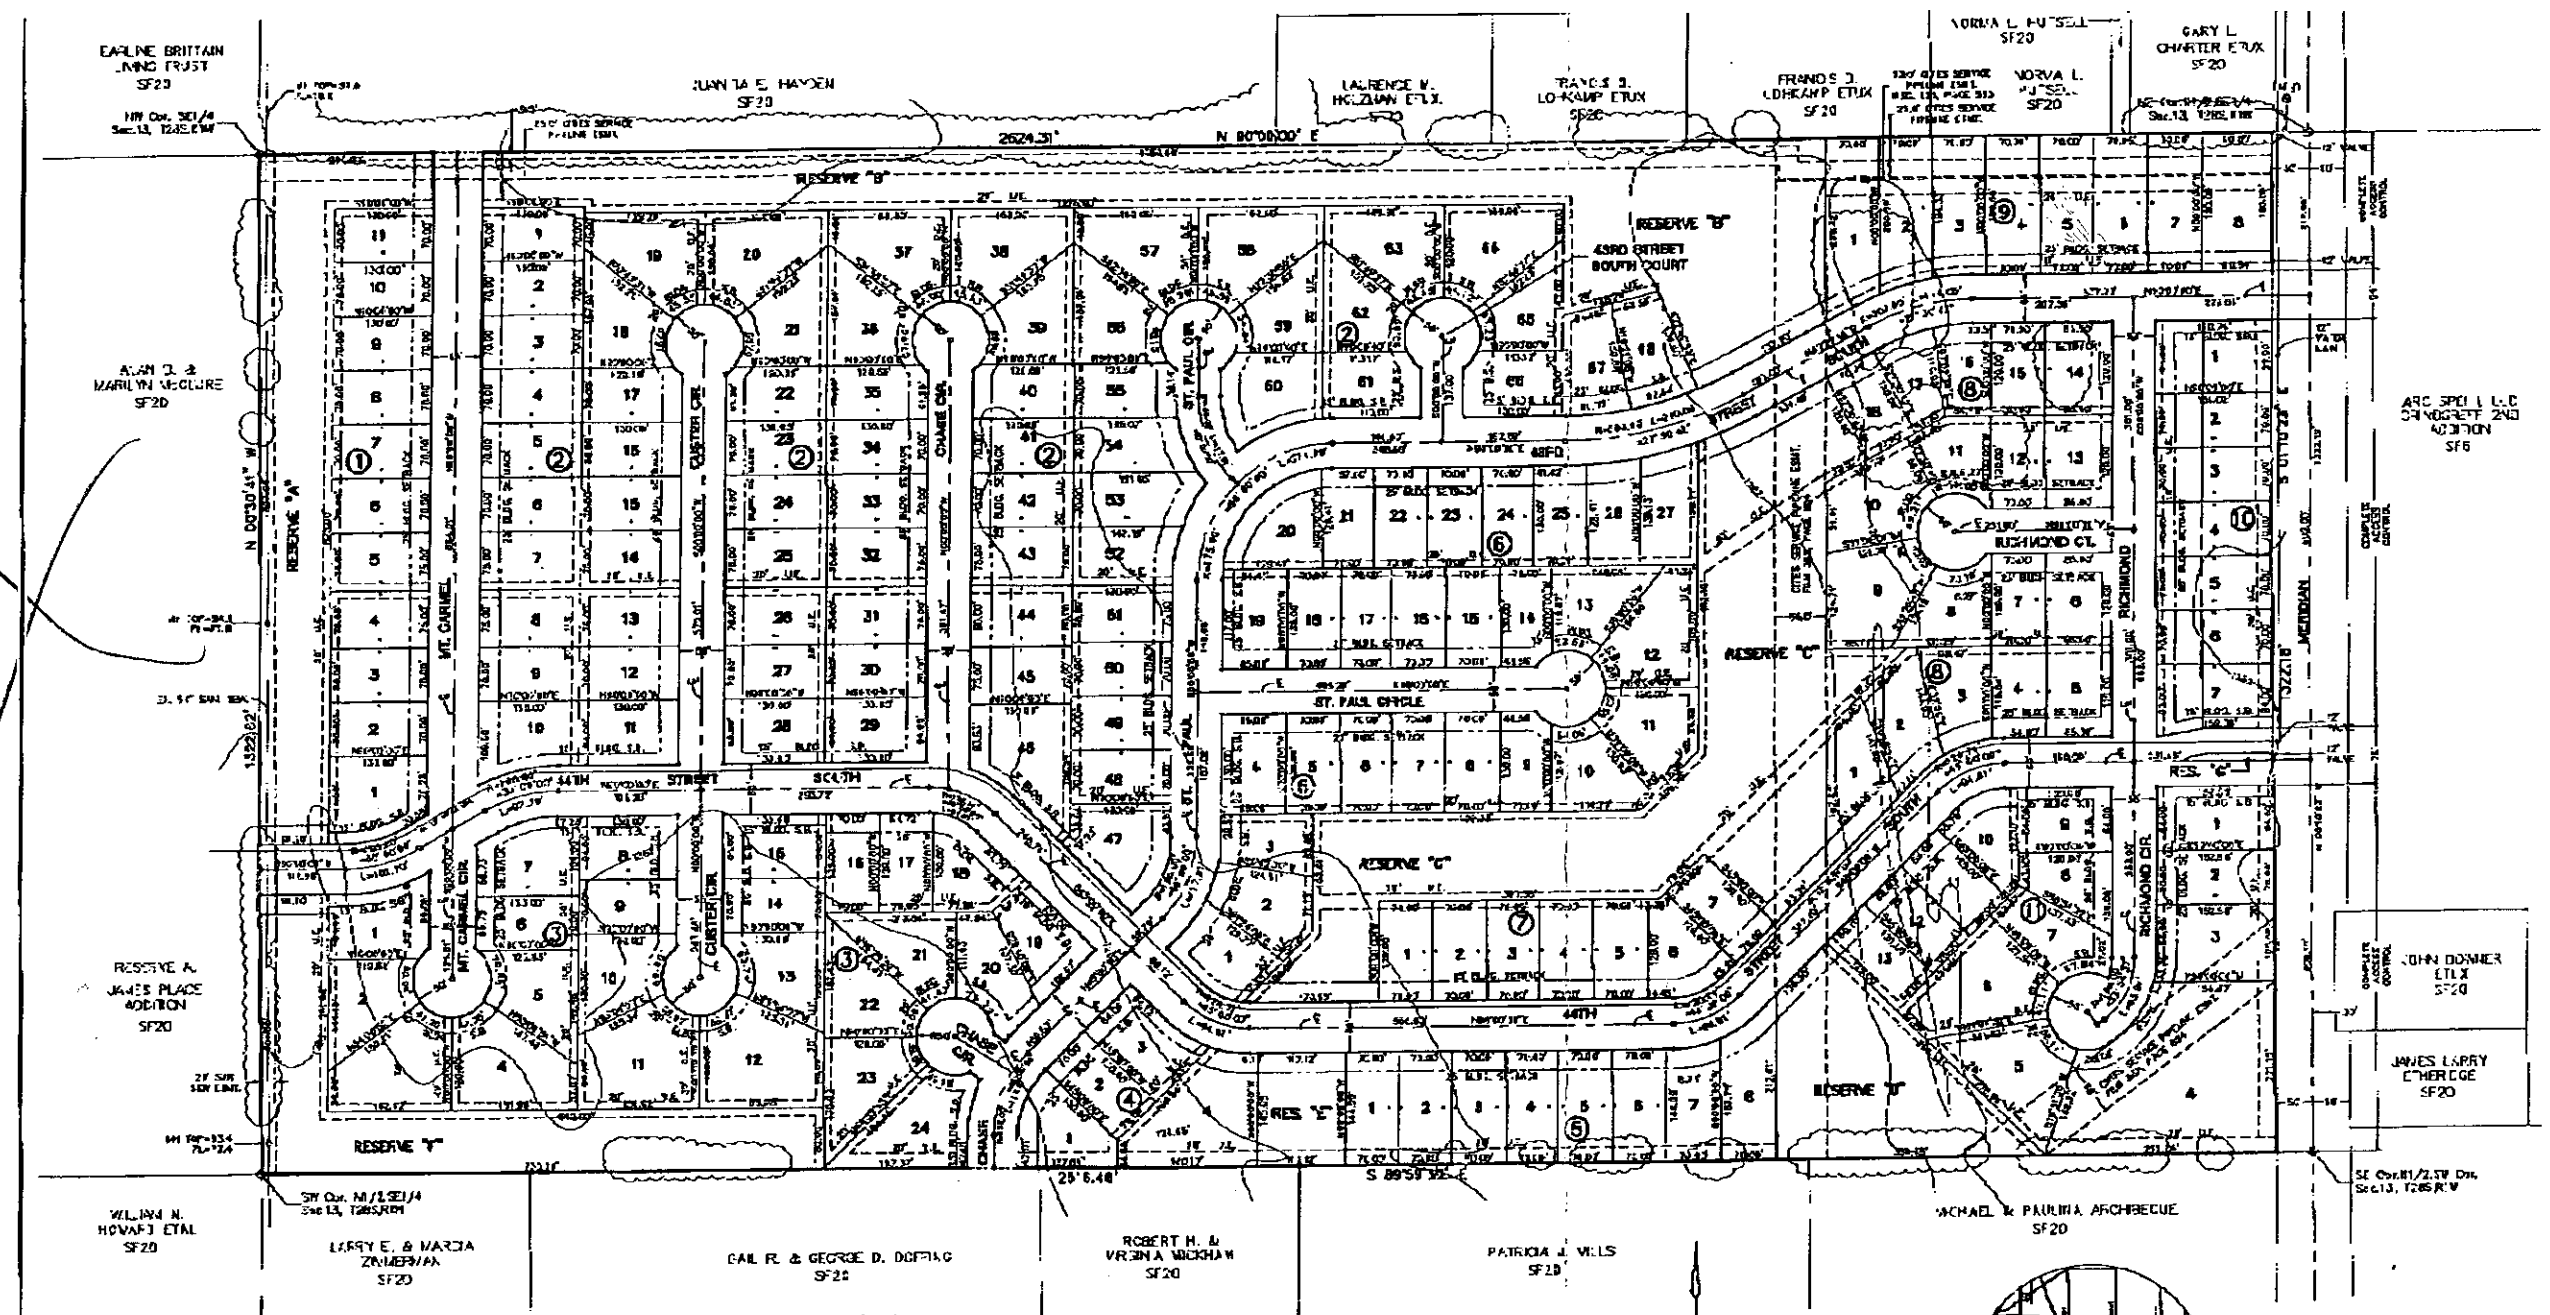

PRELIMINARY PLAT

SOUTH PARK THIRD ADDITION

Post-it® Fax Note 7671	Date 4/30	# of pages ▶ 1
To John Schmitt	From Greg Allison	
Co./Dept. SRR	Co. MKEC	

MID-KANSAS ENGINEERING CONSULTANTS, INC.
411 N. WEBB ROAD
WICHITA, KS 67206
316-684-5040