
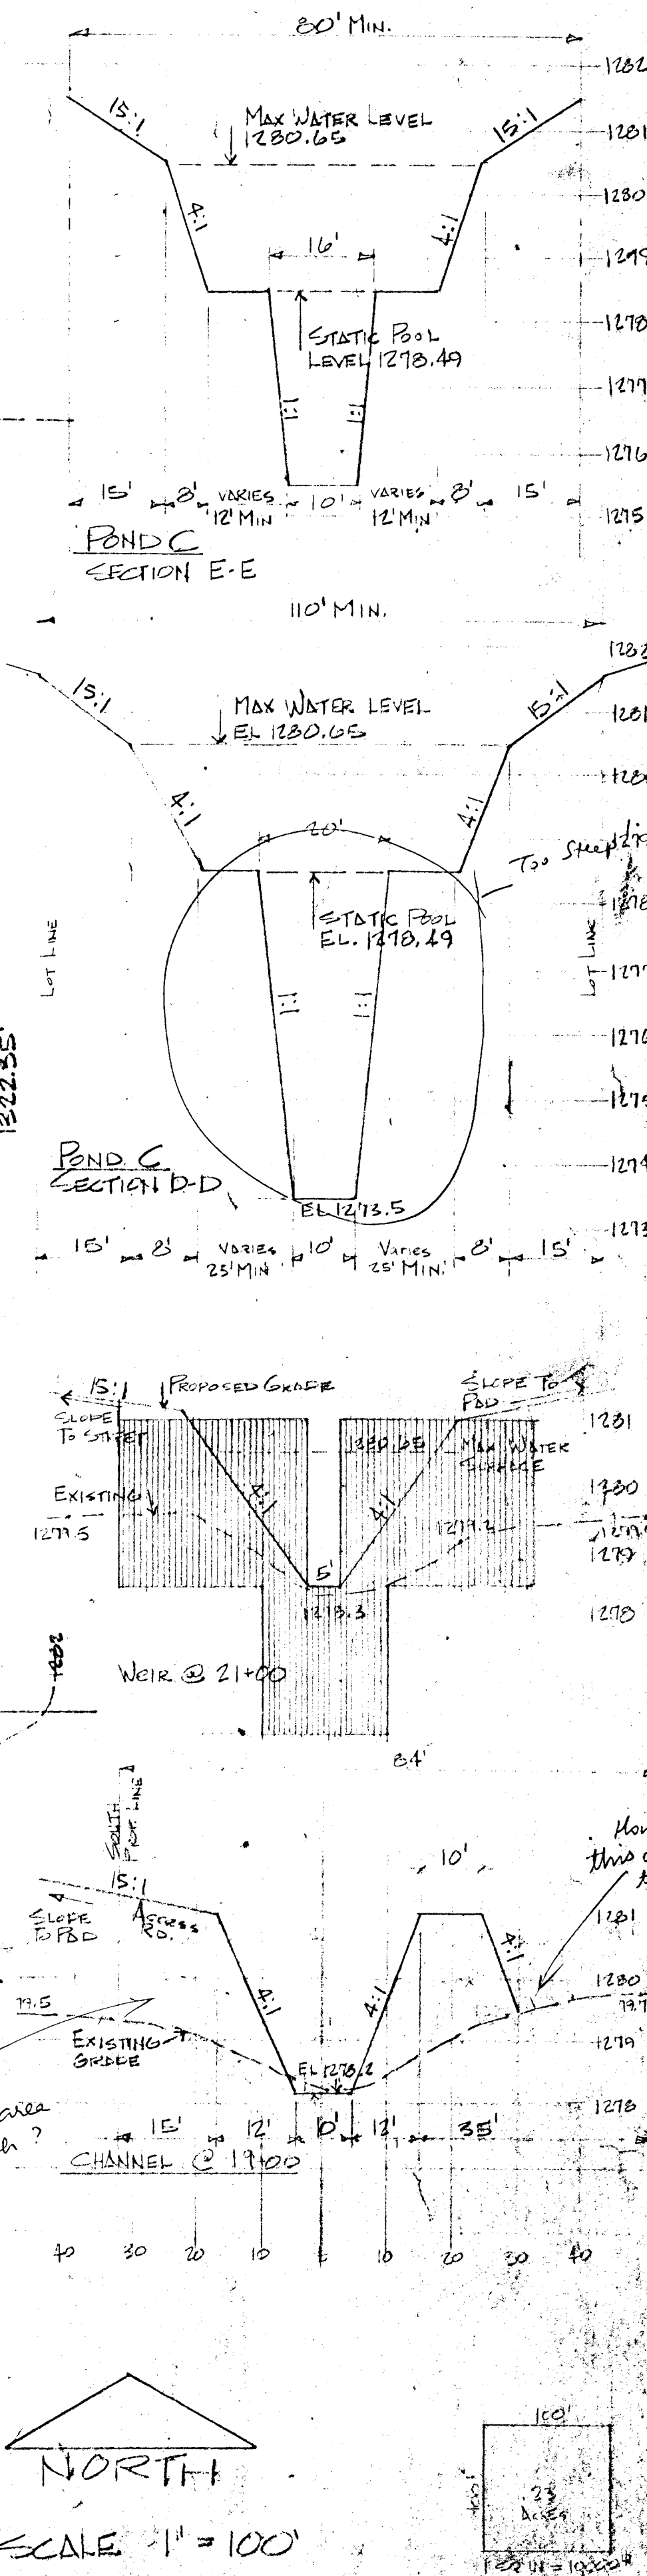


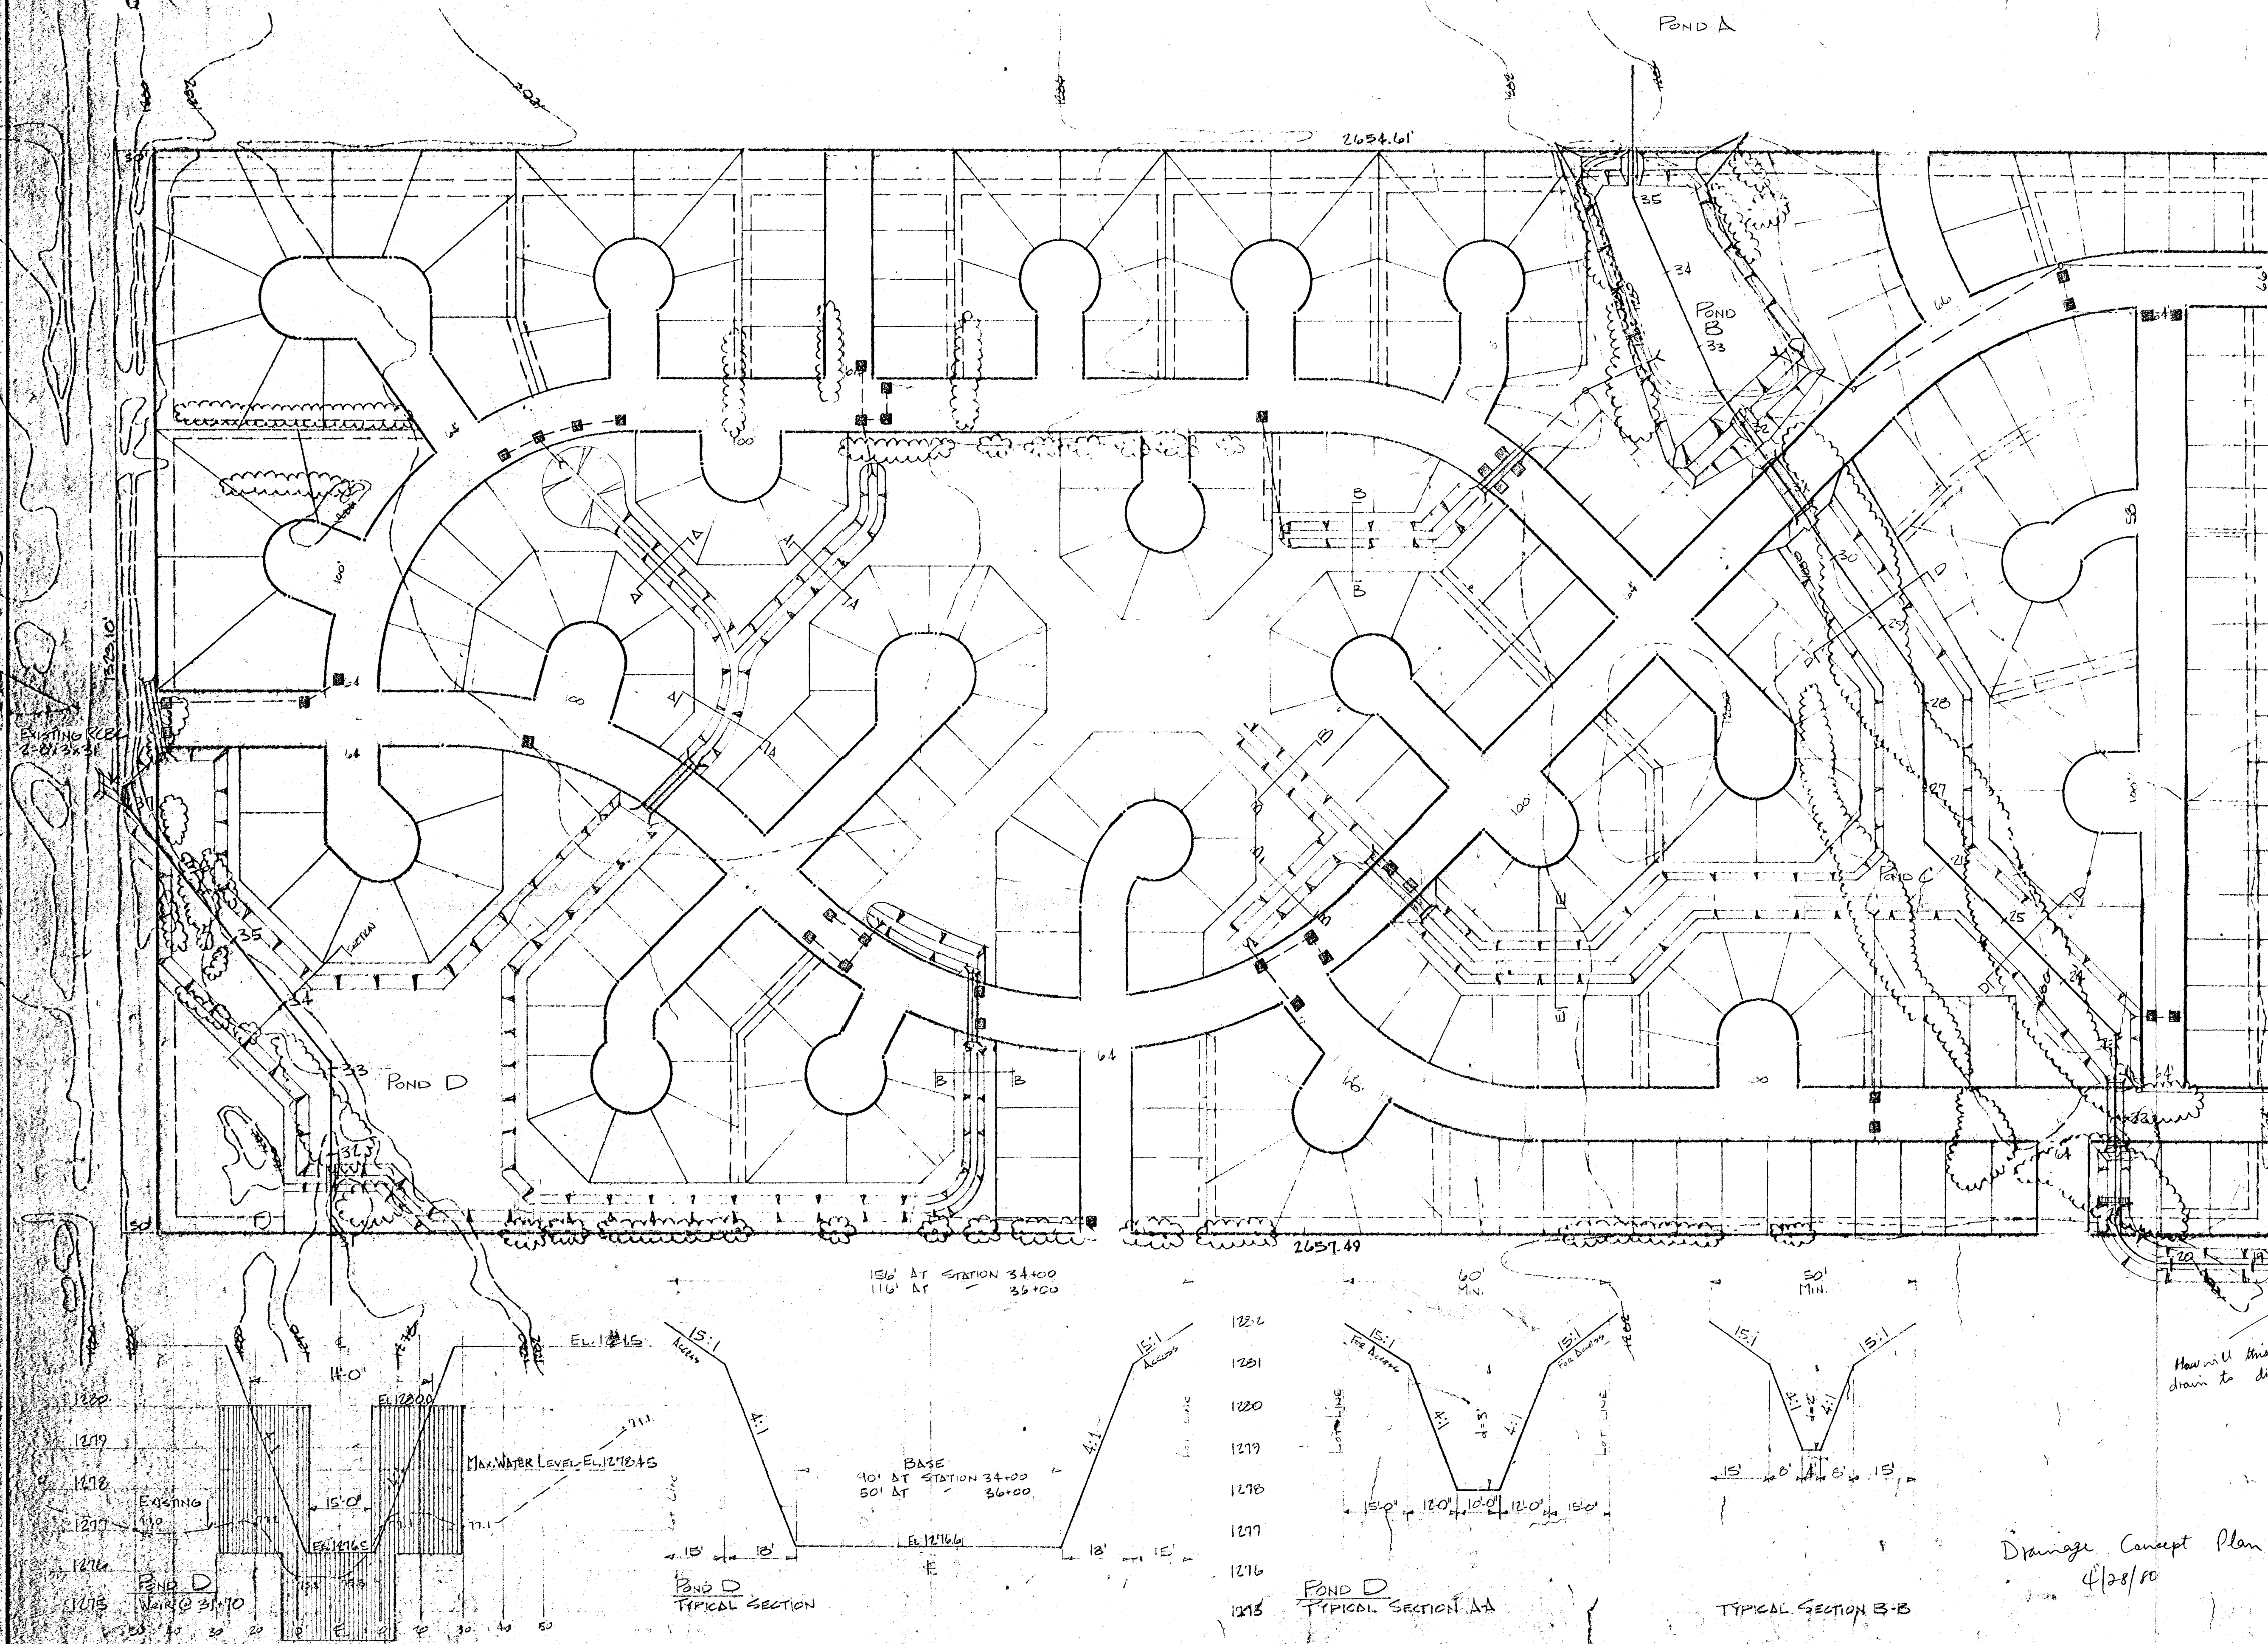

LAWRENCE E. WELLS			
A R C H I T E C T			
254 LAURA SUITE 205 WICHITA, KANSAS 67211			
DATE		CHECKED	
15 APR 80		REVIS	
DRAWN		PROJECT	
15 APR 80		1900	
PLAN AND SECTIONS		SHEET	
15 APR 80		OF	

Drainage Concept Plan
4/28/80

NORTH
SCALE 1" = 100'

100' SCALE
1" = 100'