


# LOT DRAINAGE PLAN

## THE MOORINGS 7TH ADDITION

February 1993  
Revised January 28, 1998

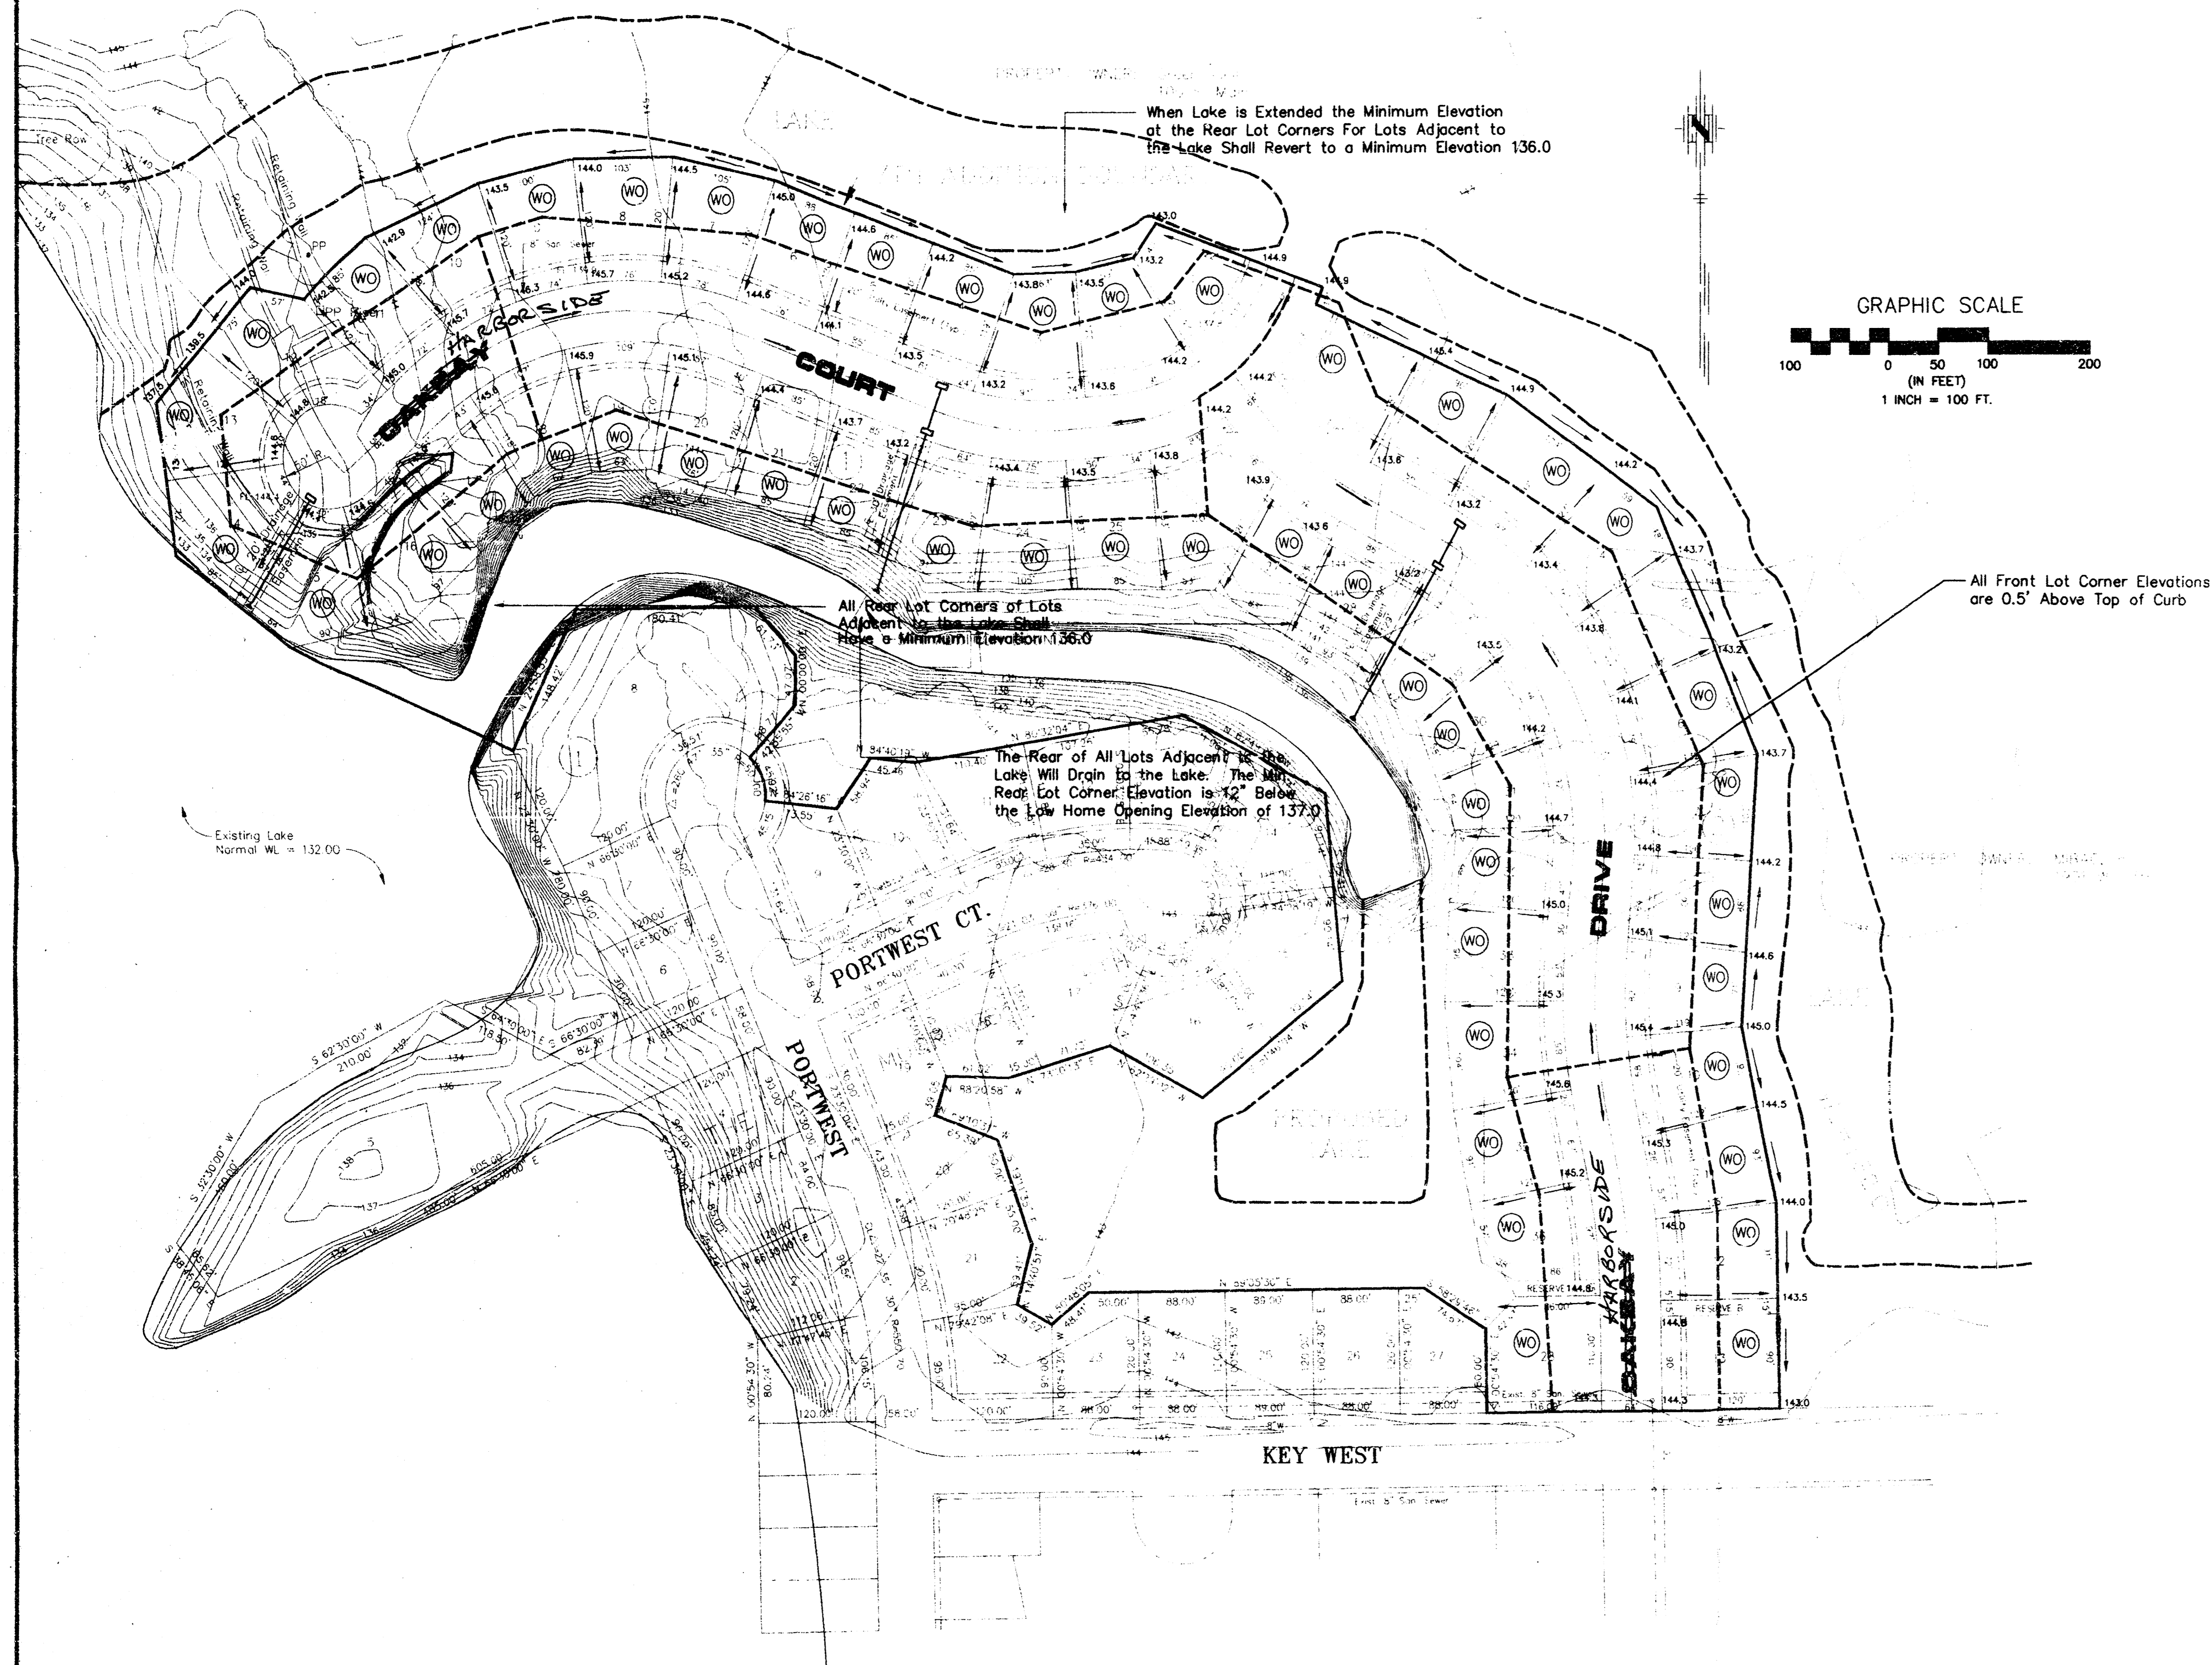

**NOTES:**

1. Topo Survey Date 6-24-92  
B.M. #7-1 59' West & 32.3' North of Meridian and  
Keywest Elev. 141.85 (City of Wichita Datum)
- B.M. #7-2 "+" cut on center 10' curb inlet at East  
side cul-de-sac built of Portwest Court in  
The Moorings 5th Addition  
Elev. 142.30 (City of Wichita Datum)
2. Reserve A is reserved for Open Space, a lake and  
Boat Docks to be owned and maintained by the  
owners of the adjacent lots
3. Lots adjacent to the Lake shall have a continuous  
minimum high point ground Elevation of 143.0  
City Datum.

WO - Above Basement

All Rear Lot Corners of Lots  
Adjacent to the Lake Shall  
Have a Minimum Elevation of 136.0


The Rear of All Lots Adjacent to the  
Lake Will Drain to the Lake. The  
Rear Lot Corner Elevation is 12" Below  
the Low Home Opening Elevation of 137.0

All Front Lot Corner Elevations  
are 0.5' Above Top of Curb

Existing Lake  
Normal WL = 132.00

APPROVED  
DRAINAGE PLAN

**PE** POE & ASSOCIATES OF KANSAS, INC.  
CONSULTING ENGINEERS  
5940 E. Central, Suite 300 • Wichita, KS 67208 • 316/693-4114 • Fax 316/693-4444

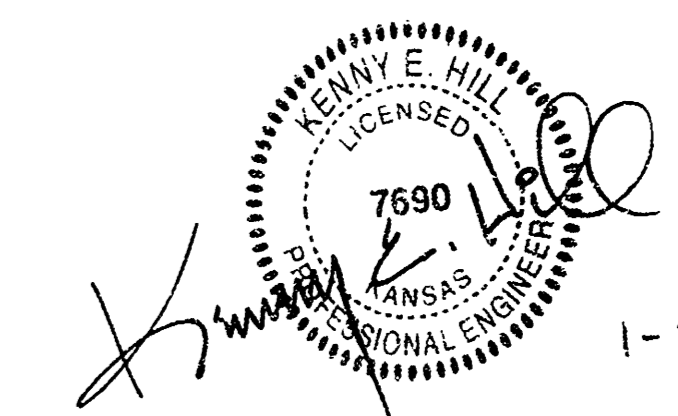

1-28-98

*THE MOORINGS 7th*