


TYPICAL VIEW OUT
NO SCALE

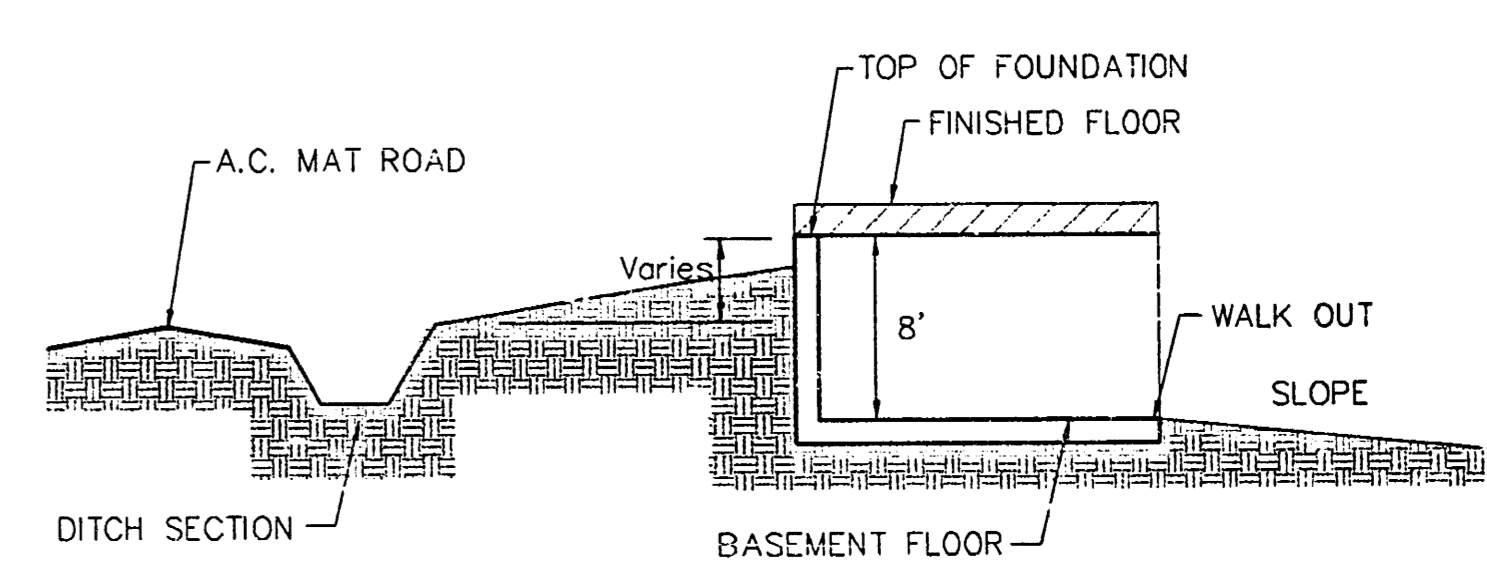

TYPICAL WALK OUT
NO SCALE

BENCHMARK:
TOP OF 1" IRON, 12" DEEP 1/4 COP,
SEC. 27, TWP. 27-S, R-2-W
ELEV = 1396.53 M.S.L.
(2008.13 CITY DATUM)

** Lots 37-40, Block A will
require 30" entrance pipe.

MINIMUM BUILDING PAD ELEVATION FOR LOWEST OPENING TO THE STRUCTURES			
LOT	BLOCK	CITY DATUM	MSL
1-22	B	228.6	1416
19-28	A	223.6	1411
1,3,4,5	A	222.6	1410




Revised 3/8/04 by AEG per NBW (Back Yard Grades, Lots 31-36, Blk A)
Revised 2/17/03 by BOT per BLP (Lot 29, Blk A)
Revised 8/19/02 by AEG per NBW
Revised 7/8/02 by AEG per NBW

**REECE FARMS ESTATES
GRADING PLAN
WICHITA, KANSAS**

BAUGHMAN COMPANY P.A.
ENGINEERING, SURVEYING, & PLANNING
316-262-7271 • 315 ELM • WICHITA, KANSAS 67211

DESIGN NBW	DRAWN AHH/JAB	APPROVED NBW	DATE 6/15/98	SCALE 1"=60'
PROJECT NUMBER				SHEET 1 OF 3

97-09-ES1

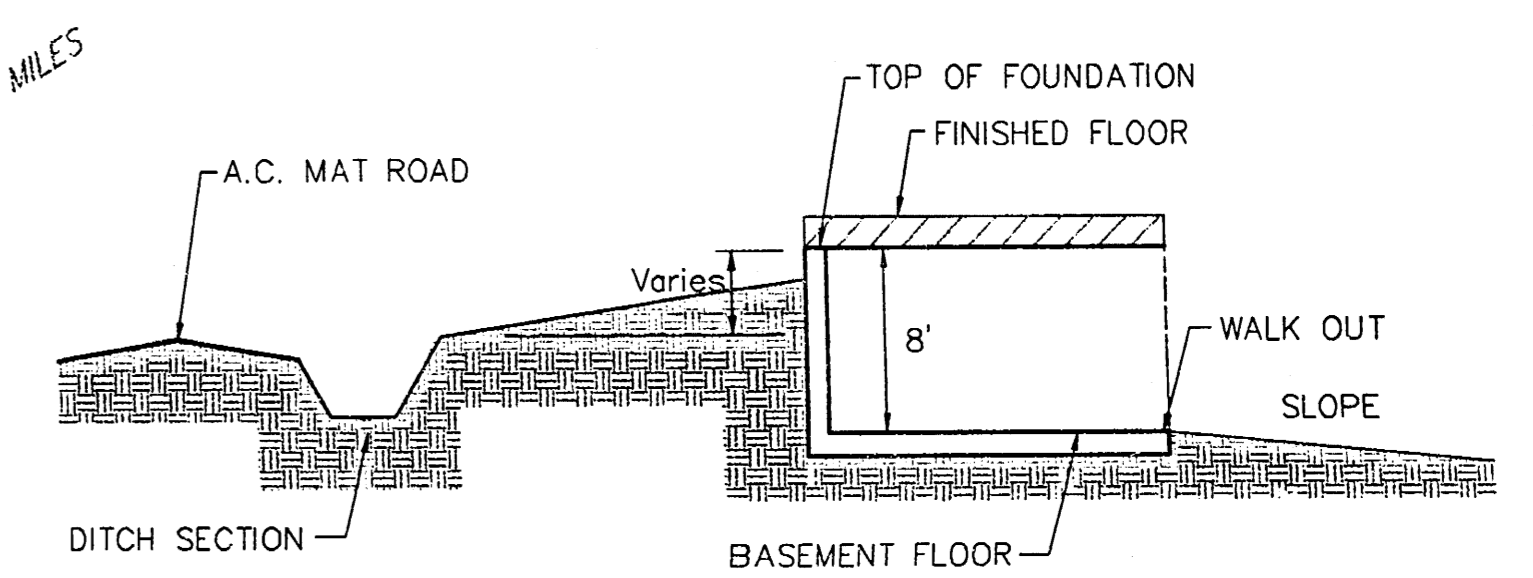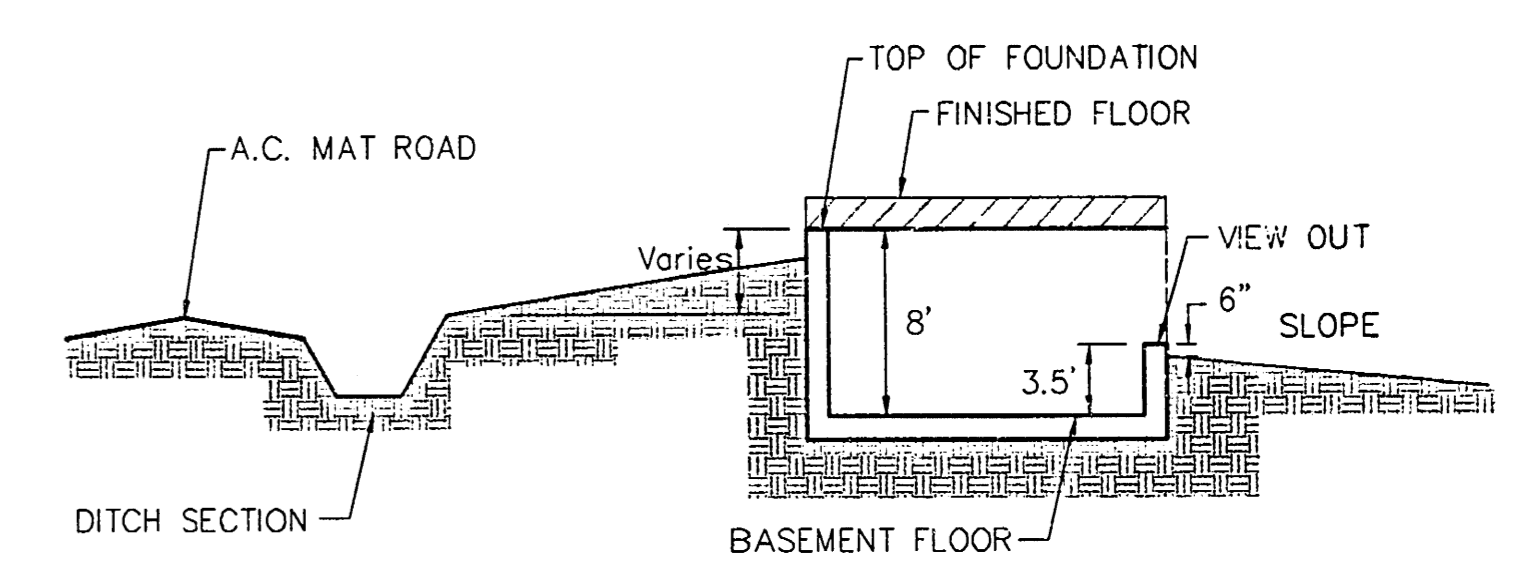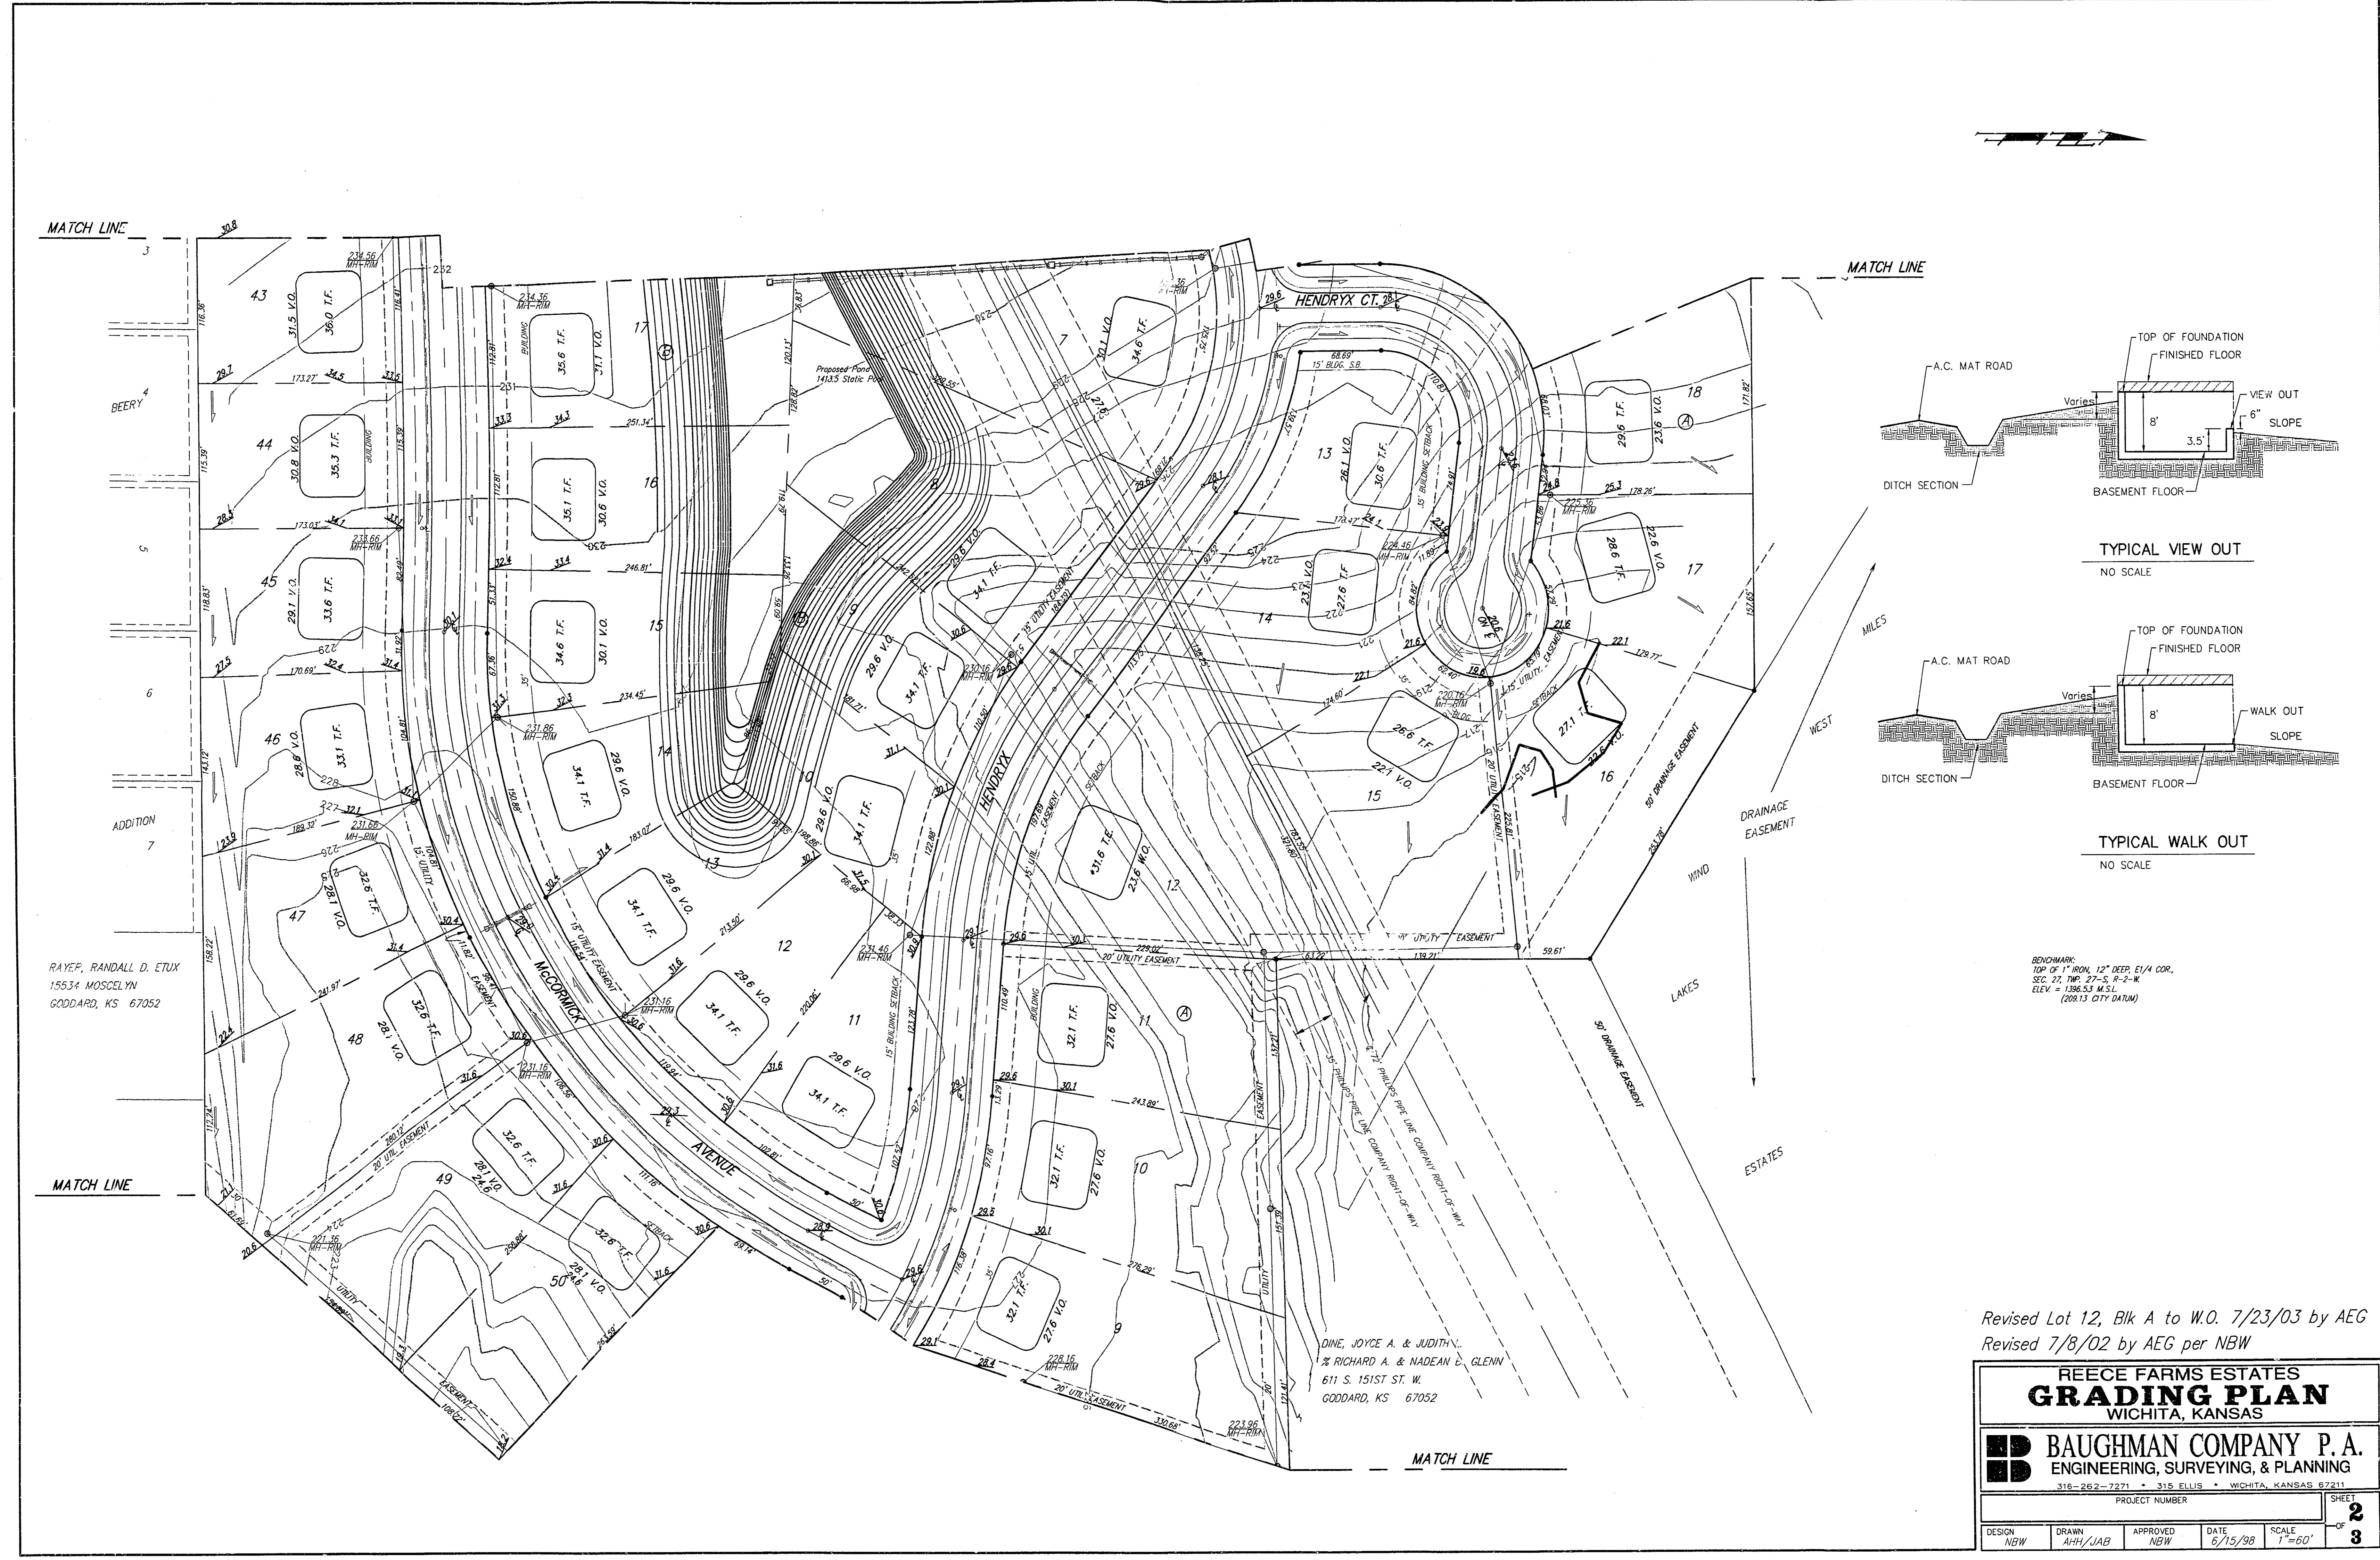

BENCHMARK:
TOP OF 1" IRON, 12" BRONZE, 1/4" COP.
SEC. 22, TWP. 27-S, R-2-W
ELEV. = 1386.53 M.S.L.
(20013 CITY DATUM)

Revised Lot 12, Blk A to W.O. 7/23/03 by AEG
Revised 7/8/02 by AEG per NBW





REECE FARMS ESTATES
GRADING PLAN
WICHITA, KANSAS

BAUGHMAN COMPANY P. A.
ENGINEERING, SURVEYING, & PLANNING
316-262-7271 • 315 ELLIS • WICHITA, KANSAS 67211


DESIGN NBW	DRAWN AHHJ/UA8	APPROVED NBW	DATE 6/15/98
PROJECT NUMBER			SHEET 2 OF 3

REECE/02

MATCH LINE

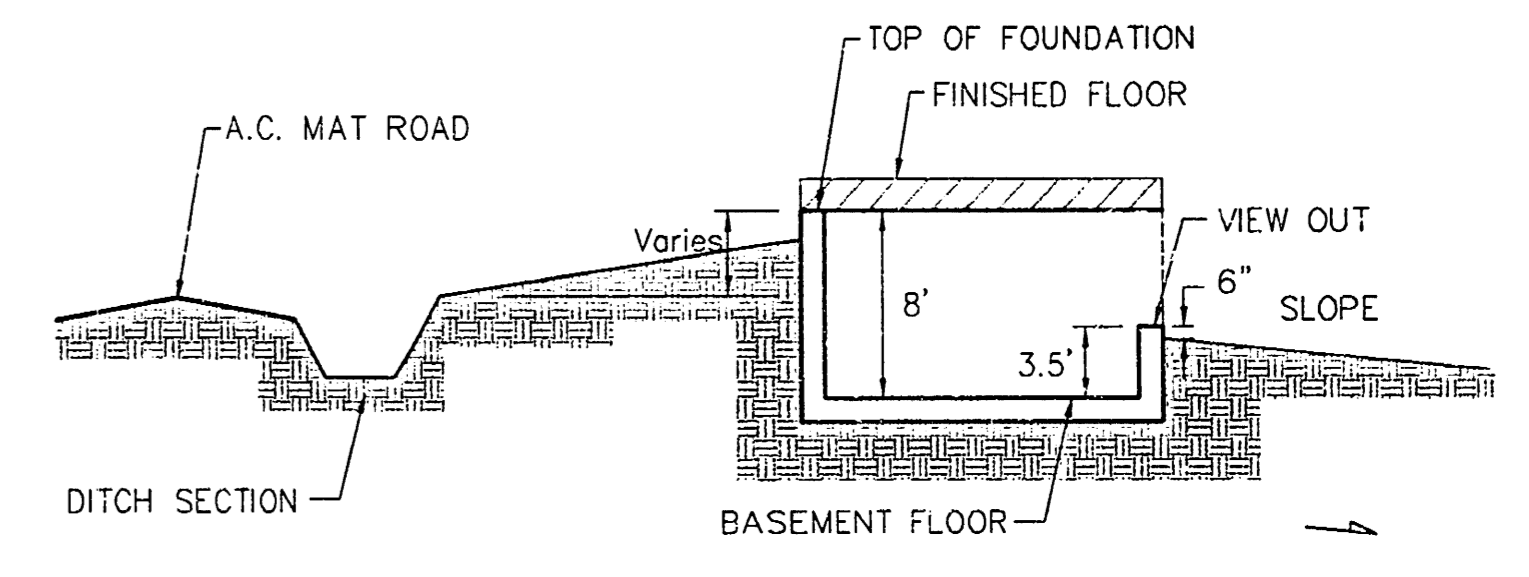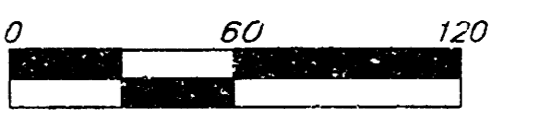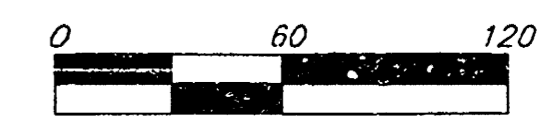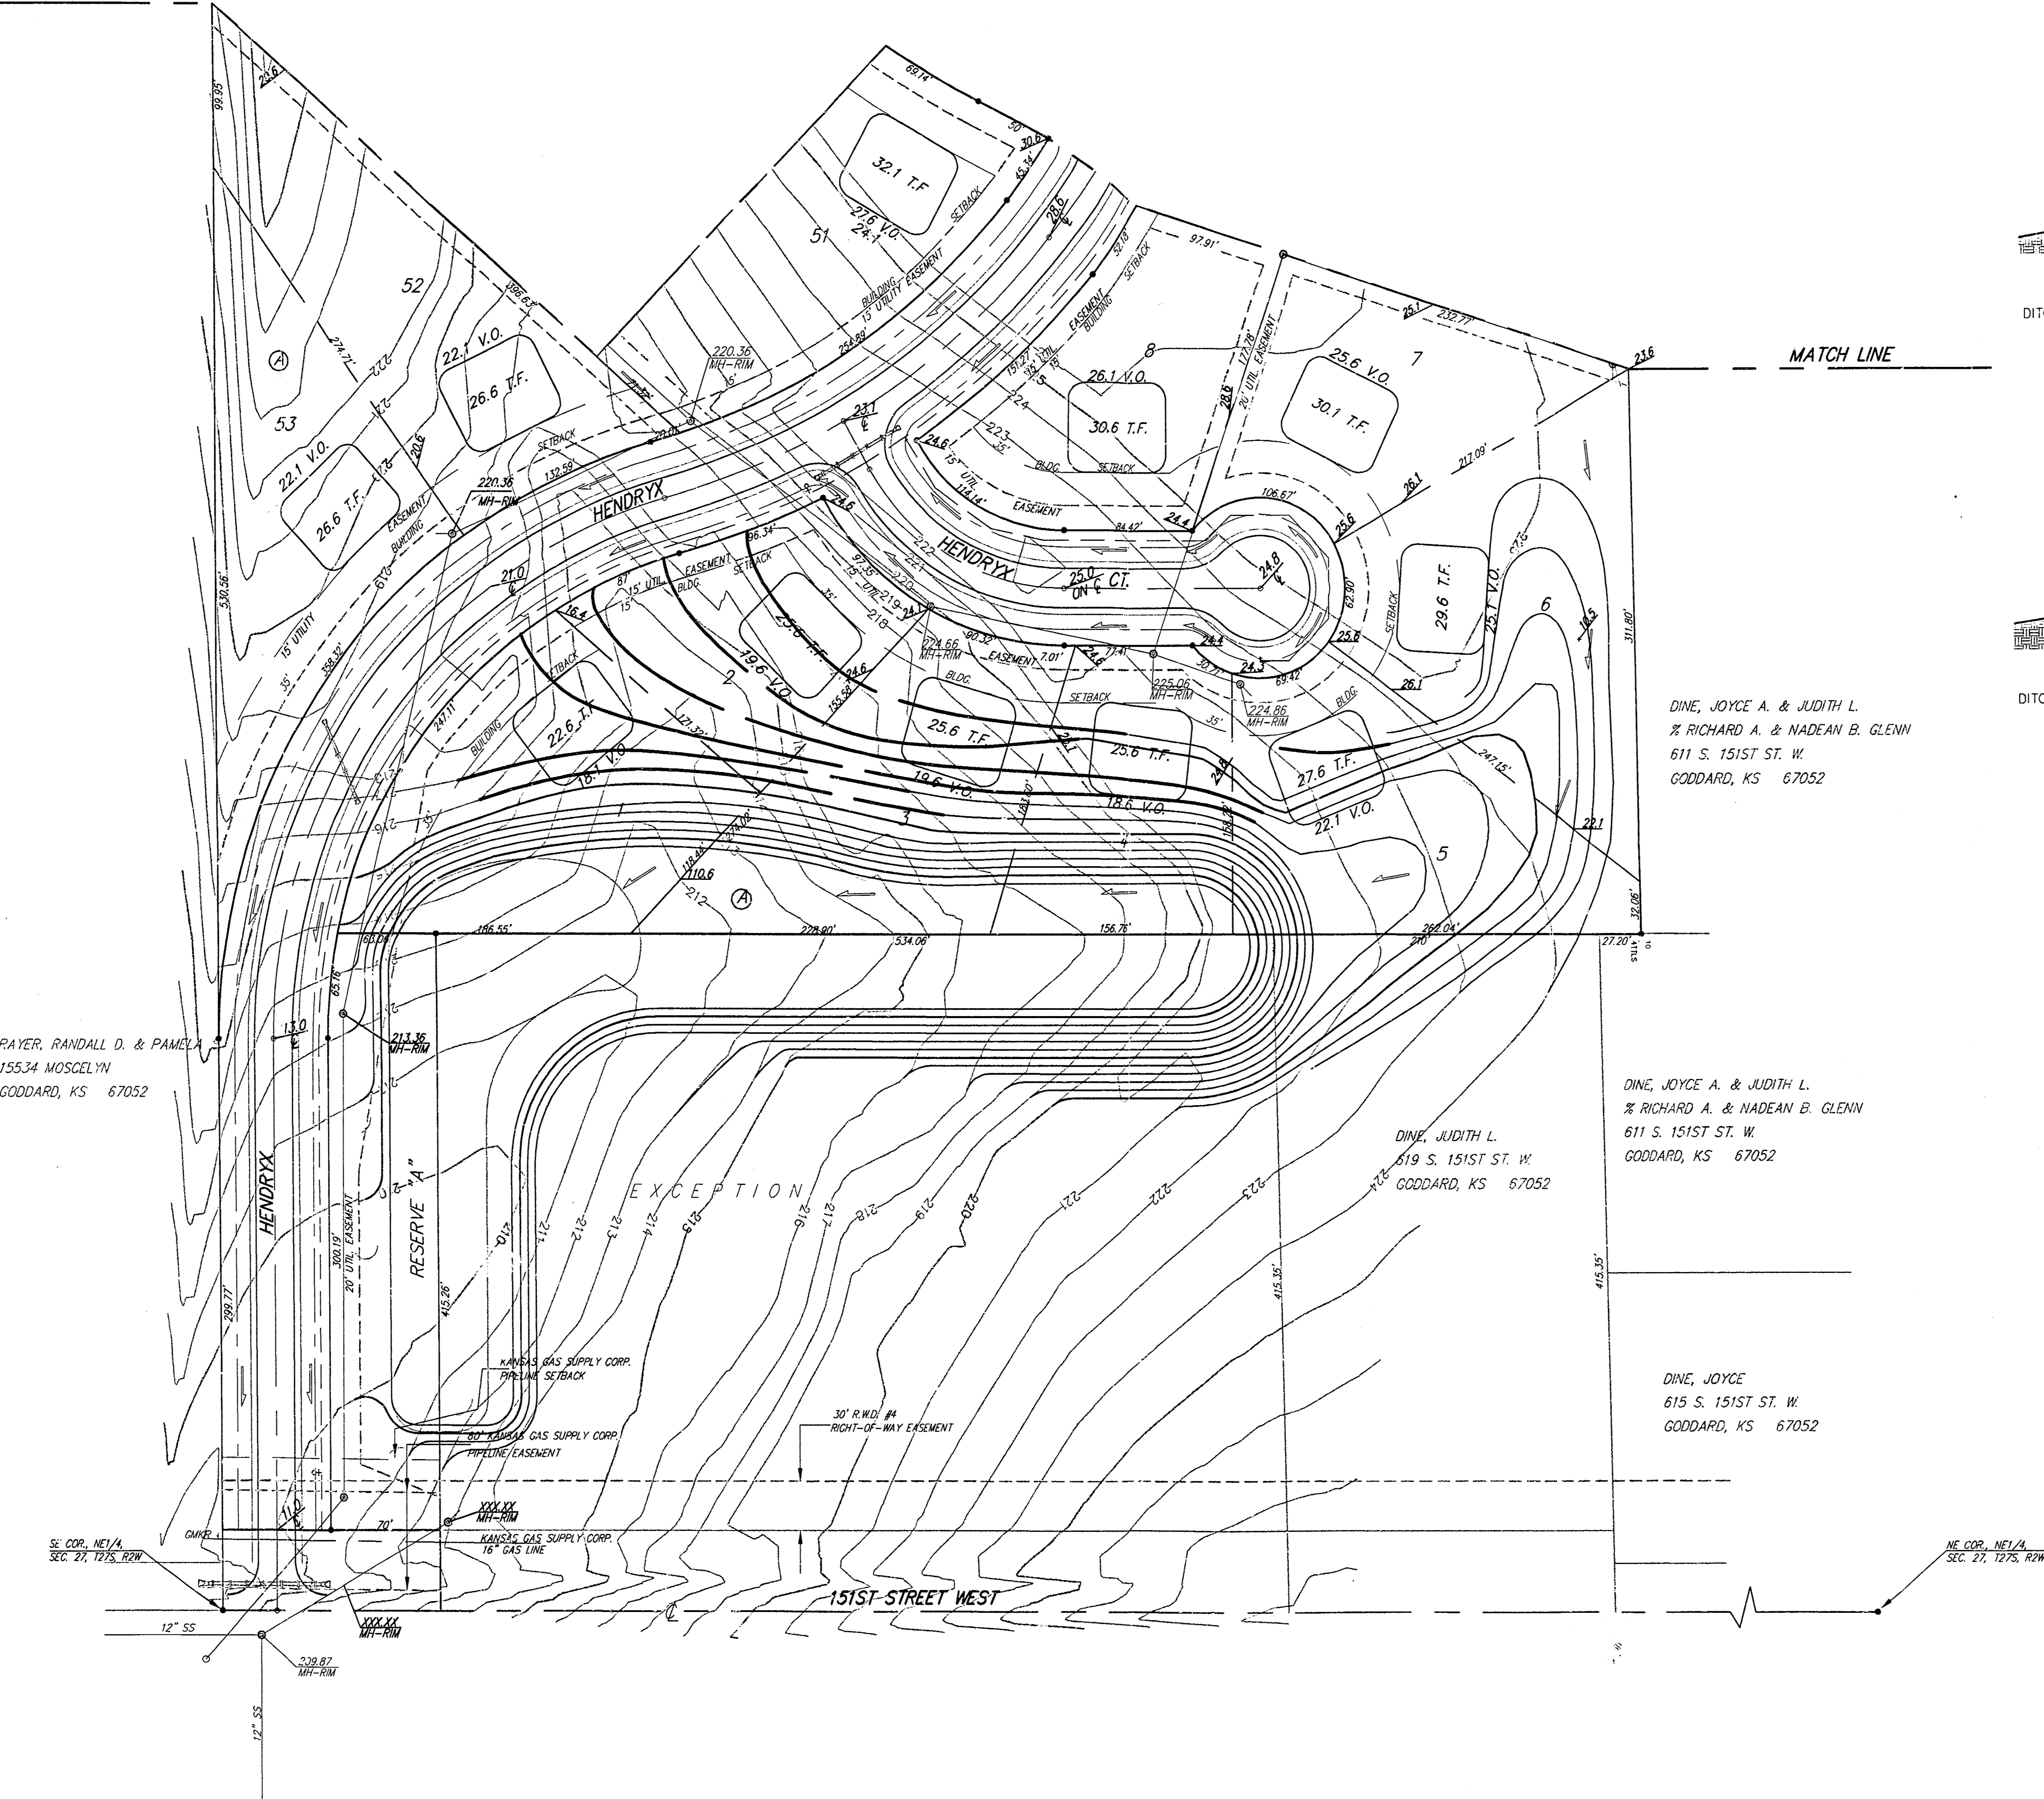

TYPICAL VIEW OUT
NO SCALE

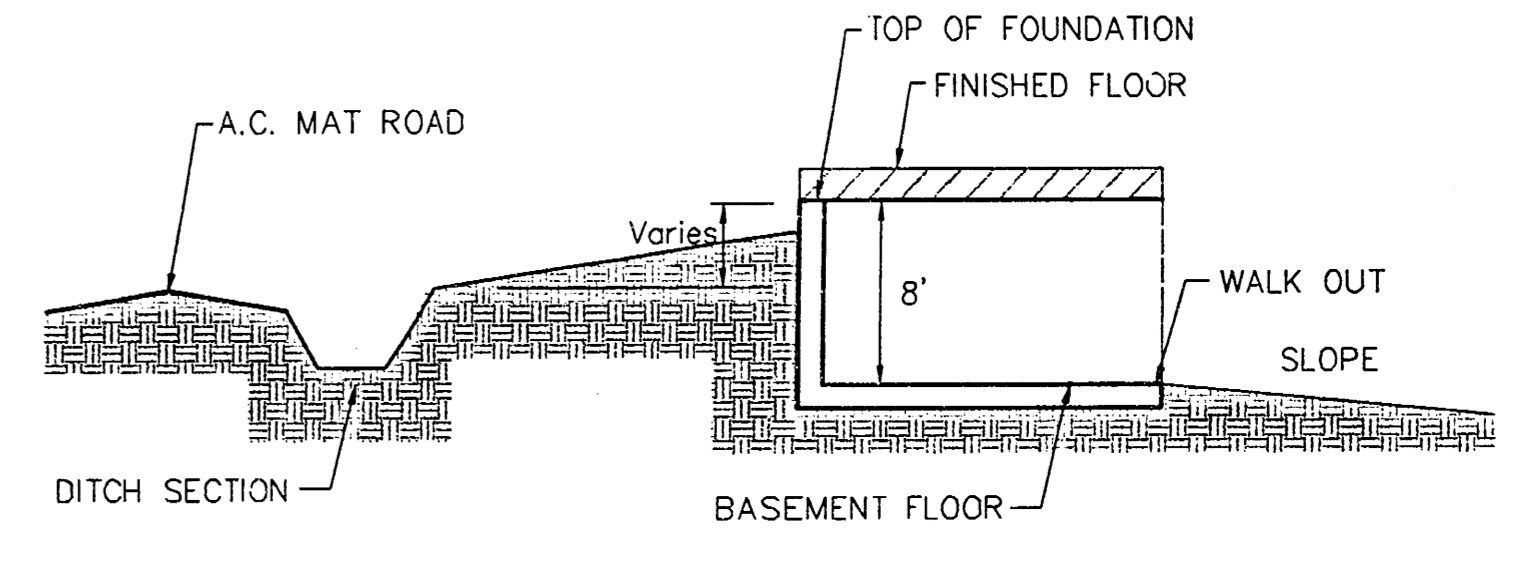

TYPICAL WALK OUT
NO SCALE

DINE, JOYCE A. & JUDITH L.
% RICHARD A. & NADEAN B. GLENN
611 S. 151ST ST. W.
GODDARD, KS 67052

DINE, JOYCE A. & JUDITH L.
% RICHARD A. & NADEAN B. GLENN
611 S. 151ST ST. W.
GODDARD, KS 67052

DINE, JOYCE
615 S. 151ST ST. W.
GODDARD, KS 67052

RAYE, RANDALL D. & PAMELA
15534 MOSCELYN
GODDARD, KS 67052

BENCHMARK:
TOP OF 1" IRON, 12" DEEP, 1/4 COR.
SEC. 27, TWP. 27-S, R-2-W
ELEV = 1206.53 M.S.L.
(2008.13 CITY DATUM)

MINIMUM BUILDING PAD ELEVATION FOR LOWEST OPENING TO THE STRUCTURES			
LOT	BLOCK	ELEVATION	
		CITY DATUM	MSL
1-22	B	228.6	1416
19-28	A	223.6	1411
1,3,4,5	A	222.6	1410

REECE FARMS ESTATES
GRADING PLAN
WICHITA, KANSAS

BAUGHMAN COMPANY P.A.
ENGINEERING, SURVEYING, & PLANNING
318-282-7271 • 315 ELLIS • WICHITA, KANSAS 67211

DESIGN	DRAWN	APPROVED	DATE	SCALE
NBW	AHH/JAB	NGW	6/15/98	1"=60'

PROJECT NUMBER: _____ SHEET **3** OF **3**