


NOTE:
Proposed top of foundation and garage floor elevations are shown on plans. Contractor to set finish floor elevation.
All street elevations shown on plans are for top of curb (full height).
View-out elevations are denoted as XX.X V.O.
Walk-out elevations are denoted as XX.X W.O.

LOT	BLOCK	BLOCK	
		CITY DATUM	M.S.L.
2-4	1	182.10	1369.50
7-9	1	182.10	1369.50
12-20	1	182.10	1369.50
22-28	1	182.10	1369.50

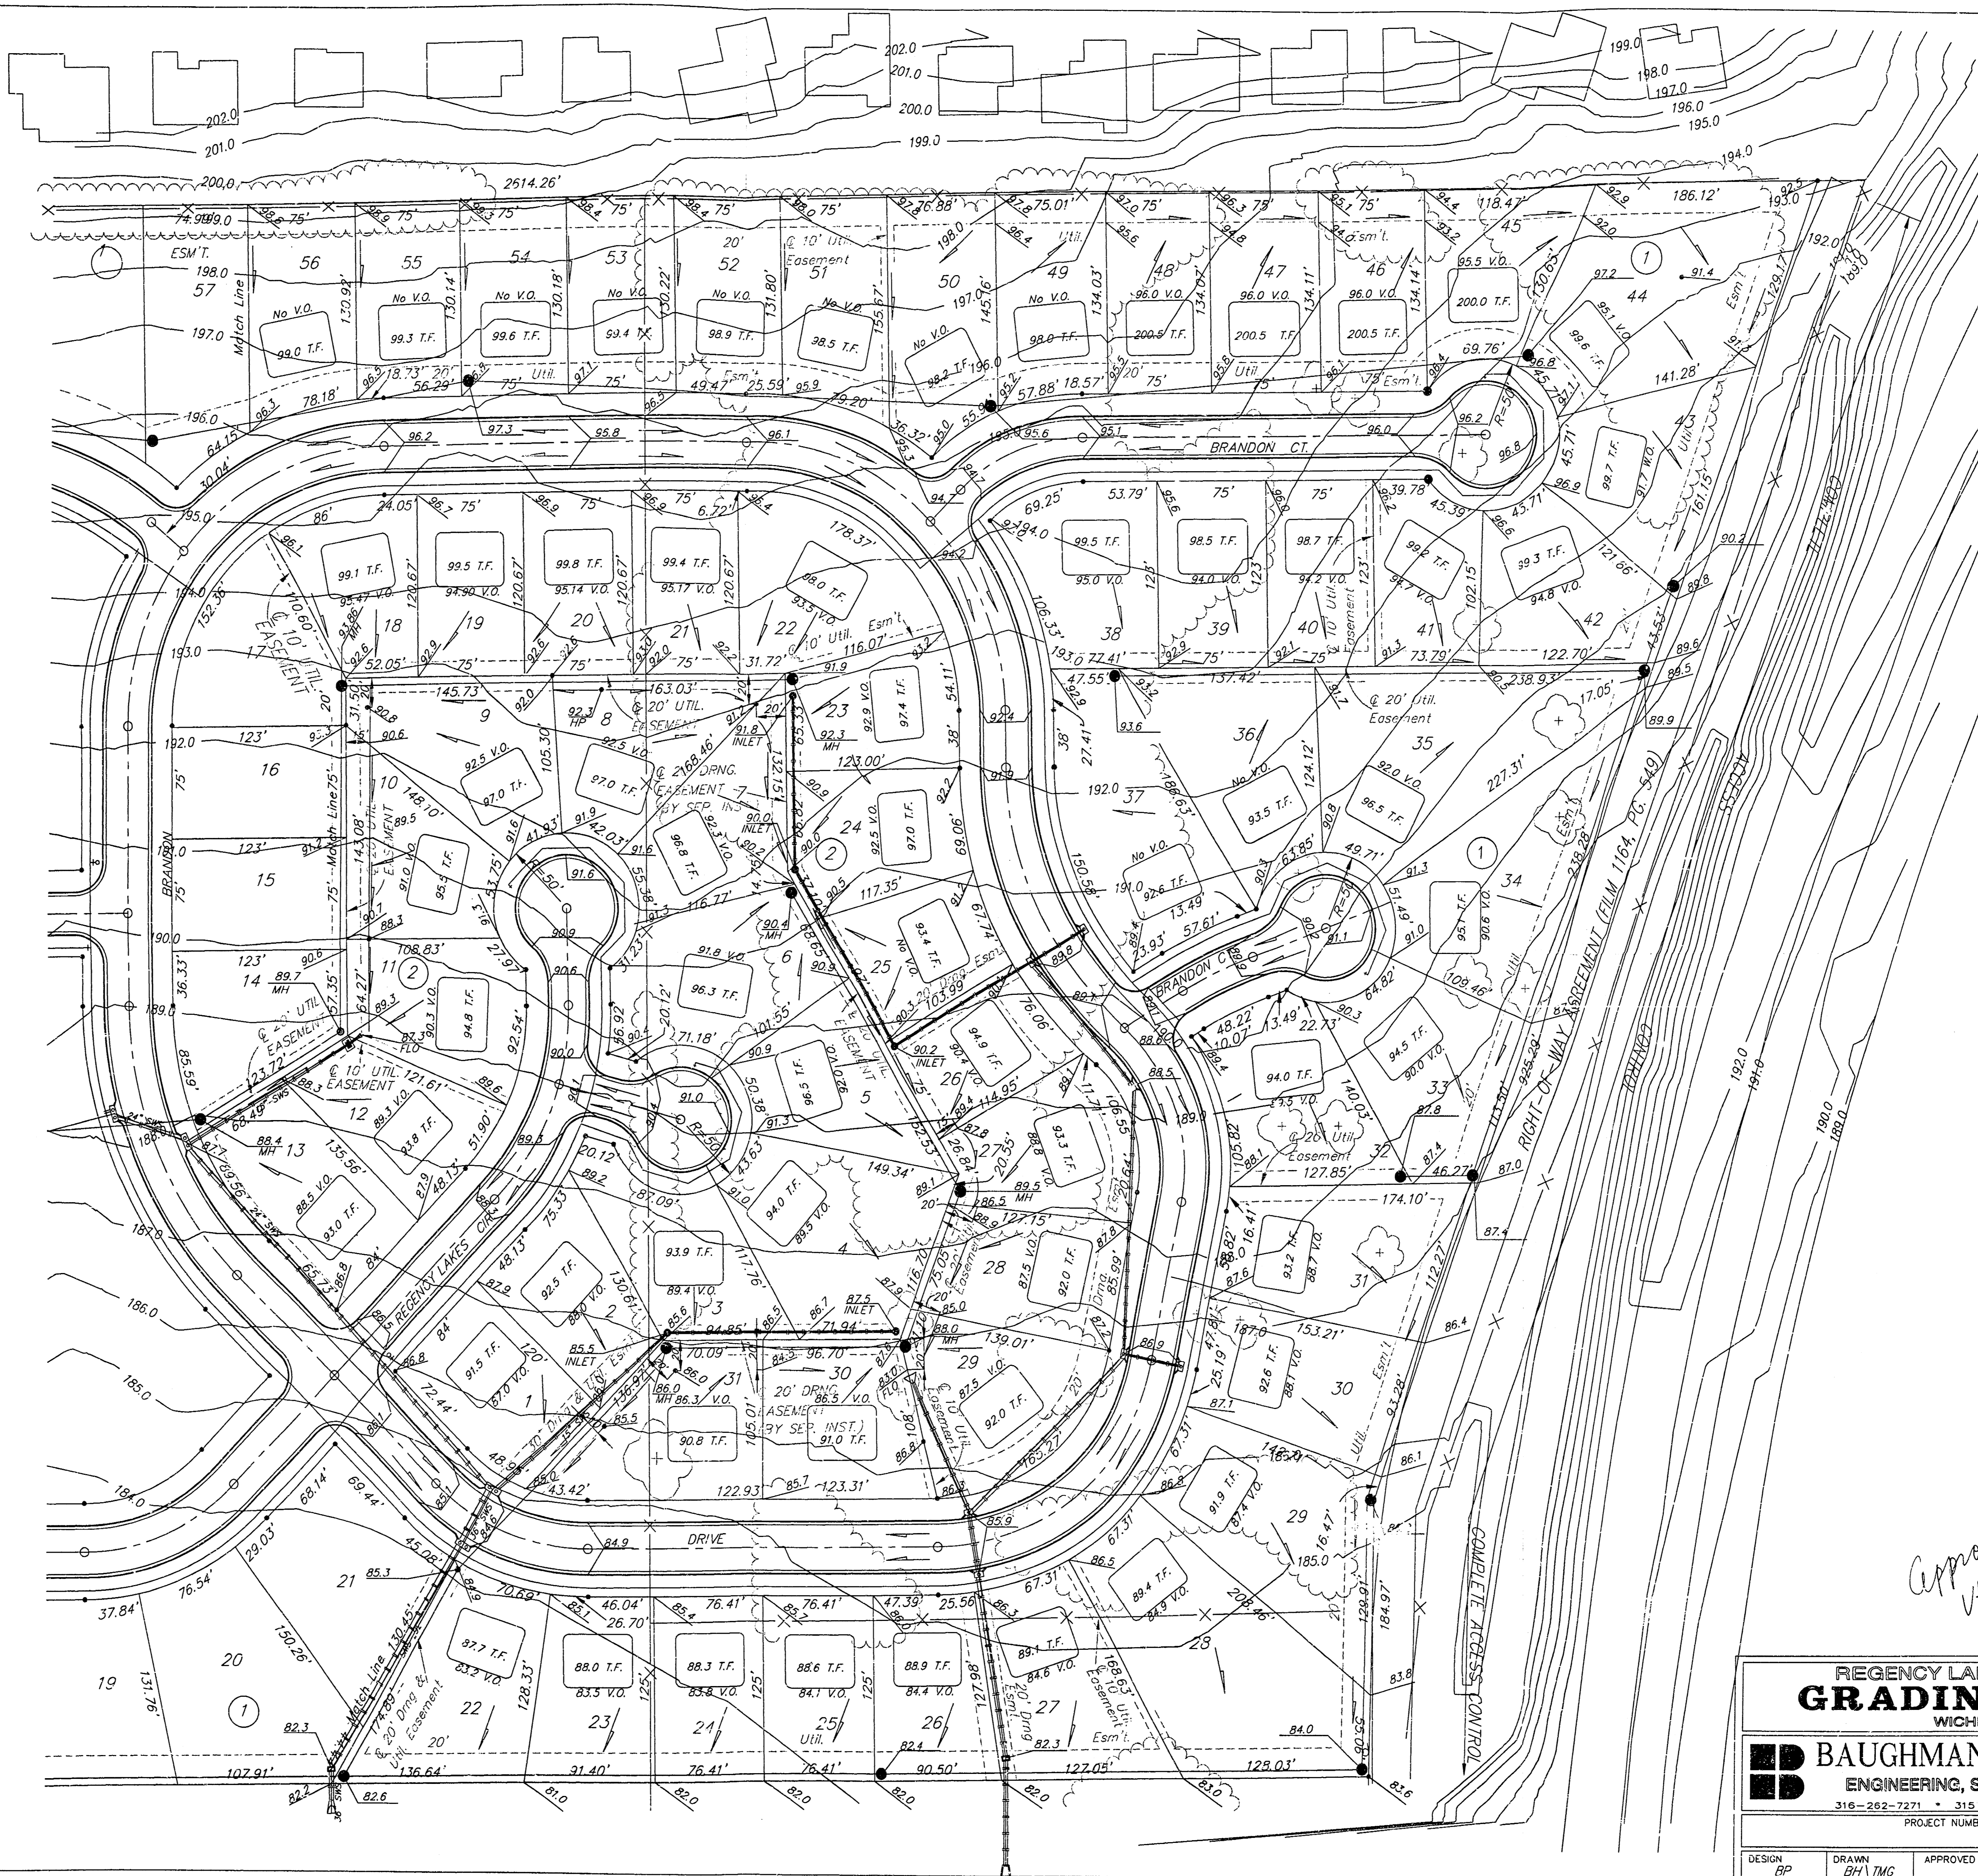

Approved
11/14/01

REGENCY LAKES ADDITION
GRADING PLAN
WICHITA, KS

BAUGHMAN COMPANY P.A.
ENGINEERING, SURVEYING, & PLANNING
316-282-7271 • 315 ELLIS • WICHITA, KANSAS 67211

PROJECT NUMBER: _____ SHEET: **2** OF **2**

DESIGN: RP DRAWN: BH/TMG APPROVED: _____ DATE: 4-21-97 SCALE: NOTED

Page 1 Not Revised
With This Pack

- Revised 11-13-01 GNX
- Revised 09-27-01 GNX
- Revised 08-29-01 GNX
- Revised 12-01-00 TMC
- Revised 04-13-00 AEC
- Revised 01-05-00 DMV