


SCALE: 1" = 60'
 • = Iron

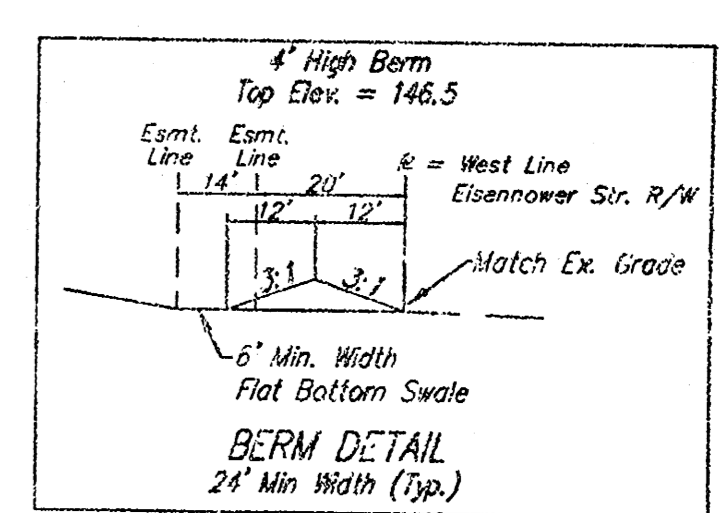

- ▲ REVISION 11/23/02 by AEG - berm and grades along east line and Replat of Lots to Ridge Port N. 5th
- ▲ REVISION 7/24/02 by AEG per NBW - top of foundations
- ▲ REVISION 4/10/02 by CNK per NBW - grades and SWS alignment
- ▲ REVISION 4/5/02 by AEG per NBW

RIDGE PORT NORTH 4TH ADDITION
GRADING PLAN
 WICHITA, KANSAS

BAUGHMAN COMPANY P.A.
 ENGINEERING, SURVEYING, & PLANNING
 310-262-7227 • 315 ELLIS • WICHITA, KANSAS 67211

PROJECT NUMBER				SHEET
DESIGN	DRAWN	APPROVED	DATE	SCALE
	RLG		3/12/2007	NOTED
				2
				2

IMPORTATION OF GRADING