


SCALE: 1" = 50'

LEGEND
 1362.0 FINISHED GRAUND ELEVATION (BOTTOM OF FINISHED FLOOR)
 1363.0 SPOT ELEV. (FINISHED)

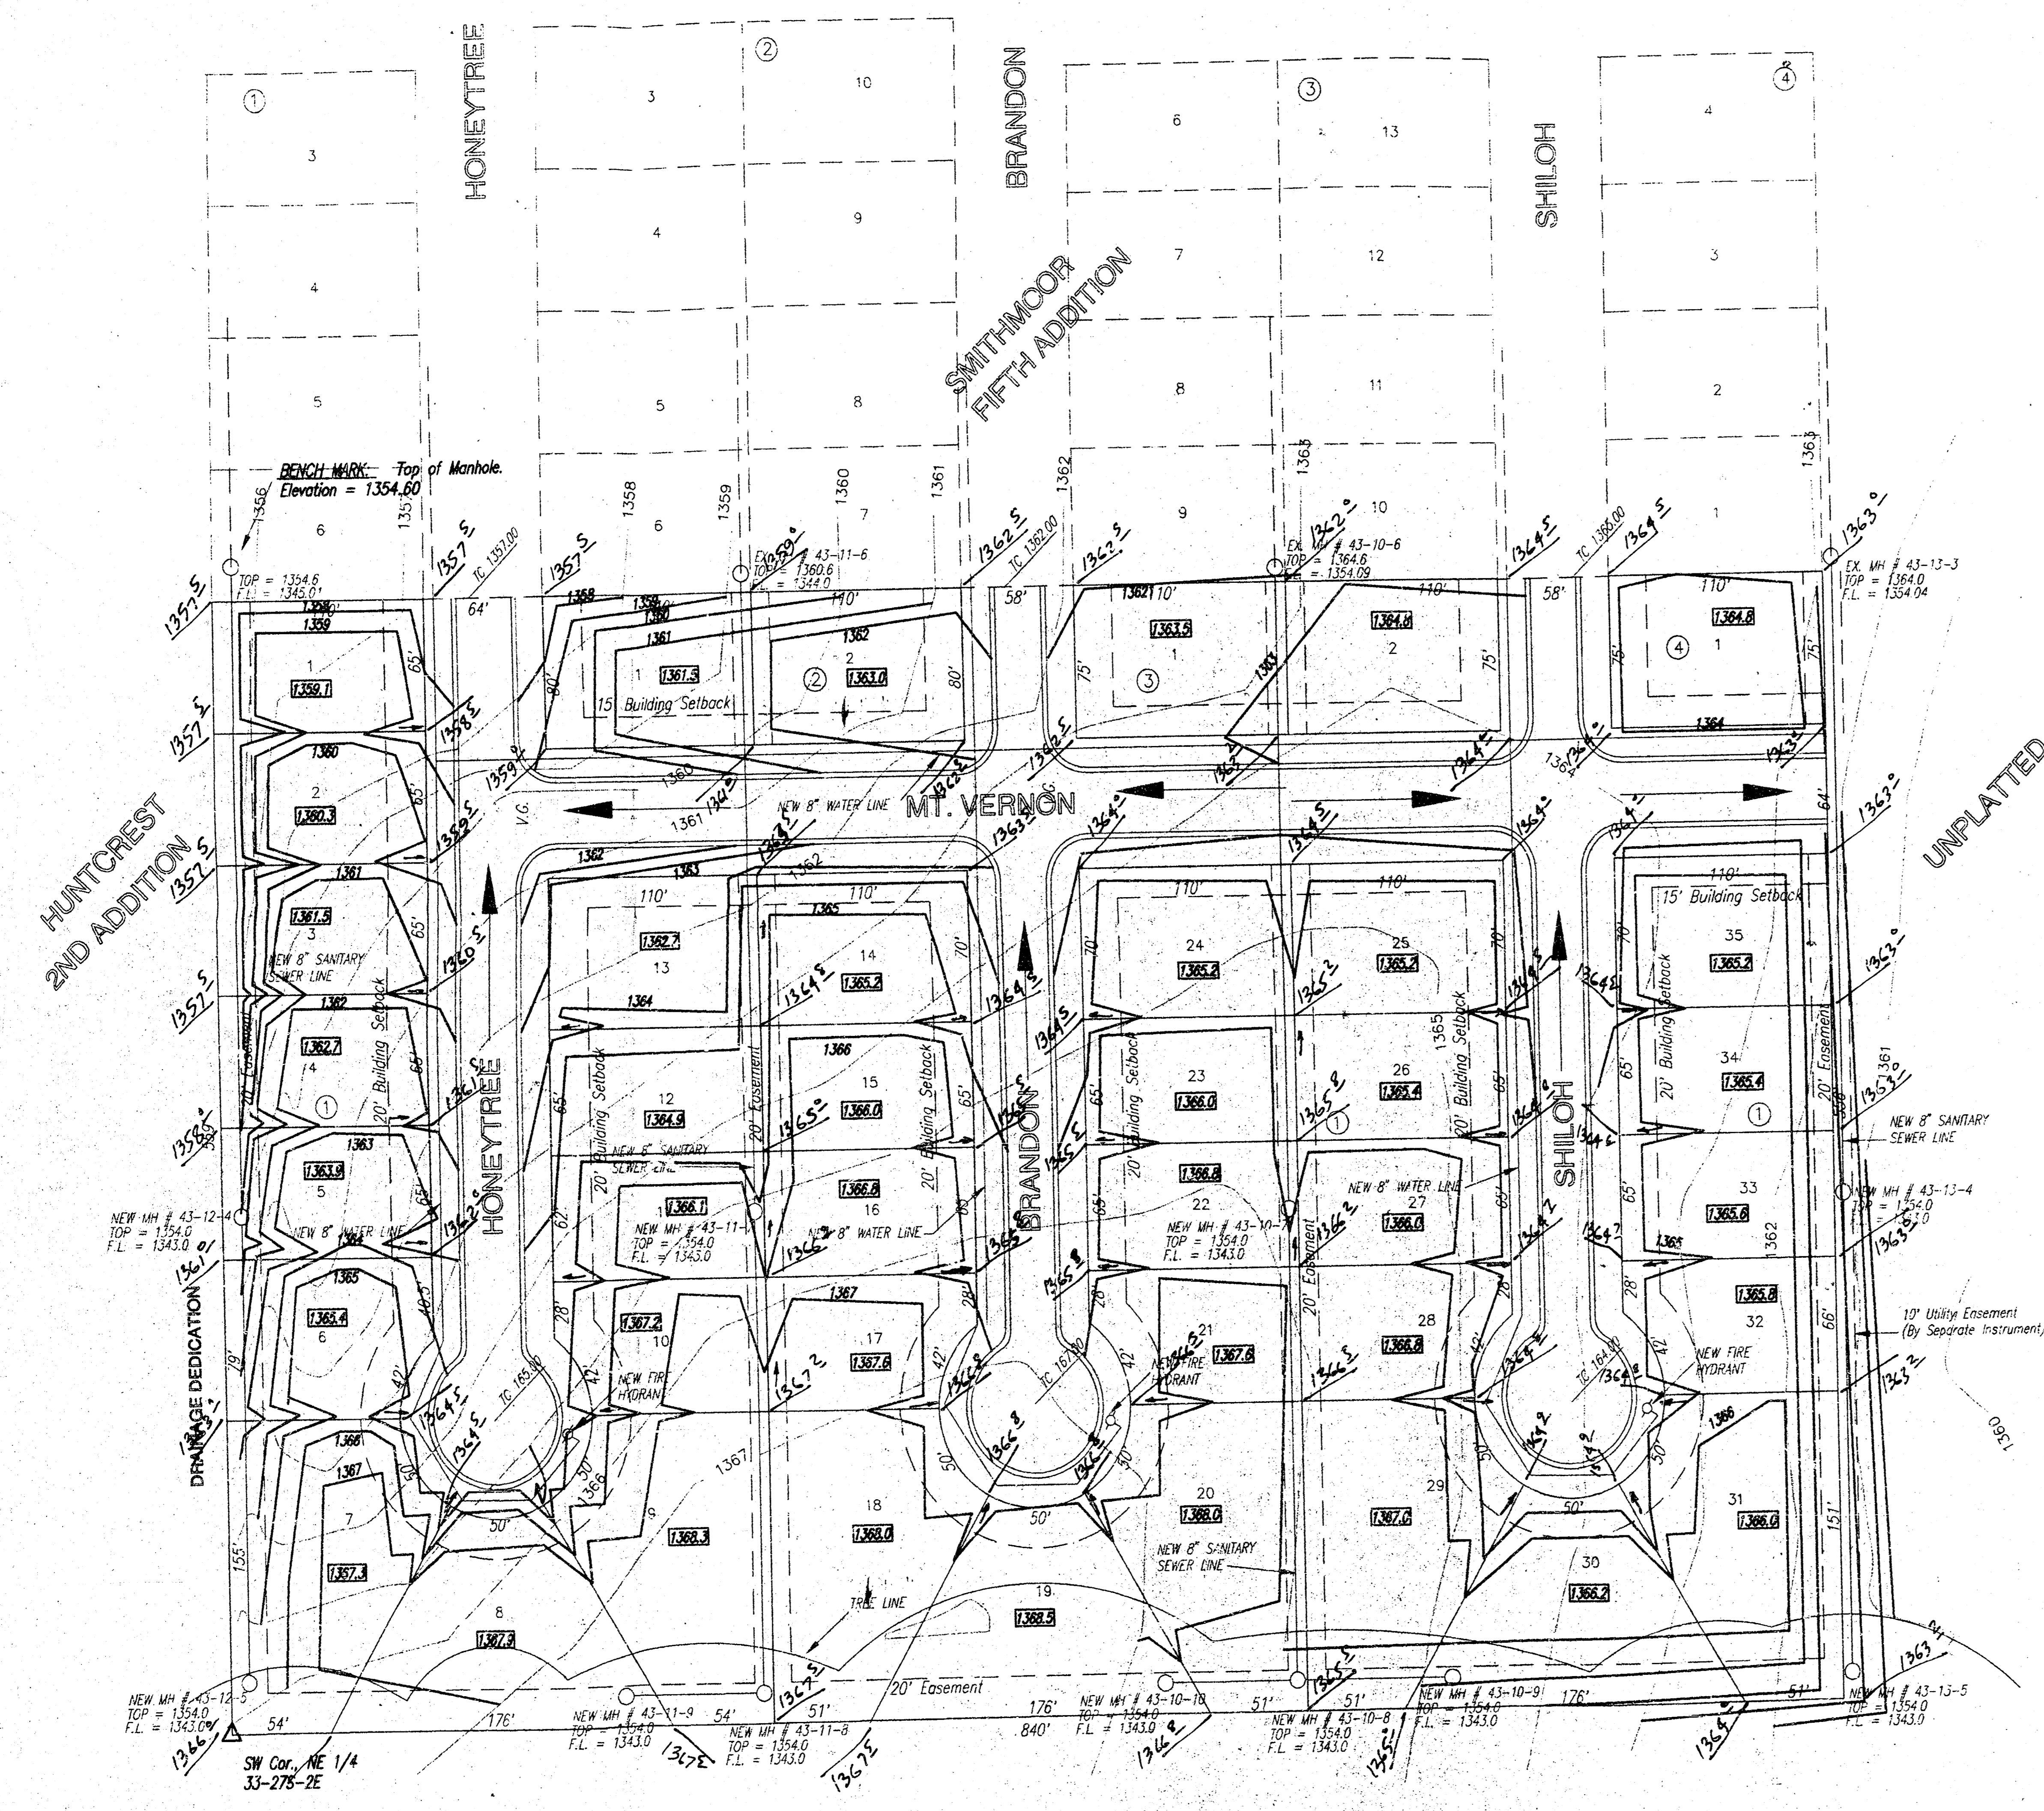

APPROVED
 VRT
 5/18/19

**LOT GRADING PLAN
 SMITHMOOR SEVENTH ADDITION
 TO
 WICHITA, SEDGWICK COUNTY, KANSAS**

ME MUNICIPAL ENGINEERS, P.A.
 254-LAURA, SUITE 201
 WICHITA, KANSAS 67211
 316-262-3842