


# FOUR CORNER LOT GRADING PLAN WHITE TAIL ADDITION TO SEDGWICK COUNTY, KANSAS

NW CORNER, NE 1/4  
SEC. 15, T27S, R2E  
OF THE 6TH P.M.  

NE CORNER, NE 1/4  
SEC. 15, T27S, R2E  
OF THE 6TH P.M.  
FOUND 1/2" I.P.

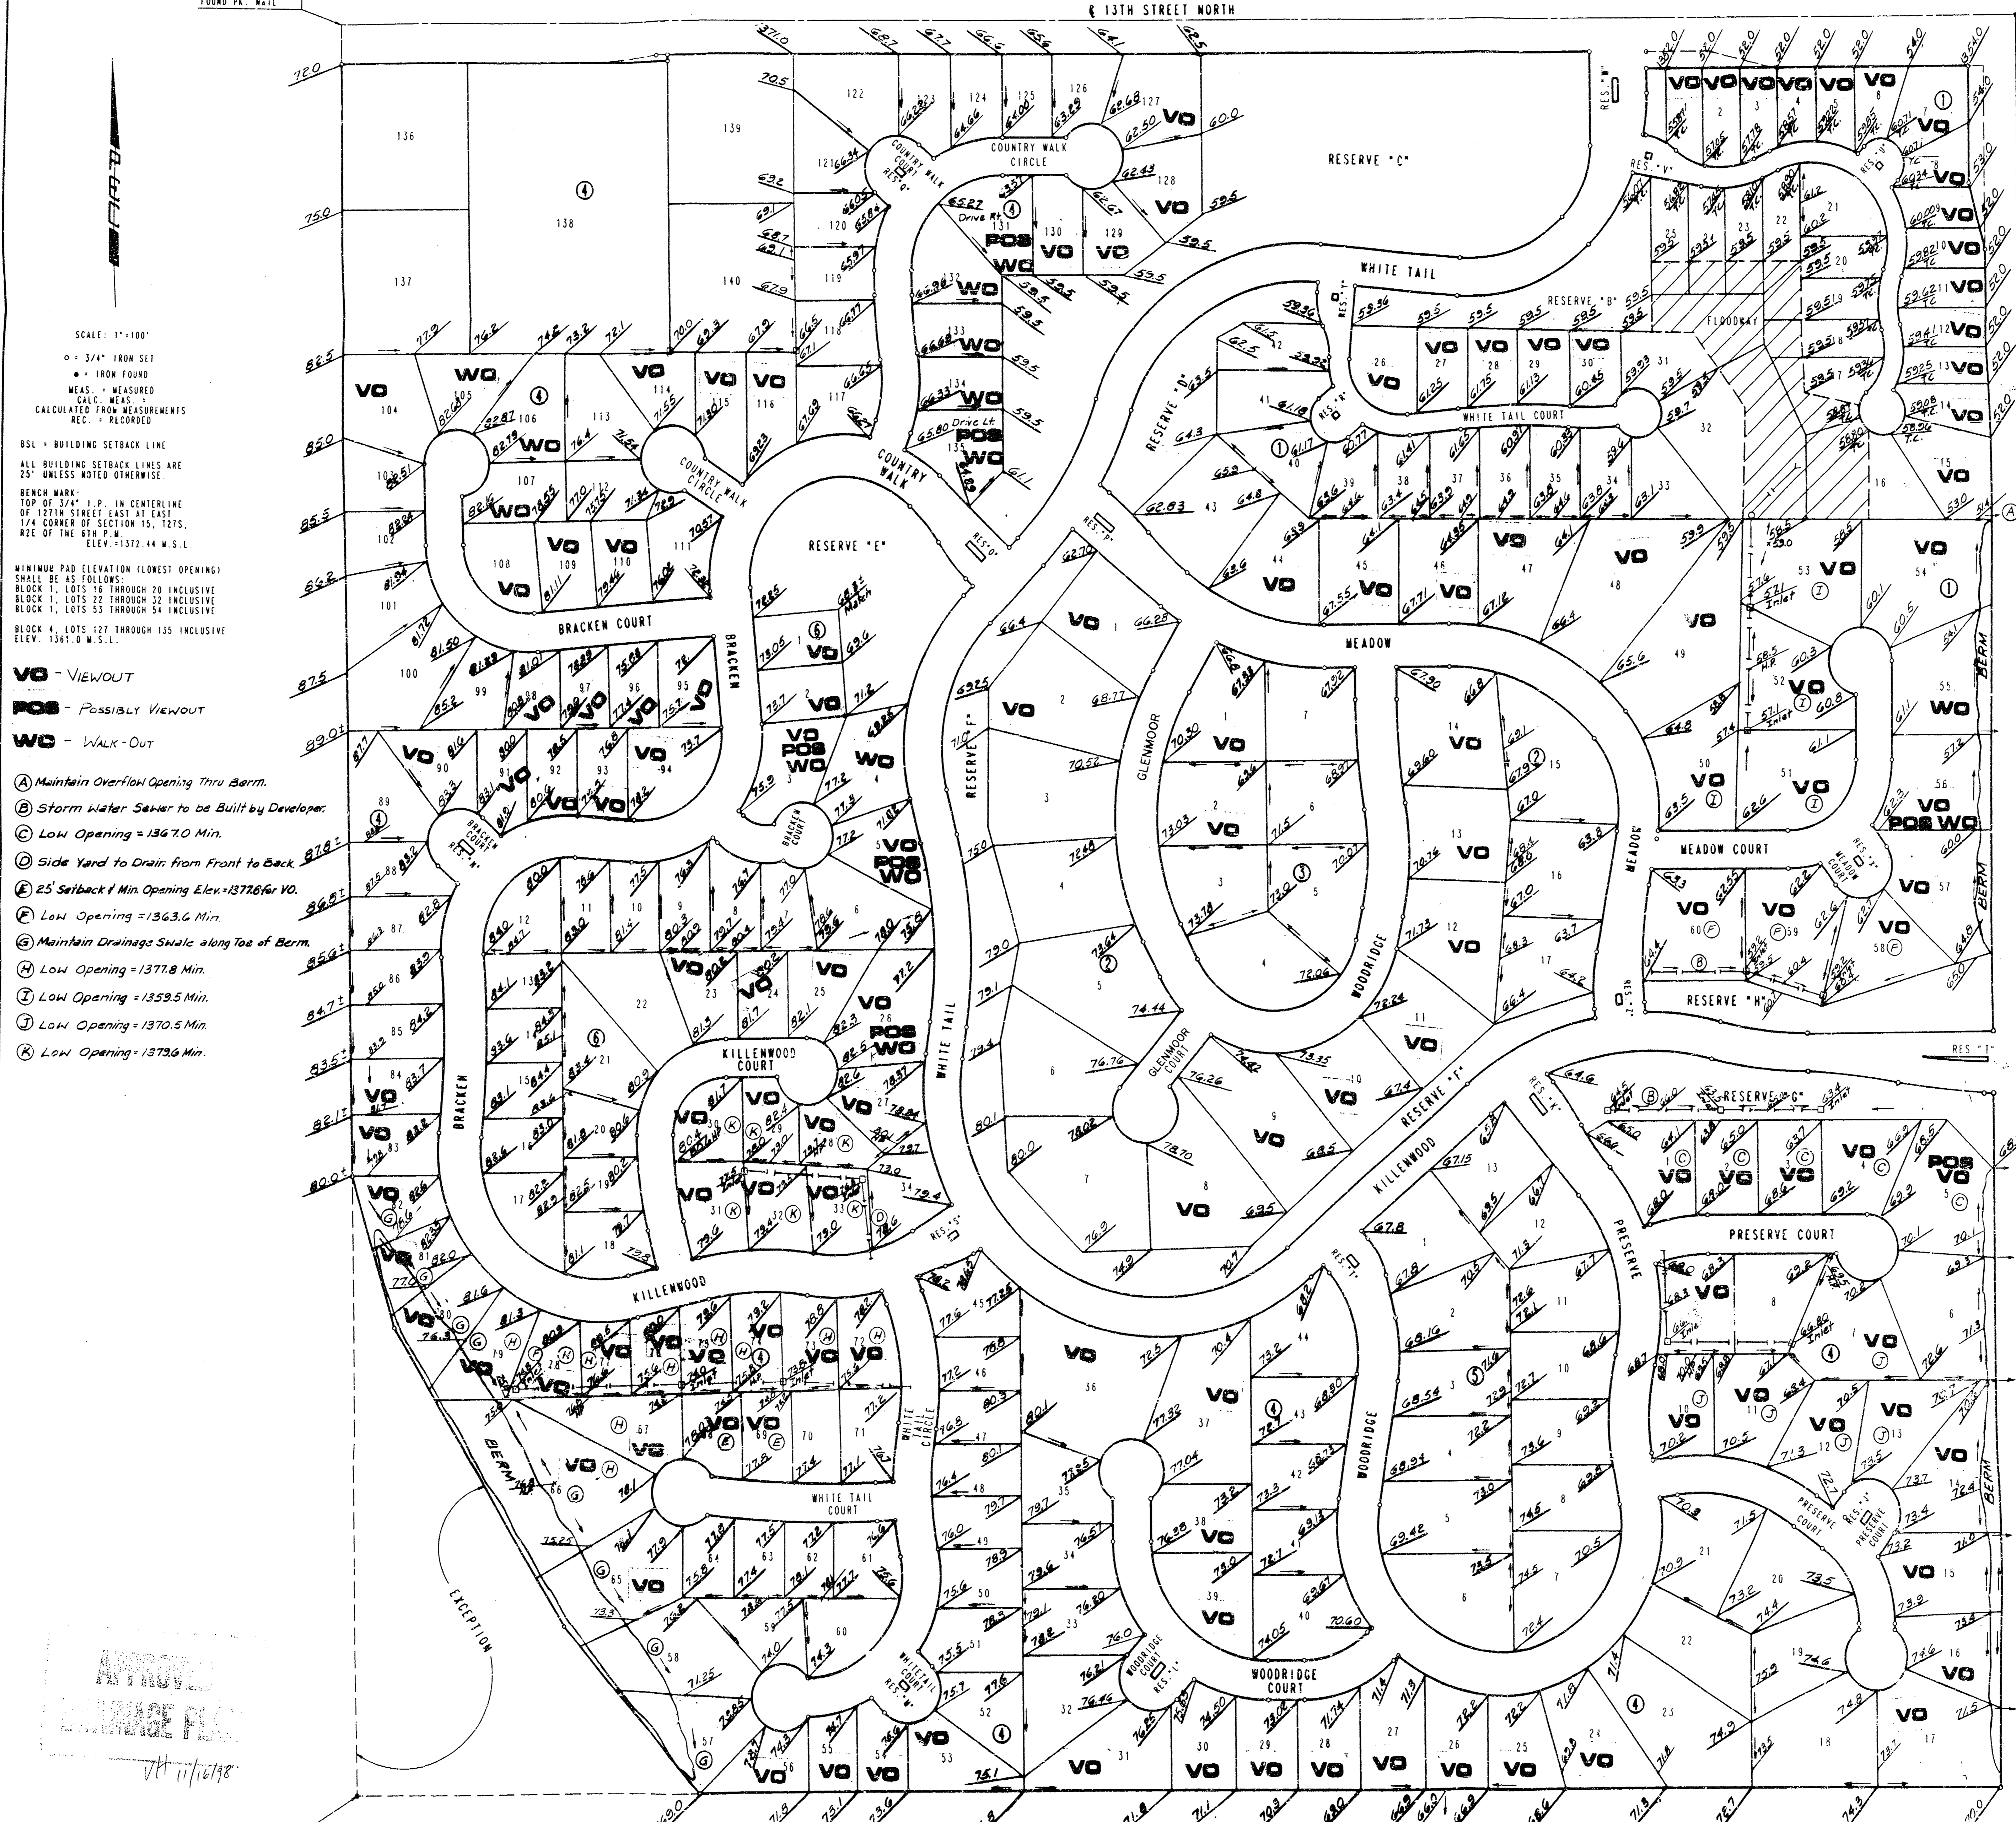

SCALE: 1"=100'  
 ○ 3/4" IRON SET  
 ● IRON FOUND  
 MEAS. - MEASURED  
 CALC. MEAS. - CALCULATED FROM MEASUREMENTS  
 REC. - RECORDED

BSL - BUILDING SETBACK LINE  
 ALL BUILDING SETBACK LINES ARE 25' UNLESS NOTED OTHERWISE

BENCH MARK:  
 TOP OF 3/4" I.P. IN CENTERLINE  
 1/4 CORNER OF SECTION 15, T27S,  
 R2E OF THE 6TH P.M.  
 ELEV. 1372.44 M.S.L.

MINIMUM PAD ELEVATION (LOWEST OPENING)  
 SHALL BE AS FOLLOWS:  
 BLOCK 1, LOTS 16 THROUGH 20 INCLUSIVE  
 BLOCK 4, LOTS 127 THROUGH 135 INCLUSIVE  
 ELEV. 1361.0 M.S.L.

- VO - VIEWOUT
  - POS - POSSIBLY VIEWOUT
  - WO - WALK-OUT
- Ⓐ Maintain Overflow Opening Thru Berm.
  - Ⓑ Storm Water Saver to be Built by Developer.
  - Ⓒ Low Opening = 1367.0 Min.
  - Ⓓ Side Yard to Drain from Front to Back
  - Ⓕ Low Opening = 1363.6 Min.
  - Ⓖ Maintain Drainage Swale along Toe of Berm.
  - Ⓗ Low Opening = 1377.8 Min.

APPROVAL  
 JH 11/16/98

WH TAIL ADDITION  
 (ORIGINALLY STARTED IN COUNTY -  
 ANNEXED LATE 1977 TO FEB 1980)

SE CORNER, NE 1/4  
 SEC. 15, T27S, R2E  
 OF THE 6TH P.M.  
 FOUND 3/4" I.P.

Rev. 2/12/94  
 Rev. 2/12/95  
 Rev. 11/15/95  
 Rev. 3/7/95  
 Rev. 4/11/94  
 11/23/93