


# FOUR CORNER LOT GRADING PLAN WHITE TAIL ADDITION TO SEDGWICK COUNTY, KANSAS

SW CORNER, BE 1/4  
SEC. 18, T27S, R2E  
OF THE 5TH P.M.  
FOUNDED 1797

NE CORNER, BE 1/4  
SEC. 18, T27S, R2E  
OF THE 5TH P.M.  
FOUNDED 1797

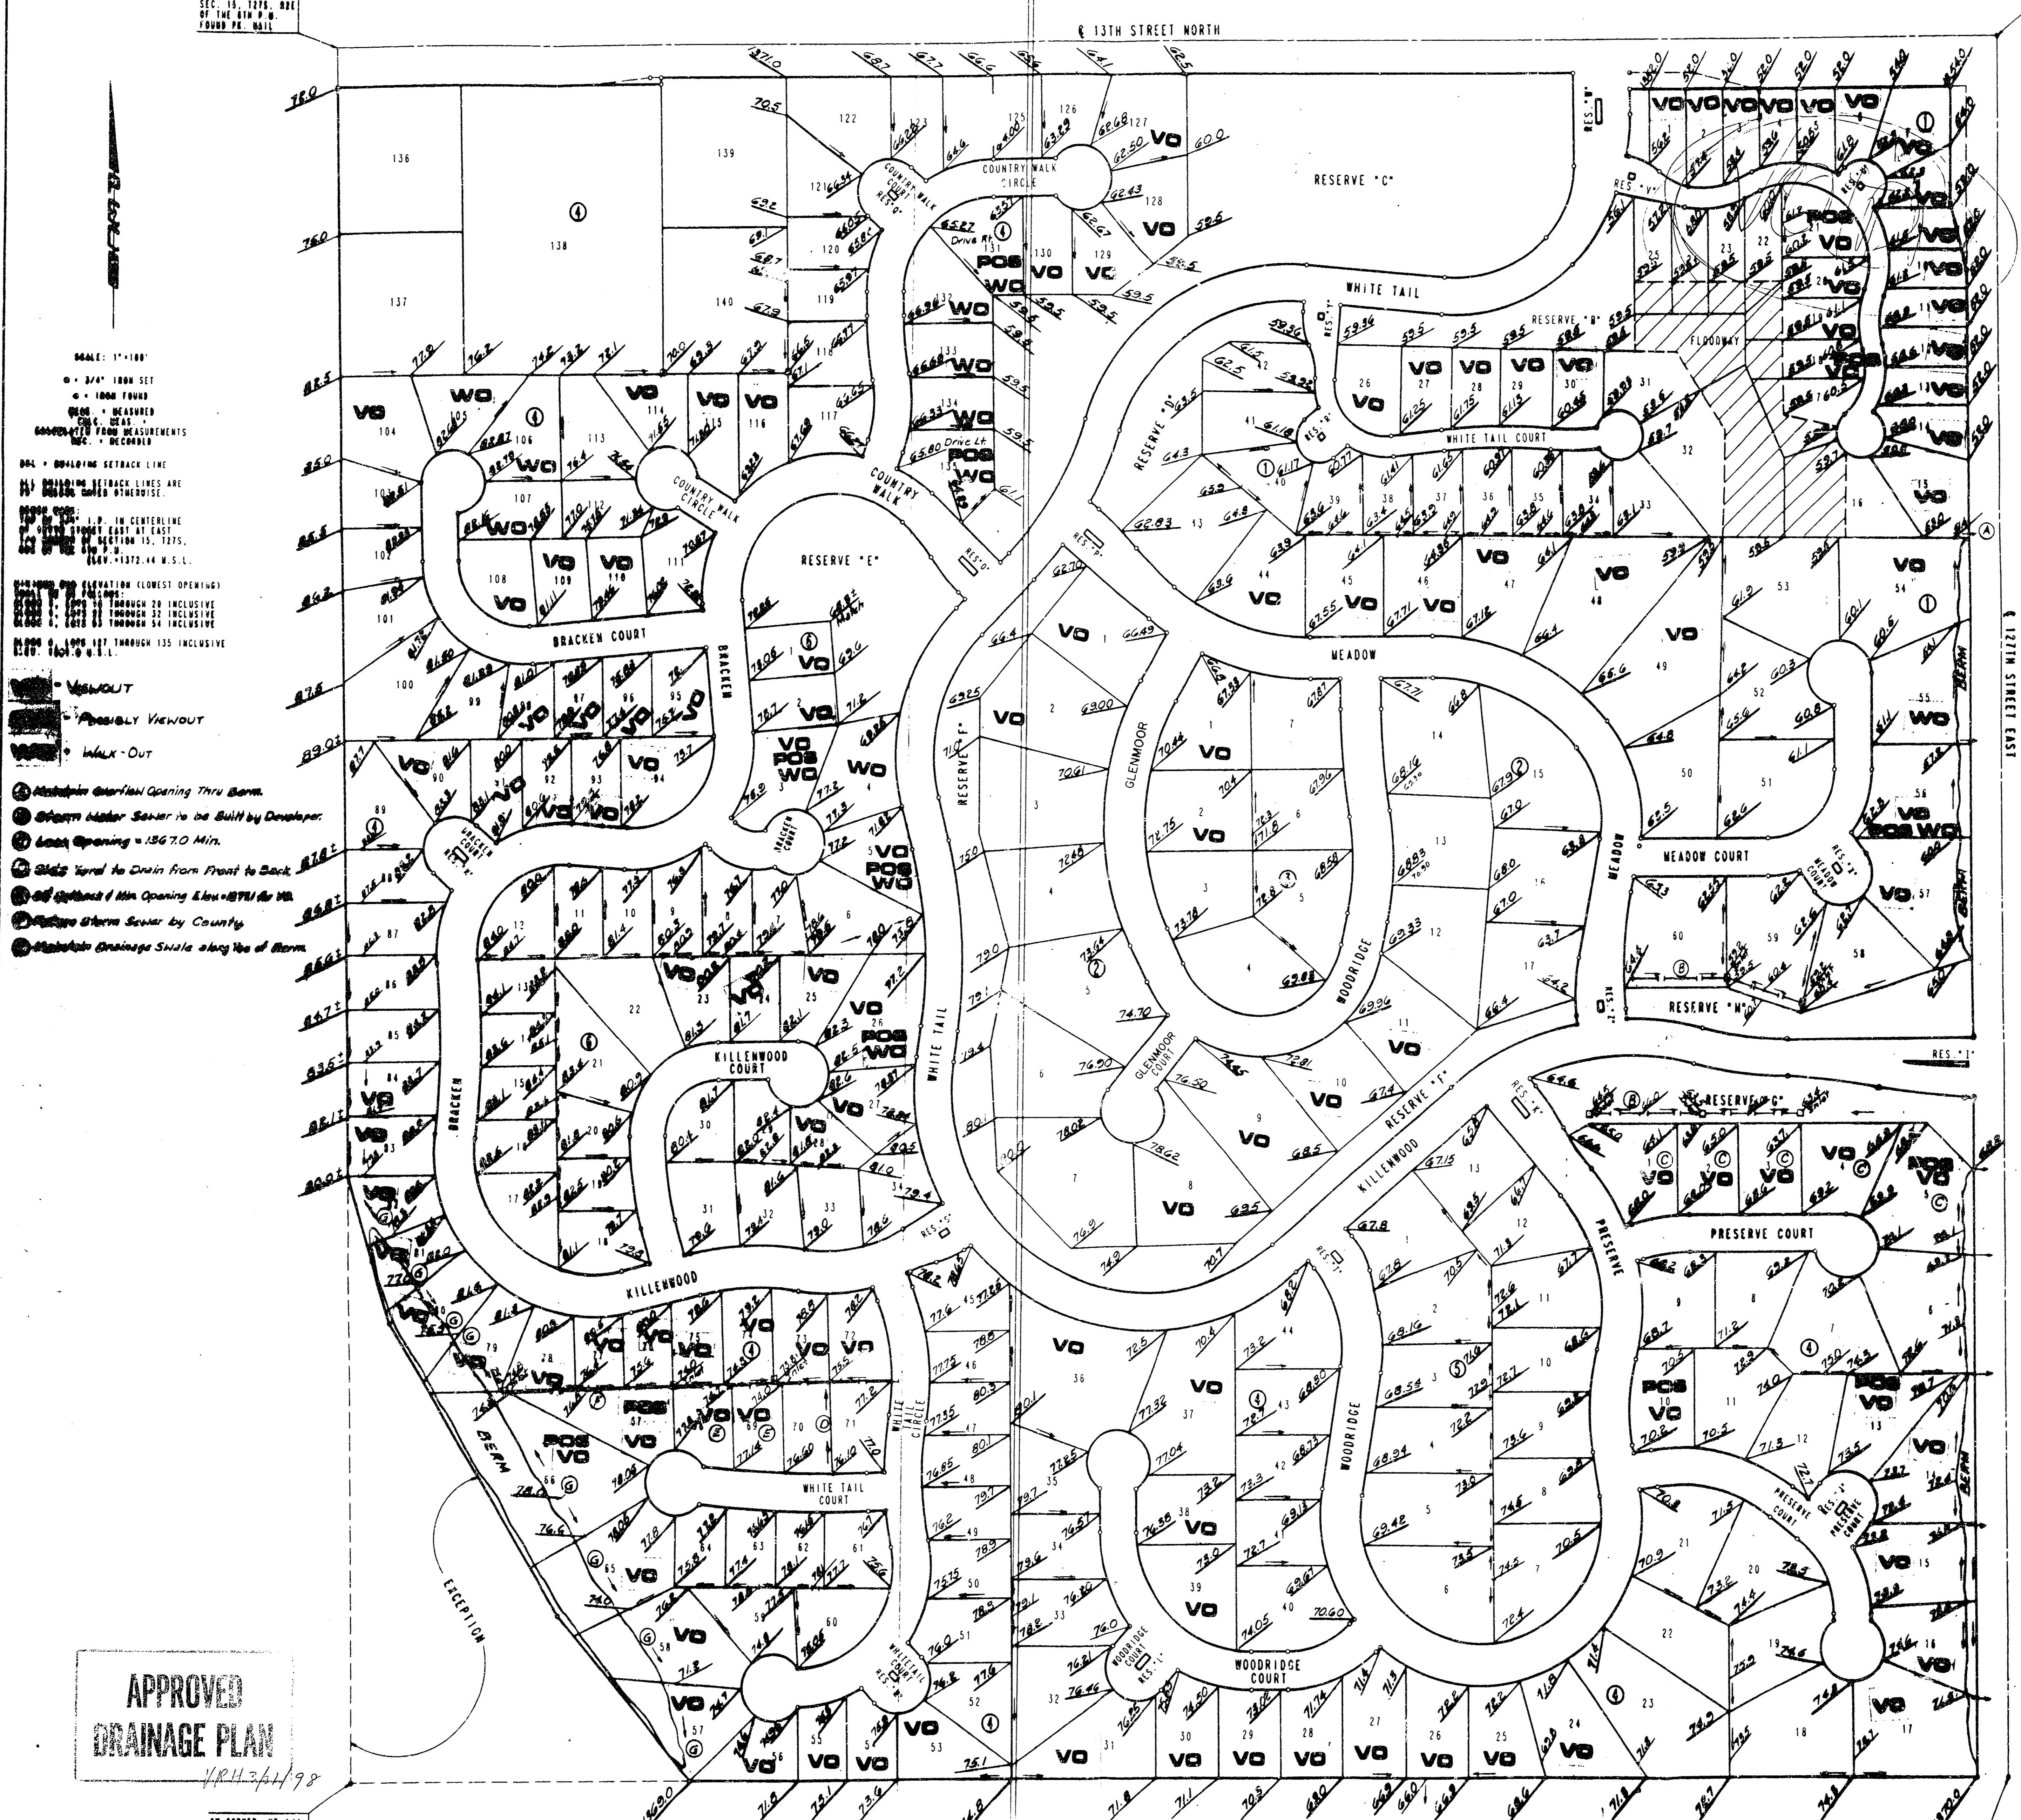

APPROVED  
DRAINAGE PLAN

WHITE TAIL ADDITION  
(ORIGINALLY STARTED IN

SW CORNER, BE 1/4  
SEC. 18, T27S, R2E  
OF THE 5TH P.M.  
FOUNDED 1797