

**AFFIDAVIT**

State of Kansas) SS James L. Armour, P.E., Acting City Engineer  
 Sedgwick County) for the City of Wichita, Kansas, being first duly sworn, on oath, states:  
 I have examined the final plat of "FOSSIL RIM ESTATES", Wichita, Sedgwick County, Kansas, and have found that certain errors do exist regarding the elevations and affected Lots as indicated in the "MINIMUM BUILDING PAD TABLE" block for Lots 9 through 11, Block D, as shown on the face of the above referenced plat and that corrections of said elevations and affected Lots are necessary. The Minimum Building Pad Elevation for the lowest opening to the structures on Lots 9 and 10, Block D, shall remain at 179.0 City Datum, as shown. The Minimum Building Pad Elevation for the lowest opening to the structures on Lot 11, Block D, shall be 176.5 City Datum, rather than 179.0 City Datum, as shown.


FURTHER AFFIANT SAITH NOT

*James L. Armour*  
 James L. Armour, P.E.

Dated this 4<sup>th</sup> day of May, 2004.

State of Kansas) SS The foregoing instrument acknowledged before me, this 4<sup>th</sup> day of May, 2004, by James L. Armour, P.E., Acting City Engineer for the City of Wichita, Kansas.

*J. Long*, Notary Public  
 My App't. Expires July 16, 2007

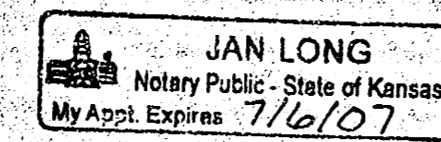

DOC. # / FLM-PG: 25506641


**CERTIFICATE OF CORRECTION TO MINIMUM BUILDING PAD ELEVATIONS AND AFFECTED LOTS**  
 FOSSIL RIM ESTATES  
 WICHITA, SEDGWICK COUNTY, KANSAS

State of Kansas) SS We, Baughman Company, P.A., Surveyors in aforesaid county and state do hereby certify that certain errors do exist regarding the elevations and affected Lots as indicated in the "MINIMUM BUILDING PAD TABLE" block for Lots 9 through 11, Block D, as shown on the face of the above referenced plat and that corrections of said elevations and affected Lots are necessary. The Minimum Building Pad Elevation for the lowest opening to the structures on Lots 9 and 10, Block D, shall remain at 179.0 City Datum, as shown. The Minimum Building Pad Elevation for the lowest opening to the structures on Lot 11, Block D, shall be 176.5 City Datum, rather than 179.0 City Datum, as shown.

The accompanying drawing is a true and correct exhibit of the corrections as noted.

Baughman Company, P.A.

*Michael G. Conroy*  
 Michael G. Conroy, Surveyor

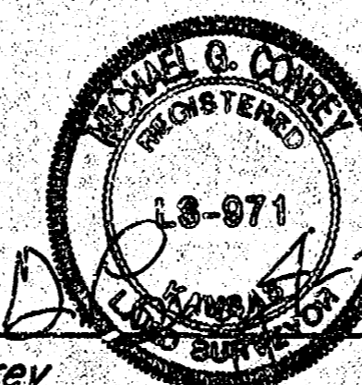

C.C.  
 9.62

Baughman Company, PA  
 315 Elli  
 Wichita, KS 67219

DOC. # / FLM-PG: 25506641

MINIMUM BUILDING PAD ELEVATIONS FOR LOWEST OPENING TO THE STRUCTURES		
LOT	BLOCK	ELEVATION
1	A	159.0
2-6	A	157.0
1-8	B	176.5
3-5	C	179.5
6	C	178.0
7,8	C	178.5
14,15	C	180.5
16,22,23	C	182.0
1-4	D	166.4
5	D	168.0
6	D	172.0
7	D	174.5
8	D	176.5
9-11	D	179.0

**INCORRECT ELEVATION AND AFFECTED LOTS**

MINIMUM BUILDING PAD ELEVATIONS FOR LOWEST OPENING TO THE STRUCTURES		
LOT	BLOCK	ELEVATION
1	A	159.0
2-6	A	157.0
1-8	B	176.5
3-5	C	179.5
6	C	178.0
7,8	C	178.5
14,15	C	180.5
16,22,23	C	182.0
1-4	D	166.4
5	D	168.0
6	D	172.0
7	D	174.5
8	D	176.5
9-10	D	179.0
11	D	176.5

**CORRECTED ELEVATION AND AFFECTED LOTS**