

September 16, 2004

Parcel "A"

All of Lot 1, Block A, Harvest Ridge Addition, Wichita, Sedgwick County, Kansas, together with the east 4.00 feet of Lot 2 in said Block A

Parcel "B"

Lot 2, Block A, Harvest Ridge Addition, Wichita, Sedgwick County, Kansas, except the east 4.00 feet thereof, together with the east 2.00 feet of Lot 3 in said Block A.

Parcel "C"

Lot 3, Block A, Harvest Ridge Addition, Wichita, Sedgwick County, Kansas, except the east 2.00 feet thereof.

Parcel "D"

All of Lot 16, Block A, Harvest Ridge Addition, Wichita, Sedgwick County, Kansas, together with the south 4.00 feet of Lot 17 in said Block A.

Parcel "E"

Lot 17, Block A, Harvest Ridge Addition, Wichita, Sedgwick County, Kansas, except the south 4.00 feet thereof.

Parcel "F"

Lot 21, Block A, Harvest Ridge Addition, Wichita, Sedgwick County, Kansas, except the south 2.00 feet thereof.

Parcel "G"

All of Lot 22, Block A, Harvest Ridge Addition, Wichita, Sedgwick County, Kansas, together with the south 2.00 feet of Lot 21 in said Block A.

Parcel "H"

All of Lot 23, Block A, Harvest Ridge Addition, Wichita, Sedgwick County, Kansas, together with the south 2.00 feet of Lot 24 in said Block A.

Parcel "I"

Lot 24, Block A, Harvest Ridge Addition, Wichita, Sedgwick County, Kansas, except the south 2.00 feet thereof.

Parcel "J"

All of Lot 35, Block A, Harvest Ridge Addition, Wichita, Sedgwick County, Kansas, together with the south 10.00 feet of Lot 36 in said Block A.

Parcel "K"

Lot 35, Block A, Harvest Ridge Addition, Wichita, Sedgwick County, Kansas, except the south 10.00 feet thereof, and except the north 4.00 feet thereof.

Parcel "L"

All of Lot 37, Block A, Harvest Ridge Addition, Wichita, Sedgwick County, Kansas, together with the north 4.00 feet of Lot 36 in said Block A, and together with the south 6.00 feet of Lot 38 in said Block A.

Parcel "M"

Lot 38, Block A, Harvest Ridge Addition, Wichita, Sedgwick County, Kansas, except the south 6.00 feet thereof, and together with the south 2.00 feet of Lot 39 in said Block A.

Parcel "N"

Lot 39, Block A, Harvest Ridge Addition, Wichita, Sedgwick County, Kansas, except the south 2.00 feet thereof.

Parcel "O"

Lot 43, Block A, Harvest Ridge Addition, Wichita, Sedgwick County, Kansas, except the south 2.00 feet thereof.

Parcel "P"

Lot 44, Block A, Harvest Ridge Addition, Wichita, Sedgwick County, Kansas, except the south 6.00 feet thereof, and together with the south 2.00 feet of Lot 43 in said Block A.

Parcel "Q"

All of Lot 45, Block A, Harvest Ridge Addition, Wichita, Sedgwick County, Kansas, together with the south 6.00 feet of Lot 44 in said Block A, and together with the north 4.00 feet of Lot 46 in said Block A.

Parcel "R"

Lot 46, Block A, Harvest Ridge Addition, Wichita, Sedgwick County, Kansas, except the north 4.00 feet thereof.

Parcel "S"

Lot 51, Block A, Harvest Ridge Addition, Wichita, Sedgwick County, Kansas, except the north 4.00 feet thereof.

Parcel "T"

All of Lot 52, Block A, Harvest Ridge Addition, Wichita, Sedgwick County, Kansas, together with the north 4.00 feet of Lot 51 in said Block A, and together with the south 6.00 feet of Lot 53 in said Block A.

Parcel "U"

Lot 53, Block A, Harvest Ridge Addition, Wichita, Sedgwick County, Kansas, except the south 6.00 feet thereof, and together with the south 2.00 feet of Lot 54 in said Block A.

Parcel "V"

Lot 54, Block A, Harvest Ridge Addition, Wichita, Sedgwick County, Kansas, except the south 2.00 feet thereof.

Parcel "W"

Lot 58, Block A, Harvest Ridge Addition, Wichita, Sedgwick County, Kansas, except the south 2.00 feet thereof.

Parcel "X"

Lot 59, Block A, Harvest Ridge Addition, Wichita, Sedgwick County, Kansas, except the south 6.00 feet thereof, together with the south 2.00 feet of Lot 58 in said Block A.

Parcel "Y"

All of Lot 60, Block A, Harvest Ridge Addition, Wichita, Sedgwick County, Kansas, together with the south 6.00 feet of Lot 59 in said Block A, and together with the north 4.00 feet of Lot 61 in said Block A.

Parcel "Z"

Lot 61, Block A, Harvest Ridge Addition, Wichita, Sedgwick County, Kansas, except the north 4.00 feet thereof.

Parcel "AA"

Lot 64, Block A, Harvest Ridge Addition, Wichita, Sedgwick County, Kansas, except the north 8.00 feet thereof.

Parcel "BB"

Lot 65, Block A, Harvest Ridge Addition, Wichita, Sedgwick County, Kansas, except the north 10.00 feet thereof, and together with the north 8.00 feet of Lot 64 in said Block A.

Parcel "CC"

All of Lot 66, Block A, Harvest Ridge Addition, Wichita, Sedgwick County, Kansas, together with the north 10.00 feet of Lot 65 in said Block A.

Parcel "DD"

All of Lot 3, Block C, Harvest Ridge Addition, Wichita, Sedgwick County, Kansas, together with the north 10.00 feet of Lot 4 in said Block C.

Parcel "EE"

Lot 4, Block C, Harvest Ridge Addition, Wichita, Sedgwick County, Kansas, except the north 10.00 feet thereof, and together with the north 6.00 feet of Lot 5 in said Block C.

Parcel "FF"

Lot 5, Block C, Harvest Ridge Addition, Wichita, Sedgwick County, Kansas, except the north 6.00 feet thereof, and together with that part of Lot 6 in said Block C described as follows: Beginning at the front corner common to said Lots 5 and 6; thence southerly along the front line of said Lot 6, being a curve to the left, having a central angle of 01°28'27"W, and a radius of 132.00 feet, an arc distance of 3.40 feet; (having a chord length of 3.40 feet bearing S20°12'18"E); thence S69°03'29"W, 144.78 feet to a point on the rear line of said Lot 6; thence N02°04'52"W along the rear line of said Lot 6, 7.46 feet to the rear corner common to said Lots 5 and 6; thence N70°31'56"E along the lot line common to said Lots 5 and 6, 142.46 feet to the point of beginning.

Parcel "GG"

Lot 6, Block C, Harvest Ridge Addition, Wichita, Sedgwick County, Kansas, except that part of said Lot 6 described as follows: Beginning at the front corner common to said Lot 6 and Lot 5 in said Block C; thence southerly along the front line of said Lot 6, being a curve to the left, having a central angle of 01°28'27"W, and a radius of 132.00 feet, an arc distance of 3.40 feet; (having a chord length of 3.40 feet bearing S20°12'18"E); thence S69°03'29"W, 144.78 feet to a point on the rear line of said Lot 6; thence N02°04'52"W along the rear line of said Lot 6, 7.46 feet to the rear corner common to said Lots 5 and 6; thence N70°31'56"E along the lot line common to said Lots 5 and 6, 142.46 feet to the point of beginning.

Parcel "HH"

Lot 12, Block C, Harvest Ridge Addition, Wichita, Sedgwick County, Kansas, except the east 2.00 feet thereof.

Parcel "II"

All of Lot 13, Block C, Harvest Ridge Addition, Wichita, Sedgwick County, Kansas, together with the east 2.00 feet of Lot 12 in said Block C.

Parcel "JJ"

Lot 19, Block C, Harvest Ridge Addition, Wichita, Sedgwick County, Kansas, except the south 7.00 feet thereof.

Parcel "KK"

All of Lot 20, Block C, Harvest Ridge Addition, Wichita, Sedgwick County, Kansas, together with the south 7.00 feet of Lot 19 in said Block C, and together with the north 1.00 foot of Lot 21 in said Block C.

Parcel "LL"

Lot 21, Block C, Harvest Ridge Addition, Wichita, Sedgwick County, Kansas, except the north 1.00 foot thereof, and except the south 3.00 feet thereof.

Parcel "MM"

Lot 22, Block C, Harvest Ridge Addition, Wichita, Sedgwick County, Kansas, except that part of said Lot 22 described as follows: Beginning at the front corner common to said Lots 22 and Lot 23 in said Block C; thence S81°43'33"W along the lot line common to said Lots 22 and 23, 131.53 feet to the rear corner common to said Lots 22 and 23; thence N02°05'55"W along the rear line of said Lot 22, 17.74 feet; thence N85°34'54"E, 130.21 feet to a point on the front line of said Lot 22; thence southerly along the front line of said Lot 22, being a curve to the left, having a central angle of 03°51'21" and a radius of 132.00 feet, an arc distance of 8.88 feet, (having a chord length of 8.88 feet bearing S06°20'47"E), to the point of beginning, and together with the south 3.00 feet of Lot 21 in said Block C.

Parcel "NN"

All of Lot 23, Block C, Harvest Ridge Addition, Wichita, Sedgwick County, Kansas, together with that part of Lot 22 in said Block C described as follows: Beginning at the front corner common to said Lots 22 and 23; thence S81°43'33"W along the lot line common to said Lots 22 and 23, 131.53 feet to the rear corner common to said Lots 22 and 23; thence N02°05'55"W along the rear line of said Lot 22, 17.74 feet; thence N85°34'54"E, 130.21 feet to a point on the front line of said Lot 22; thence southerly along the front line of said Lot 22, being a curve to the left, having a central angle of 03°51'21" and a radius of 132.00 feet, and arc distance of 8.88 feet, (having a chord length of 8.88 feet bearing S06°20'47"E), to the point of beginning.

Parcel "OO"

Lot 29, Block C, Harvest Ridge Addition, Wichita, Sedgwick County, Kansas, except the east 2.00 feet thereof.

Parcel "PP"

All of Lot 30, Block C, Harvest Ridge Addition, Wichita, Sedgwick County, Kansas, together with the east 2.00 feet of Lot 29 in said Block C.

Parcel "QQ"

Lot 32, Block C, Harvest Ridge Addition, Wichita, Sedgwick County, Kansas, except the south 4.00 feet thereof.

Parcel "RR"

All of Lot 33, Block C, Harvest Ridge Addition, Wichita, Sedgwick County, Kansas, together with the south 4.00 feet of Lot 32 in said Block C, and together with the north 4.00 feet of Lot 34 in said Block C.

Parcel "SS"

Lot 34, Block C, Harvest Ridge Addition, Wichita, Sedgwick County, Kansas, except the north 4.00 feet thereof.

Parcel "TT"

Lot 50, Block B, Harvest Ridge Addition, Wichita, Sedgwick County, Kansas, except the north 3.11 feet thereof.

Parcel "UU"

Lot 49, Block B, Harvest Ridge Addition, Wichita, Sedgwick County, Kansas, except the north 7.11 feet thereof, and together with the north 3.11 feet of Lot 50 in said Block B.

Parcel "VV"

Lot 48, Block B, Harvest Ridge Addition, Wichita, Sedgwick County, Kansas, except that part of said Lot 48 described as follows: Beginning at the front corner common to said Lot 48 and Lot 47 in said Block B; thence N78°08'01"E along the lot line common to said Lots 47 and 48, 135.03 feet to the rear corner common to said Lots 47 and 48; thence S00°00'00"E along the rear line of said Lot 48, 17.02 feet; thence S81°03'45"W, 131.96 feet to a point on the front line of said Lot 48; thence northerly along the front line of said Lot 48, being a curve to the left, having a central angle of 02°55'44" and a radius of 194.00 feet, an arc distance of 9.92 feet, (having a chord length of 9.92 feet bearing N10°24'07"W), to the point of beginning, and together with the north 7.11 feet of Lot 49 in said Block B.

Parcel "WW"

Lot 47, Block B, Harvest Ridge Addition, Wichita, Sedgwick County, Kansas, except that part of said Lot 47 described as follows: Beginning at the front corner common to said Lot 47 and Lot 46 in said Block B; thence N59°44'28"E along the lot line common to said Lots 46 and 47, 141.04 feet to the rear corner common to said Lots 46 and 47; thence S50°39'29"E along the rear line of said Lot 47, 5.05 feet; thence S60°32'47"W, 142.84 feet to a point on the front line of said Lot 47; thence northwesterly along the front line of said Lot 47, being a curve to the left, having a central angle of 00°48'19" and a radius of 194.00 feet, an arc distance of 2.73 feet, (having a chord length of 2.73 feet bearing N29°51'23"W), to the point of beginning, and together with that part of Lot 48 in said Block B described as follows: Beginning at the front corner common to said Lots 47 and 48; thence N78°08'01"E along the lot line common to said Lots 47 and 48, 135.03 feet to the rear corner common to said Lots 47 and 48; thence S00°00'00"E along the rear line of said Lot 48, 17.02 feet; thence S81°03'45"W, 131.96 feet to a point on the front line of said Lot 48; thence northerly along the front line of said Lot 48, being a curve to the left, having a central angle of 02°55'44" and a radius of 194.00 feet, an arc distance of 9.92 feet, (having a chord length of 9.92 feet bearing N10°24'07"W), to the point of beginning.

Parcel "XB"

Lot 35, Block B, Harvest Ridge Addition, Wichita, Sedgwick County, Kansas, except the north 15.75 feet thereof, and together with the north 13.75 feet of Lot 36 in said Block B.

Parcel "XF"

All of Lot 34, Block B, Harvest Ridge Addition, Wichita, Sedgwick County, Kansas, together with the north 15.75 feet of Lot 34 in said Block B.




All of Lot 14, Block B, Harvest Ridge Addition, Wichita, Sedgwick County, Kansas, together with the north 4.00 feet of Lot 15 in said Block B, and together with the south 2.00 feet of Lot 13 in said Block B.

Parcel "XI"

Lot 13, Block B, Harvest Ridge Addition, Wichita, Sedgwick County, Kansas, except the south 2.00 feet thereof, and except the north 2.00 feet thereof.

Parcel "XJ"

Lot 12, Block B, Harvest Ridge Addition, Wichita, Sedgwick County, Kansas, except the north 6.00 feet thereof, and together with the north 2.00 feet of Lot 13 in said Block B.

Parcel "XK"

All of Lot 11, Block B, Harvest Ridge Addition, Wichita, Sedgwick County, Kansas, together with the north 6.00 feet of Lot 12 in said Block B.

Parcel "XL"

Lot 8, Block B, Harvest Ridge Addition, Wichita, Sedgwick County, Kansas, except the east 6.00 feet thereof.

Parcel "XX"

All of Lot 46, Block B, Harvest Ridge Addition, Wichita, Sedgwick County, Kansas, together with that part of Lot 47 in said Block B described as follows: Beginning at the front corner common to said Lots 46 and 47; thence N59°44'28"E along the lot line common to said Lots 46 and 47, 141.04 feet to the rear corner common to said Lots 46 and 47; thence S50°39'29"E along the rear line of said Lot 47, 5.05 feet; thence S60°32'47"W, 142.84 feet to a point on the front line of said Lot 47; thence northwesterly along the front line of said Lot 47, being a curve to the left, having a central angle of 00°48'19" and a radius of 194.00 feet, an arc distance of 2.73 feet, (having a chord length of 2.73 feet bearing N29°51'23"W), to the point of beginning.

Parcel "YY"

All of Lot 41, Block B, Harvest Ridge Addition, Wichita, Sedgwick County, Kansas, together with the east 4.00 feet of Lot 40 in said Block B.

Parcel "ZZ"

Lot 40, Block B, Harvest Ridge Addition, Wichita, Sedgwick County, Kansas, except the east 4.00 feet thereof.

Parcel "XA"

Lot 39, Block B, Harvest Ridge Addition, Wichita, Sedgwick County, Kansas, except the north 2.75 feet thereof.

Parcel "XB"

Lot 38, Block B, Harvest Ridge Addition, Wichita, Sedgwick County, Kansas, except the north 6.75 feet thereof, and together with the north 2.75 feet of Lot 39 in said Block B.

Parcel "XC"

Lot 37, Block B, Harvest Ridge Addition, Wichita, Sedgwick County, Kansas, except the north 8.75 feet thereof, and together with the north 6.75 feet of Lot 38 in said Block B.

Parcel "XD"

Lot 36, Block B, Harvest Ridge Addition, Wichita, Sedgwick County, Kansas, except the north 13.75 feet thereof, and together with the north 8.75 feet of Lot 37 in said Block B.

Parcel "XM"

All of Lot 7, Block B, Harvest Ridge Addition, Wichita, Sedgwick County, Kansas, together with the east 6.00 feet of Lot 8 in said Block B.

Parcel "XN"

Lot 6, Block B, Harvest Ridge Addition, Wichita, Sedgwick County, Kansas, except the east 10.00 feet thereof.

Parcel "XO"

All of Lot 5, Block B, Harvest Ridge Addition, Wichita, Sedgwick County, Kansas, together with the east 10.00 feet of Lot 6 in said Block B.

Parcel "XP"

All of Lot 4, Block B, Harvest Ridge Addition, Wichita, Sedgwick County, Kansas, together with the west 3.00 feet of Lot 3 in said Block B.

Parcel "XQ"

Lot 3, Block B, Harvest Ridge Addition, Wichita, Sedgwick County, Kansas, except the west 3.00 feet thereof.


Parcel "XR"

Lot 2, Block B, Harvest Ridge Addition, Wichita, Sedgwick County, Kansas, except the east 6.00 feet thereof.

Parcel "XS"

All of Lot 1, Block B, Harvest Ridge Addition, Wichita, Sedgwick County, Kansas, together with the east 6.00 feet of Lot 2 in said Block B.


EXHIBIT **PART OF HARVEST RIDGE ADDITION** **WICHITA, SEDGWICK COUNTY, KANSAS**

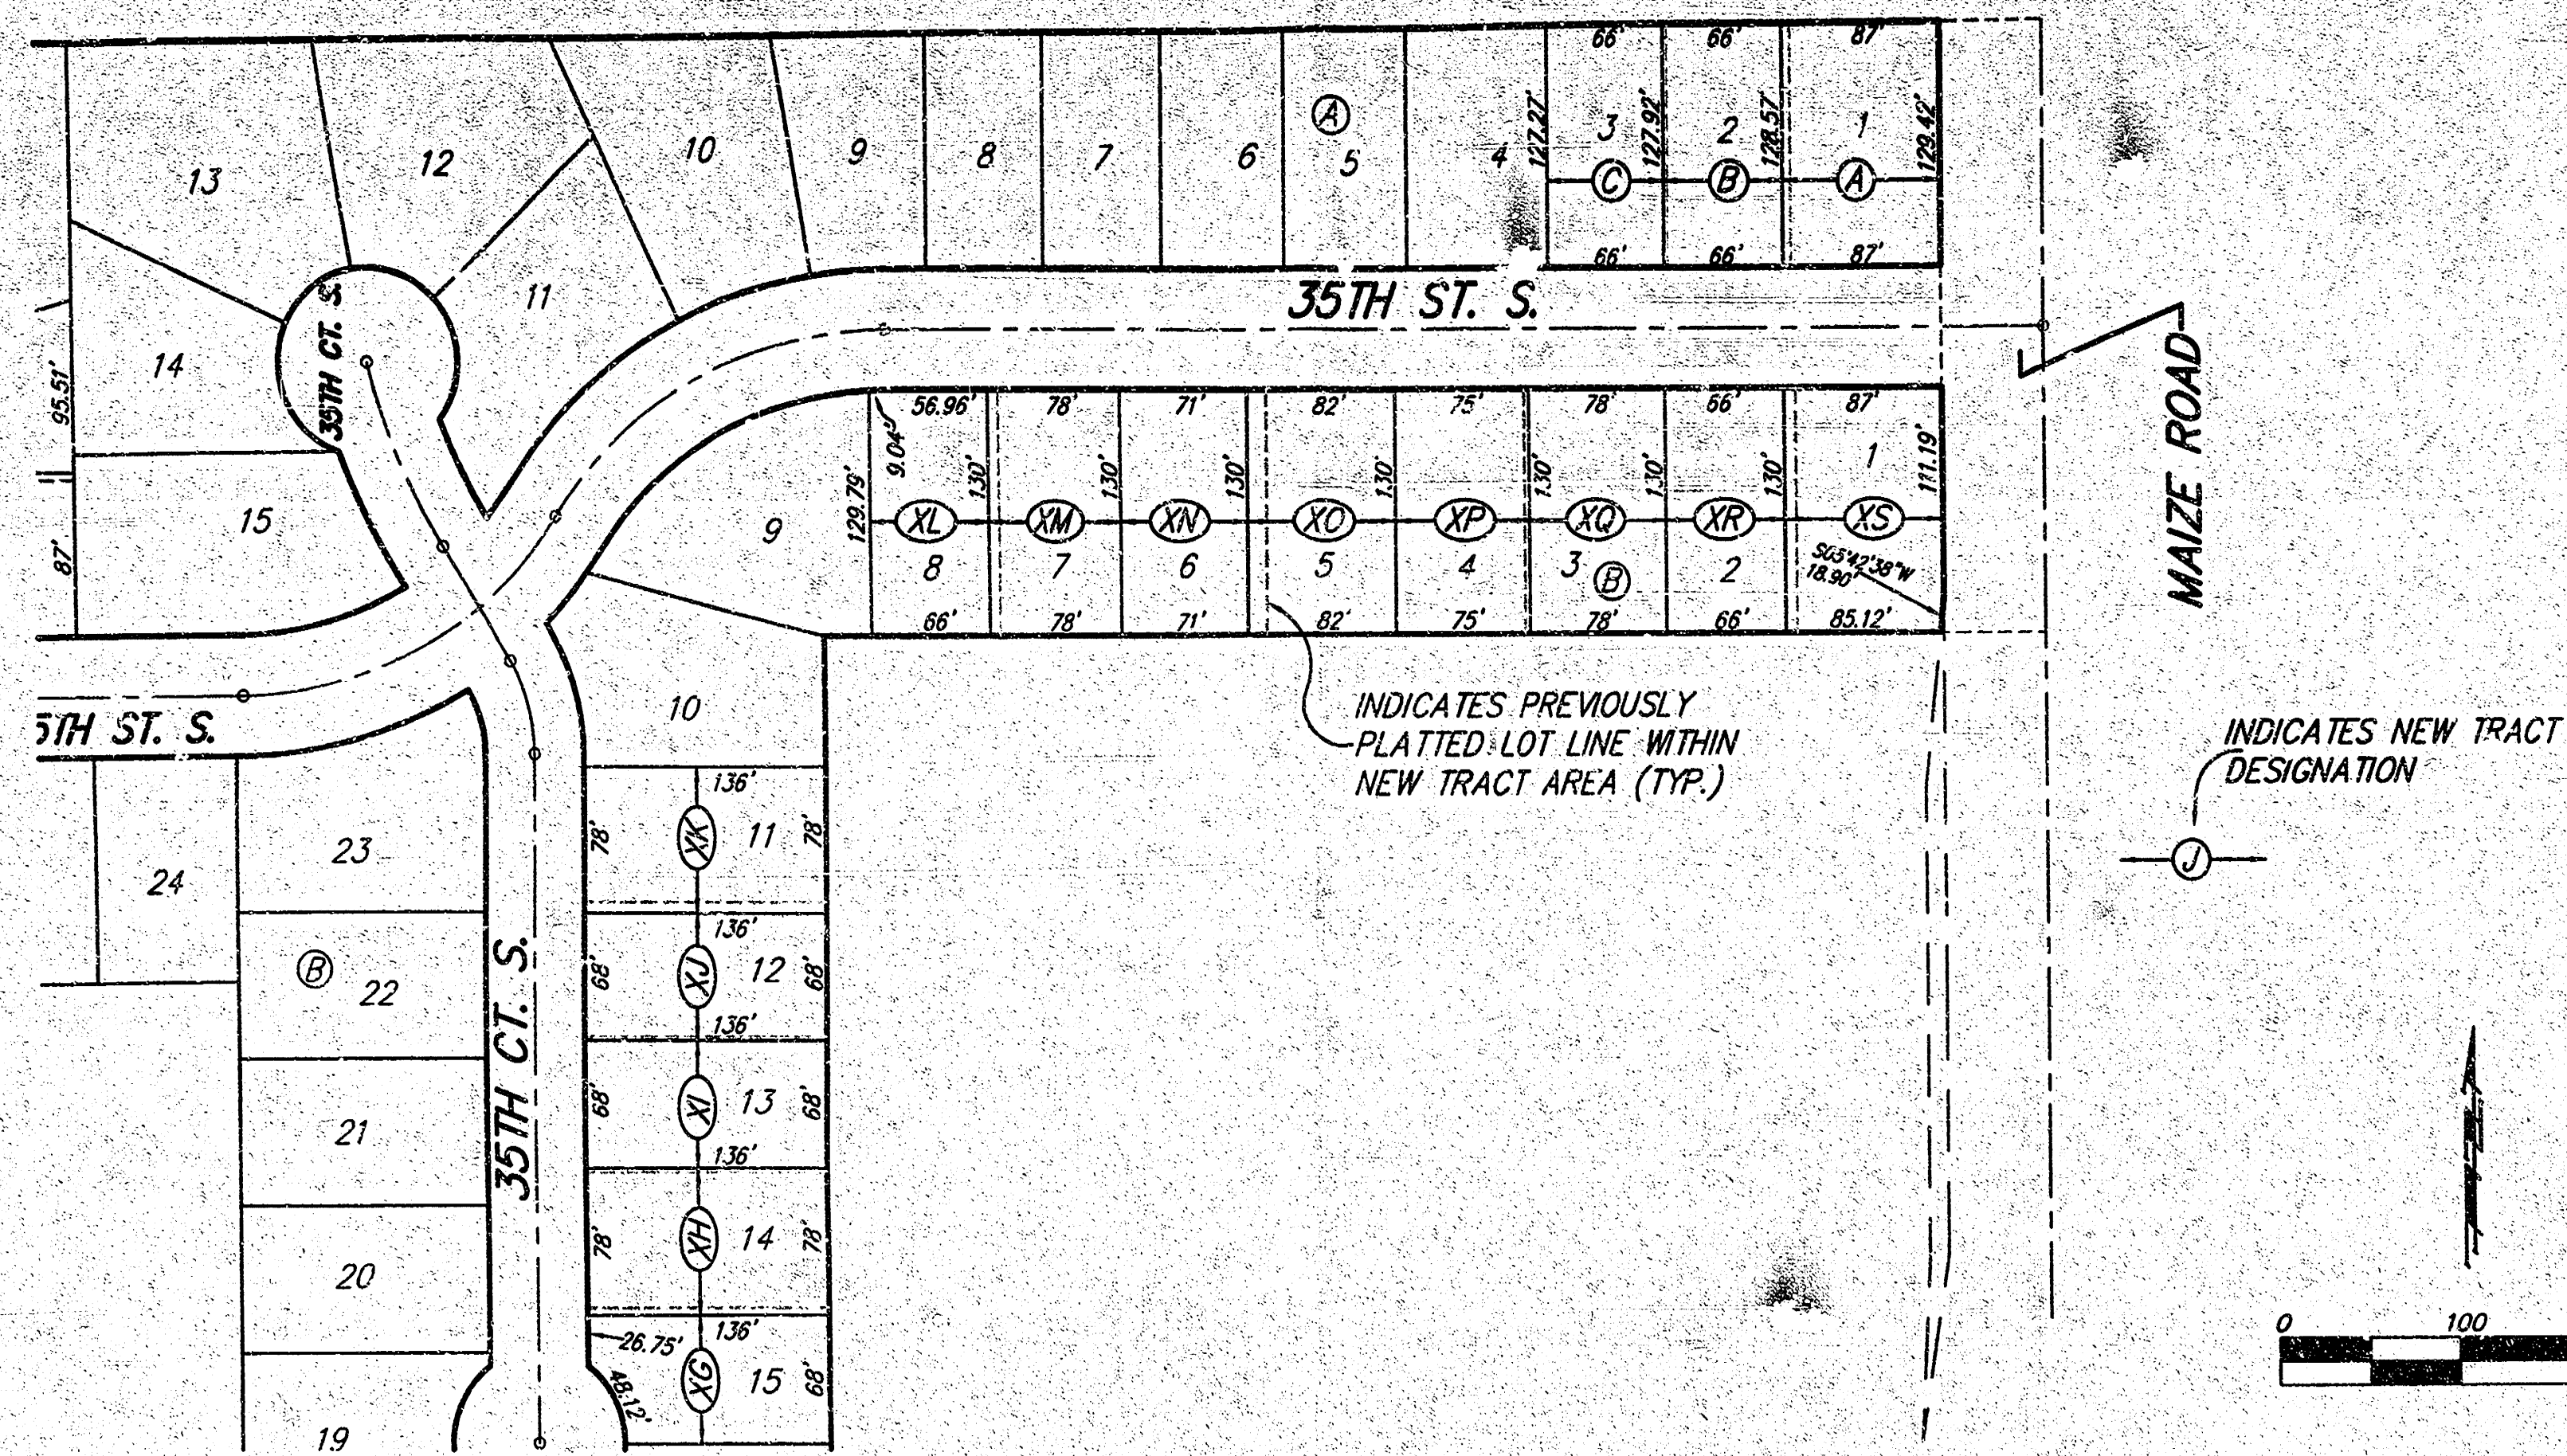

PAGE 1 OF 5

Baughman Company, P.A.
 215 E. 10th St., Wichita, KS 67202
 (316) 262-2271 F (316) 262-0199
 P:\PLATTING\WICHITA\HARVEST RIDGE ADDITION\WICHITA HARVEST RIDGE ADDITION.DWG


EXHIBIT **PART OF HARVEST RIDGE ADDITION** **WICHITA, SEDGWICK COUNTY, KANSAS**

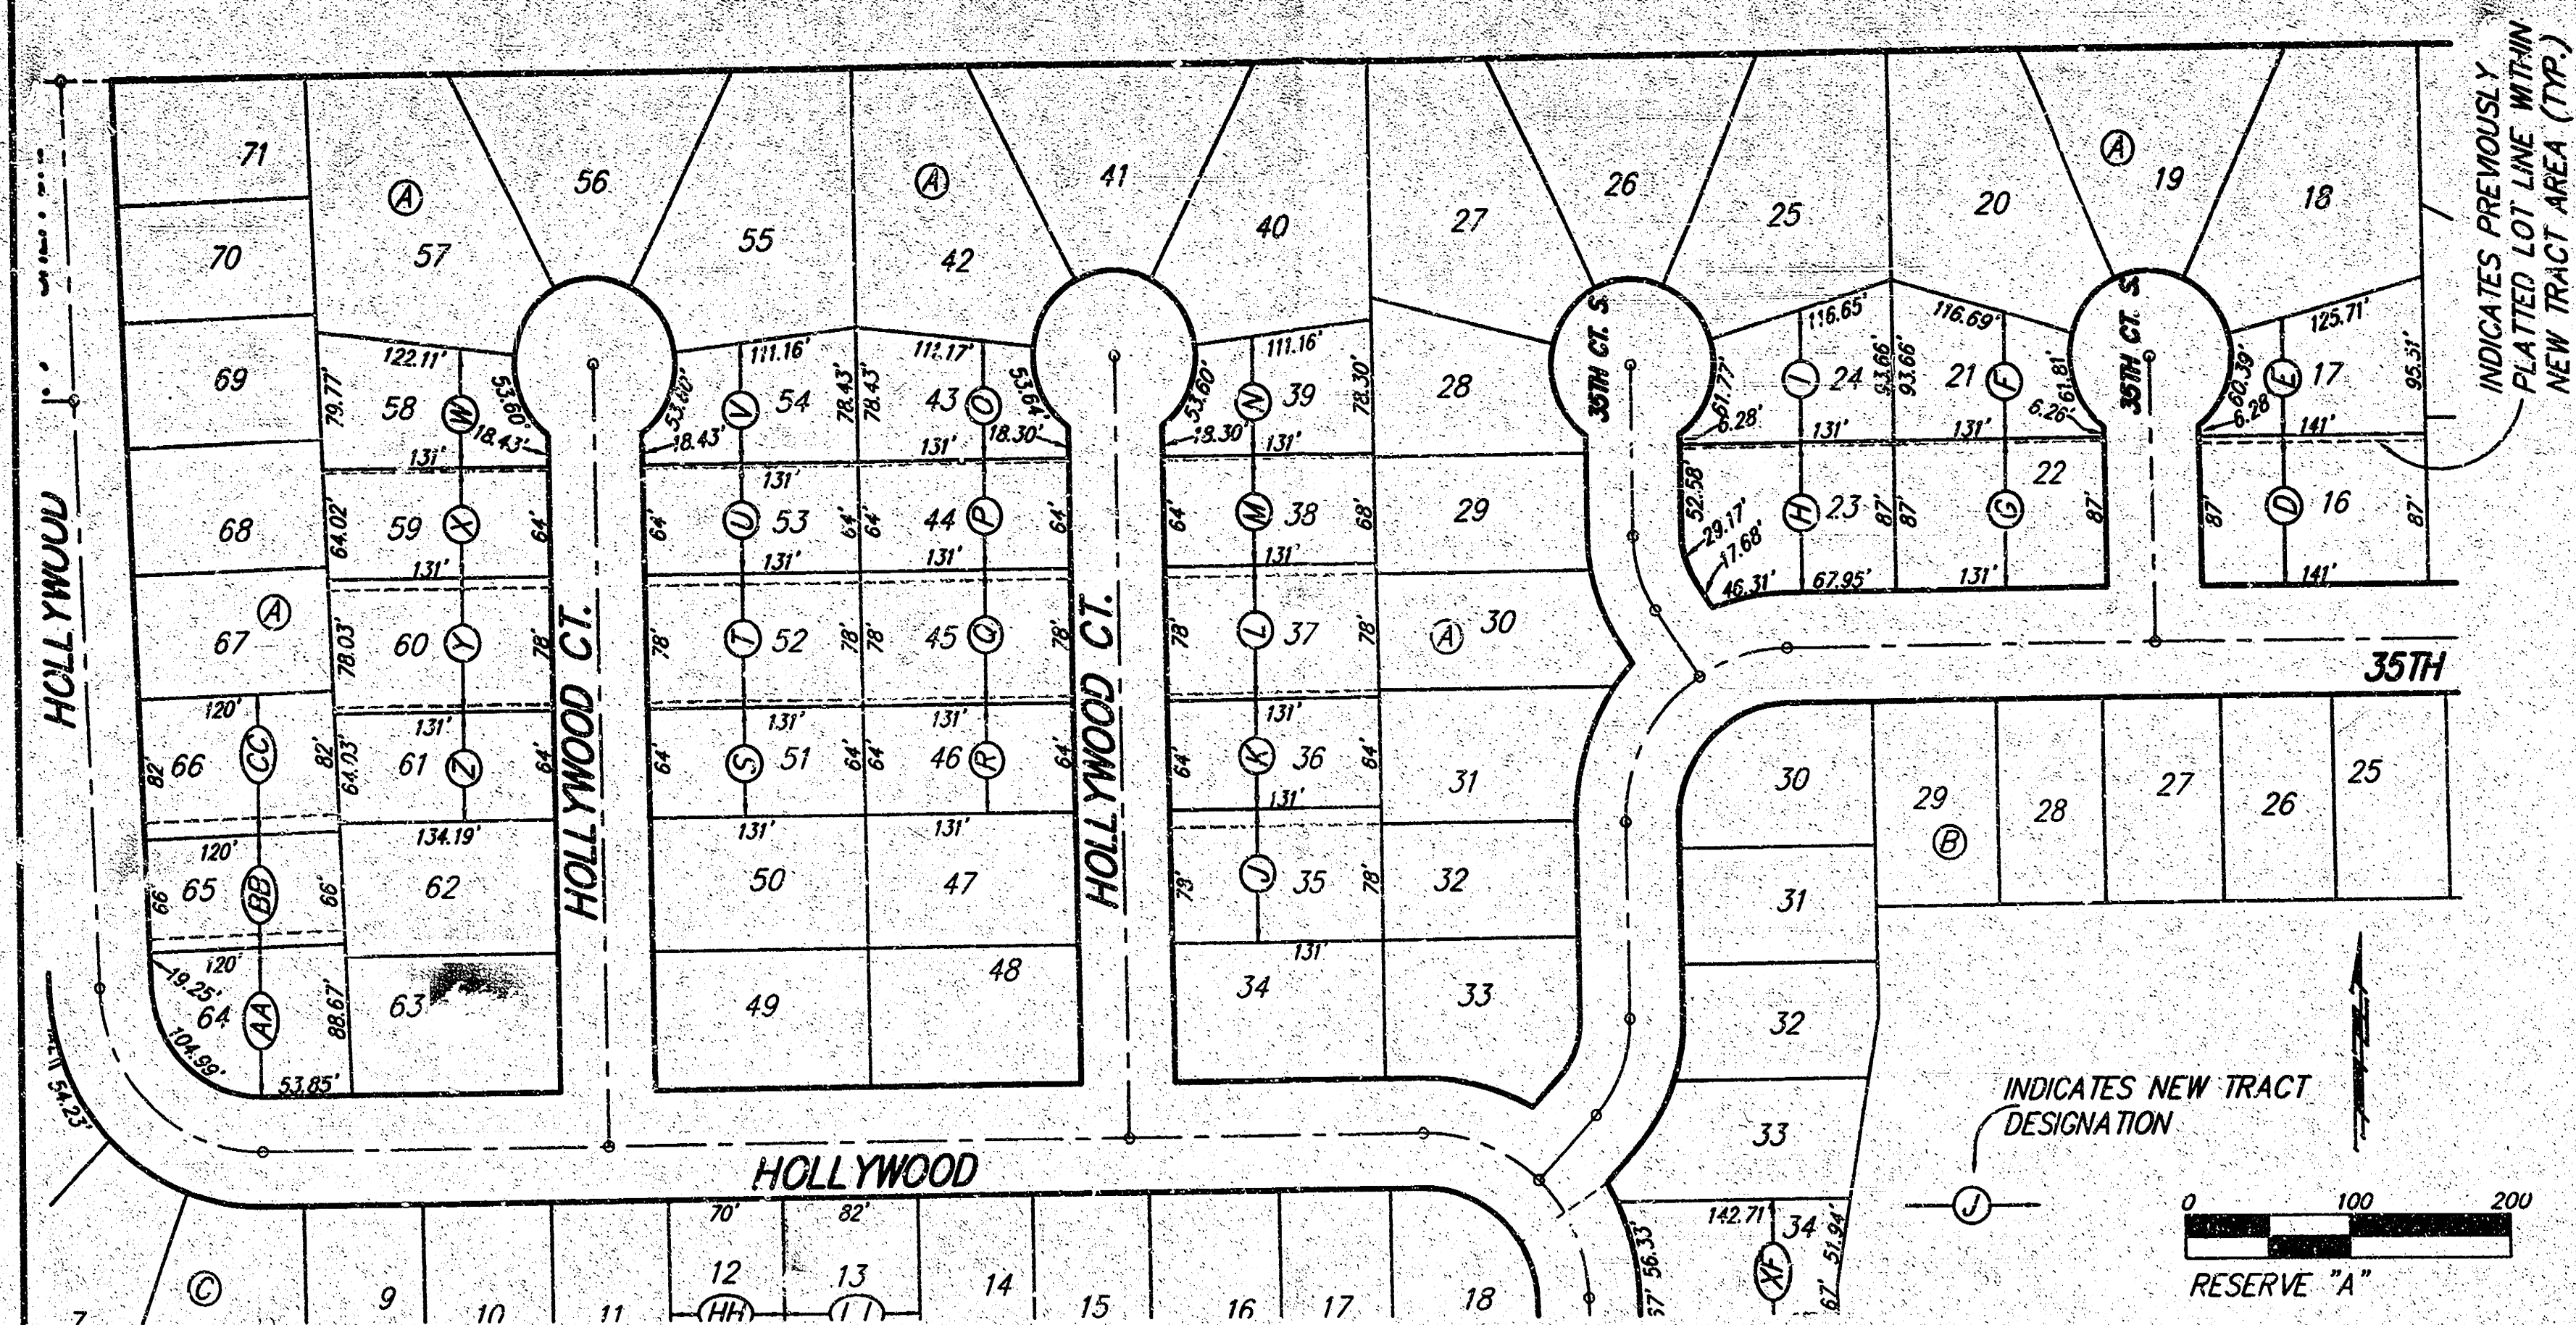

PAGE 2 OF 5

Baughman Company, P.A.
 215 E. 10th St., Wichita, KS 67202
 (316) 262-2271 F (316) 262-0199
 P:\PLATTING\WICHITA\HARVEST RIDGE ADDITION\WICHITA HARVEST RIDGE ADDITION.DWG


EXHIBIT **PART OF HARVEST RIDGE ADDITION** **WICHITA, SEDGWICK COUNTY, KANSAS**

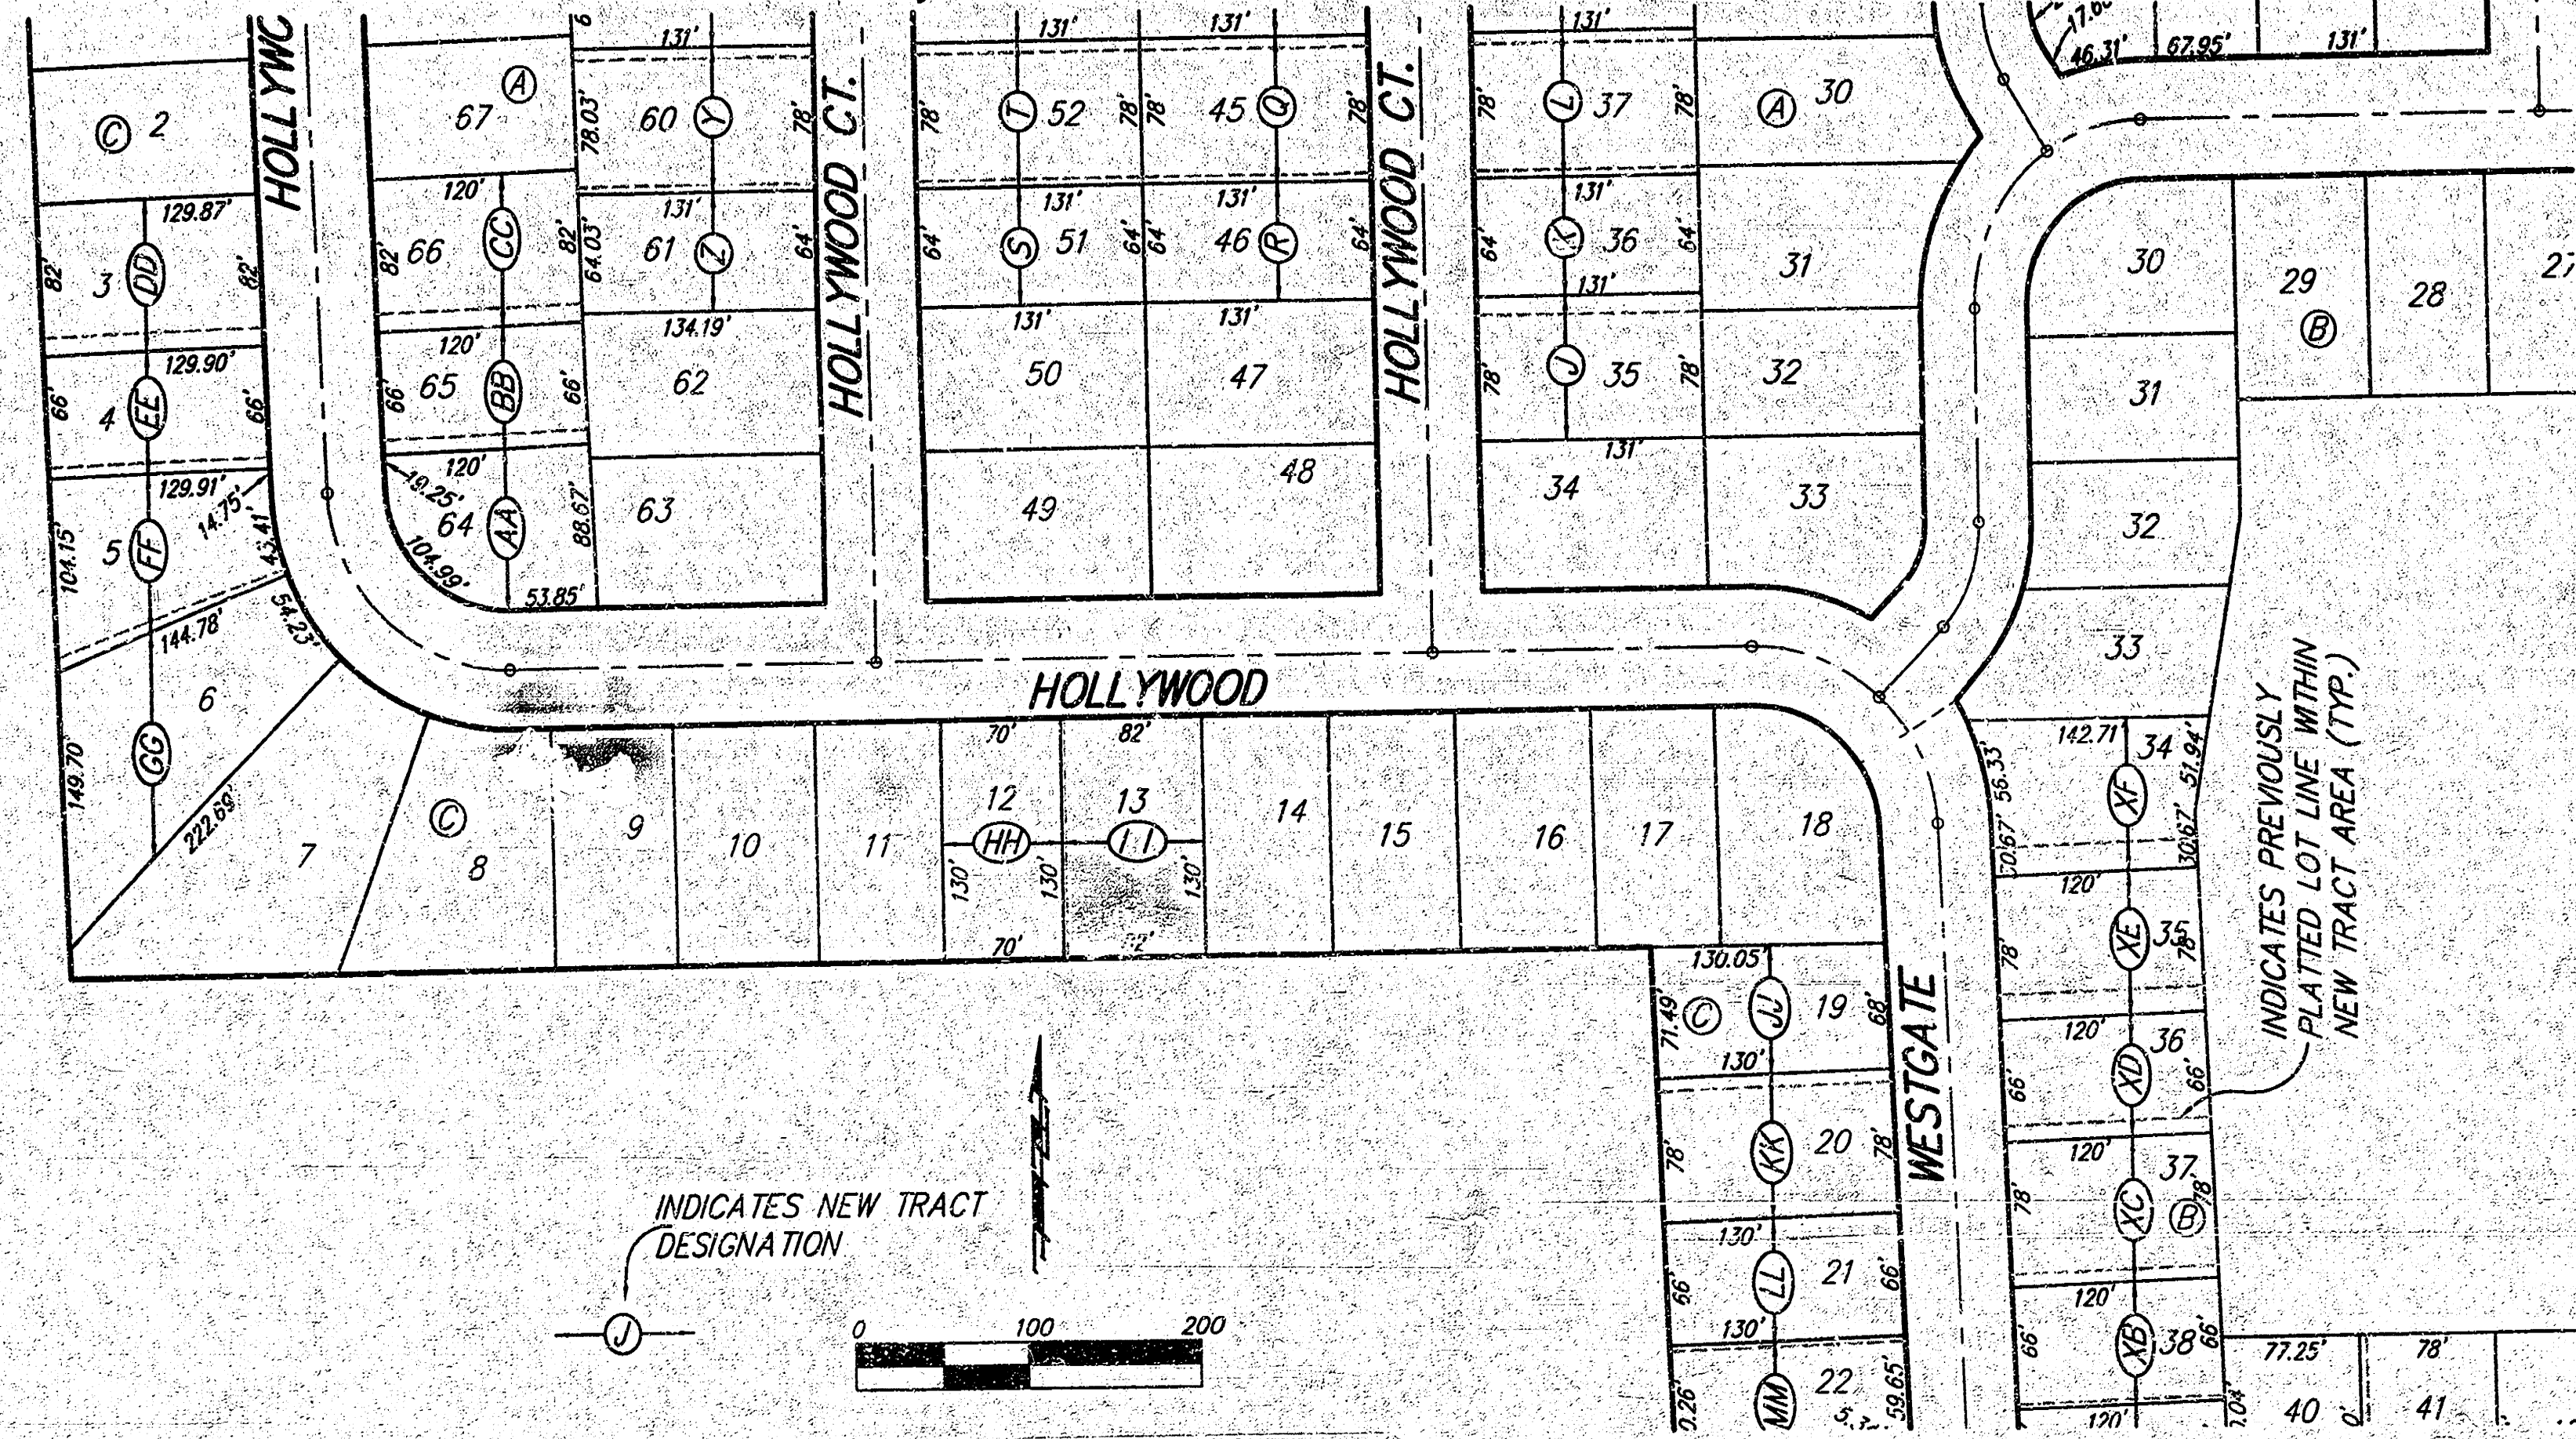

PAGE 3 OF 5

Baughman Company, P.A.
 215 E. 10th St., Wichita, KS 67202
 (316) 262-2271 F (316) 262-0199
 P:\PLATTING\WICHITA\HARVEST RIDGE ADDITION\WICHITA HARVEST RIDGE ADDITION.DWG

EXHIBIT **PART OF HARVEST RIDGE ADDITION** **WICHITA, SEDGWICK COUNTY, KANSAS**

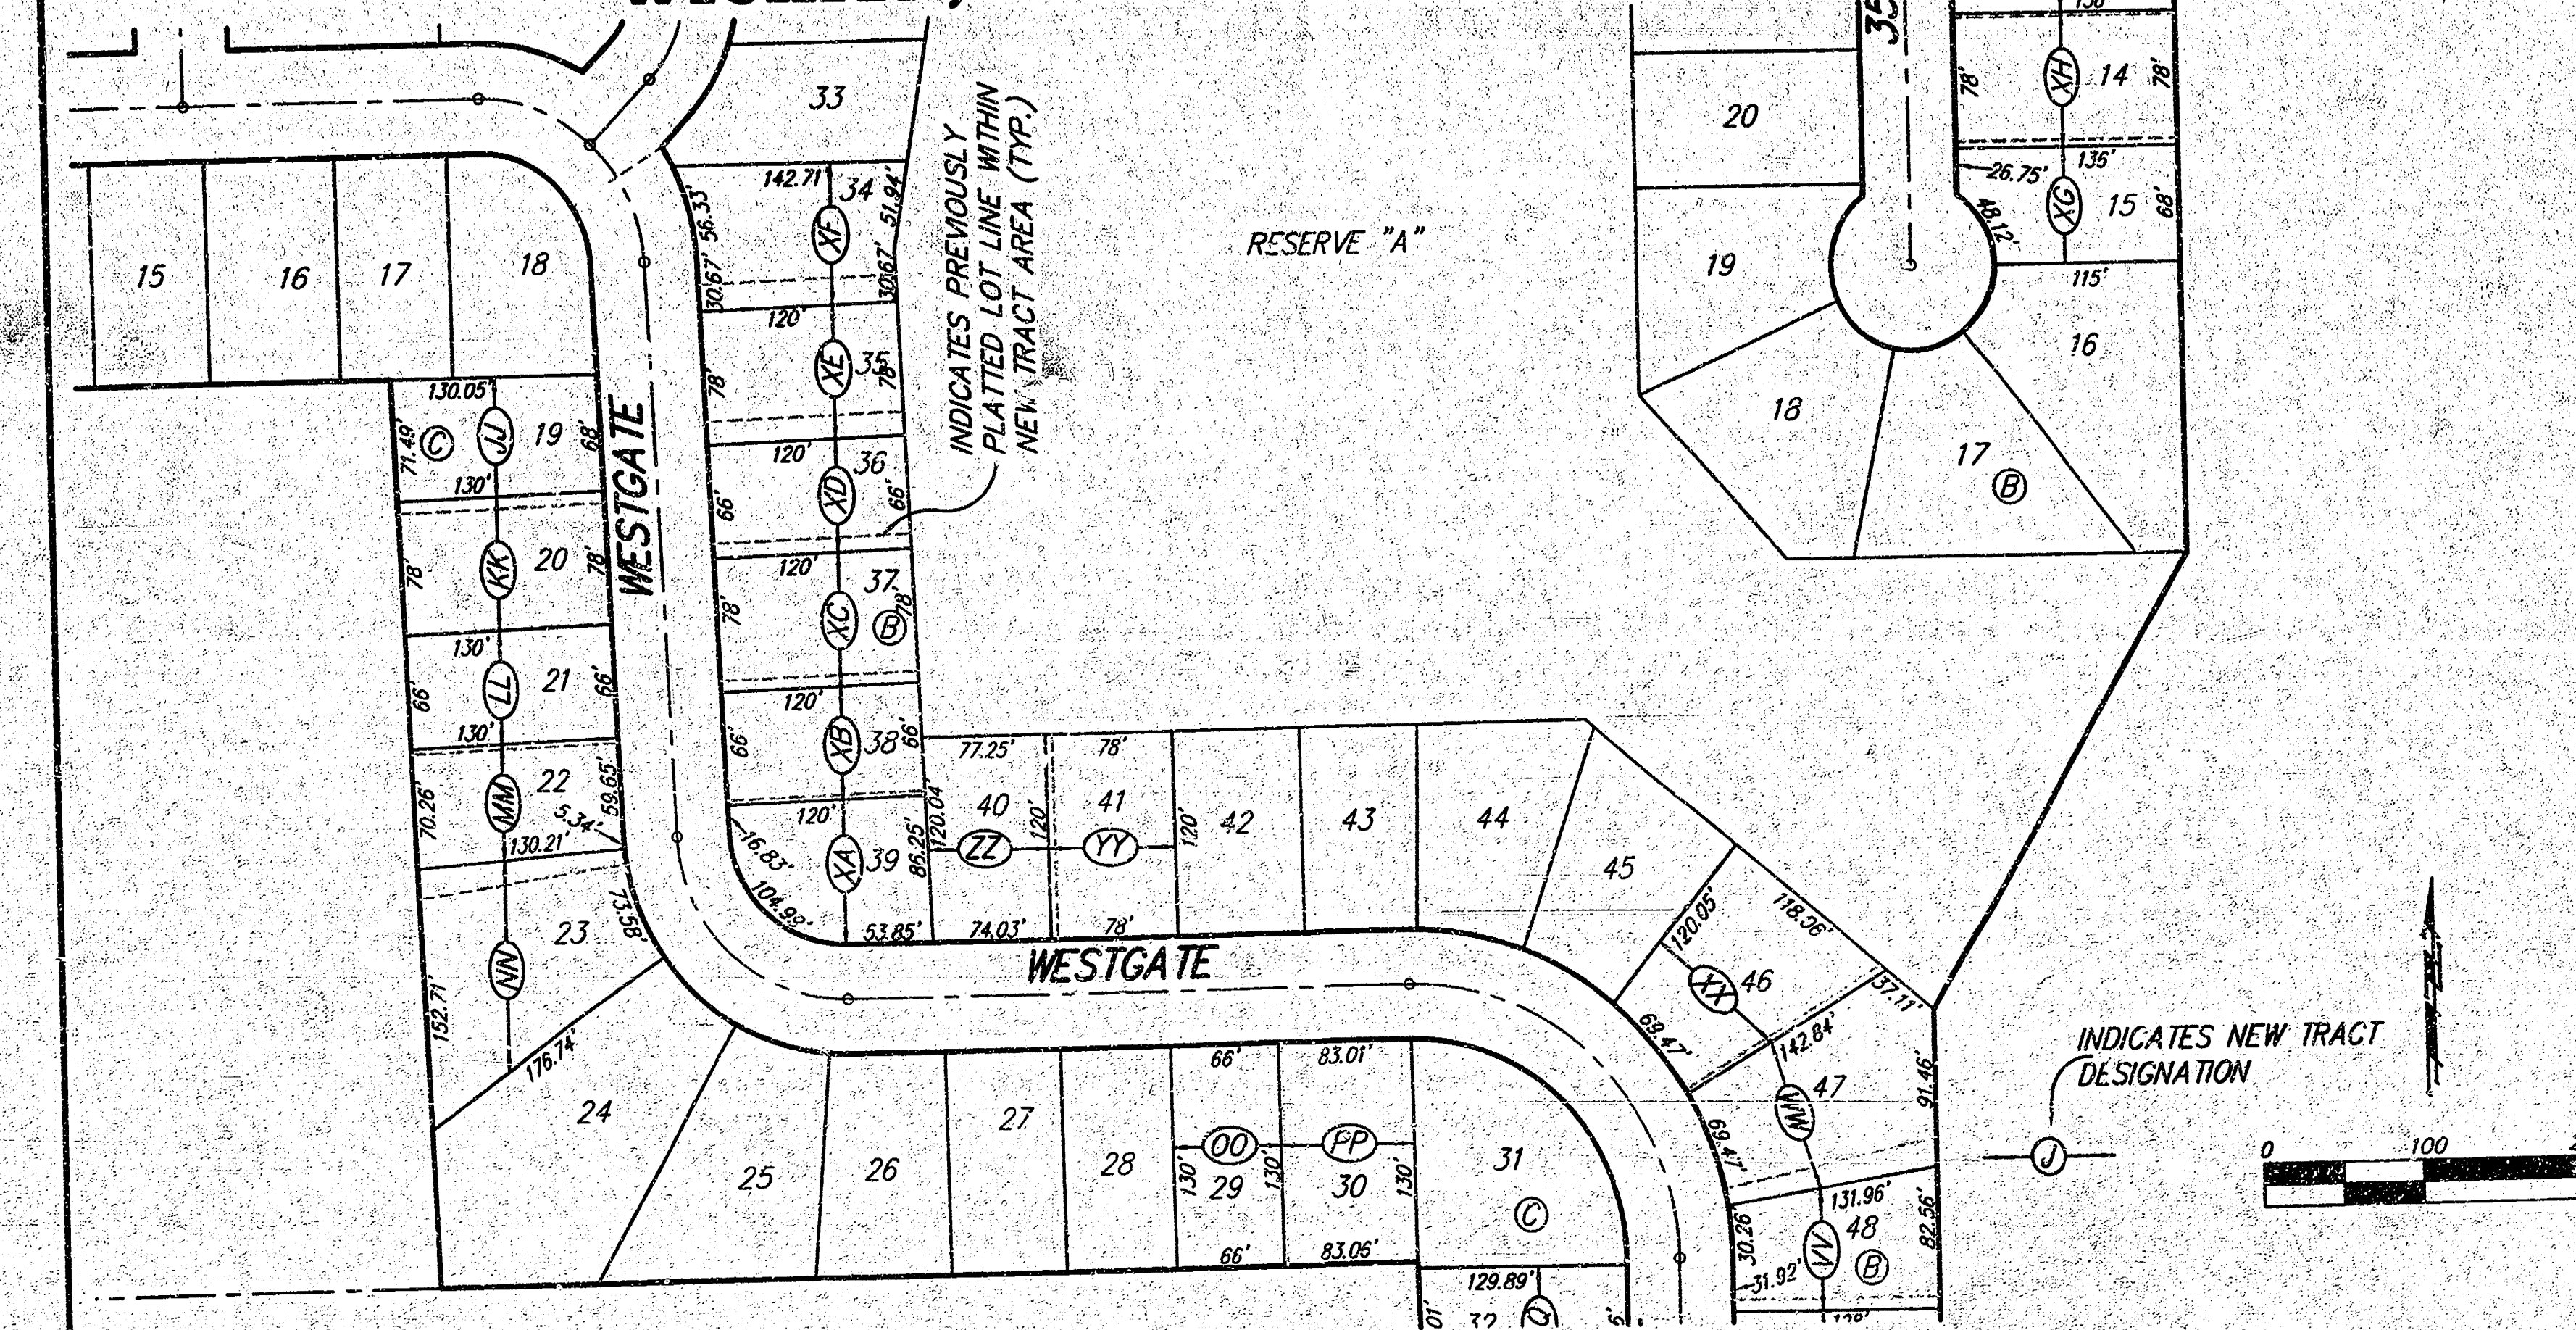

PAGE 4 OF 5

Baughman Company, P.A.
 215 E. 10th St., Wichita, KS 67202
 (316) 262-2271 F (316) 262-0199
 P:\PLATTING\WICHITA\HARVEST RIDGE ADDITION\WICHITA HARVEST RIDGE ADDITION.DWG

EXHIBIT **PART OF HARVEST RIDGE ADDITION** **WICHITA, SEDGWICK COUNTY, KANSAS**

