
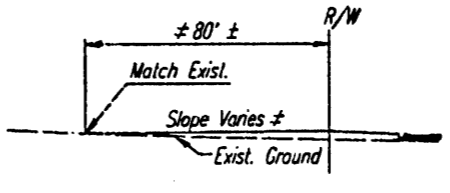
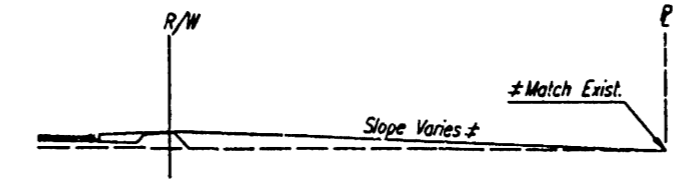
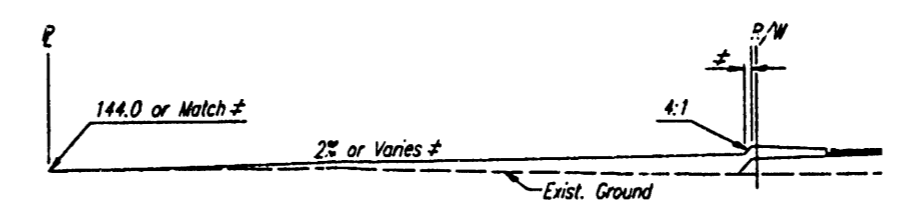


PROJECT	SHEET	DIST.
173-18-16-0000-00-000-001	14	23

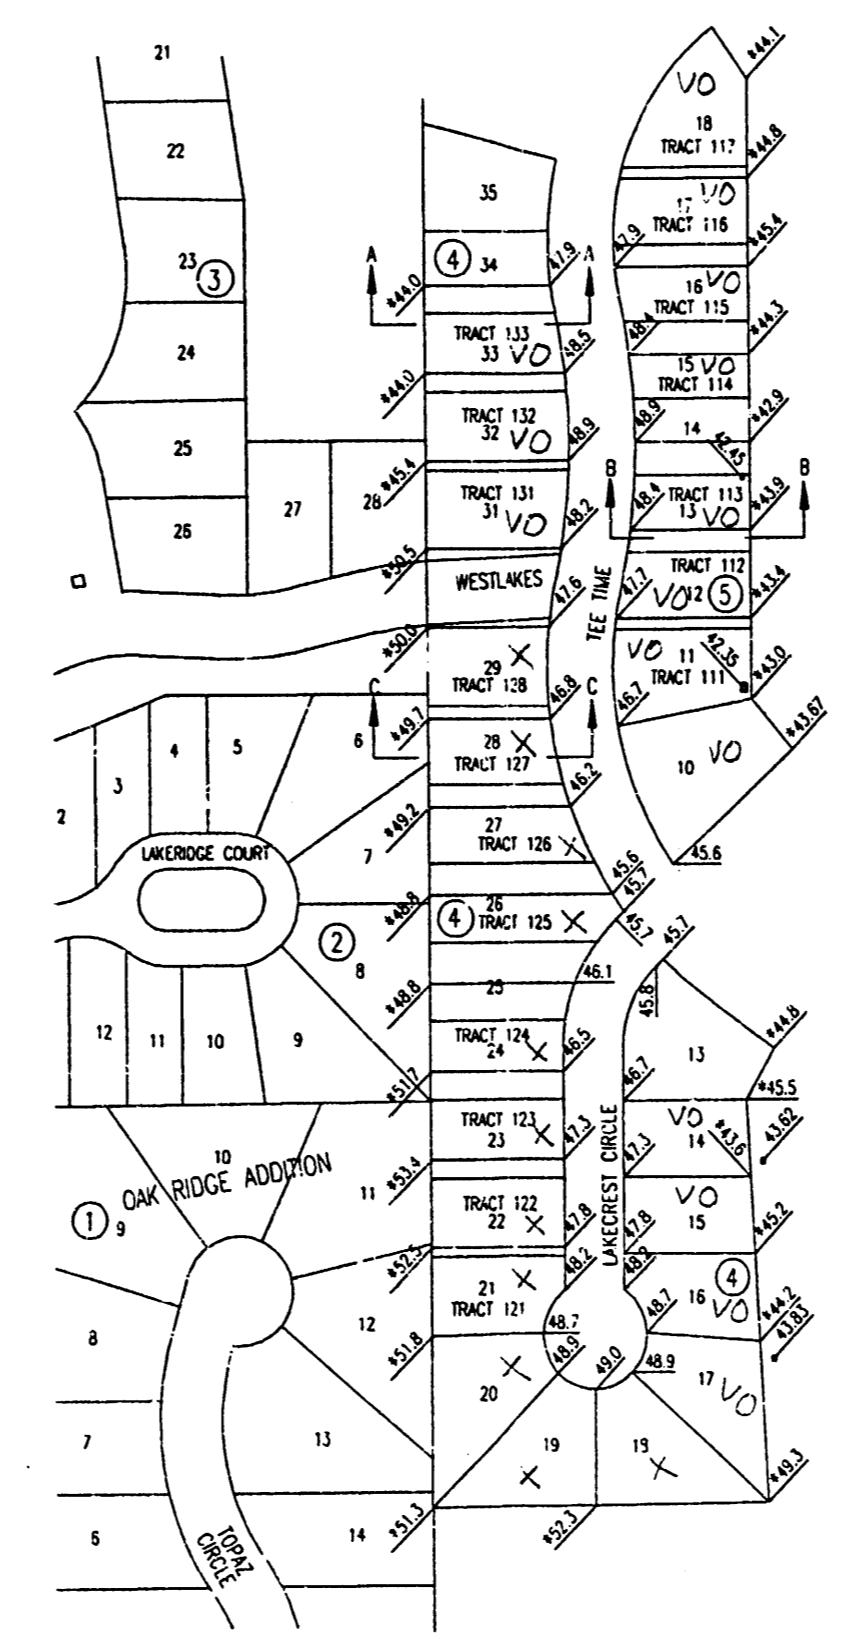


Match Existing
O Existing Intersect

DOWN: BEST COPY: B.S. SCALE: 1"=100'
 1/23/00/0002/174 ECOM-SHOW: 8-11-2000

DATE	BY	CHK	APP
FOREST LAKES PHASE 5 REV. CITY OF WICHITA, KANSAS FOUR CORNER LOT GRADING PLAN			
DATE	BY	CHK	APP
July 2000			