



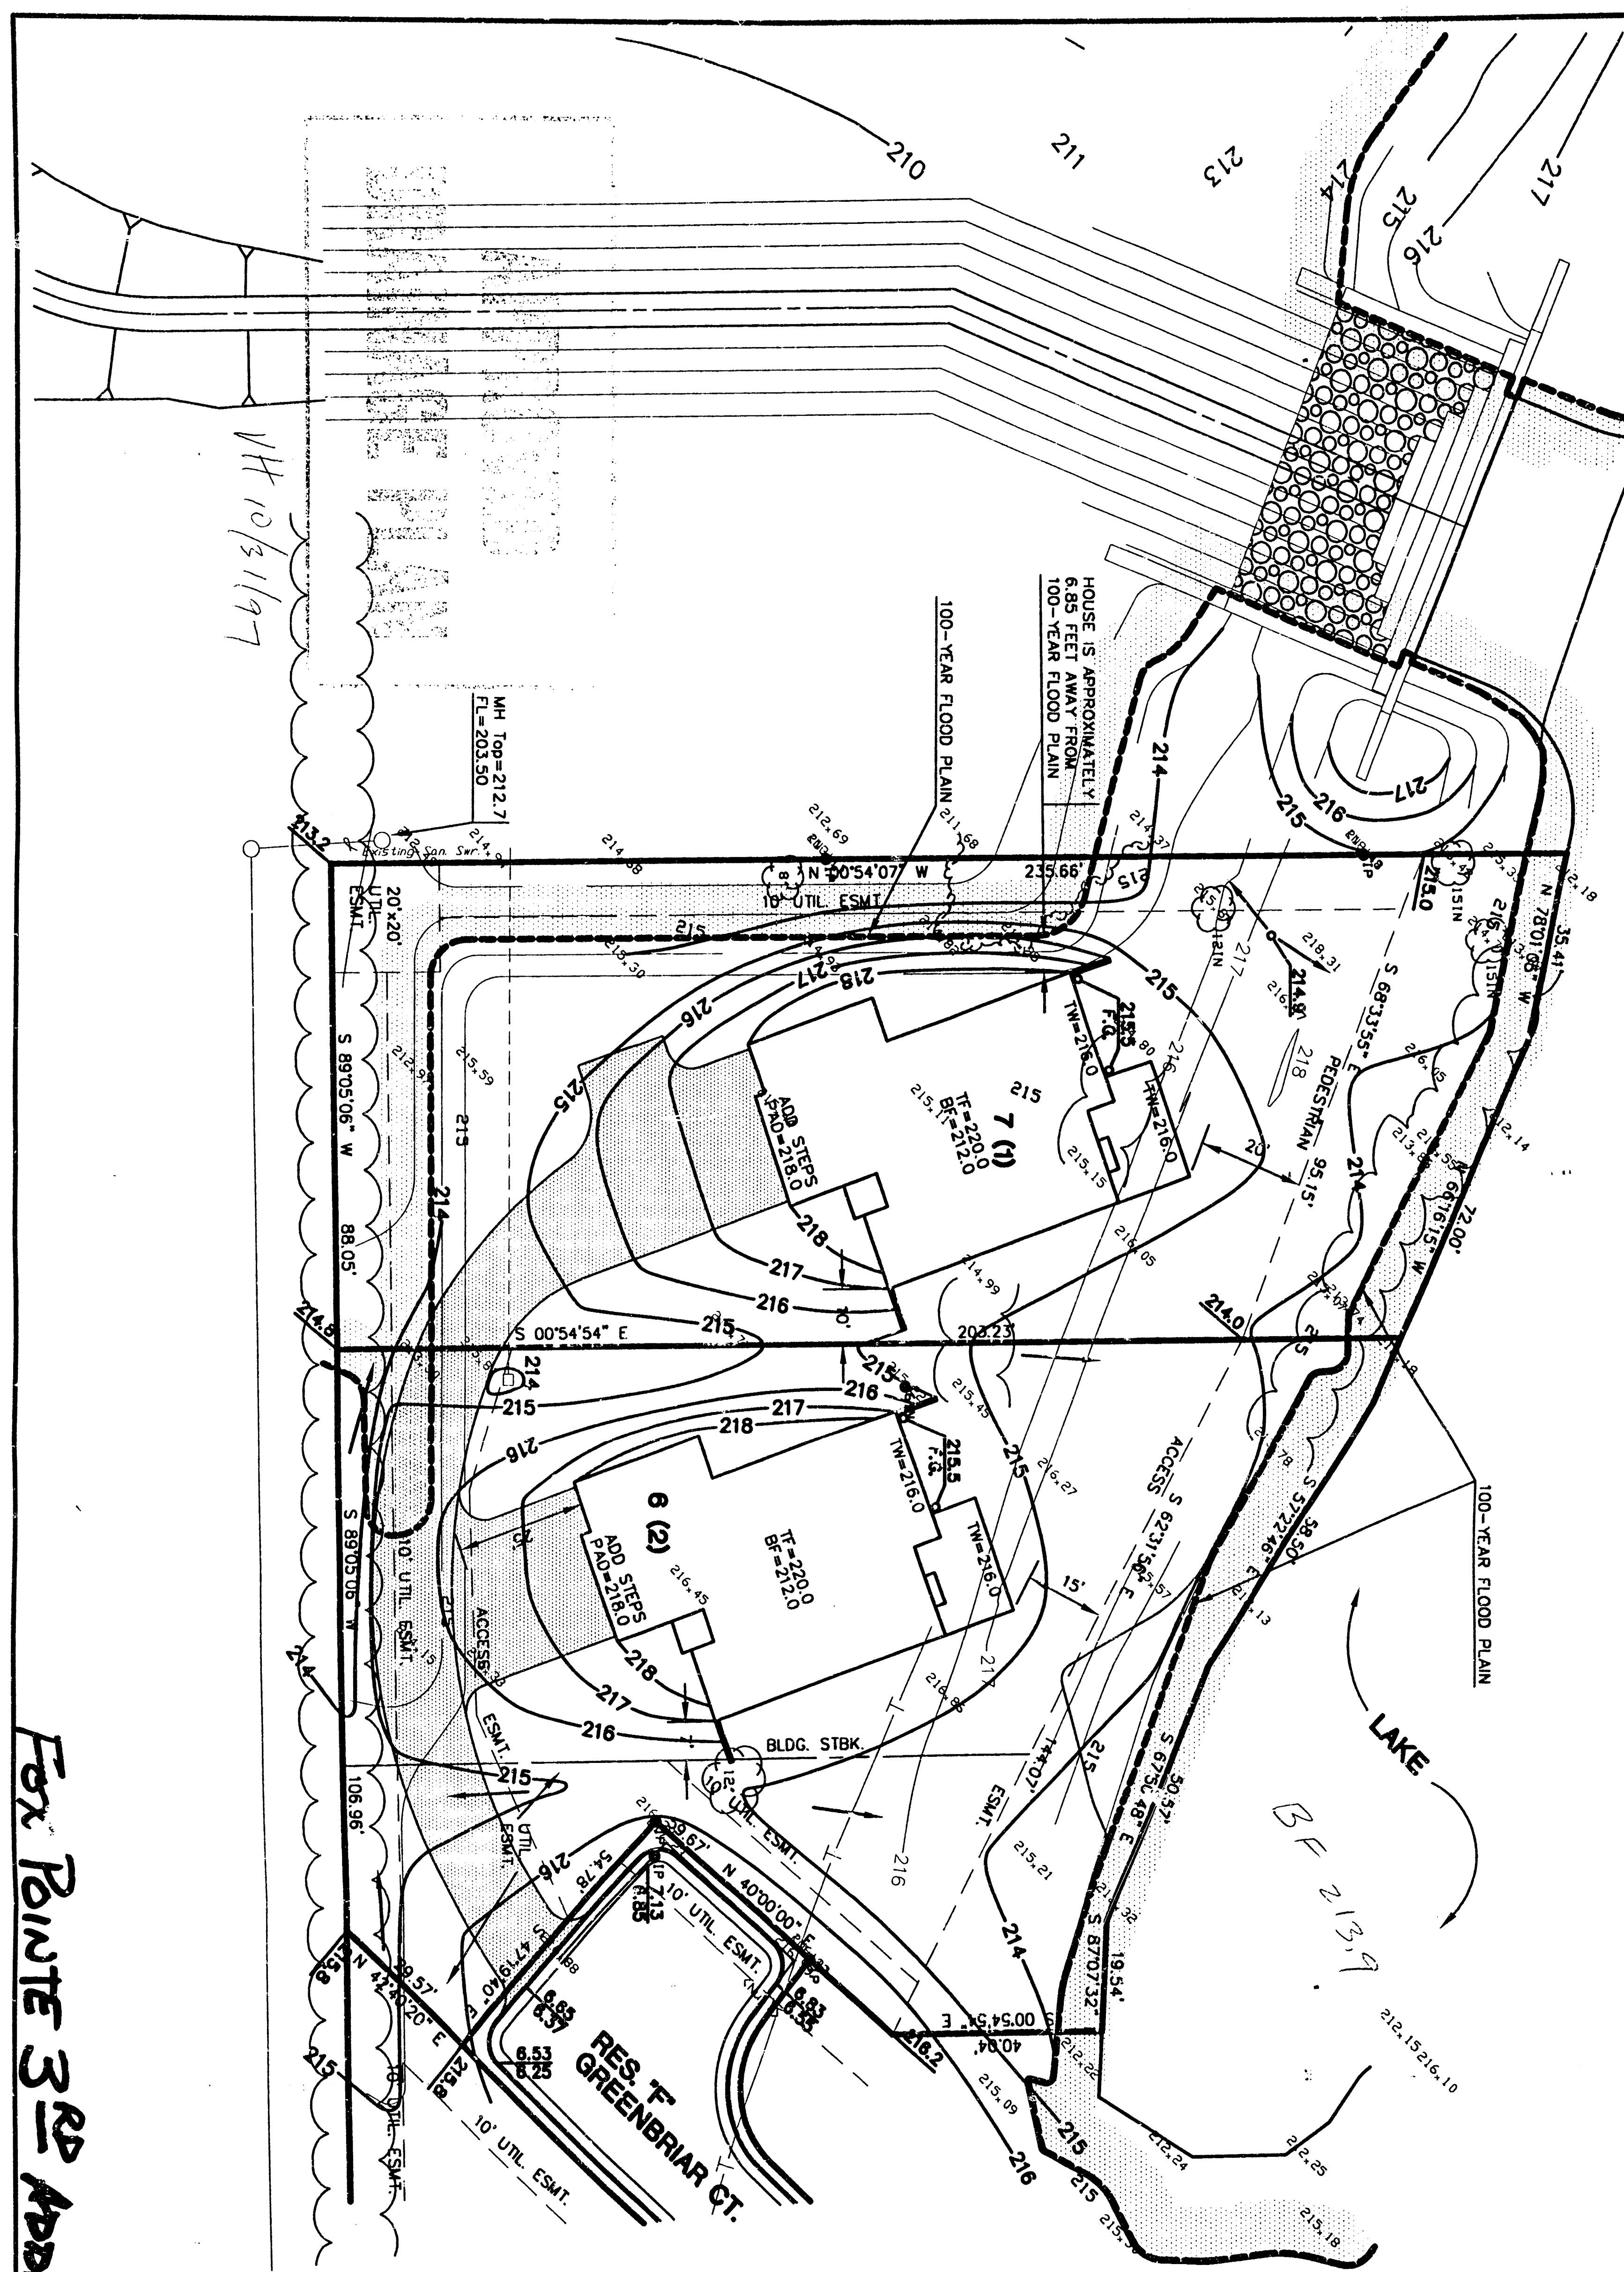

# LEGEND


|                            |                                        |
|----------------------------|----------------------------------------|
| T.W.                       | Top of Wall                            |
| F.G.                       | Finished Ground                        |
| B.L.                       | Brick Ledge                            |
| 1880                       | Proposed Elevations                    |
| 200                        | Existing Elevations                    |
| 0.0%                       | Flow Arrow & Percent Slope             |
| PAD                        | Elevation @ Garage Door Opening        |
| T.F.                       | Top of Foundation                      |
| T.C.                       | Top of Curb                            |
| IL                         | Flow Line                              |
| Add 1 Step                 | Step from Garage Floor to Finish Floor |
| Drop Siding or Brick Ledge | Drop Siding or Brick Ledge             |
| GRD.                       | Ground                                 |

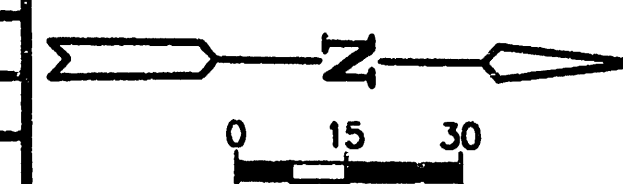

## GENERAL NOTES

- Builder shall provide retaining walls along property line for grade transitions when required to maintain proper slopes between houses.
- This drawing is provided for grading and drainage only and does not represent a boundary or mortgage title inspection. Information shown is from the plat unless otherwise indicated.

BUILDER: LEEWOOD HOMES

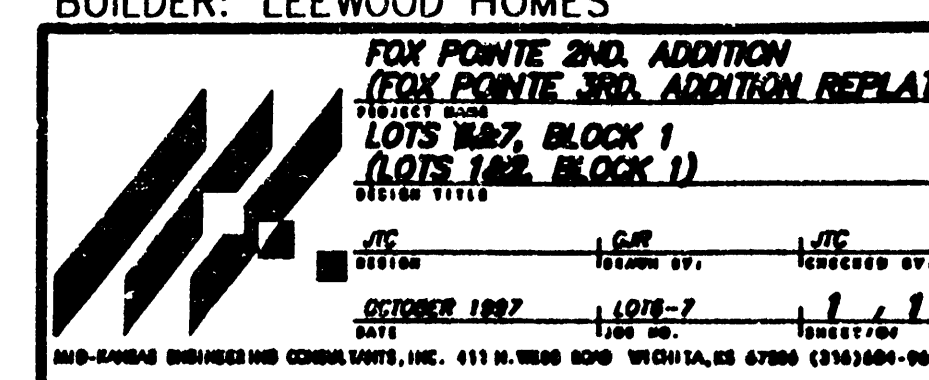

