


**APPROVED  
DRAINAGE PLAN**

*Kenneth E. Hill*  
7/28/99

WATER LEVEL  
127.6      WATER LEVEL  
127.6  
POND

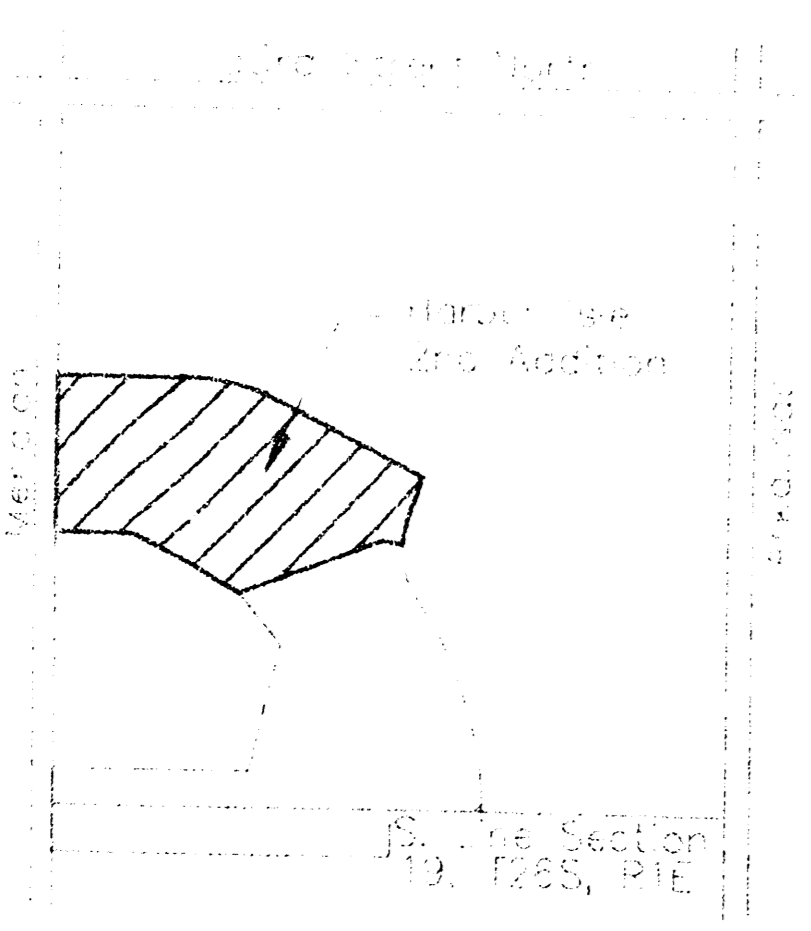

VICINITY MAP

**NOTES:**

- The maximum low opening for homes built in this addition shall be 34" (City of Wichita Return) or 1321.4 (MSL Datum).
- The minimum pavement floor elevation for homes built in this addition shall be 131.1 (City of Wichita Datum) or 1418.4 (MSL Datum).

**LEGEND:**

- 47.5 (Suggested Top of Foundation Elevation)
- 48.0 (Suggested Garage Floor Elevation)
- 48.5 (Suggested Elevation of Rear of Home)
- 49.0 (Six (6) Inch New Out Let)
- Indicates Drainage Path

**BENCHMARKS**

1. "BM" set on southeast corner of north meadow at Meridian Avenue and M10. Elevation: 139.35 (City of Wichita Datum)

LOT GRADING PLAN- REVISED

# HARBOR ISLE 2ND ADDITION

TO WICHITA - SEDGWICK COUNTY, KANSAS  
DATE: FEB. 1, 1998      REVISED 7/28/99 ←

**PE** POE & ASSOCIATES OF KANSAS, INC.  
CONSULTING ENGINEERS  
5940 E. Central, Suite 200 • P.O. Box 45 • 67208 • 316.855.4114 • Fax: 316.855.4444

**HARBOR ISLE 2ND**      7-28-99  
Revision

5:48PM 02/01/99 08:00 AM 14:25:24 1999 WKS: P1027