


BENCHMARKS:

BM #1 "□" On Top of Curb Located on the South Side of Hendryx 15' West of the East Line of Auburn Hills 2nd Addition. Elev. = 134.32 City Datum

BM #2 "□" On Top of Curb Located at 14.29' North and 38.05' West of the Northeast corner of Lot 13, Block B, Auburn Hills Addition. Elev. = 144.83 City Datum




Scale: 1" = 60'
• = Iron

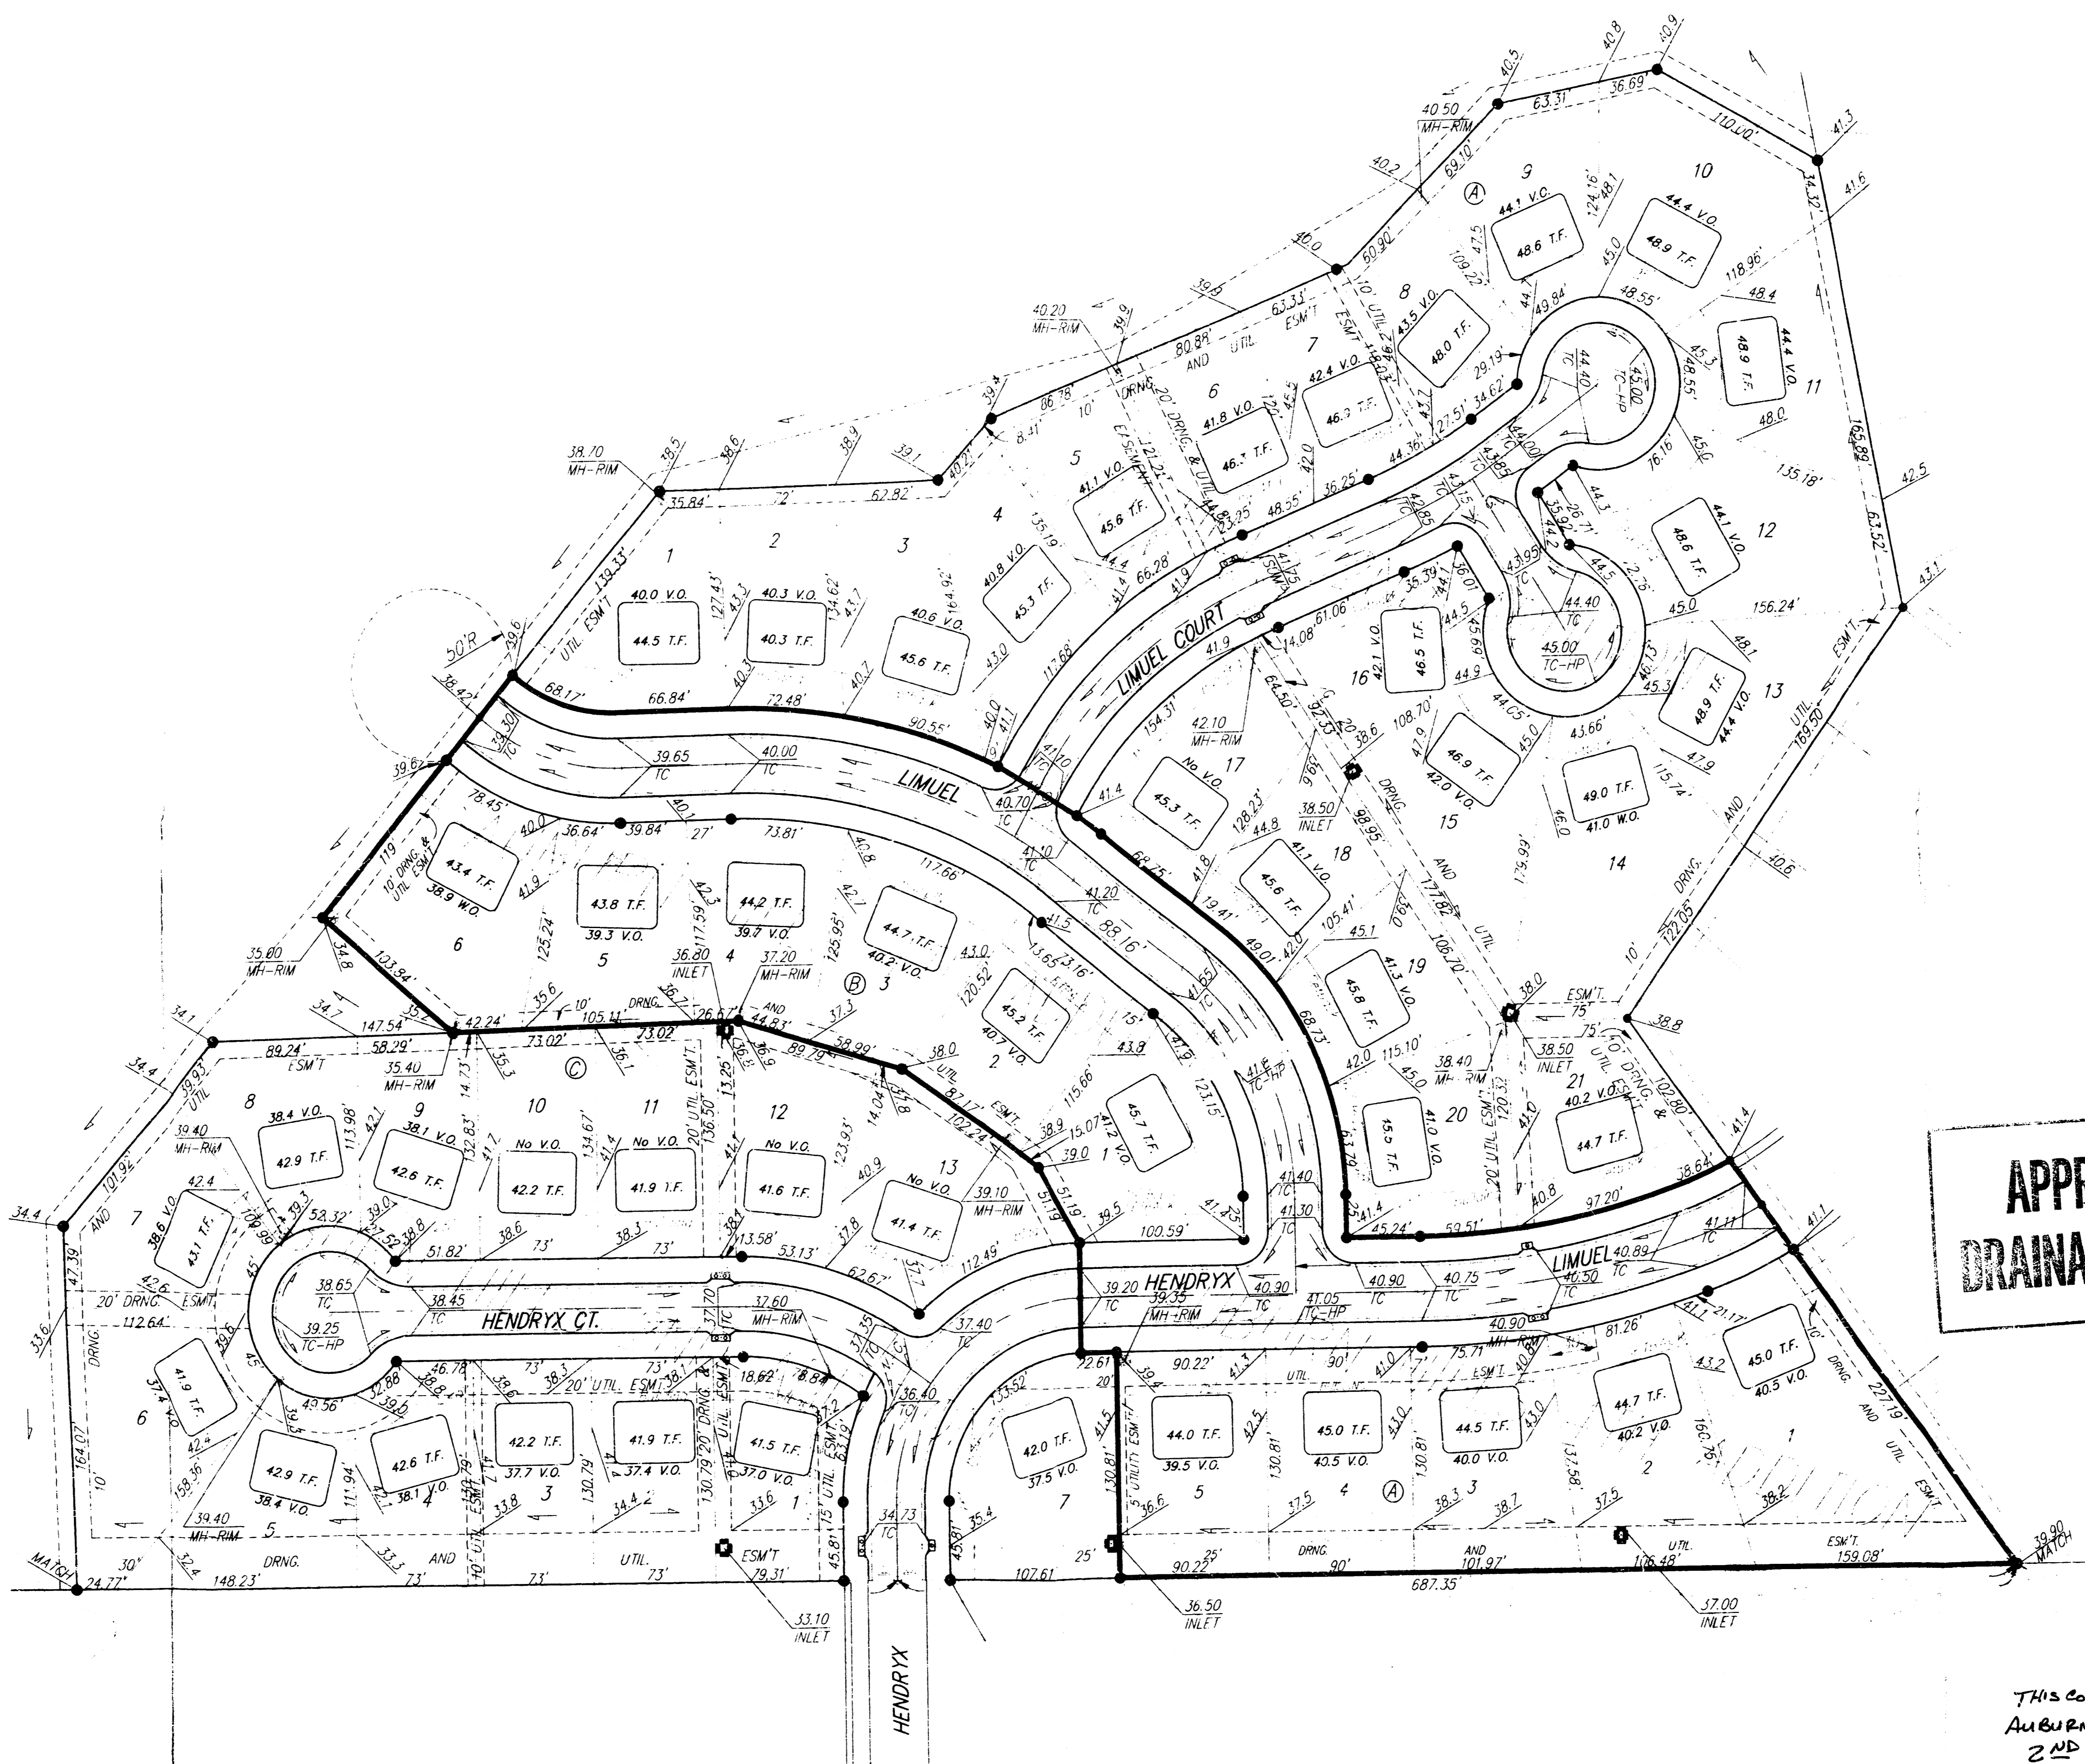


NOTE:

Proposed top of foundation elevations are shown on plans. Contractor to set finish floor elevation. All street elevations shown on plans are for top of curb (full height). View-out elevations are marked as XXX V.O. Walk-out elevations are marked as XXX W.O.

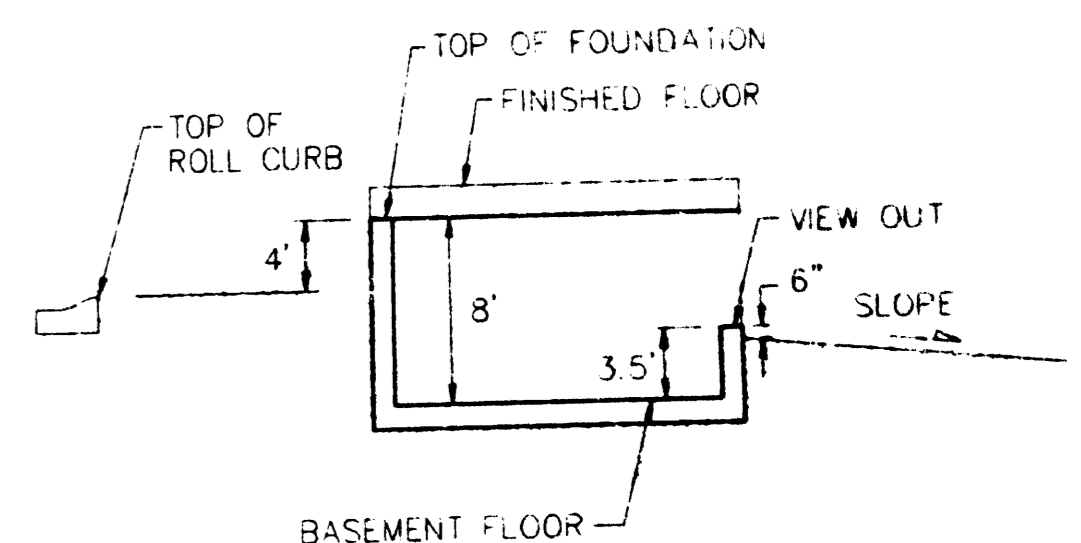

TYPICAL VIEW OUT
NO SCALE

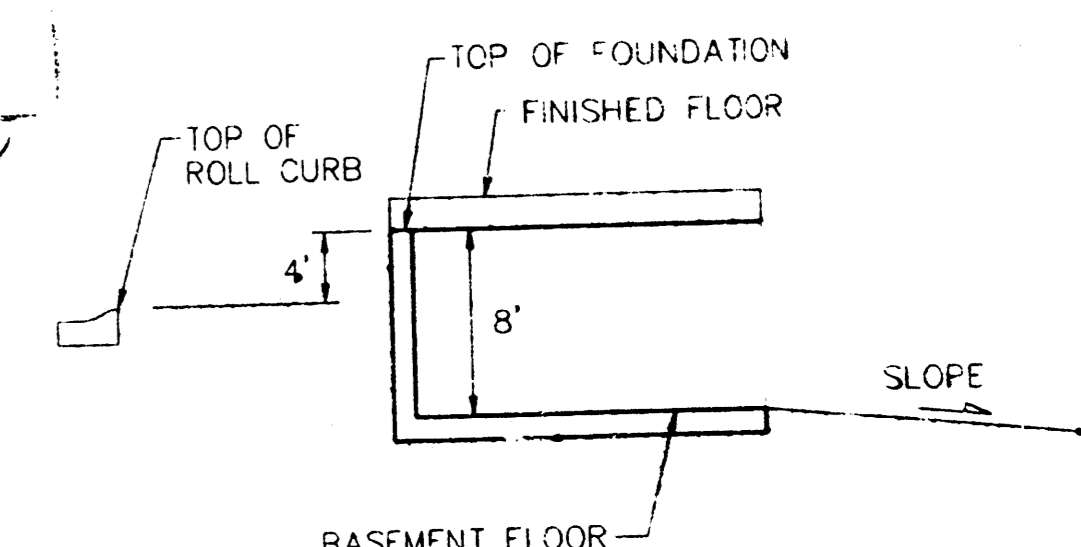

TYPICAL WALK OUT
NO SCALE

APPROVED DRAINAGE PLAN

VH 718798

THIS COVERS
AUBURN HILLS
2ND AND
4th ADDITIONS

Note: Revised 12/31/97 bp

LOT GRADING PLAN

WICHITA, KANSAS
BAUGHMAN COMPANY P.A.
ENGINEERING, SURVEYING, & PLANNING

DESIGN	DRAWN	APPROVED	DATE	SCALE	SHEET
					1 of 1

PLAT CARD MARKED 8 JULY 1998