


PEMBROOK

AN ADDITION, TO WICHITA, SEDGWICK COUNTY, KANSAS

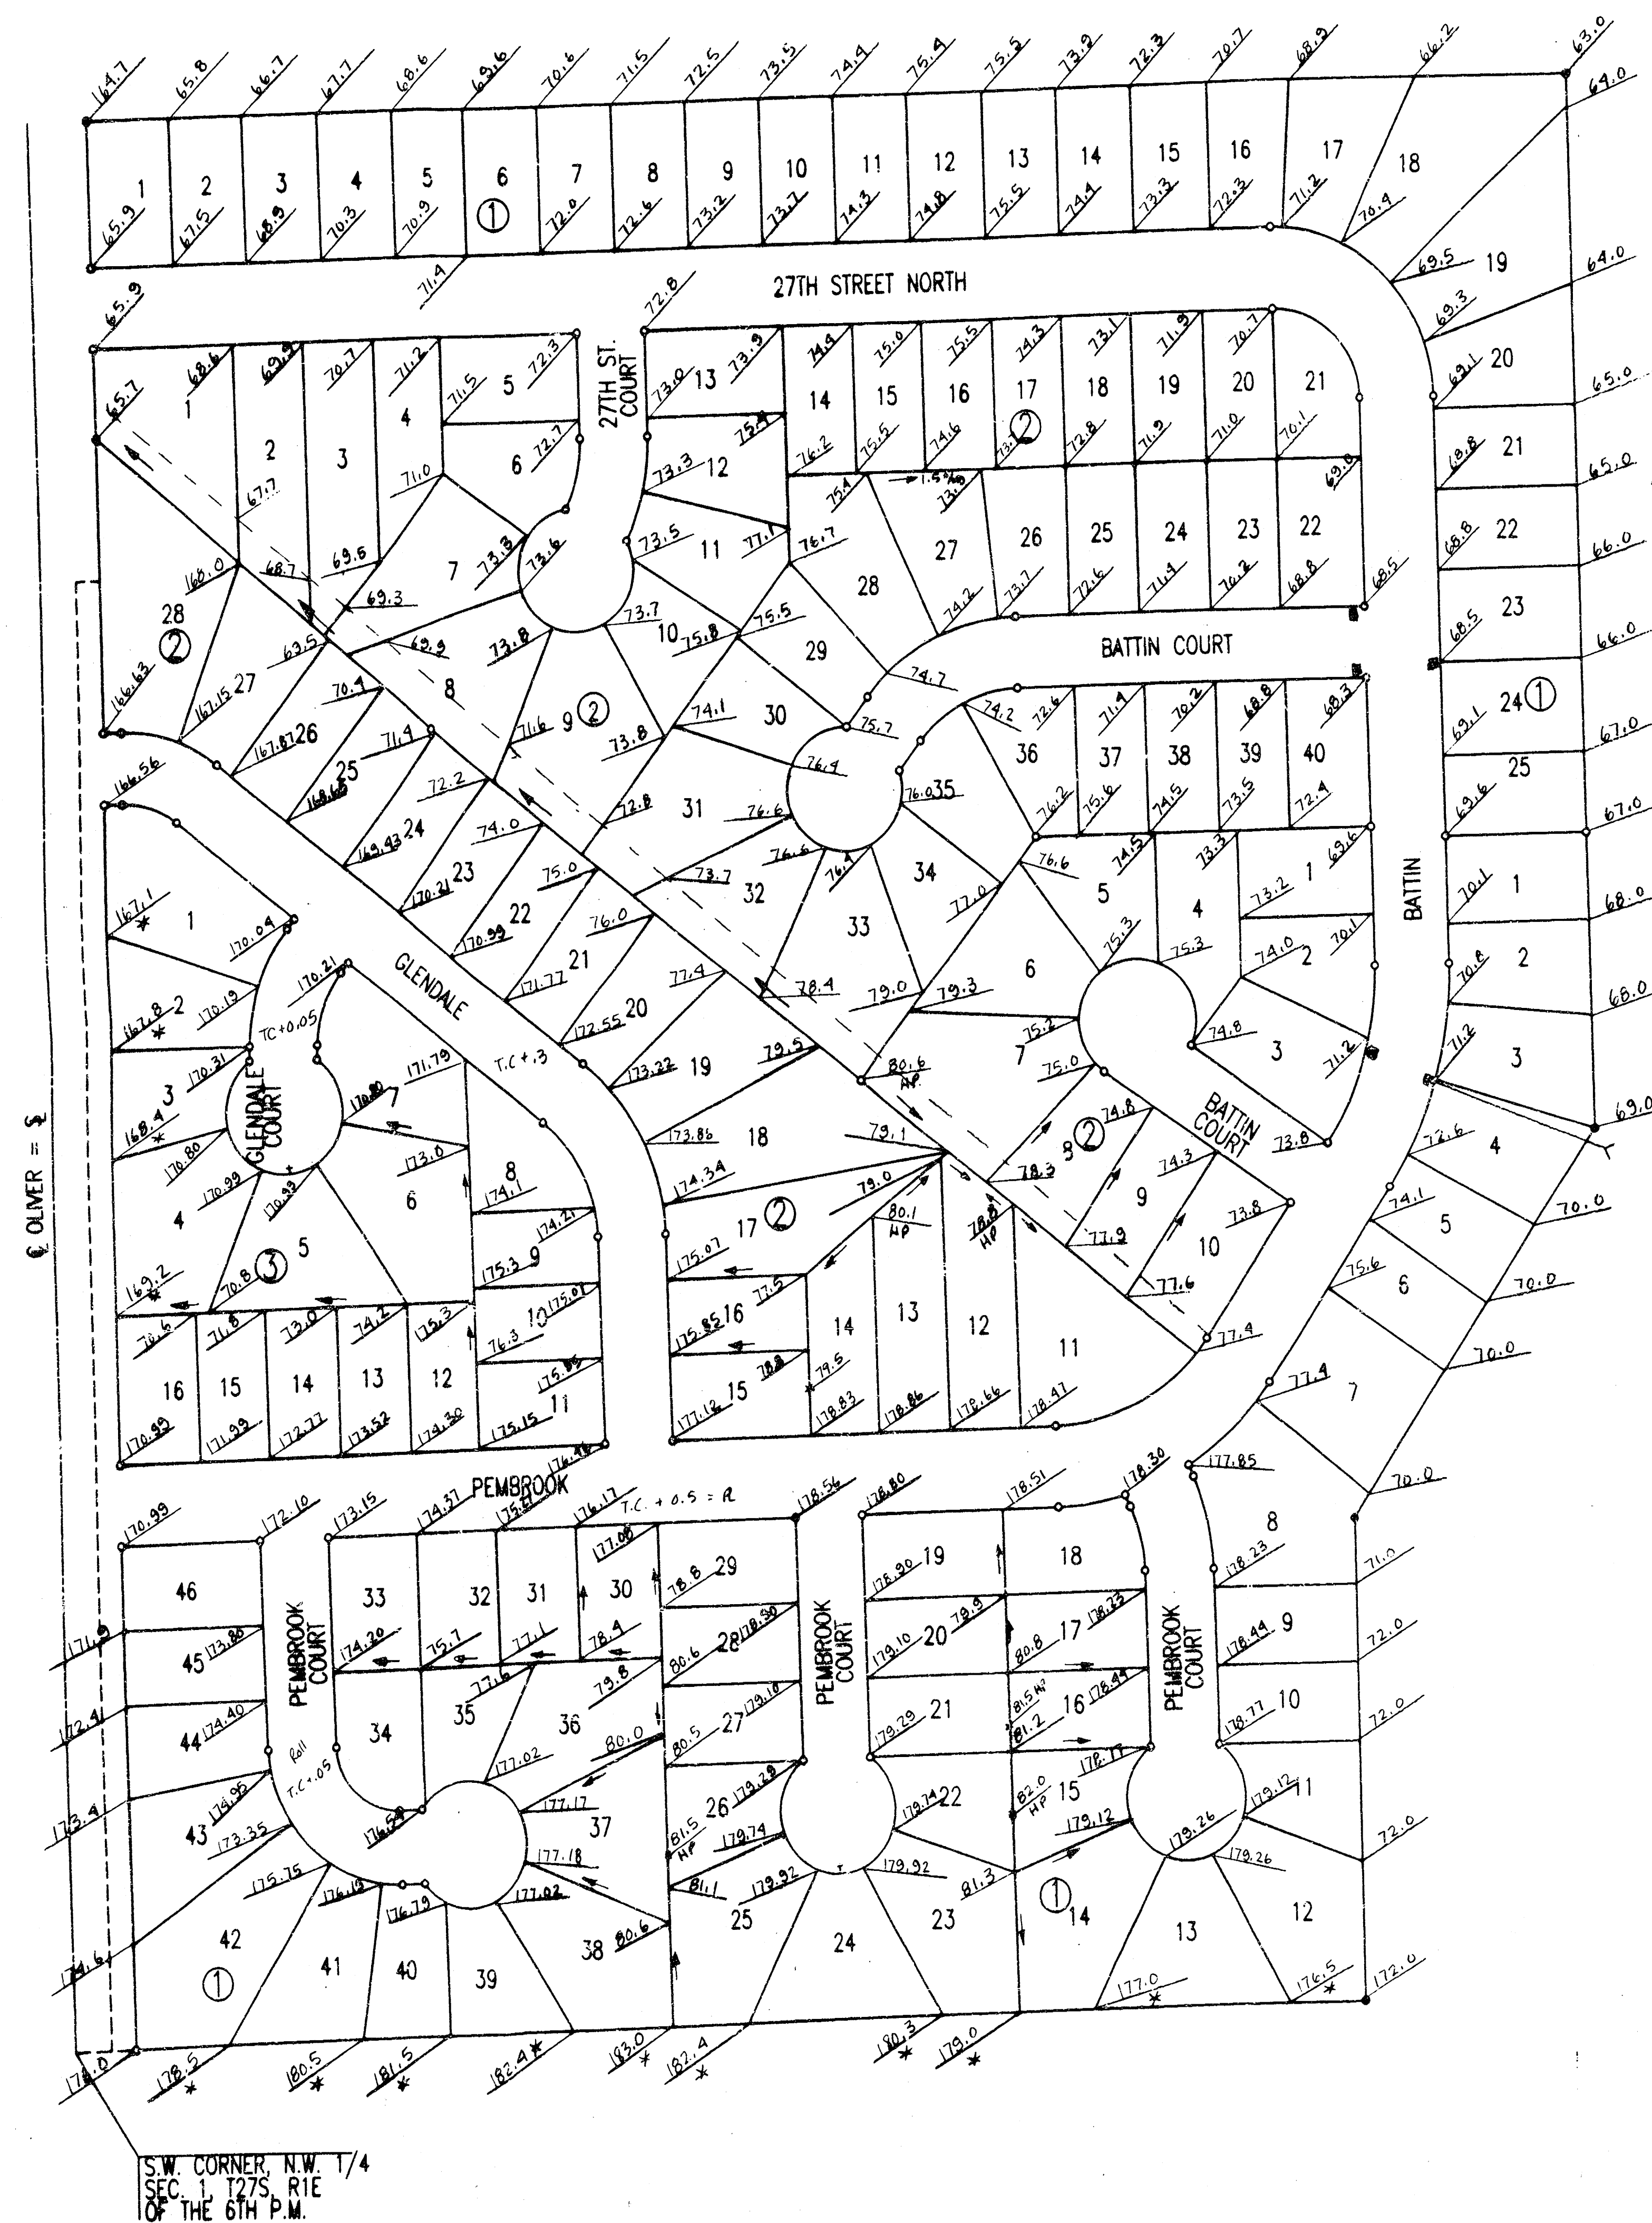

SCALE: 1"=100'
 ○ = IRON SET
 ● = IRON FOUND
 CALC. MEAS. = CALCULATED FROM MEASUREMENT
 MEAS. = MEASURED
 S.S. = SANITARY SEWER
 B.S.L. = BUILDING SETBACK LINE

B.M. - DISC 29' NORTH AND 33' EAST OF
 CENTERLINE OLIVER AND 29TH STREET
 NORTH. ELEV.=159.68 CITY DATUM
 B.M. - RAILROAD SPIKE IN S.W. FACE OF
 POWER POLE 26.5' NORTH OF 1/16
 CORNER, 1/4 MILE EAST OF 29TH
 STREET NORTH AND OLIVER.
 ELEV.=161.18 CITY DATUM

MINIMUM PAD ELEVATION (LOWEST OPENING) AS
 FOLLOWS:
 BLOCK 1
 LOT 1 ELEV. 167.00 CITY DATUM
 LOT 2 ELEV. 168.00 CITY DATUM
 LOTS 3 AND 4 ELEV. 169.00 CITY DATUM
 LOTS 5 THROUGH 7 ELEV. 170.00 CITY DATUM
 LOTS 8 AND 9 ELEV. 171.00 CITY DATUM
 LOTS 10 THROUGH 12 ELEV. 172.00 CITY DATUM
 THIS ADDITION IS SUBJECT TO THE REQUIREMENTS
 OF THE BEACON HILL C.U.P., DP-147 ON FILE
 WITH THE METROPOLITAN AREA PLANNING
 DEPARTMENT.

* Match Existing Elevation

PEMBROOK & PEMBROOK 2ND

**APPROVED
 DRAINAGE PLAN**

Revised 7-27-98 KER

234 A