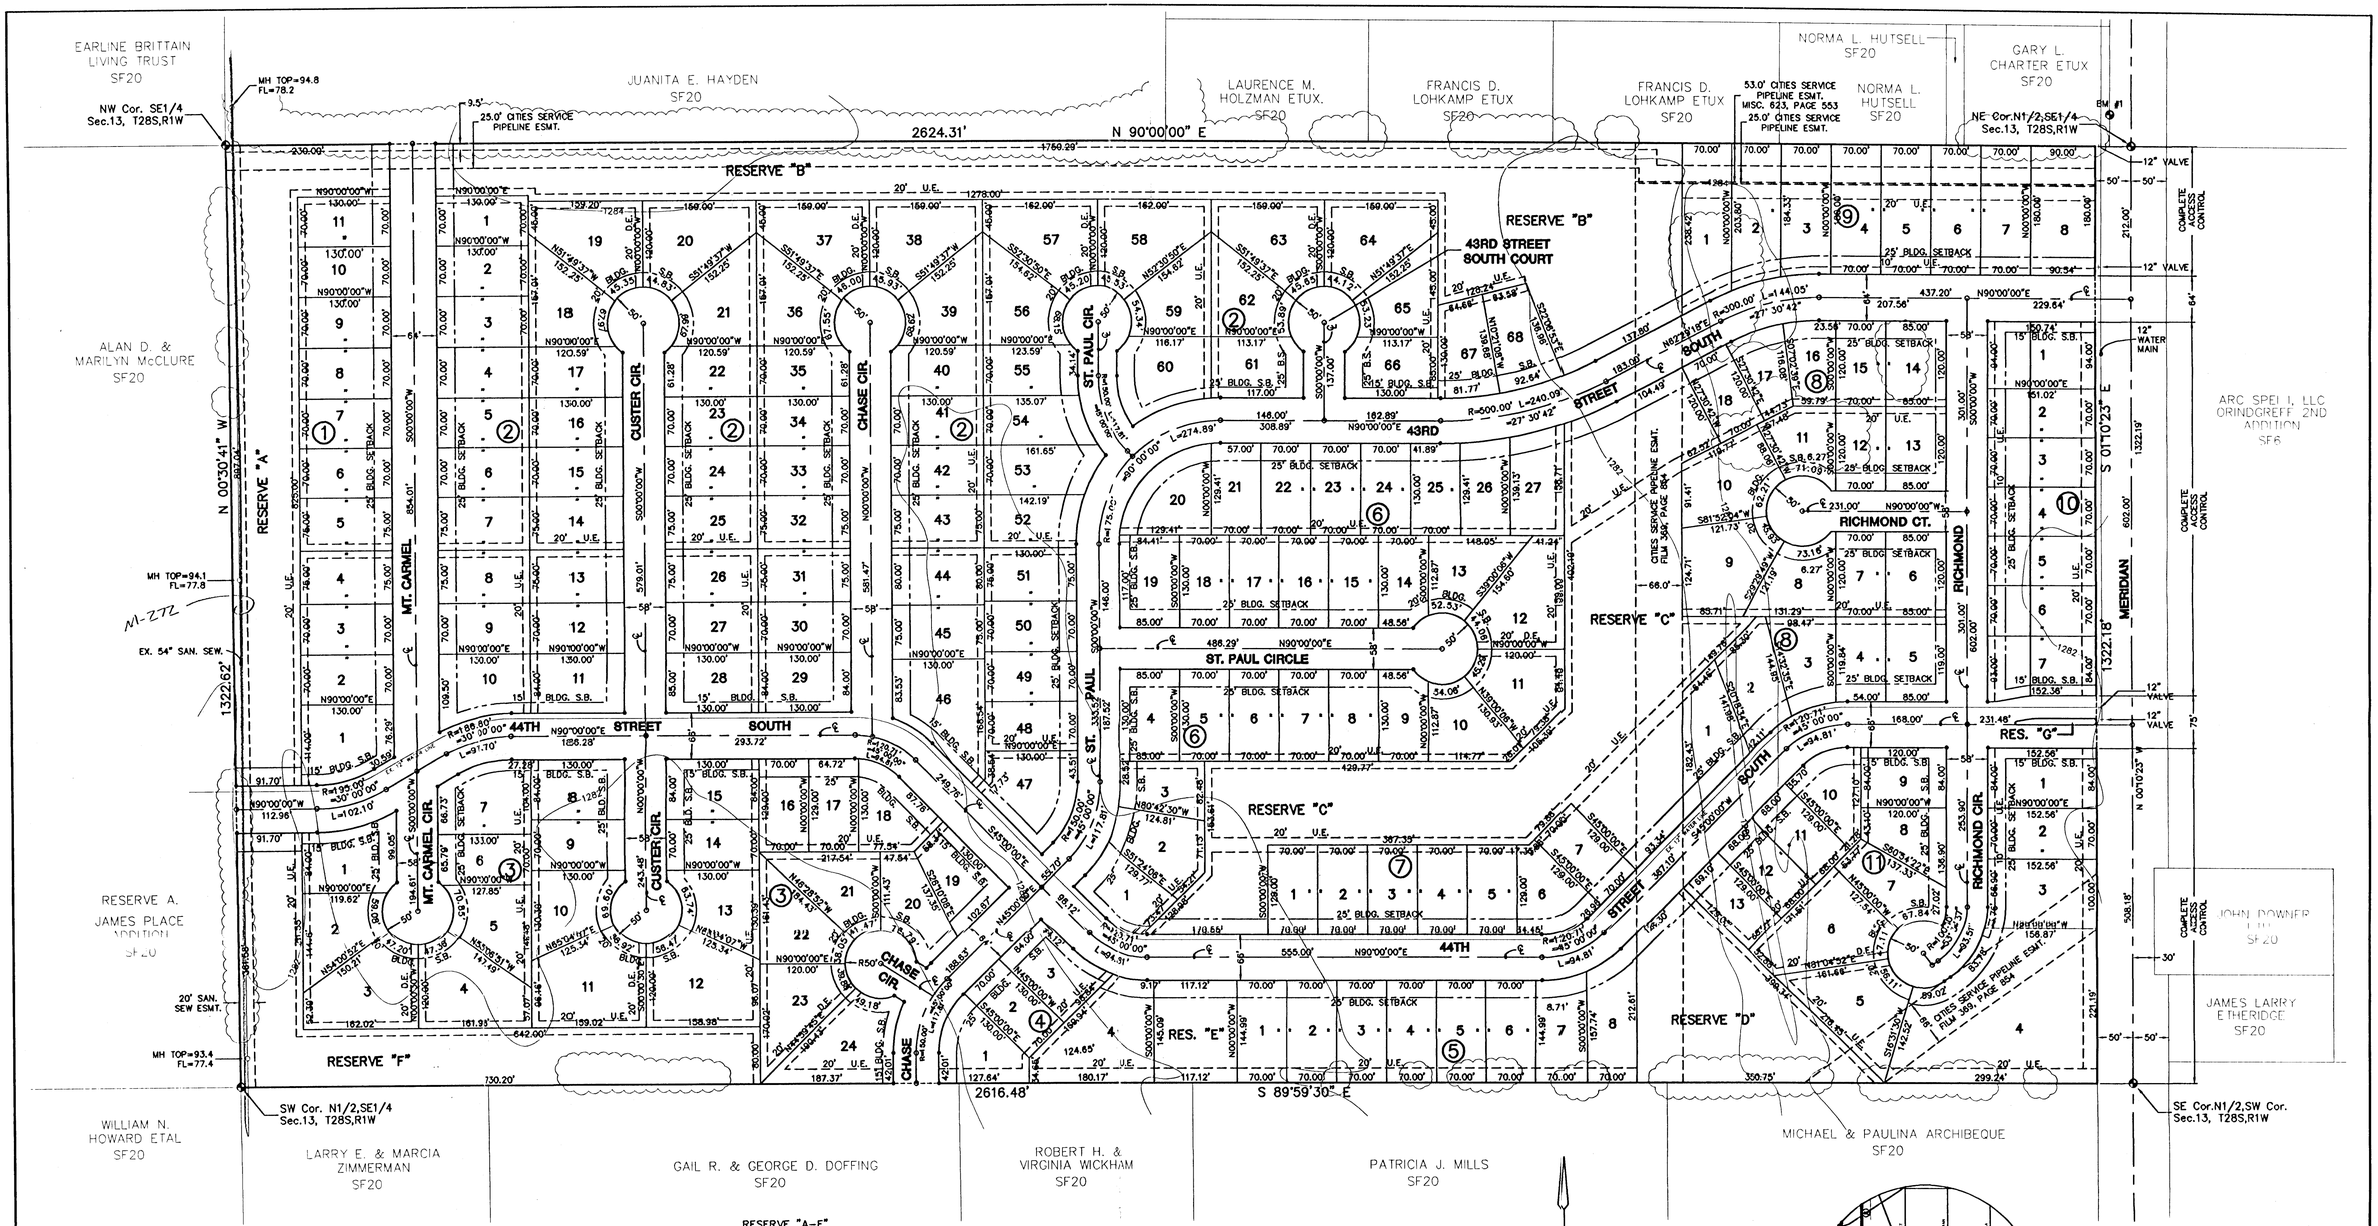

EXISTING ZONING: SF6
PROPOSED ZONING: SF6

RESERVE "A-F"
DRAINAGE
LANDSCAPING
OPEN SPACE

RESERVE "G"
ENTRY MONUMENT
LANDSCAPING
OPEN SPACE

BENCHMARKS

BM #1 COW BENCH MARK. 44' NORTH AND 30' EAST QUARTER SECTION CORNER. 67' NORTH OF 4' GAS VENT PIPE. 70' NORTH OF 4' FENCE EXS. 94.2' NORTH OF TELE POLE. 41.0' SOUTH OF TELE POLE. 54.6' NE OF 1/4 SEC COR IRON. ELEV=93.396

LOCATION MAP

PRELIMINARY PLAT

SOUTH PARK THIRD ADDITION

OWNER: BUILDERS INC. - 1081 S. GLENDALE ST. - WICHITA, KANSAS 67218

APRIL 1998

MID-KANSAS ENGINEERING CONSULTANTS, INC.
411 N. WEBB ROAD
WICHITA, KS. 67206
316-684-9600

G:\CIVIL\95138\PROP\95138-PL.DWG Tue Apr 21 11:28:31 1998